


NOTES:

1. LEVELS ARE IN TERMS OF THE MOTURIKI DATUM.
2. ORIGIN OF LEVELS TCC BENCHMARK BM 1069 RL 42.220m.
3. METHOD OF SURVEY: GPS
4. ALL WORKS WERE CARRIED OUT TO TCC IDC 2011 STANDARDS.
5. ALL MAINS ARE DN 100 PVC UNLESS OTHERWISE SPECIFIED.
6. ALL RIDERMAINS ARE 63 OD PE UNLESS OTHERWISE SPECIFIED.
7. ALL PVC PIPE WATERMAINS ARE PVC PN9 PIPE.
8. REFER TO TABLE FOR PE PIPE DETAILS
9. WHERE MULTIPLE WATER METERS ARE BANKED AT THE BOUNDARY 2 OR 3 WATER METERS HAVE BEEN PLACED IN EACH BOX.
10. NO VALVES OR HYDRANTS ARE LOCATED IN THE CARRIAGEWAY.
11. ALL WATER METERS HAVE BEEN INSTALLED WITHIN THE ROAD RESERVE.
12. ALL BURIED AS BUILT INFORMATION SUPPLIED BY HIGGINS CONTRACTORS LTD.

LEGEND:

- AS BUILT WATER MAIN
- AS BUILT RIDER MAIN
- EXISTING WATER
- AS BUILT WATER CONNECTION
- AS BUILT HYDRANT
- AS BUILT SLUICE VALVE
- AS BUILT GATE VALVE
- AS BUILT WATER METER
- EXISTING HYDRANT
- EXISTING SLUICE VALVE
- EXISTING GATE VALVE

PE PIPE DIMENSIONS				
TYPE	SIZE	STANDARD DIMENSION RATIO	MATERIAL	PRESSURE RATING
MAIN	125mm OD	SDR11	PE80	PN 12.5
RIDERMAIN	63mm OD	SDR11	PE80	PN 12.5
CONNECTION	25mm OD	SDR11	PE80	PN 12.5

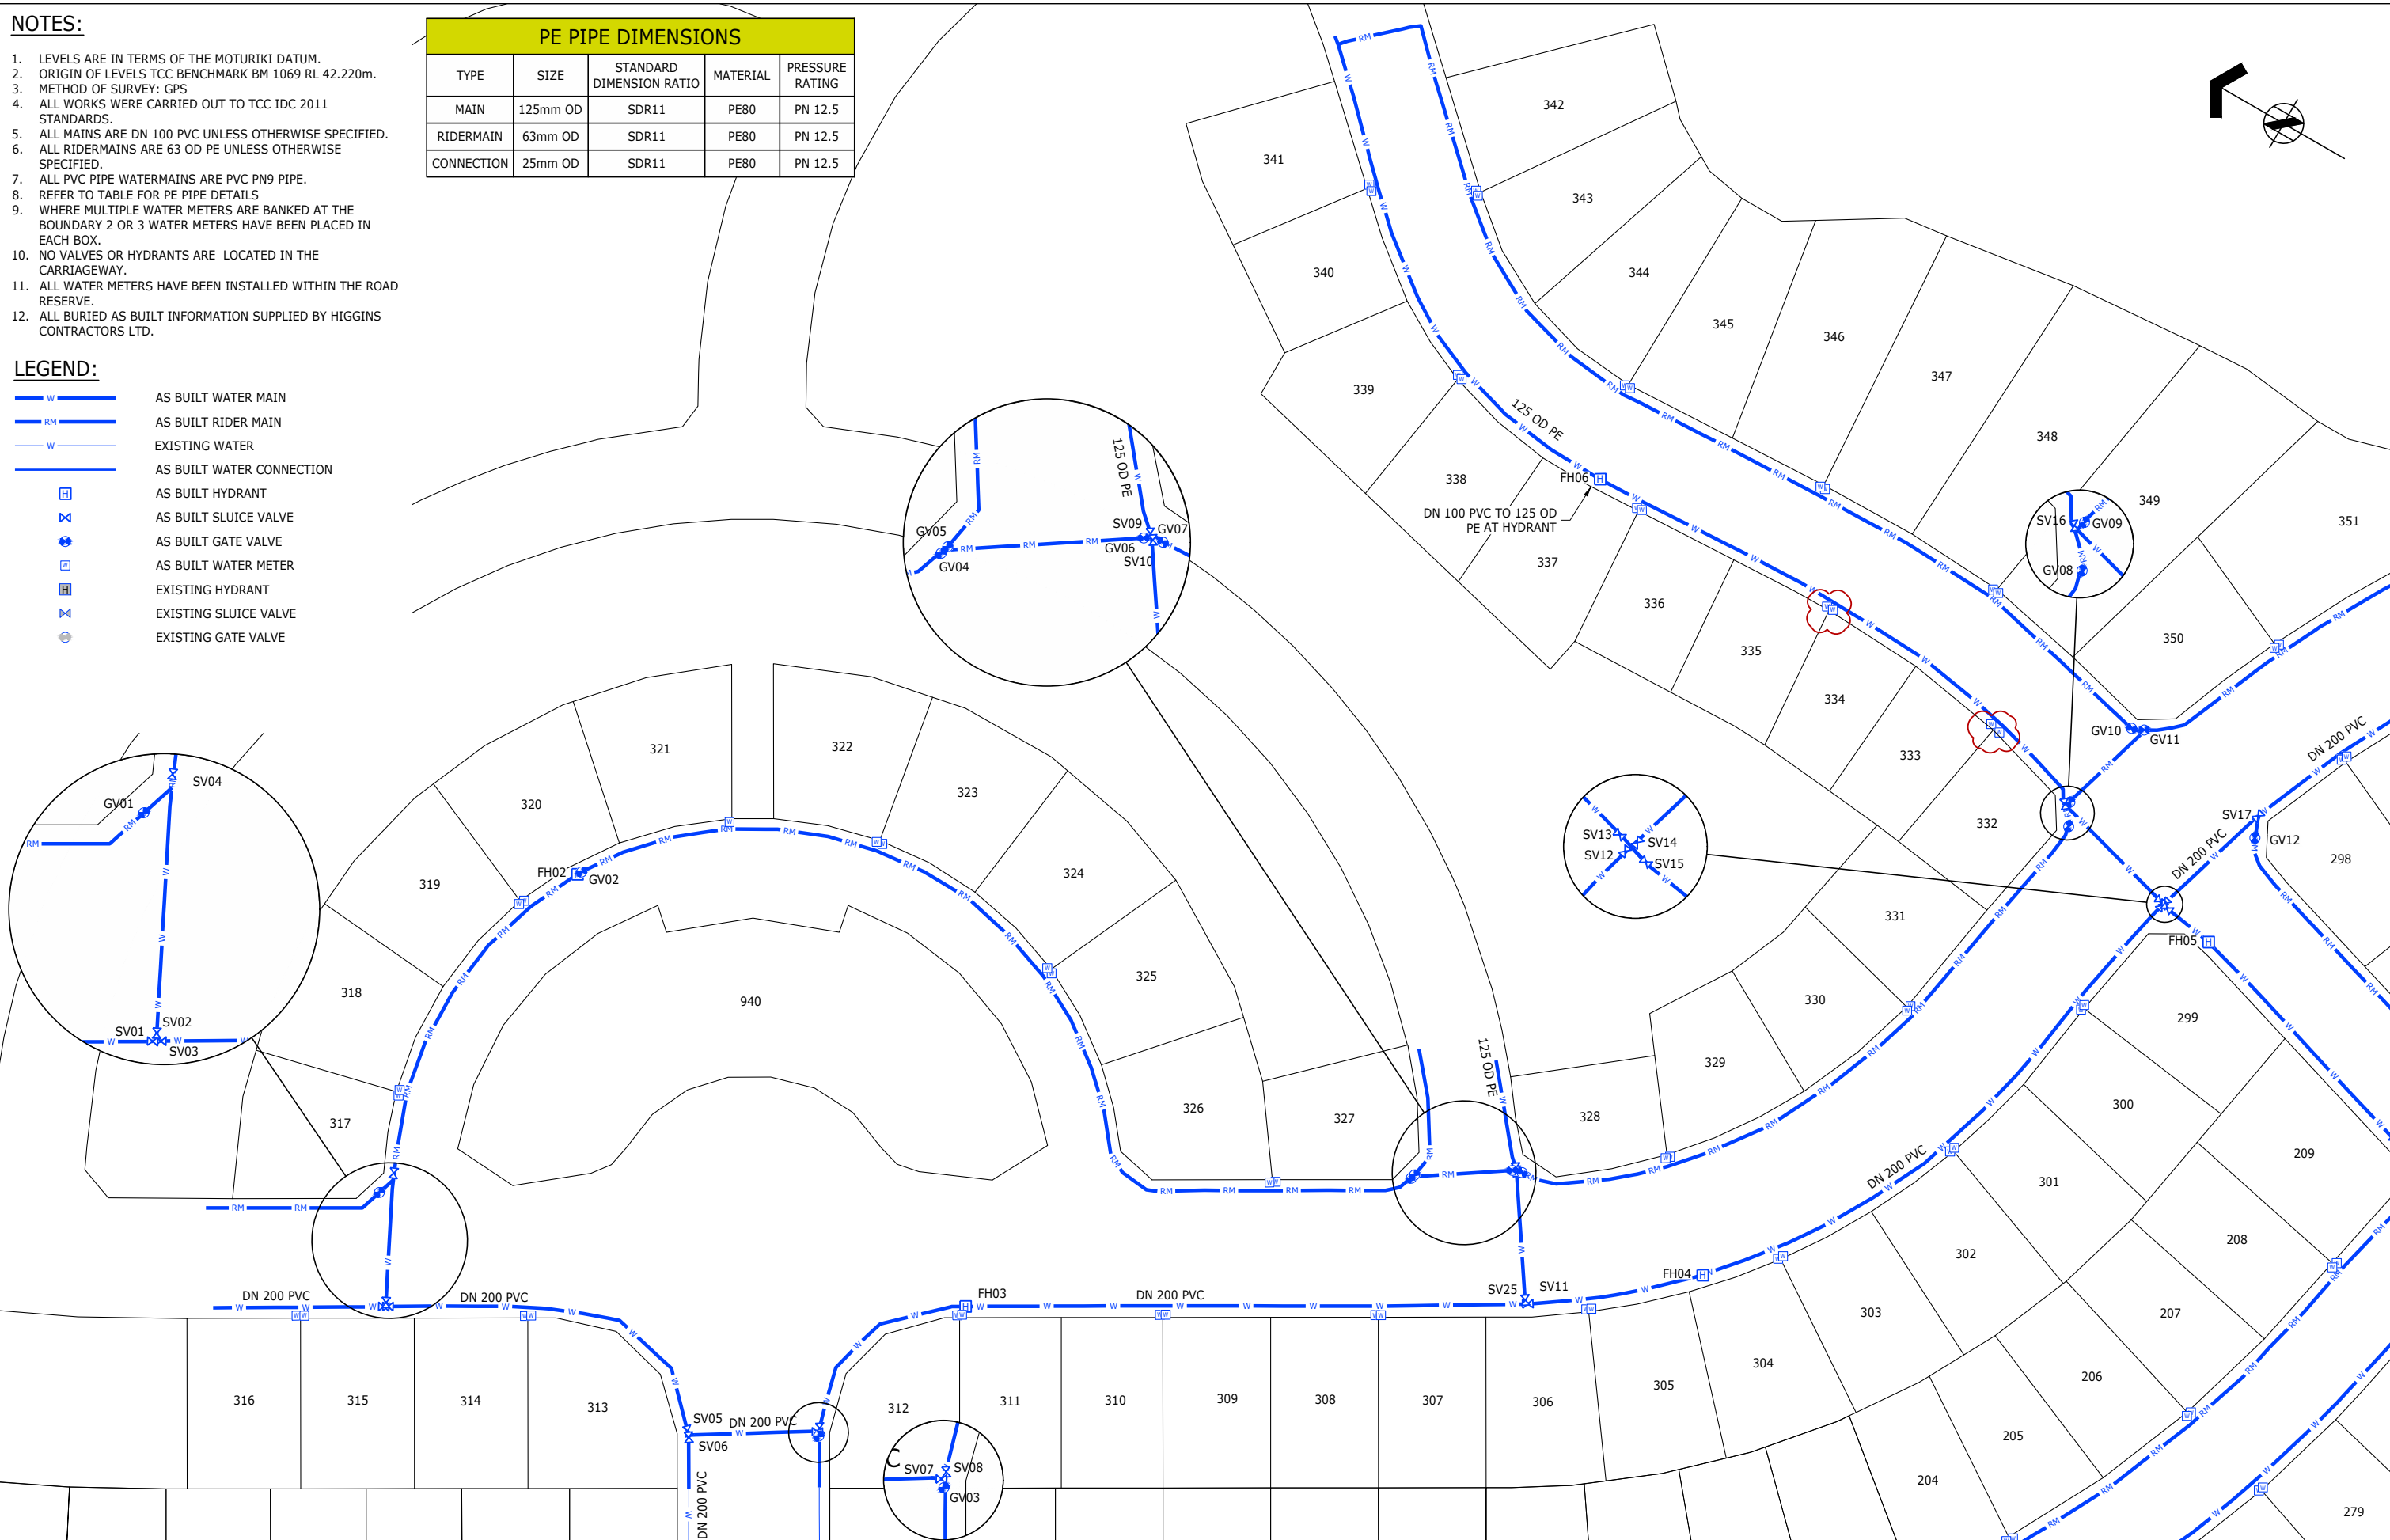

ORIGINATOR:	DATE:	SIGNED:	PLT BY:
RXD	28.04.16		TRS
DRAWN:	DATE:	SIGNED:	PLT DATE:
HEH	28.04.16		13.06.16
CHECKED:	DATE:	SIGNED:	SURVEY BY:
GPR	13.06.16		
APPROVED:	DATE:	SIGNED:	SURVEY DATE:
GPR	13.06.16		
BY:	DATE:	SIGNED:	

ASSOCIATION OF CONSULTING ENGINEERS
NEW ZEALAND

ISO 9001
QUALITY ASSURED

THIS DRAWING AND DESIGN REMAINS THE PROPERTY OF, AND MAY NOT BE REPRODUCED OR ALTERED, WITHOUT THE WRITTEN PERMISSION OF HARRISON GRIERSON CONSULTANTS LIMITED. NO LIABILITY SHALL BE ACCEPTED FOR UNAUTHORISED USE OF THIS DRAWING.

TAURANGA OFFICE
LEVEL 1 HARRISON GRIERSON HOUSE
141 CAMERON ROAD TAURANGA 3110
T +64 7 578 0023
W www.harrisongrierson.com

PROJECT:

Summit

THE LAKES (2012) LIMITED, TAURANGA

TITLE:

STAGES 3CD
WATER RETICULATION AS BUILT PLAN
SHEET 1
TCC IP 101665

ISSUE STATUS:	AS BUILT
PROJECT No:	1520-137966-01
SCALES:	1:500 - A1 1:1000 - A3
DRAWING No:	137966-AB301
REV	C