


PE PIPE DIMENSIONS				
TYPE	SIZE	STANDARD DIMENSION RATIO	MATERIAL	PRESSURE RATING
MAIN	250mm OD	SDR13.6	PE100	PN 12.5
MAIN	125mm OD			
RIDERMAIN	63mm OD	SDR11	PE80	
CONNECTION	25mm OD			

NOTES:

- LEVELS ARE IN TERMS OF THE MOTURIKI DATUM.
- COORDINATES ARE IN TERMS OF BAY OF PLENTY 2000 CIRCUIT.
- ORIGIN OF LEVELS TCC BENCHMARK BM 1142 RL 35.645m.
- METHOD OF SURVEY: GPS
- ALL WORKS WERE CARRIED OUT TO TCC IDC 2011 STANDARDS.
- ALL RIDERMAINS ARE 63 OD PE UNLESS OTHERWISE SPECIFIED.
- REFER TO TABLE FOR PE PIPE DETAILS
- WHERE MULTIPLE WATER METERS ARE BANKED AT THE BOUNDARY 2 OR 3 WATER METERS HAVE BEEN PLACED IN EACH BOX.
- NO VALVES OR HYDRANTS ARE LOCATED IN THE CARRIAGEWAY.
- ALL WATER METERS HAVE BEEN INSTALLED WITHIN THE ROAD RESERVE EXCEPT FOR KISSLING TERRACE.

LEGEND:

- AS BUILT WATER MAIN
- AS BUILT RIDER MAIN
- AS BUILT HYDRANT
- AS BUILT SLUICE VALVE
- AS BUILT GATE VALVE
- AS BUILT WATER METER

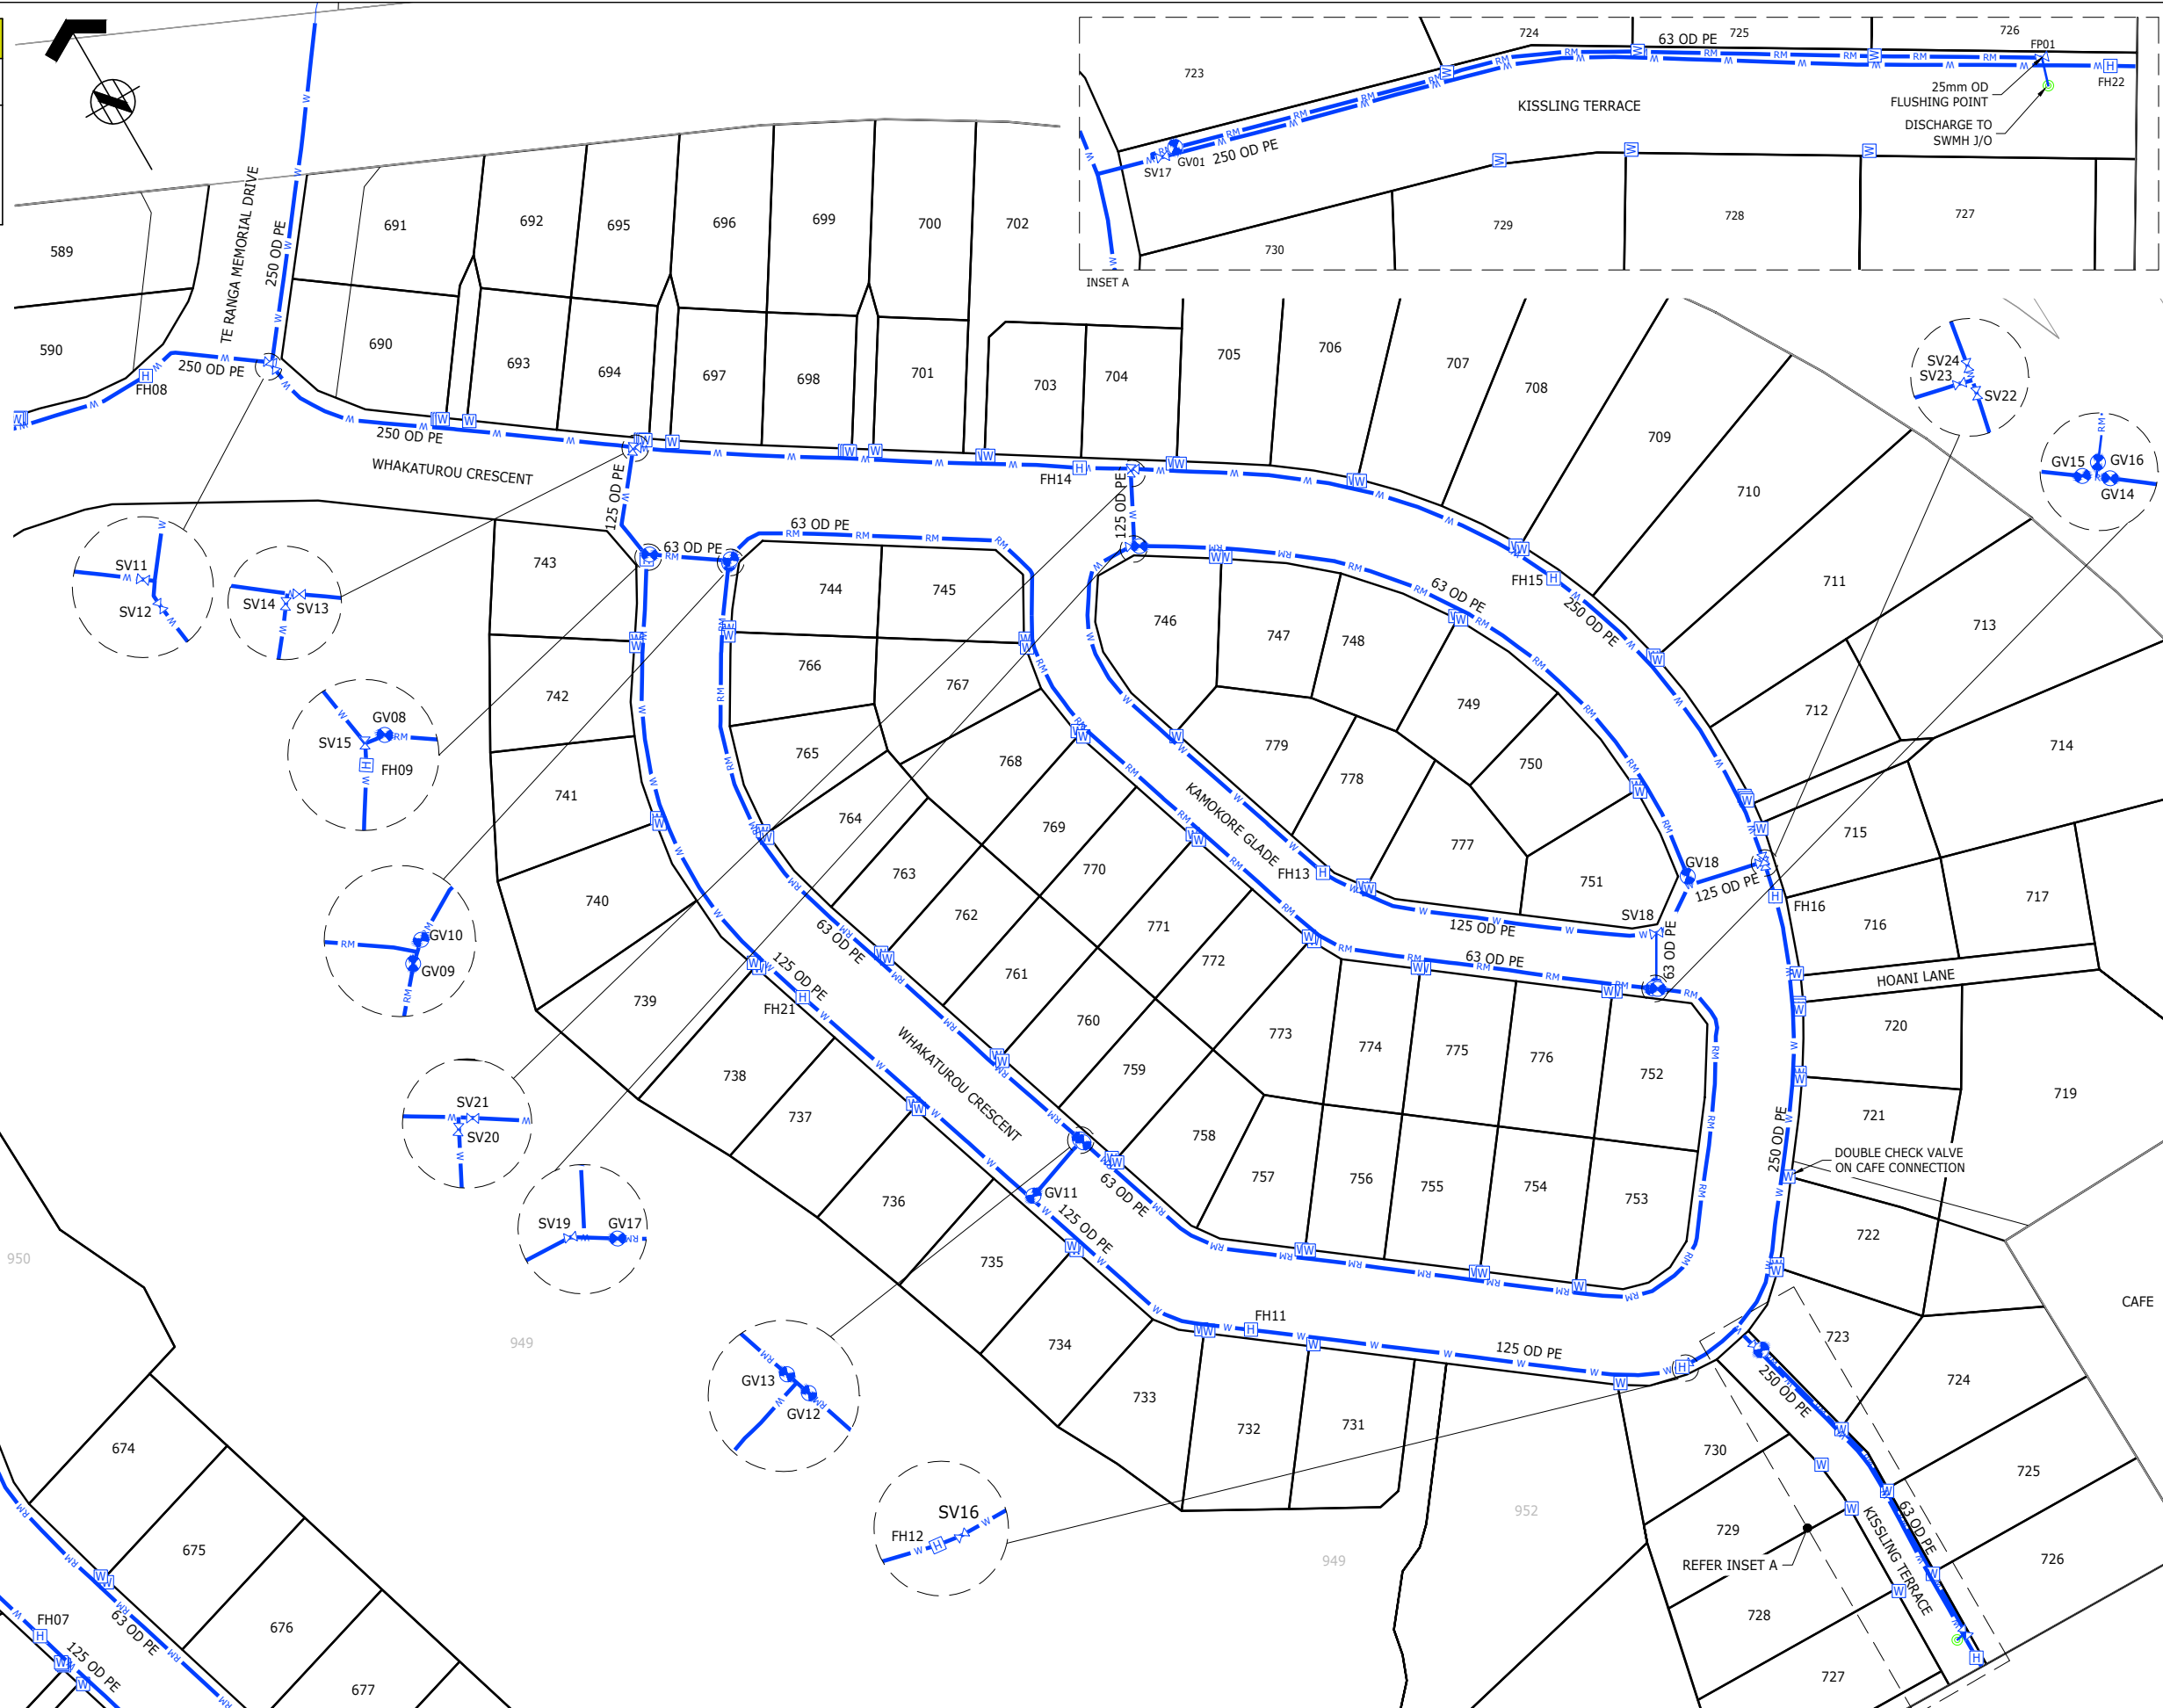

ORIGINATOR: PSJ	DATE: 06.06.18	SIGNED:	TR
DRAWN: PSJ	DATE: 06.06.18	SIGNED:	PSJ
CHECKED: GPR	DATE: 27.06.18	SIGNED:	GPR
APPROVED: GPR	DATE: 27.06.18	SIGNED:	GPR

ASSOCIATION OF CONSULTING ENGINEERS NEW ZEALAND
 ISO 9001 QUALITY ASSURED
 THIS DRAWING AND DESIGN REMAINS THE PROPERTY OF, AND MAY NOT BE REPRODUCED OR ALTERED, WITHOUT THE WRITTEN PERMISSION OF HARRISON GRIERSON CONSULTANTS LIMITED. NO LIABILITY SHALL BE ACCEPTED FOR UNAUTHORISED USE OF THIS DRAWING.

TAURANGA OFFICE
 LEVEL 1, 60 SPRING STREET
 TAURANGA 3110
 T +64 7 578 0023
 W www.harrisongrierson.com

PROJECT: **Summit**
 THE LAKES (2012) LIMITED, TAURANGA

TITLE: **STAGE 3JKL CIVILS**
WATER RETICULATION AS BUILT PLAN
 SHEET 2
 TCC IP 101861

ISSUE STATUS: FINAL AS BUILT	PROJECT No: 1510-141209-01	SCALES: 1:625 - A1 1:1250 - A3	A1
DRAWING No: 141209-AB302	REV: B		