

THIS DRAWING AND DESIGN REMAINS THE PROPERTY OF, AND MAY NOT BE REPRODUCED OR ALTERED, WITHOUT THE WRITTEN PERMISSION OF HARRISON GRIERSON CONSULTANTS LIMITED. NO LIABILITY SHALL BE ACCEPTED FOR UNAUTHORISED USE OF THIS DRAWING.

NOTES:

- LEVELS ARE IN TERMS OF THE MOTURIKI DATUM.
- ORIGIN OF LEVELS TCC BENCHMARK BM 1070 RL 55.865m.
- METHOD OF SURVEY: GPS
- ALL WORKS WERE CARRIED OUT TO TCC IDC 2011 STANDARDS.
- ALL RIDERMAINS ARE 63 OD PE UNLESS OTHERWISE SPECIFIED.
- ALL PVC PIPE WATERMAINS ARE PVC PN9 PIPE.
- REFER TO TABLE FOR PE PIPE DETAILS
- WHERE MULTIPLE WATER METERS ARE BANKED AT THE BOUNDARY 2 OR 3 WATER METERS HAVE BEEN PLACED IN EACH BOX.
- NO VALVES OR HYDRANTS ARE LOCATED IN THE CARRIAGEWAY.
- ALL WATER METERS HAVE BEEN INSTALLED WITHIN THE ROAD RESERVE.
- ALL BURIED AS BUILT INFORMATION SUPPLIED BY HIGGINS CONTRACTORS LTD.

LEGEND:

- AS BUILT WATER MAIN
- AS BUILT RIDER MAIN
- EXISTING WATER
- AS BUILT WATER CONNECTION
- AS BUILT HYDRANT
- AS BUILT SLUICE VALVE
- AS BUILT GATE VALVE
- AS BUILT WATER METER
- EXISTING HYDRANT
- EXISTING SLUICE VALVE
- EXISTING GATE VALVE

HG TAURANGA OFFICE
LEVEL 1, 60 SPRING STREET
TAURANGA 3110
T +64 7 578 0023
W www.harrisongrierson.com

B	AS BUILT FINAL	TR	22.02.17
A	AS BUILT DRAFT	TR	08.02.17
REF	REVISIONS	BY	DATE

Summit
THE LAKES (2012) LTD.


TITLE:
STAGES 3GH
WATER RETICULATION AS BUILT PLAN
SHEET 1
TCC IP 101696

ORIGINATOR:	DATE:	SIGNED:	PLOT BY:
TRS	08.02.17		TRS
DRAWN:	DATE:	SIGNED:	PLOT DATE:
TRS	08.02.17		22.02.17
CHECKED:	DATE:	SIGNED:	SURVEY BY:
TCH	22.02.17		
APPROVED:	DATE:	SIGNED:	SURVEY DATE:
GPR	22.02.17		

ISSUE STATUS: **AS BUILT**

PROJECT No:	SCALES:	A1
1500-138804-01	1:500 - A1 1:1000 - A3	

DRAWING No: **138804-AB311** REV **B**

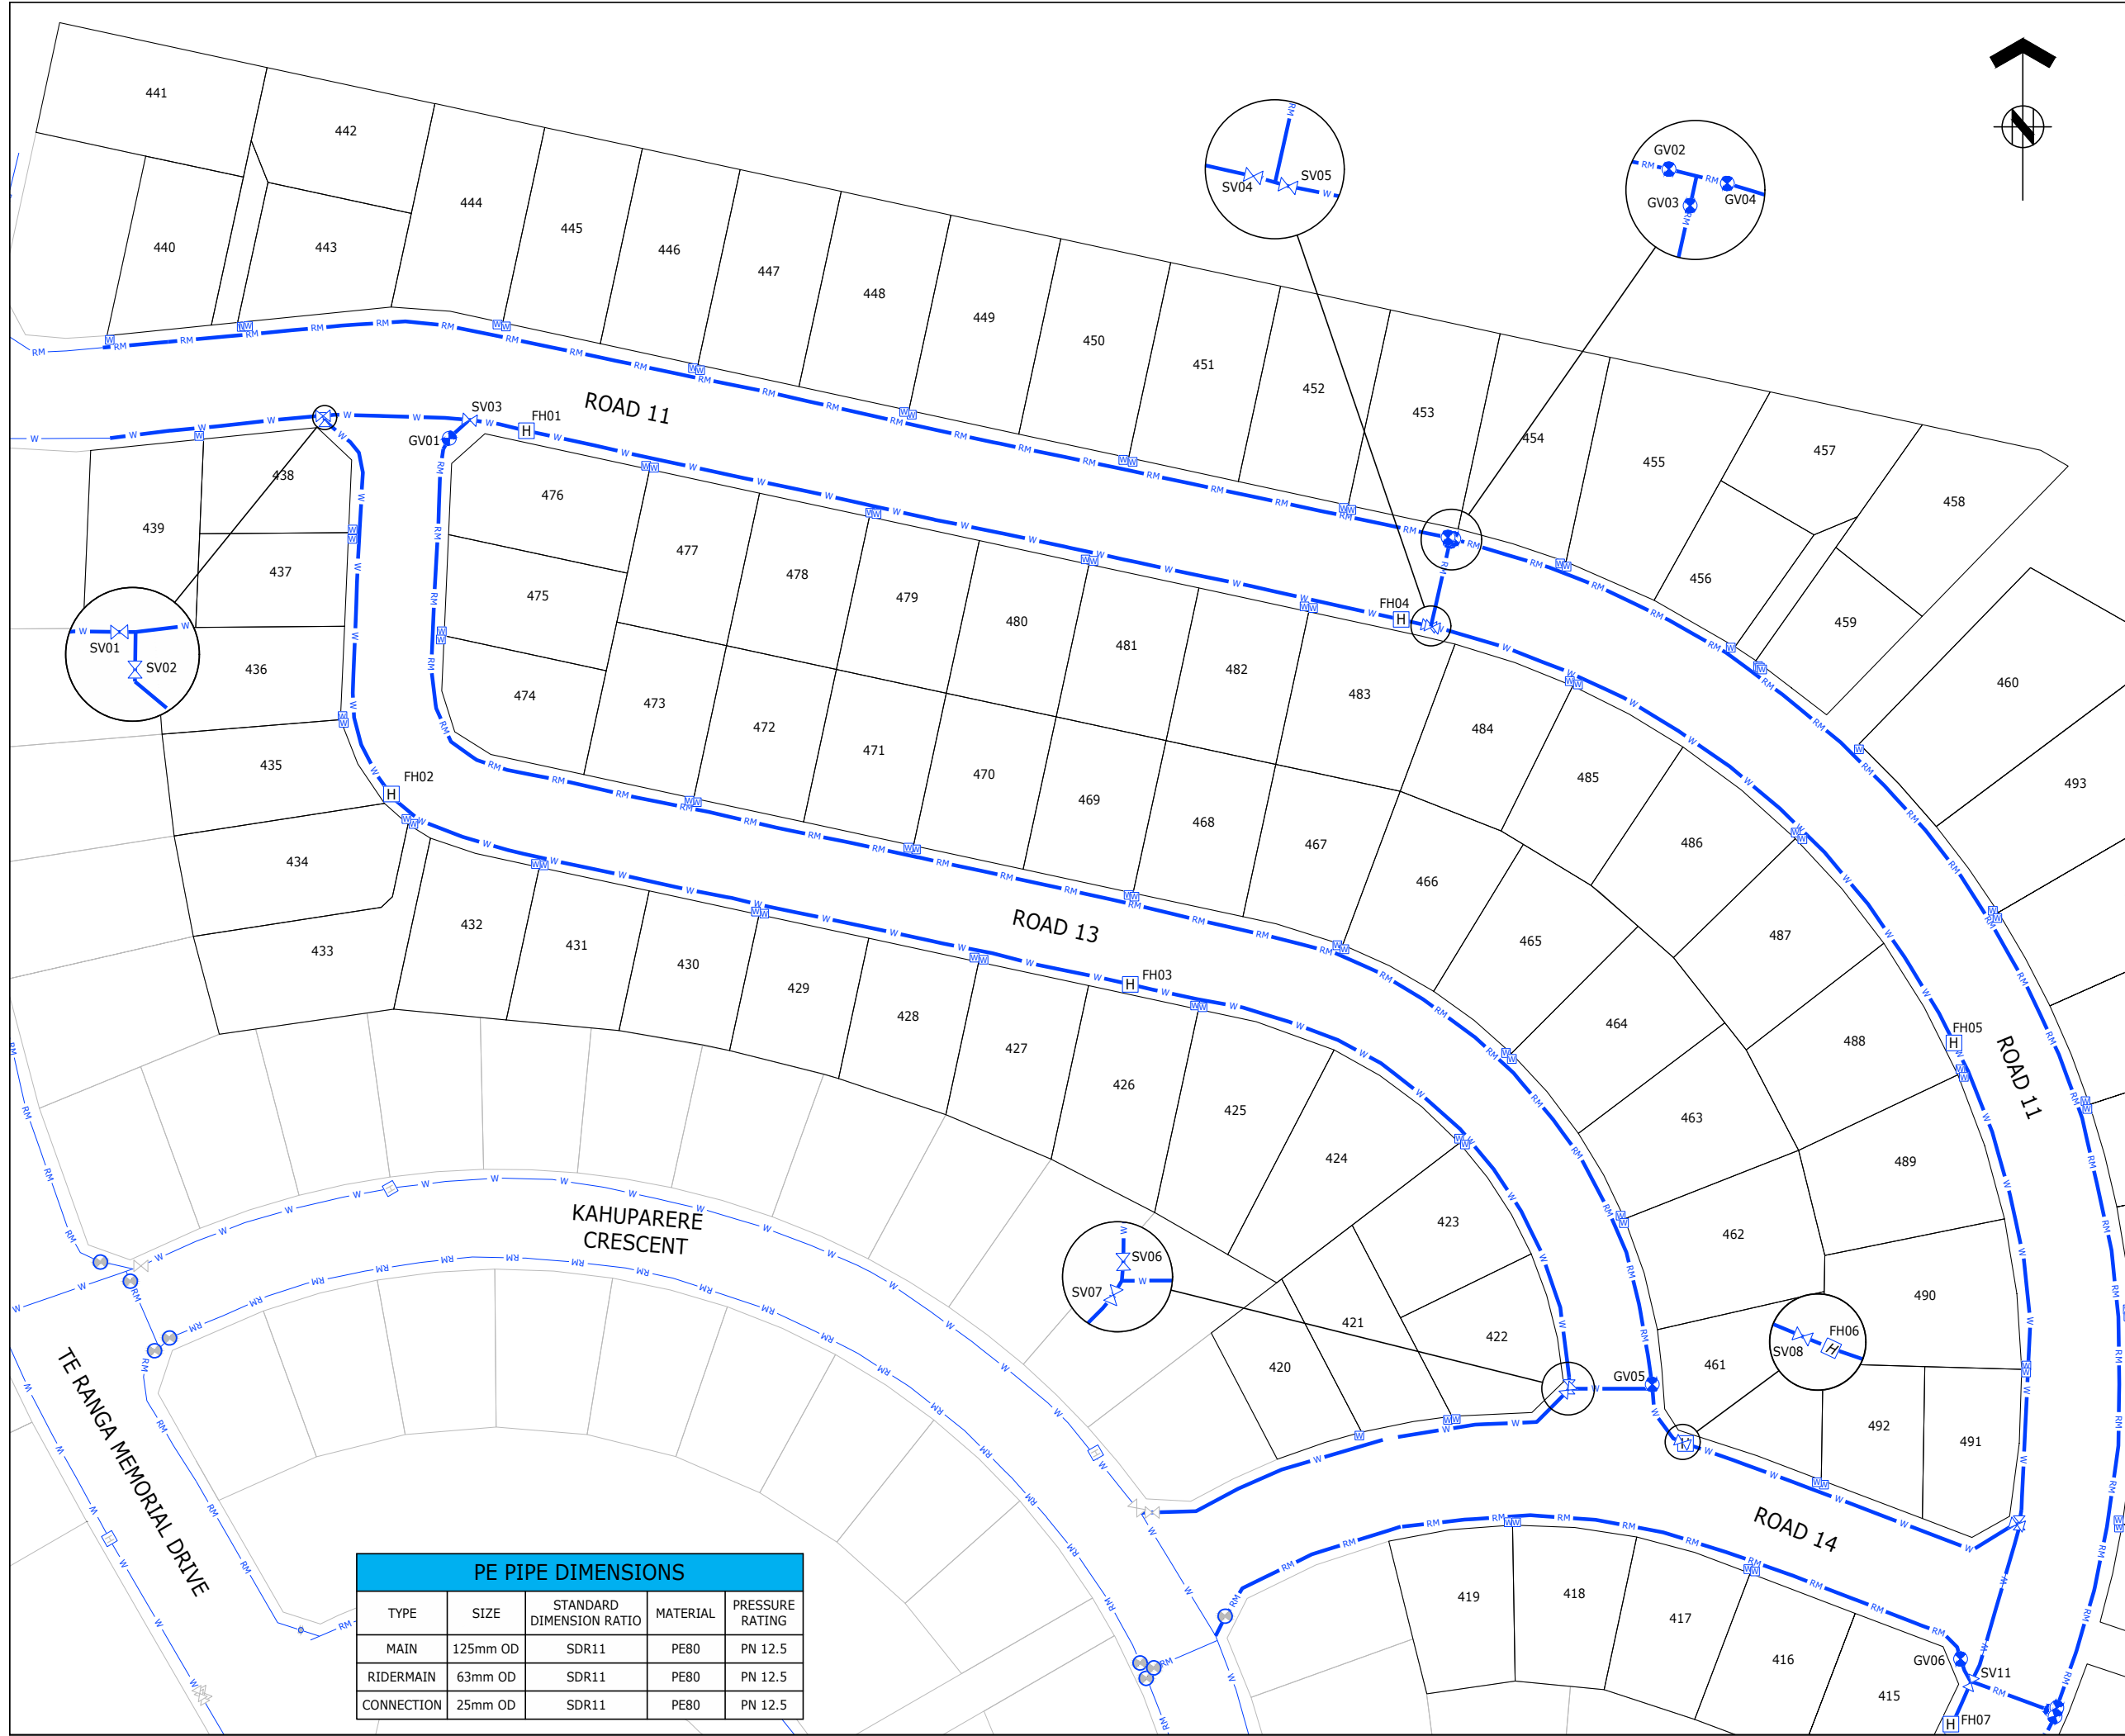

PE PIPE DIMENSIONS				
TYPE	SIZE	STANDARD DIMENSION RATIO	MATERIAL	PRESSURE RATING
MAIN	125mm OD	SDR11	PE80	PN 12.5
RIDERMAIN	63mm OD	SDR11	PE80	PN 12.5
CONNECTION	25mm OD	SDR11	PE80	PN 12.5