


A DAM 2 CROSS SECTION
 AB411 SCALE 1:125 - A1
 1:250 - A3

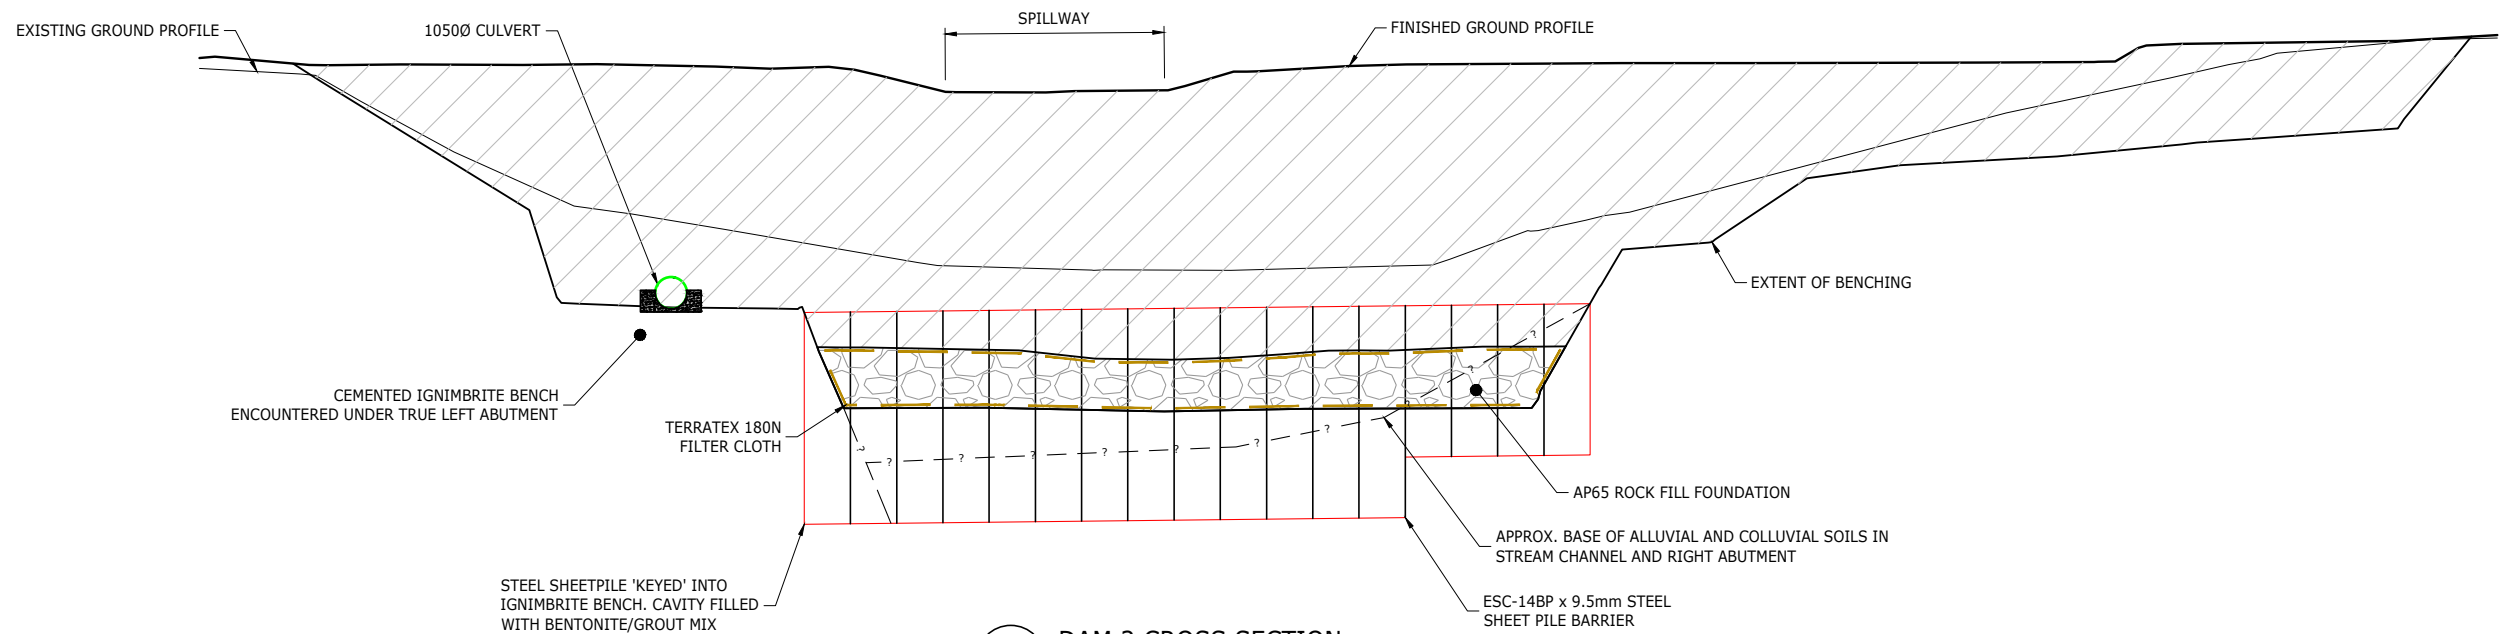

B DAM 2 CROSS SECTION
 AB411 SCALE 1:125 - A1
 1:250 - A3

LEGEND:

- MIRAFI PET 600 WOVEN GEOTEXTILE
- TERRATEX 180N FILTER CLOTH
- SHEET PILING
- SHEET PILING (CROSS SECTION)
- COMPACTED CLAY CORE
- AP65 ROCK FILL FOUNDATION

ORIGINATOR: TRS		DATE: 01.03.17	SIGNED:	PLOT BY: RJM	ASSOCIATION OF CONSULTING ENGINEERS NEW ZEALAND ISO 9001 QUALITY ASSURED	Tauranga Office Level 1, 60 Spring Street Tauranga 3110 T +64 7 578 0023 W www.harrisongrierson.com	PROJECT: THE LAKES (2012) LTD TAURANGA	TITLE: STAGE 3 (ZONE 3) EARTHWORKS DAM 2 AS BUILT CROSS SECTIONS TCC IP101782	ISSUE STATUS: AS BUILT	
DRAWN: TRS		DATE: 01.03.17	SIGNED:	PLOT DATE: 04.05.17					PROJECT No: 1510-137845-01 SCALES: AS SHOWN A1	
CHECKED: RJM		DATE: 4.05.17	SIGNED:	SURVEY BY:	THIS DRAWING AND DESIGN REMAINS THE PROPERTY OF, AND MAY NOT BE REPRODUCED OR ALTERED, WITHOUT THE WRITTEN PERMISSION OF HARRISON GRIERSON CONSULTANTS LIMITED. NO LIABILITY SHALL BE ACCEPTED FOR UNAUTHORISED USE OF THIS DRAWING.	REF REVISIONS	DRAWING No: 137845-AB421		REV 2	
APPROVED: GPR		DATE: 01.03.17	SIGNED:	SURVEY DATE:						