




B
 AB411
 LOW PLATFORM PICNIC BENCH TYPE 1
 SCALE 1:50 - A1, 1:100 - A3

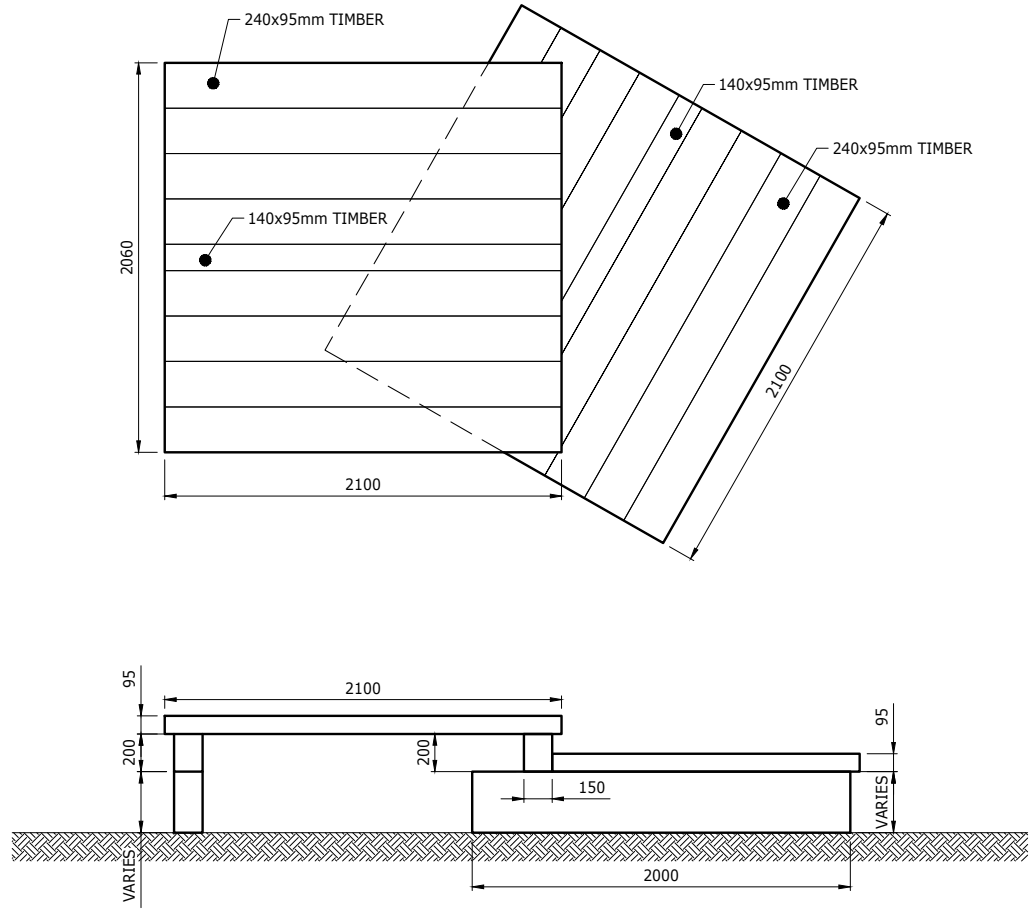

C
 AB411
 LOW PLATFORM PICNIC BENCH TYPE 2
 SCALE 1:50 - A1, 1:100 - A3

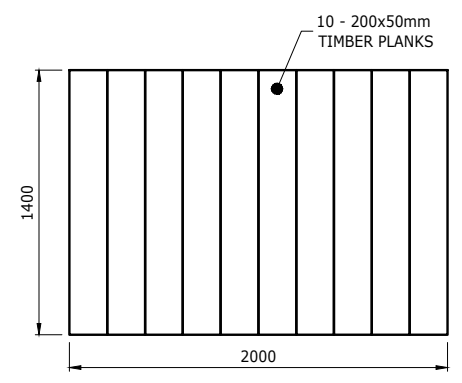

D
 AB411
 PLAYGROUND BRIDGE
 SCALE 1:50 - A1, 1:100 - A3

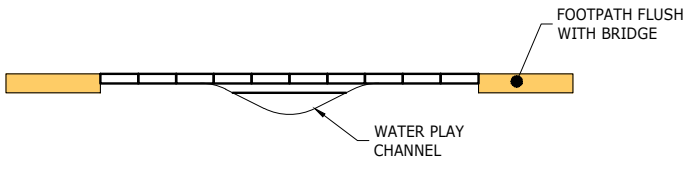

ORIGINATOR: TCH		DATE: 18.01.18	SIGNED:	PLOT BY: TRS	ASSOCIATION OF CONSULTING ENGINEERS NEW ZEALAND ISO 9001 QUALITY ASSURED	TAURANGA OFFICE LEVEL 1, 60 SPRING STREET TAURANGA 3110 T +64 7 578 0023 W www.harrisongrierson.com	PROJECT: Summit THE LAKES (2012) LIMITED	TITLE: STAGE 3I PLAYGROUND AS BUILT DETAILS TCC IP 101782	ISSUE STATUS: FINAL AS BUILT		
DRAWN: TRS		DATE: 18.01.18	SIGNED:	PLOT DATE: 18.01.18					PROJECT No: 1520-139618-01	SCALES: 1:100 - A1 1:200 - A3	A1
CHECKED: TCH		DATE: 18.01.18	SIGNED:	SURVEY BY:					DRAWING No:		REV
APPROVED: GPR		DATE: 18.01.18	SIGNED:	SURVEY DATE:					139618-AB412		A
A	FINAL AS BUILT	TCH	18.01.18	APPROVED:							
REF	REVISIONS	BY	DATE	GPR	18.01.18						