


**STORMWATER LINE C LONGSECTION**  
SCALE 1:125 - A1, 1:250 - A3

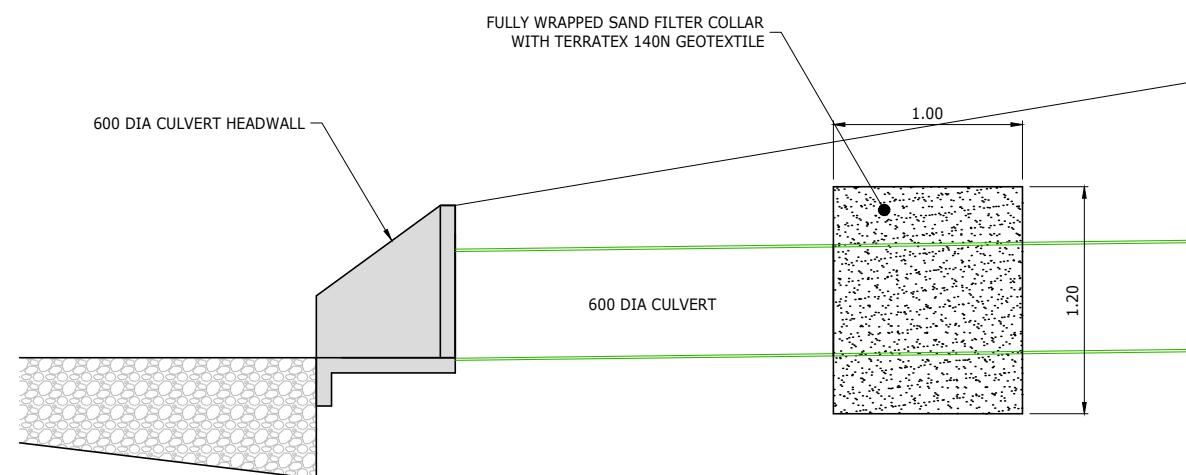

**D FILTER COLLAR DETAIL**  
SCALE 1:20 - A1, 1:40 - A3

ORIGINATOR: TCH		DATE: 18.01.18	SIGNED:	TRIS	ASSOCIATION OF CONSULTING ENGINEERS NEW ZEALAND	ISO 9001 QUALITY ASSURED	TAURANGA OFFICE LEVEL 1, 60 SPRING STREET TAURANGA 3110 T +64 7 578 0023 W www.harrisongrierson.com	<b>Summit</b> THE LAKES (2012) LIMITED	PROJECT: STAGE 3I POND 2 AS BUILT STORMWATER LONG SECTION TCC IP 101782	ISSUE STATUS: FINAL AS BUILT	
DRAWN: TRS		DATE: 18.01.18	SIGNED:	19.01.18	THIS DRAWING AND DESIGN REMAINS THE PROPERTY OF, AND MAY NOT BE REPRODUCED OR ALTERED, WITHOUT THE WRITTEN PERMISSION OF HARRISON GRIERSON CONSULTANTS LIMITED. NO LIABILITY SHALL BE ACCEPTED FOR UNAUTHORISED USE OF THIS DRAWING.					PROJECT No: 1520-139618-01	SCALES: AS SHOWN
C	FINAL AS BUILT	TCH	19.01.18	CHECKED: TCH	DATE: 19.01.18	SIGNED:				DRAWING No: 135952-AB411	
B	FINAL AS BUILT	TCH	19.01.18	CHECKED: TCH	DATE: 19.01.18	SIGNED:				REV	
A	DRAFT AS BUILT	TCH	18.01.18	APPROVED: GPR	DATE: 19.01.18	SIGNED:				C	
REF	REVISIONS	BY	DATE	GPR	19.01.18						