




**STEPS CROSS SECTION**  
SCALE 1:10 - A1, 1:20 - A3

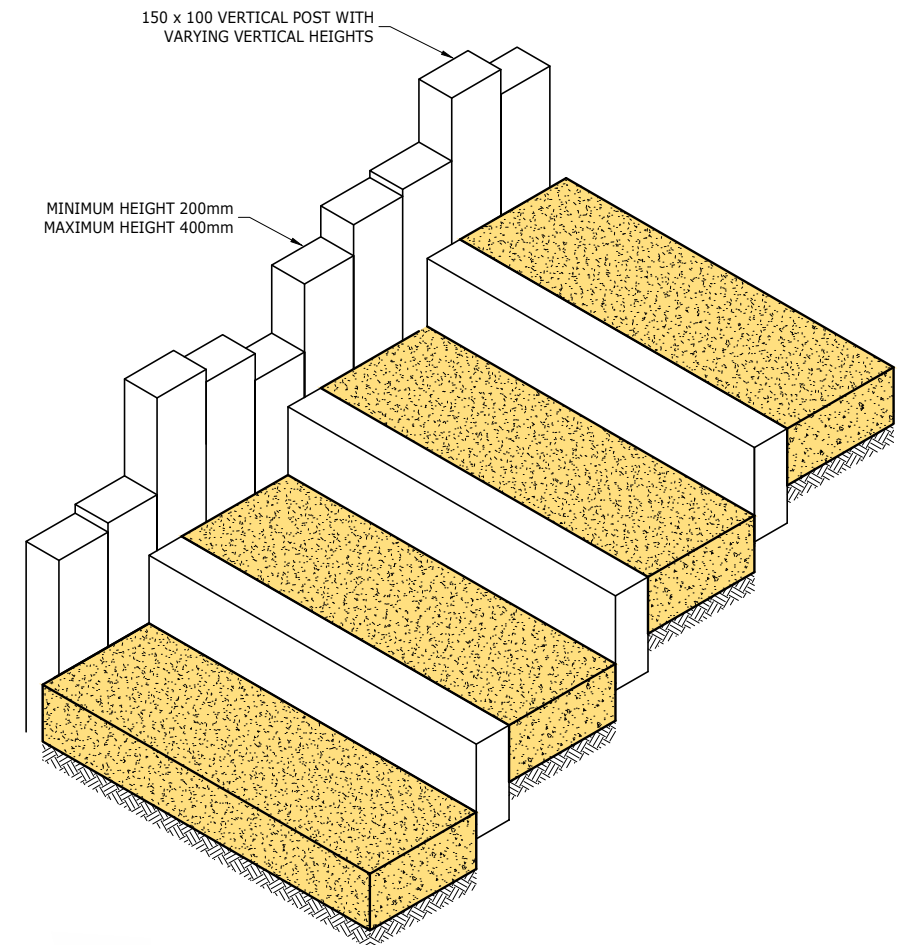

**STEPS ISOMETRIC PLAN**  
SCALE 1:10 - A1, 1:20 - A3

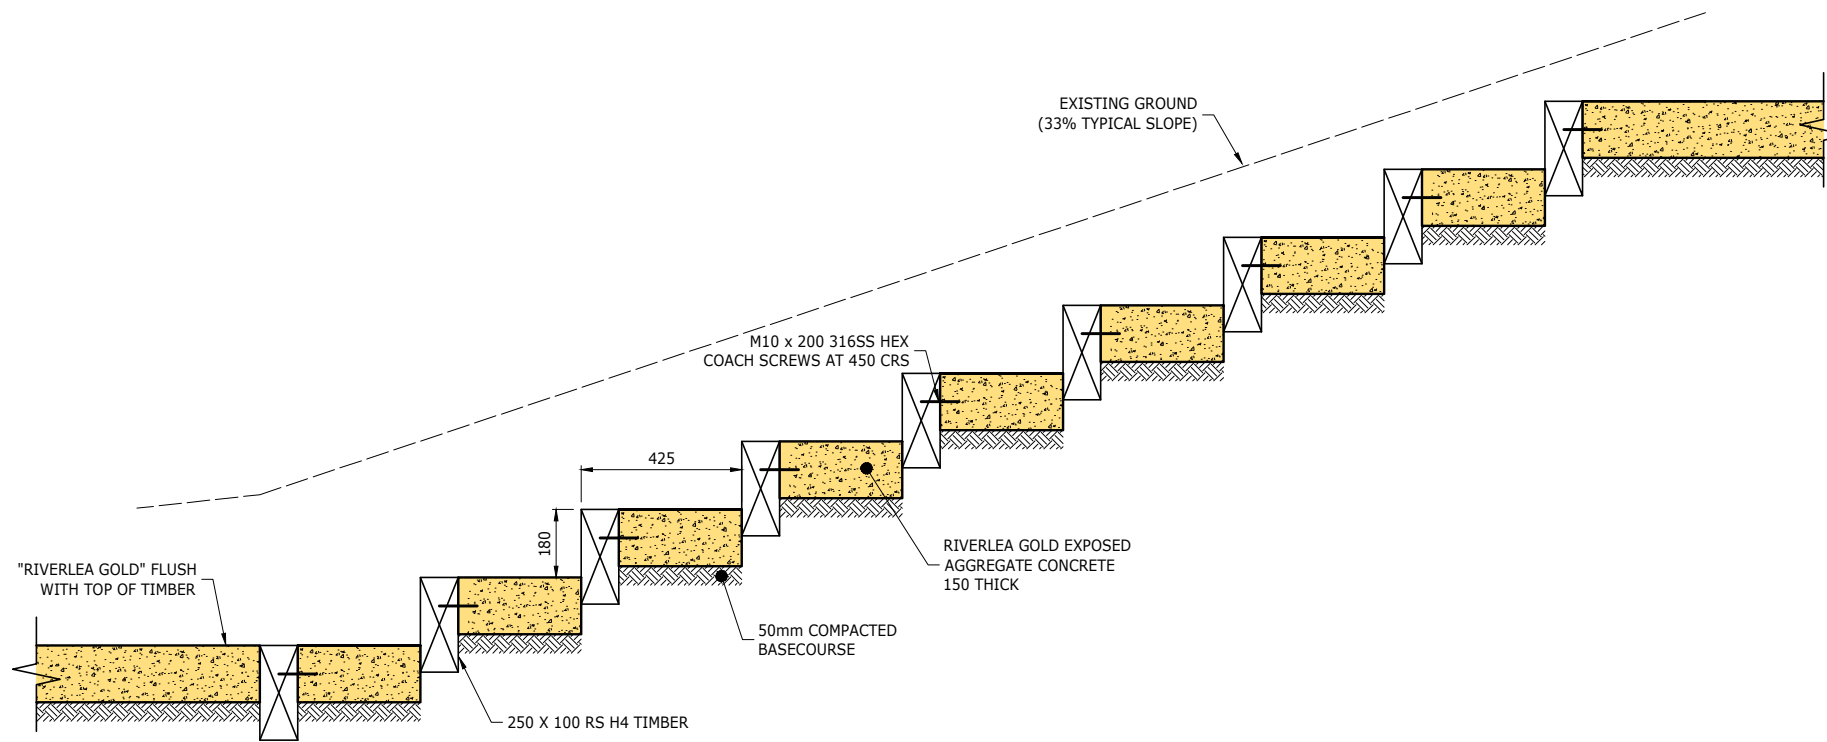

**STEPS ELEVATION 1**  
SCALE 1:10 - A1, 1:20 - A3

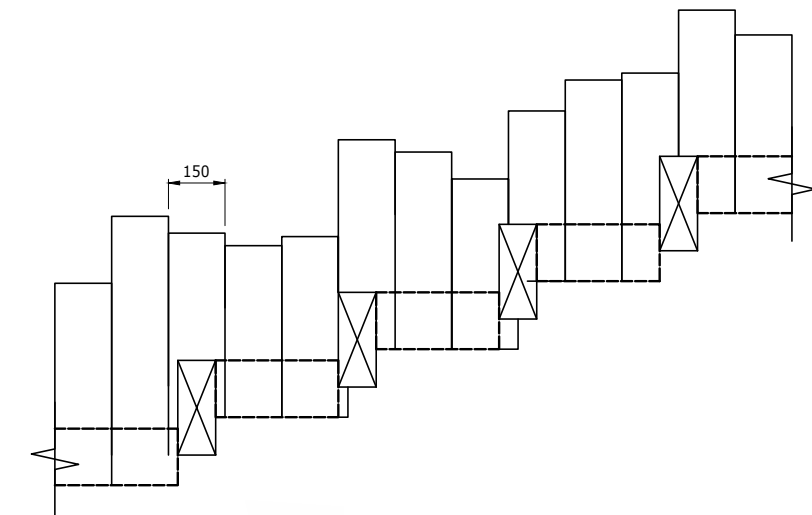

**STEPS ELEVATION 2**  
SCALE 1:10 - A1, 1:20 - A3

**NOTES:**

1. ALL TIMBER H4 TREATED RADIATA PINE ROUGH SAWN
2. ALL FITTINGS ARE GALVANISED STEEL

ORIGINATOR: HEH		DATE: 07.07.17	SIGNED:	HEH	ISO 9001 QUALITY ASSURED	<p>TAURANGA OFFICE LEVEL 1, 60 SPRING STREET TAURANGA 3110 T +64 7 578 0023 W www.harrisingrierson.com</p>	<p>PROJECT: <b>Central</b> THE LAKES (2012) LTD, TAURANGA</p>	<p>TITLE: <b>STAGES 2UV CIVILS</b> LOT 300 STEPS AS BUILT DETAILS TCC IP 25104</p>	ISSUE STATUS: <b>AS BUILT</b>	
DRAWN: HEH		DATE: 07.07.17	SIGNED:	HEH	PROJECT No: 1510-139652-01				SCALES: AS SHOWN	A1
CHECKED: GPR		DATE: 07.07.17	SIGNED:	GPR	<p>THIS DRAWING AND DESIGN REMAINS THE PROPERTY OF, AND MAY NOT BE REPRODUCED OR ALTERED, WITHOUT THE WRITTEN PERMISSION OF HARRISON GRIERSON CONSULTANTS LIMITED. NO LIABILITY SHALL BE ACCEPTED FOR UNAUTHORISED USE OF THIS DRAWING.</p>	DRAWING No: <b>139652-AB621</b>		REV	1	
APPROVED: GPR		DATE: 07.07.17	SIGNED:	GPR		REFER TO APPROVED MASTER DRAWINGS FOR ORIGINAL SIGNATURES File: TAURANGA N:\1510\139652_A 2UV CIVILS\CAD\AS BUILT\139652-01-AB621.DWG				
1	FINAL AS BUILT	GPR	07.07.17							
REF	REVISIONS	BY	DATE							