


**NOTES:**


- LEVELS ARE IN TERMS OF THE MOTURIKI DATUM.
- ORIGIN OF LEVELS TCC BENCHMARK BM 1021 RL 12.515m.
- METHOD OF SURVEY: GPS
- ALL WORKS HAVE BEEN CARRIED OUT TO TCC IDC 2011 STANDARDS.
- STANDARD ROAD RESERVE FOOTPATHS ARE 1.5m WIDE 'RIVERLEA GOLD' EXPOSED AGGREGATE CONCRETE.
- ALL VEHICLE/PEDESTRIAN LETDOWNS AND PATH STUBS WITHIN ROAD RESERVE ARE 'RIVERLEA GOLD' EXPOSED AGGREGATE CONCRETE.
- ALL CONCRETE RIGHT OF WAYS ARE 'HALF BLACK' EXPOSED AGGREGATE.
- COUNCIL BENCHMARKS HAVE BEEN SUPPLIED BY TCC. FINAL LOCATIONS HAVE BEEN CONFIRMED ON SITE BY SURVEYOR.

**LEGEND:**

- 'HALF BLACK' EXPOSED AGGREGATE CONCRETE
- 'RIVERLEA GOLD' EXPOSED AGGREGATE CONCRETE
- BERM/RESERVE GRASS
- SUBSOIL DRAIN
- 500-1000mm BOULDER

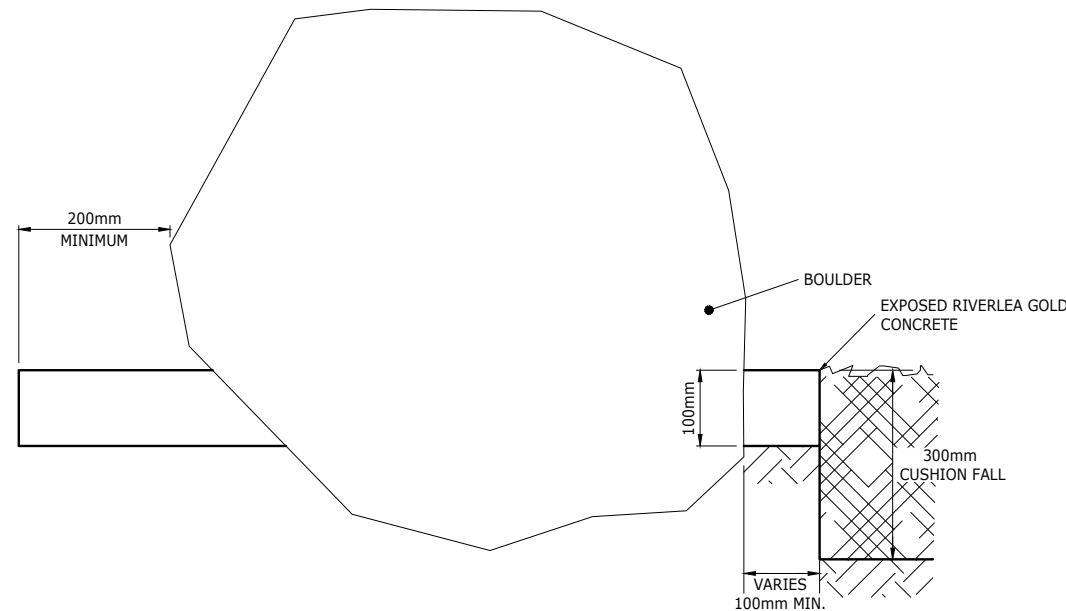

**A** PLAYGROUND BOUNDARY CROSS SECTION  
SCALE 1:5 - A1, 1:10 - A3

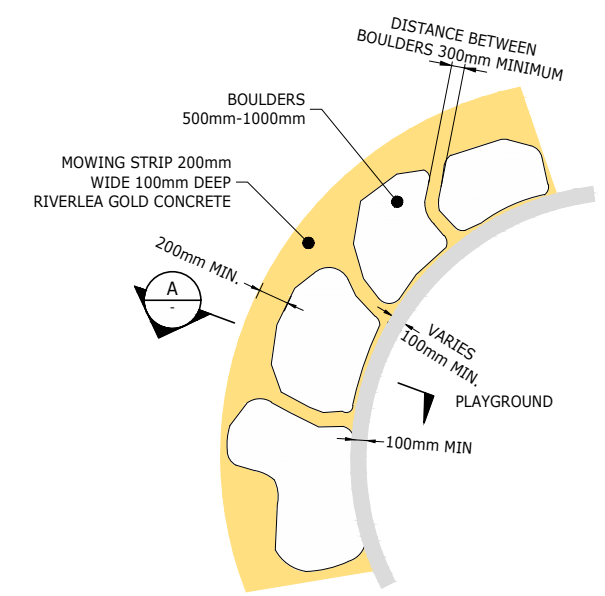

PLAYGROUND BOUNDARY DETAIL  
SCALE 1:50 - A1, 1:100 - A3

ORIGINATOR: HEH		DATE: 07.07.17	SIGNED:	PLOT BY: HEH	DATE: 07.07.17	ASSOCIATION OF CONSULTING ENGINEERS NEW ZEALAND Tauranga Office Level 1, 60 Spring Street Tauranga 3110 T +64 7 578 0023 W www.harrisongrierson.com	ISO 9001 QUALITY ASSURED	<b>Central</b> THE LAKES (2012) LTD, TAURANGA	PROJECT: STAGE 2UV LOT 303 PLAYGROUND AS BUILT PLAN TCC IP 25104	ISSUE STATUS: AS BUILT		
DRAWN: TRS		DATE: 07.07.17	SIGNED:	PLOT DATE: 07.07.17	PROJECT No: 1510-139652-01					SCALES: 1:500 - A1 1:1000 - A3	A1	
CHECKED: GPR		DATE: 07.07.17	SIGNED:	SURVEY BY:	DRAWING No: 139652-AB411					REV	1	
1	FINAL AS BUILT	TRR	07.07.17	APPROVED: GPR	DATE: 07.07.17					SIGNED:	SURVEY DATE:	