



**NOTES:**

- TIMBER TREATMENT:  
 POSTS & OTHER TIMBER IN CONTACT WITH GROUND H5  
 ALL FENCE MEMBERS H4  
 TOP RAIL H3.2
- ALL TIMBER RADIATA PINE, UNLESS OTHERWISE NOTED.
- ALL SITE CUTS TREATED WITH METALEX, OR SIMILAR.
- ALL POSTS EMBEDDED IN 20 MPA CONCRETE, 300 DIA, WITH A MINIMUM 100mm CONCRETE IN BASE OF HOLES.
- BATTENS FIXED TO PALINGS WITH SCREWS. ALL OTHER FIXINGS STANDARD FENCE FIXINGS.
- ALL FITTINGS GALVANISED.
- ALL TIMBER ROUGH SAWN.
- NOISE WALL POSTS LINED UP WITH RETAINING WALL POSTS (BOTH AT 1.8m CRS).

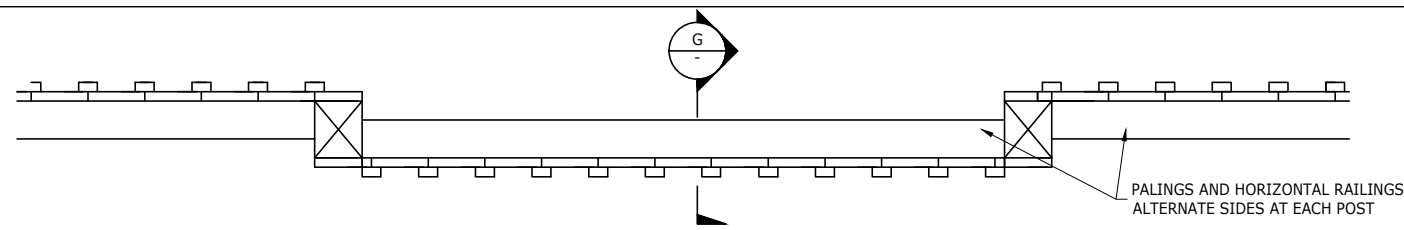


**NOISE WALL TYPICAL PLAN VIEW**

SCALE 1:10 - A1  
1:20 - A3

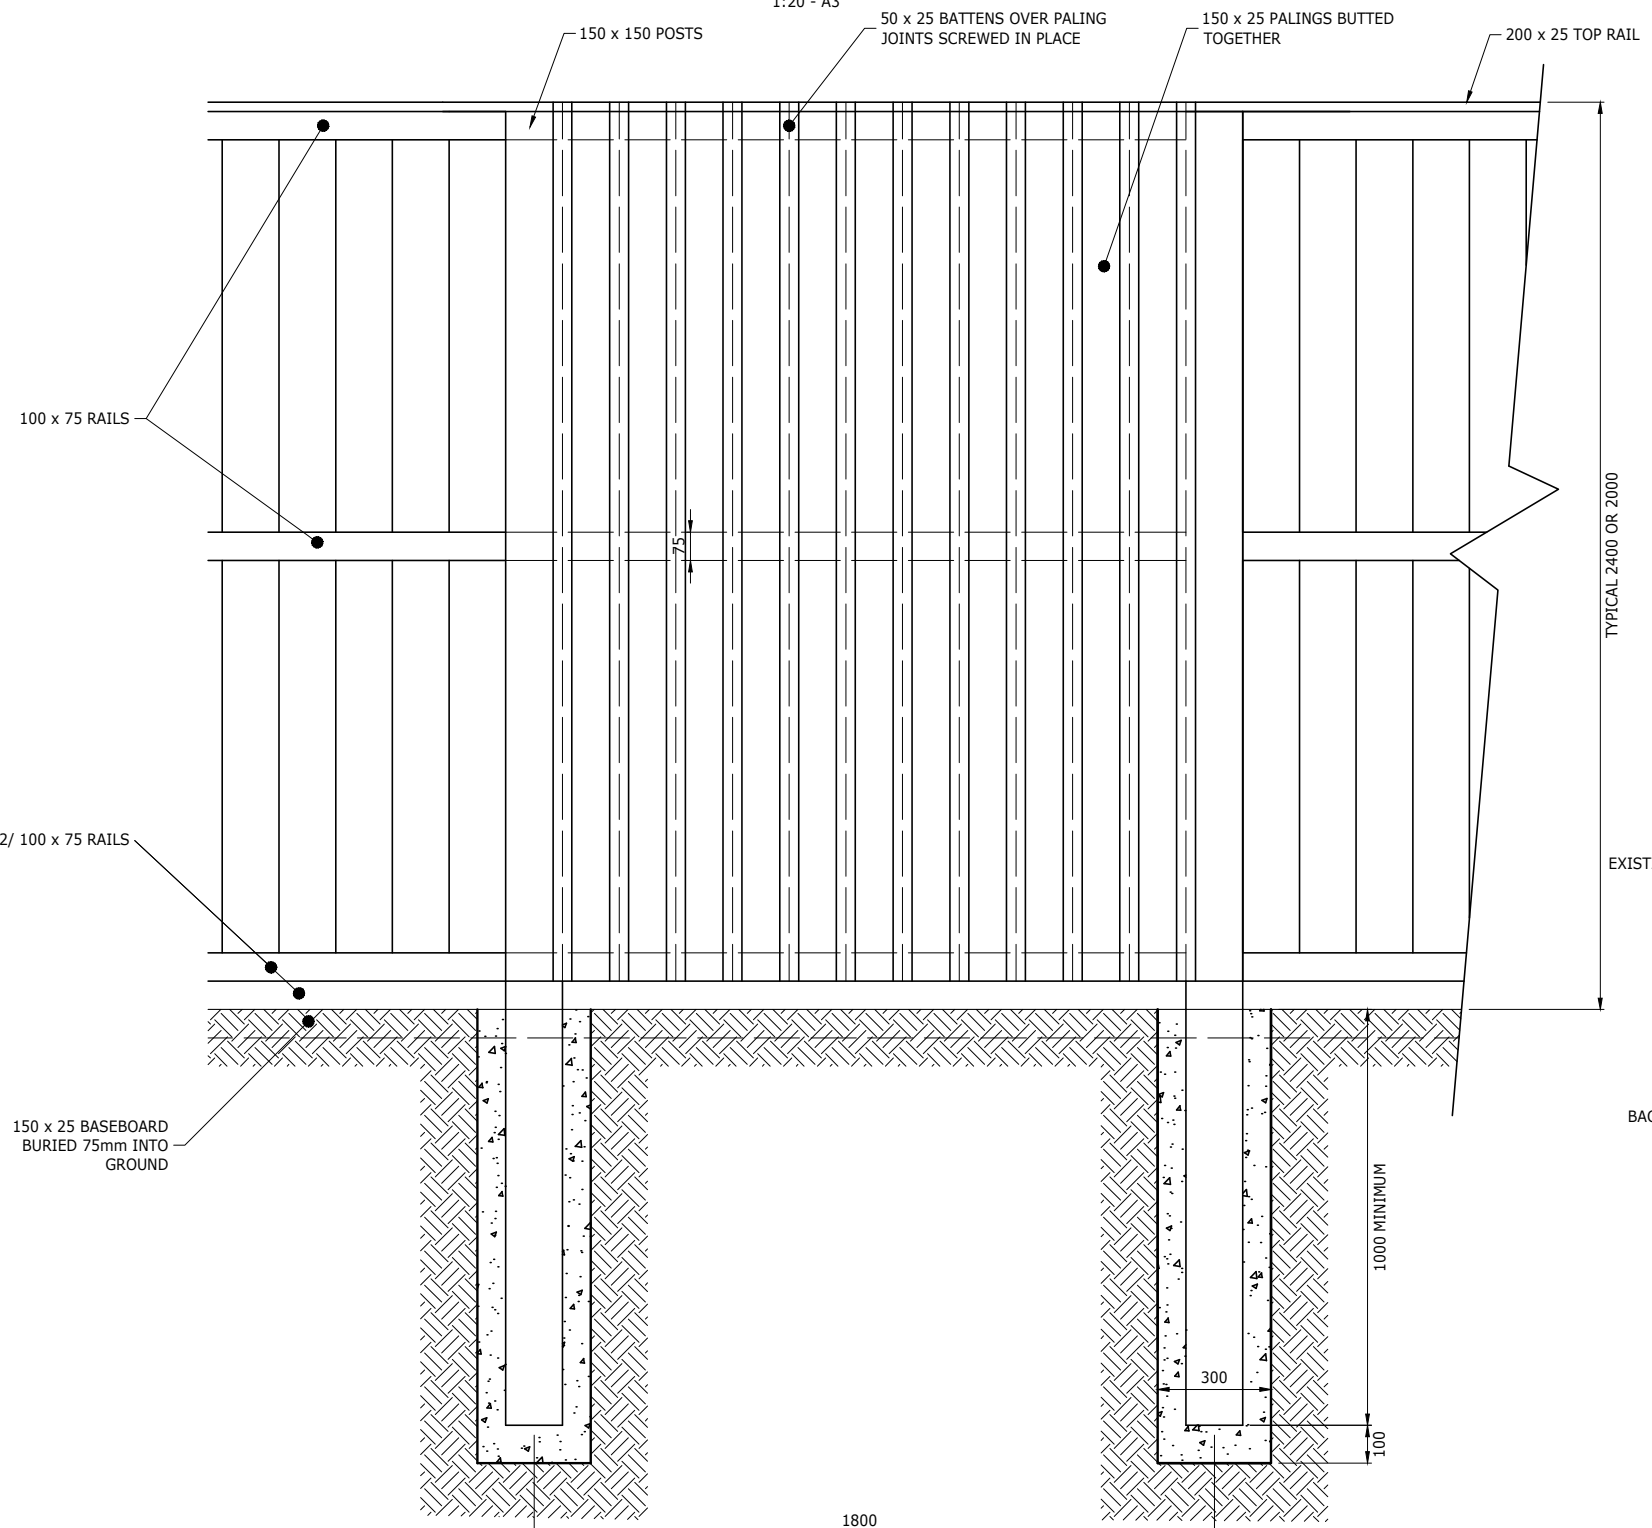

**NOISE WALL TYPICAL ELEVATION**

SCALE 1:10 - A1  
1:20 - A3

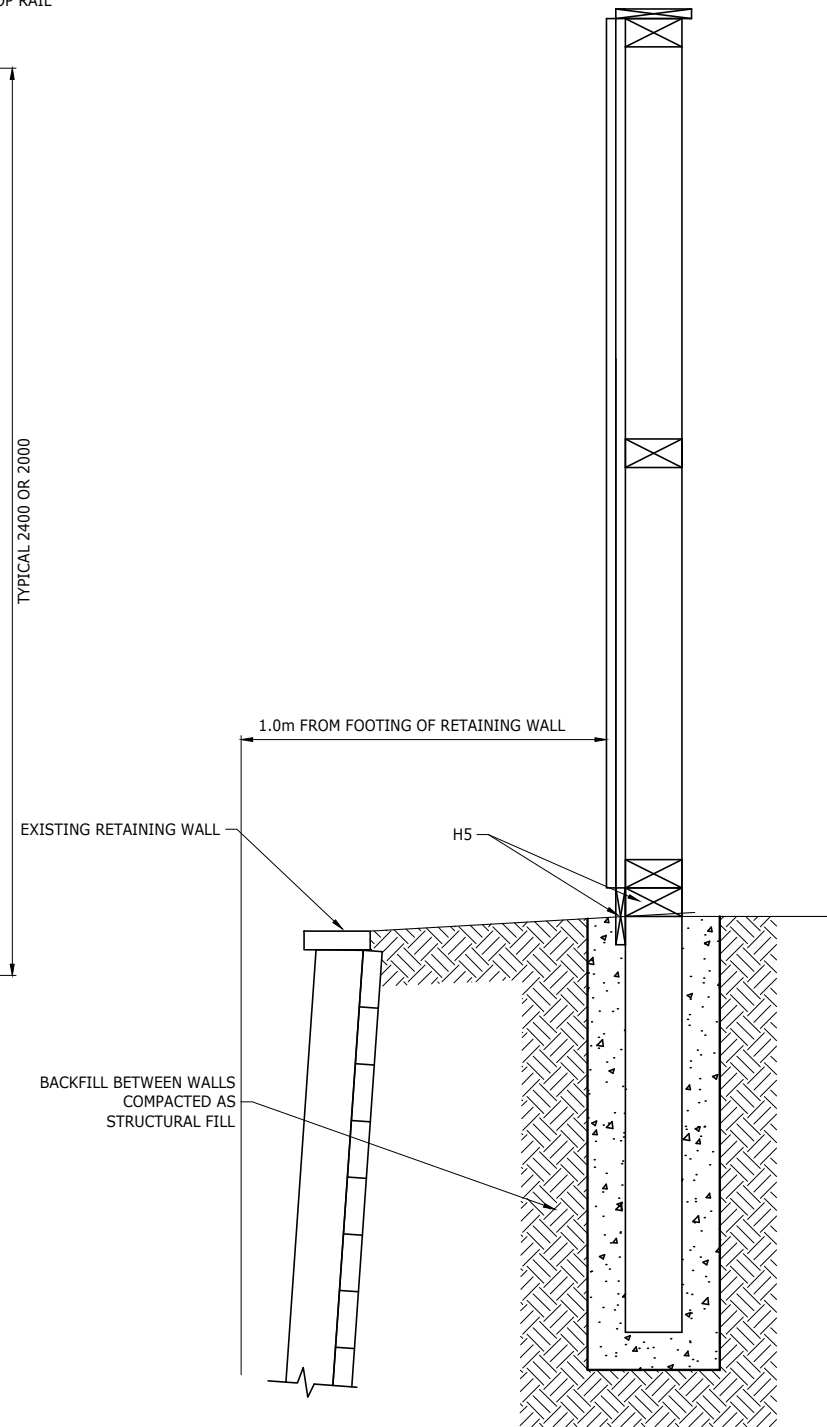

**NOISE WALL TYPICAL CROSS SECTION PANELLING SECTION**

SCALE 1:10 - A1  
1:20 - A3

ORIGINATOR:	HEH	DATE:	07.07.17	SIGNED:		PLOT BY:	HEH
DRAWN:	TRS	DATE:	07.07.17	SIGNED:		PLOT DATE:	07.07.17
CHECKED:	GPR	DATE:	07.07.17	SIGNED:		SURVEY BY:	
APPROVED:	GPR	DATE:	07.07.17	SIGNED:		SURVEY DATE:	
REF	REVISIONS	BY	DATE				

ASSOCIATION OF CONSULTING ENGINEERS NEW ZEALAND  
 ISO 9001 QUALITY ASSURED  
 THIS DRAWING AND DESIGN REMAINS THE PROPERTY OF, AND MAY NOT BE REPRODUCED OR ALTERED, WITHOUT THE WRITTEN PERMISSION OF HARRISON GRIERSON CONSULTANTS LIMITED. NO LIABILITY SHALL BE ACCEPTED FOR UNAUTHORISED USE OF THIS DRAWING.

**HG**  
 TAURANGA OFFICE  
 LEVEL 1, 60 SPRING STREET  
 TAURANGA 3110  
 T +64 7 578 0023  
 W www.harrisongrierson.com

PROJECT: **Central**  
 THE LAKES (2012) LTD, TAURANGA

TITLE: **STAGES 2UV CIVILS AS BUILT NOISE WALL DETAILS TCC IP 25104**

ISSUE STATUS:	AS BUILT	
PROJECT No:	1510-139652-01	SCALE: AS SHOWN
DRAWING No:	139652-AB611	REV 1