


TAKITIMU DRIVE (SH36)

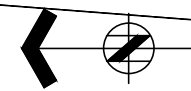

NOTES:

1. LEVELS ARE IN TERMS OF THE MOTURIKI DATUM.
2. ORIGIN OF LEVELS TCC BENCHMARK BM 1021 RL 12.515m.
3. METHOD OF SURVEY: GPS
4. ALL WORKS WERE CARRIED OUT TO TCC IDC 2011 STANDARDS.
5. ALL WASTEWATER MAINS ARE 150mm uPVC PIPES UNLESS SHOWN OTHERWISE.
6. ALL WASTEWATER MAINS ARE SN16 UNLESS SHOWN OTHERWISE.
7. ALL STORMWATER AND WASTEWATER CONNECTIONS ARE 100mm NB uPVC, UNLESS UNDER CARRIAGEWAY WHERE 150mm NB uPVC ARE USED.
8. ALL MANHOLES ARE 1050mm DIA UNLESS OTHERWISE SHOWN.
9. ALL DEEP DRAINAGE CONNECTIONS ARE RAMPED UP TO WITHIN 1.5m OF SURFACE.
10. ALL BURIED AS BUILT INFORMATION SUPPLIED BY HIGGINS CONTRACTORS LTD.

LEGEND:

- AS BUILT WASTEWATER
- EXISTING WASTEWATER
- AS BUILT WASTEWATER CONNECTION
- AS BUILT MANHOLE
- ⊙ EXISTING MANHOLE
- AS BUILT RODDING EYE
- ← FLOW DIRECTION

ORIGINATOR:	HEH	DATE:	19.06.17	SIGNED:		PLOT BY:	HEH
DRAWN:	TRS	DATE:	19.06.17	SIGNED:		PLOT DATE:	07.07.17
CHECKED:	GPR	DATE:	07.07.17	SIGNED:		SURVEY BY:	
APPROVED:	TRS	DATE:	19.06.17	SIGNED:		SURVEY DATE:	
REF	REVISIONS	BY	DATE	GPR			

ASSOCIATION OF CONSULTING ENGINEERS NEW ZEALAND
 ISO 9001 QUALITY ASSURED
 THIS DRAWING AND DESIGN REMAINS THE PROPERTY OF, AND MAY NOT BE REPRODUCED OR ALTERED, WITHOUT THE WRITTEN PERMISSION OF HARRISON GRIERSON CONSULTANTS LIMITED. NO LIABILITY SHALL BE ACCEPTED FOR UNAUTHORISED USE OF THIS DRAWING.



TAURANGA OFFICE
 LEVEL 1, 60 SPRING STREET
 TAURANGA 3110
 T +64 7 578 0023
 W www.harrisongrierson.com

PROJECT: **Central**
 THE LAKES (2012) LTD, TAURANGA

TITLE: STAGE 2UV
 WASTEWATER RETICULATION AS BUILT PLANS
 SHEET 1
 TCC IP 25104

ISSUE STATUS:	AS BUILT	
PROJECT No:	1510-139652-01	SCALES: 1:500 - A1 1:1000 - A3
DRAWING No:	139652-AB201	REV 2