
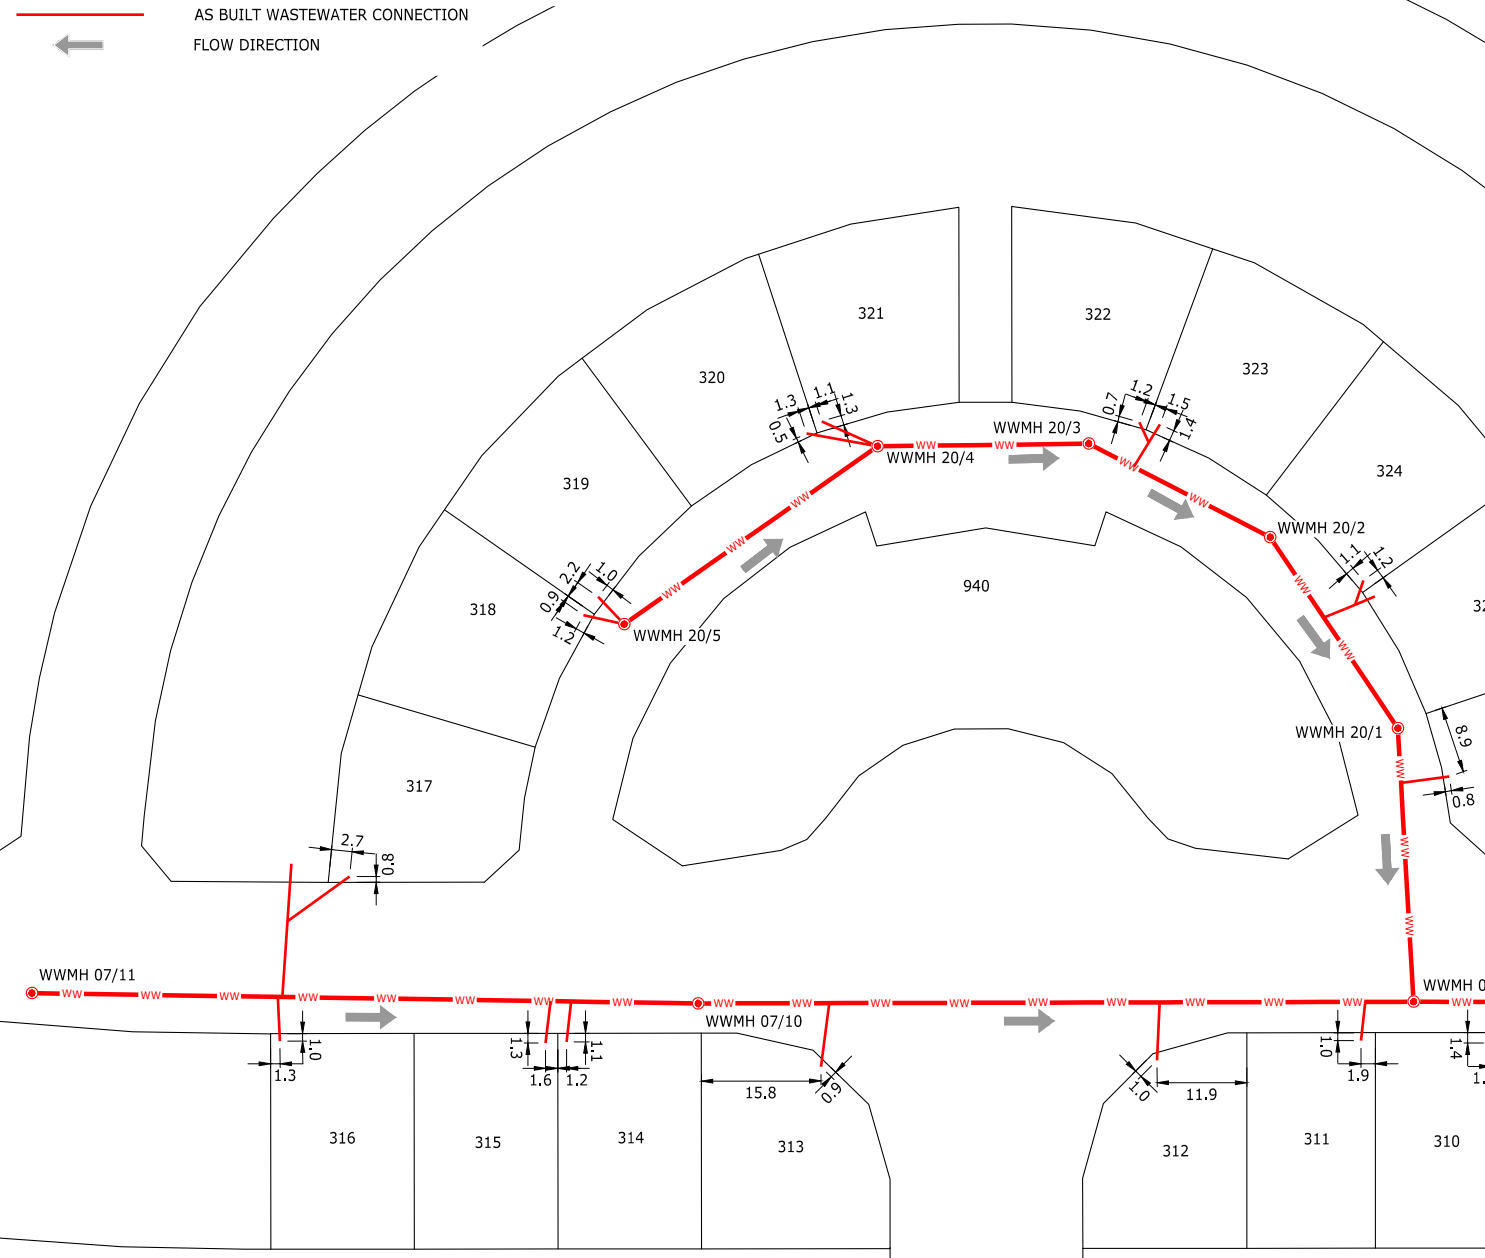
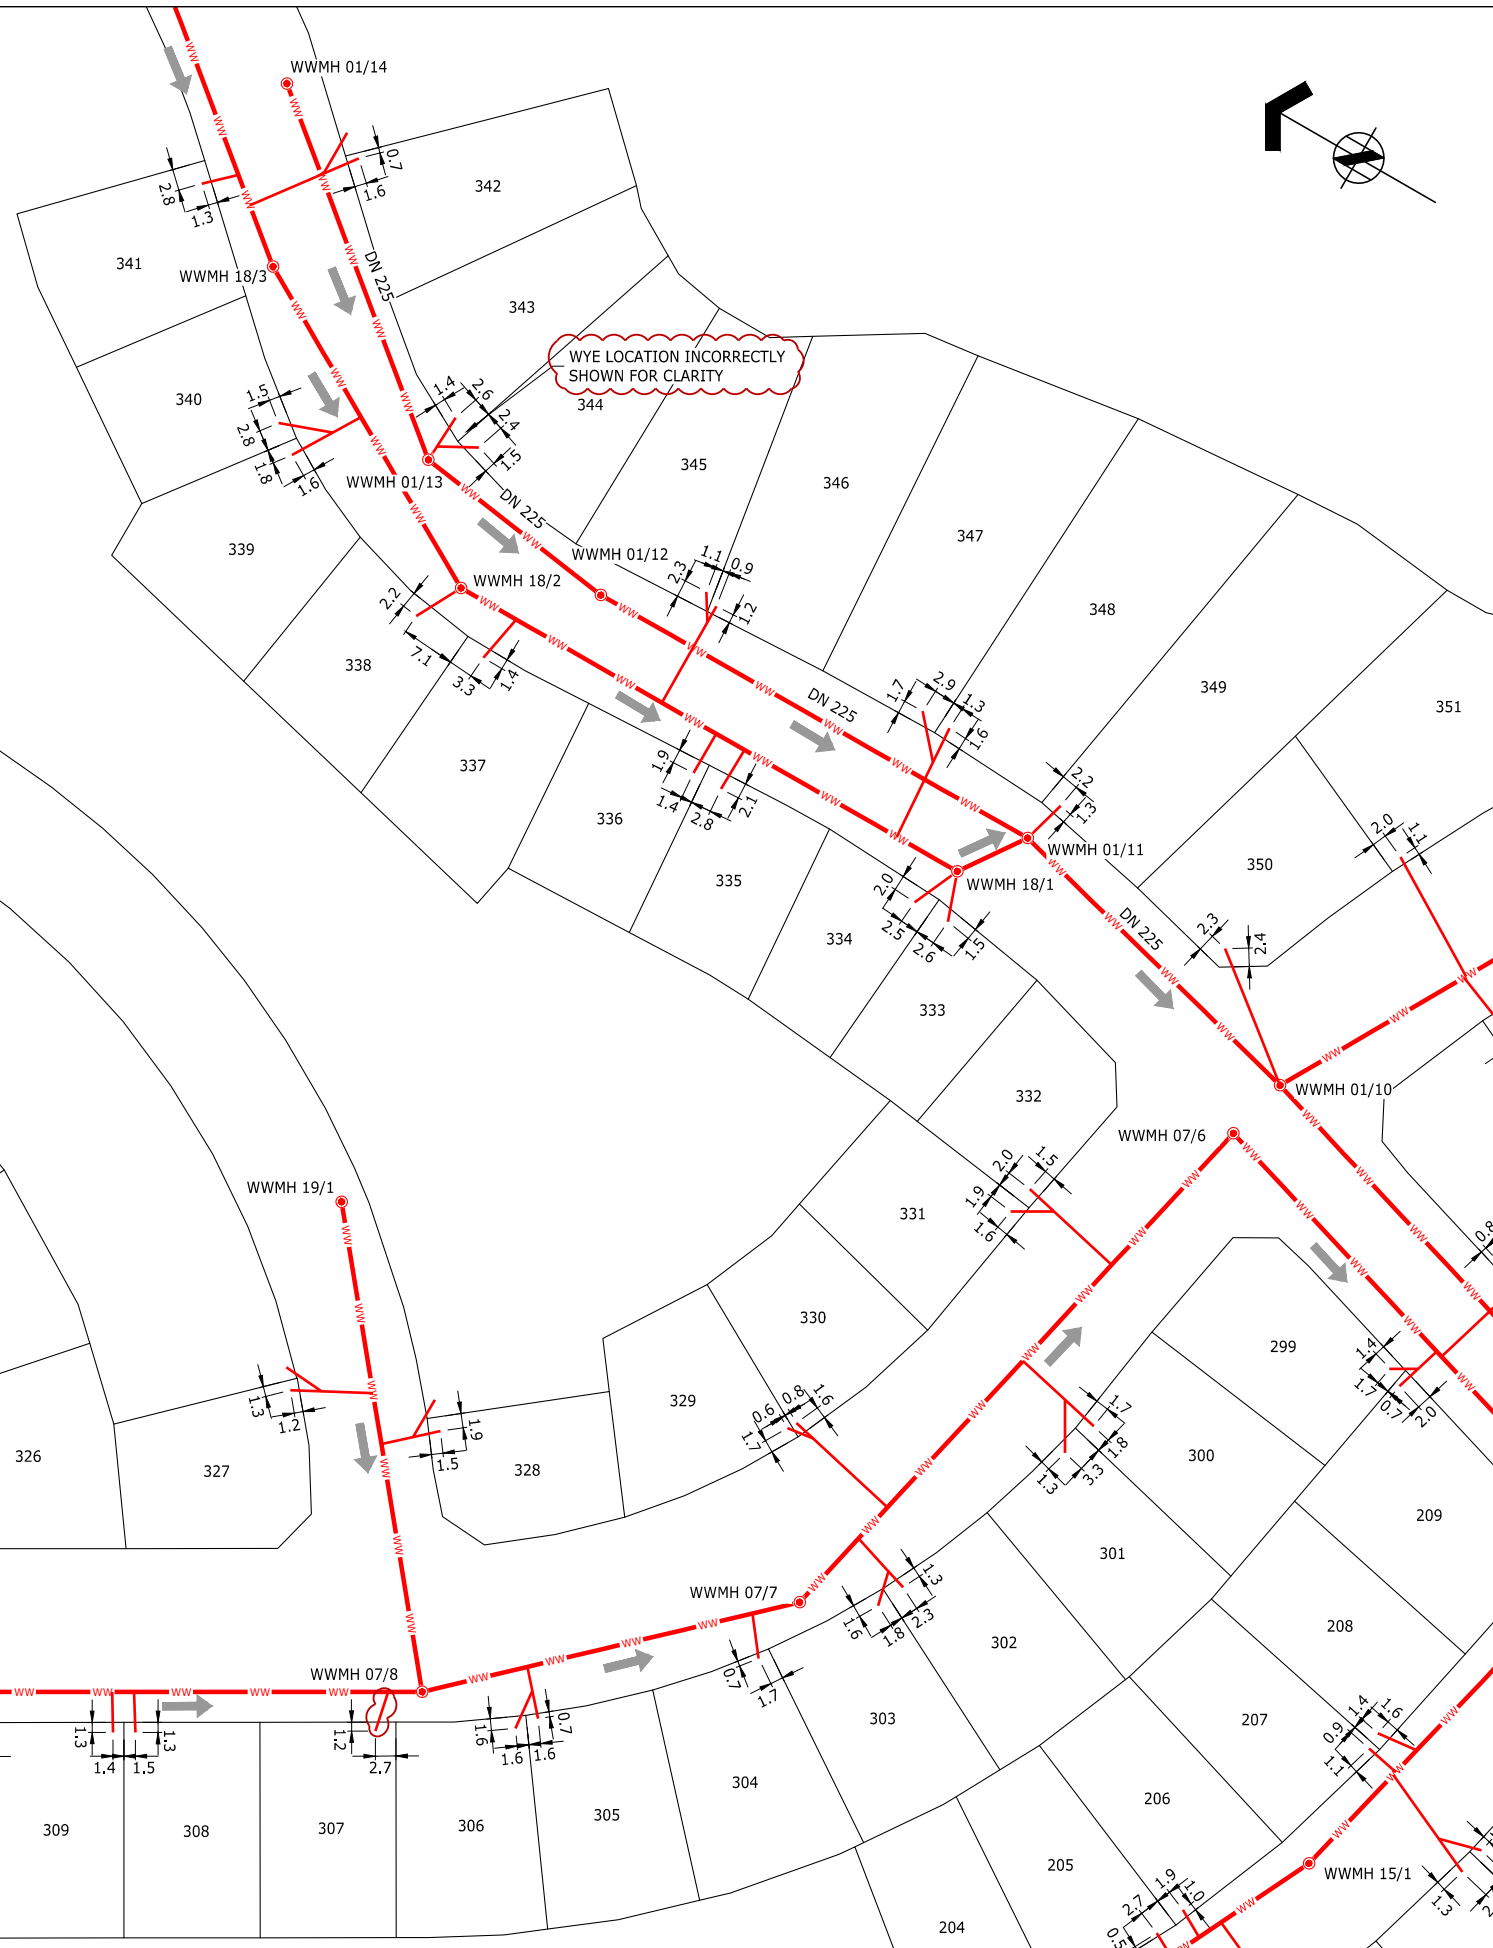


NOTES:

1. LEVELS ARE IN TERMS OF THE MOTURIKI DATUM.
2. ORIGIN OF LEVELS TCC BENCHMARK BM 1069 RL 42.220m.
3. METHOD OF SURVEY: GPS
4. ALL WORKS WERE CARRIED OUT TO TCC IDC 2011 STANDARDS.
5. ALL WASTEWATER MAINS ARE 150mm uPVC PIPES UNLESS SHOWN OTHERWISE.
6. ALL WASTEWATER MAINS ARE SN16 UNLESS SHOWN OTHERWISE.
7. ALL STORMWATER AND WASTEWATER CONNECTIONS ARE 100mm NB uPVC, UNLESS UNDER CARRIAGEWAY WHERE 150mm NB uPVC ARE USED.
8. ALL MANHOLES ARE 1050mm DIA UNLESS OTHERWISE SHOWN.
9. ALL DEEP DRAINAGE CONNECTIONS ARE RAMPED UP TO WITHIN 1.5m OF SURFACE.
10. ALL BURIED AS BUILT INFORMATION SUPPLIED BY HIGGINS CONTRACTORS LTD.

LEGEND:

- AS BUILT MANHOLE
- EXISTING MANHOLE
- AS BUILT RODDING EYE
- AS BUILT WASTEWATER
- - - EXISTING WASTEWATER
- AS BUILT WASTEWATER CONNECTION
- ← FLOW DIRECTION

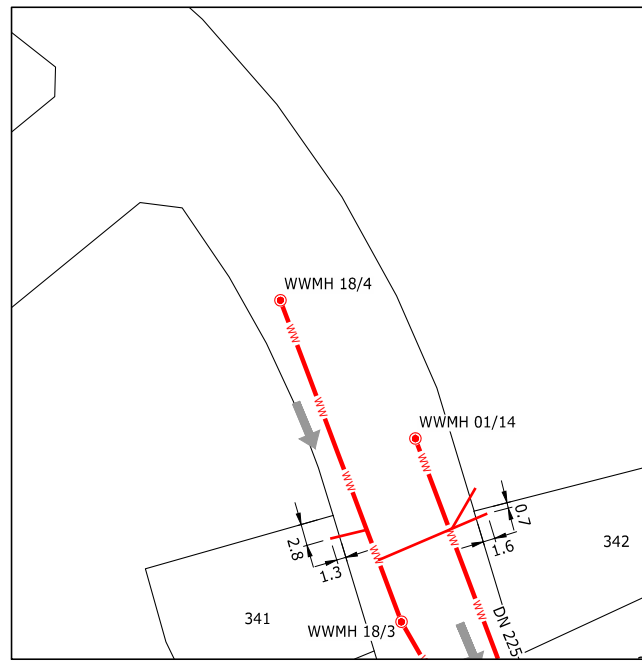

<table border="1"> <tr> <td>ORIGINATOR:</td> <td>RXD</td> <td>DATE:</td> <td>28.04.16</td> <td>SIGNED:</td> <td></td> <td>PLOT BY:</td> <td>HEH</td> </tr> <tr> <td>DRAWN:</td> <td>HEH</td> <td>DATE:</td> <td>28.04.16</td> <td>SIGNED:</td> <td></td> <td>PLOT DATE:</td> <td>23.06.16</td> </tr> </table>		ORIGINATOR:	RXD	DATE:	28.04.16	SIGNED:		PLOT BY:	HEH	DRAWN:	HEH	DATE:	28.04.16	SIGNED:		PLOT DATE:	23.06.16	<p>ASSOCIATION OF CONSULTING ENGINEERS NEW ZEALAND</p> <p>ISO 9001 QUALITY ASSURED</p>	<p>HG</p> <p>TAURANGA OFFICE LEVEL 1 HARRISON GRIERSON HOUSE 141 CAMERON ROAD TAURANGA 3110 T +64 7 578 0023 W www.harrisongrierson.com</p>	<p>PROJECT:</p> <p>Summit</p> <p>THE LAKES (2012) LIMITED, TAURANGA</p>	<p>TITLE:</p> <p>STAGES 3CD WASTEWATER RETICULATION AS BUILT PLAN SHEET 1 TCC IP 101665</p>	<p>ISSUE STATUS:</p> <p>AS BUILT</p> <table border="1"> <tr> <td>PROJECT No:</td> <td>1520-137966-01</td> <td>SCALES:</td> <td>1:500 - A1 1:1000 - A3</td> <td>A1</td> </tr> <tr> <td>DRAWING No:</td> <td>137966-AB201</td> <td></td> <td></td> <td>REV</td> </tr> <tr> <td></td> <td></td> <td></td> <td></td> <td>D</td> </tr> </table>	PROJECT No:	1520-137966-01	SCALES:	1:500 - A1 1:1000 - A3	A1	DRAWING No:	137966-AB201			REV					D																												
ORIGINATOR:	RXD	DATE:	28.04.16	SIGNED:		PLOT BY:	HEH																																																										
DRAWN:	HEH	DATE:	28.04.16	SIGNED:		PLOT DATE:	23.06.16																																																										
PROJECT No:	1520-137966-01	SCALES:	1:500 - A1 1:1000 - A3	A1																																																													
DRAWING No:	137966-AB201			REV																																																													
				D																																																													
<table border="1"> <tr> <td>REF</td> <td>REVISIONS</td> <td>BY</td> <td>DATE</td> <td>GPR</td> <td>DATE</td> <td>GPR</td> <td>DATE</td> <td>GPR</td> <td>DATE</td> <td>GPR</td> </tr> <tr> <td>D</td> <td>WYE NOTE ADDED</td> <td>GPR</td> <td>23.06.16</td> <td>CHECKED:</td> <td>HEH</td> <td>DATE:</td> <td>23.06.16</td> <td>SIGNED:</td> <td></td> <td></td> </tr> <tr> <td>C</td> <td>MINOR AMENDMENTS</td> <td>GPR</td> <td>13.06.16</td> <td>CHECKED:</td> <td>GPR</td> <td>DATE:</td> <td>23.06.16</td> <td>SIGNED:</td> <td></td> <td></td> </tr> <tr> <td>B</td> <td>AS BUILT FINAL</td> <td>GPR</td> <td>30.05.16</td> <td>APPROVED:</td> <td></td> <td>DATE:</td> <td>23.06.16</td> <td>SIGNED:</td> <td></td> <td></td> </tr> <tr> <td>A</td> <td>AS BUILT DRAFT</td> <td>GPR</td> <td>18.05.16</td> <td>APPROVED:</td> <td></td> <td>DATE:</td> <td>23.06.16</td> <td>SIGNED:</td> <td></td> <td></td> </tr> </table>		REF	REVISIONS	BY	DATE	GPR	DATE	GPR	DATE	GPR	DATE	GPR	D	WYE NOTE ADDED	GPR	23.06.16	CHECKED:	HEH	DATE:	23.06.16	SIGNED:			C	MINOR AMENDMENTS	GPR	13.06.16	CHECKED:	GPR	DATE:	23.06.16	SIGNED:			B	AS BUILT FINAL	GPR	30.05.16	APPROVED:		DATE:	23.06.16	SIGNED:			A	AS BUILT DRAFT	GPR	18.05.16	APPROVED:		DATE:	23.06.16	SIGNED:			<p>THIS DRAWING AND DESIGN REMAINS THE PROPERTY OF, AND MAY NOT BE REPRODUCED OR ALTERED, WITHOUT THE WRITTEN PERMISSION OF HARRISON GRIERSON CONSULTANTS LIMITED. NO LIABILITY SHALL BE ACCEPTED FOR UNAUTHORISED USE OF THIS DRAWING.</p>								
REF	REVISIONS	BY	DATE	GPR	DATE	GPR	DATE	GPR	DATE	GPR																																																							
D	WYE NOTE ADDED	GPR	23.06.16	CHECKED:	HEH	DATE:	23.06.16	SIGNED:																																																									
C	MINOR AMENDMENTS	GPR	13.06.16	CHECKED:	GPR	DATE:	23.06.16	SIGNED:																																																									
B	AS BUILT FINAL	GPR	30.05.16	APPROVED:		DATE:	23.06.16	SIGNED:																																																									
A	AS BUILT DRAFT	GPR	18.05.16	APPROVED:		DATE:	23.06.16	SIGNED:																																																									