



NOISE WALL TYPICAL PLAN VIEW

SCALE 1:10 - A1
1:20 - A3

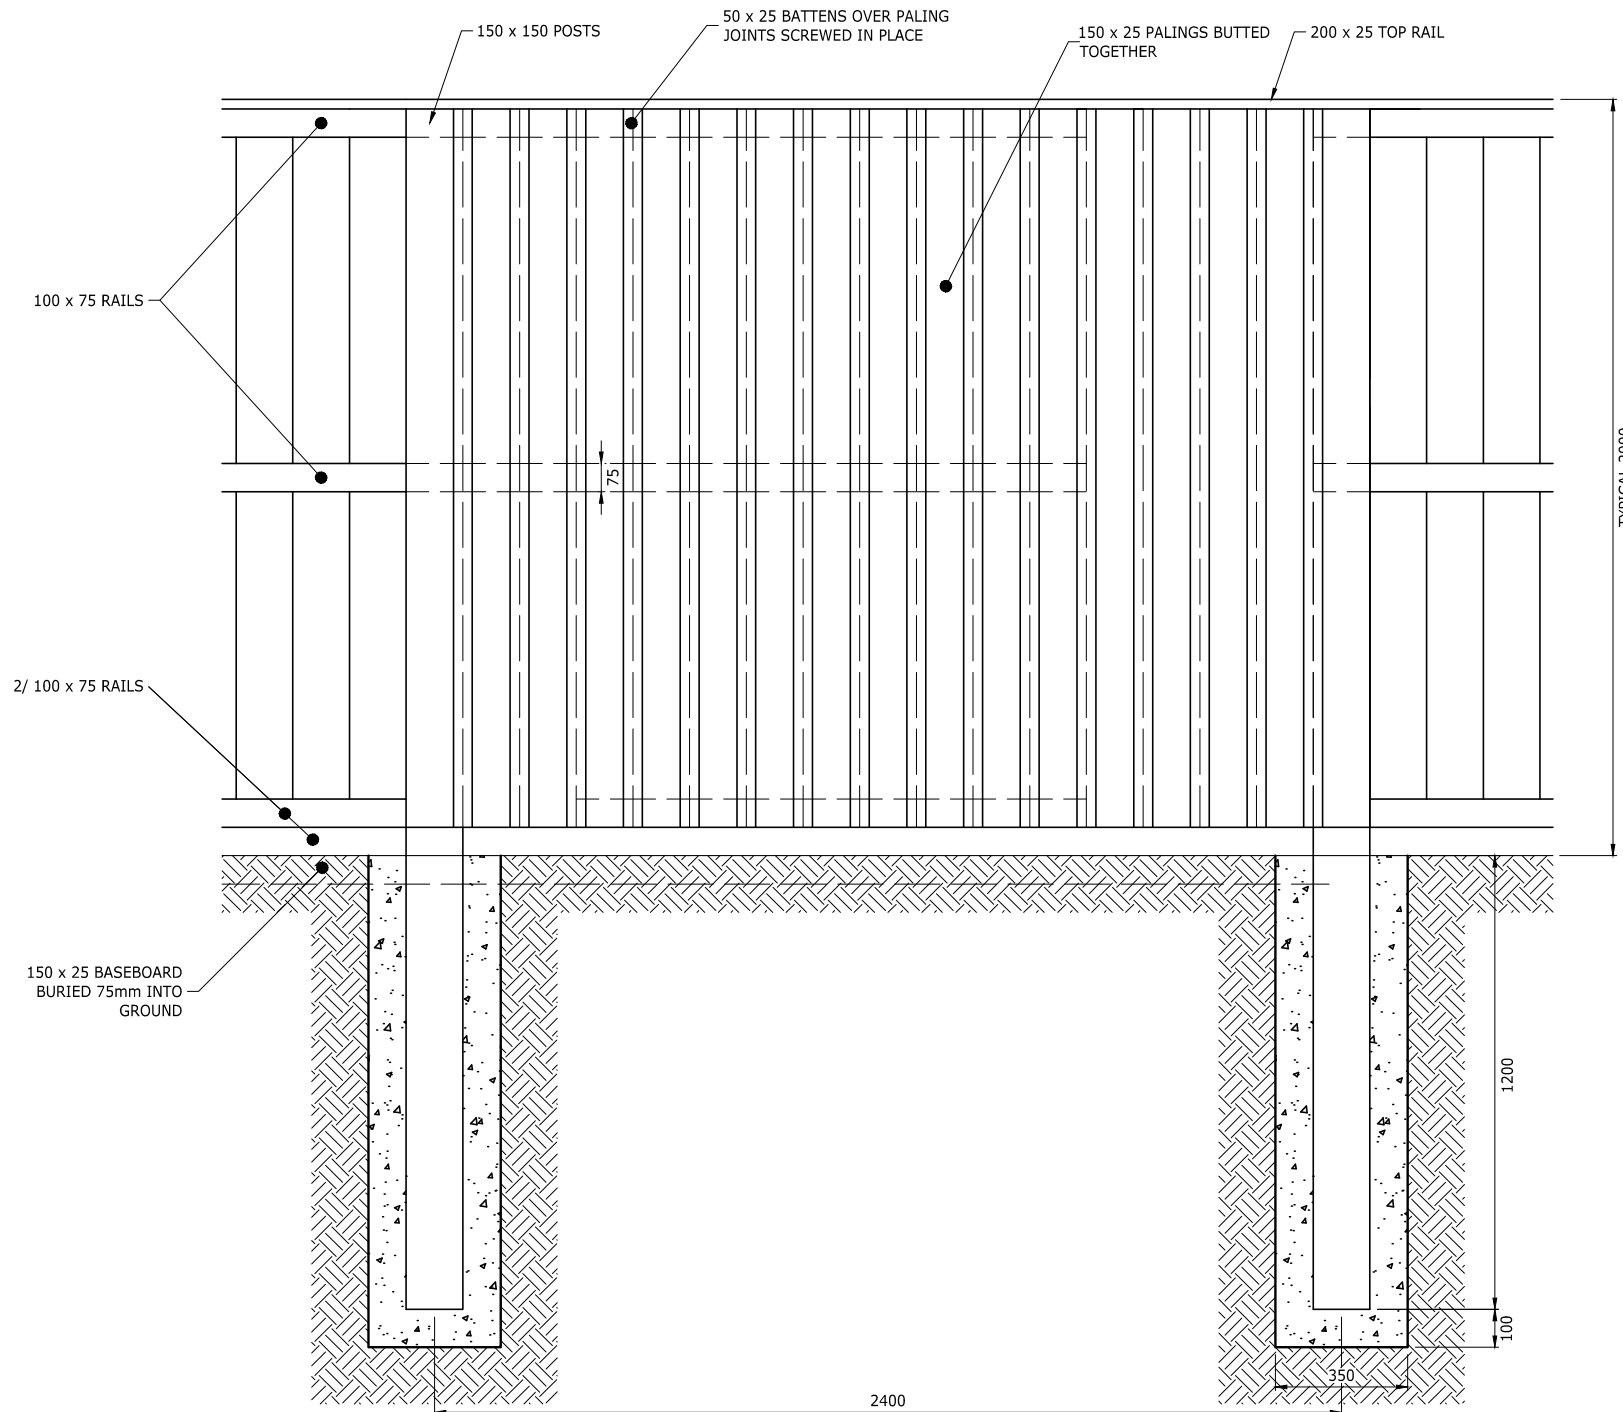

NOISE WALL TYPICAL ELEVATION

SCALE 1:10 - A1
1:20 - A3

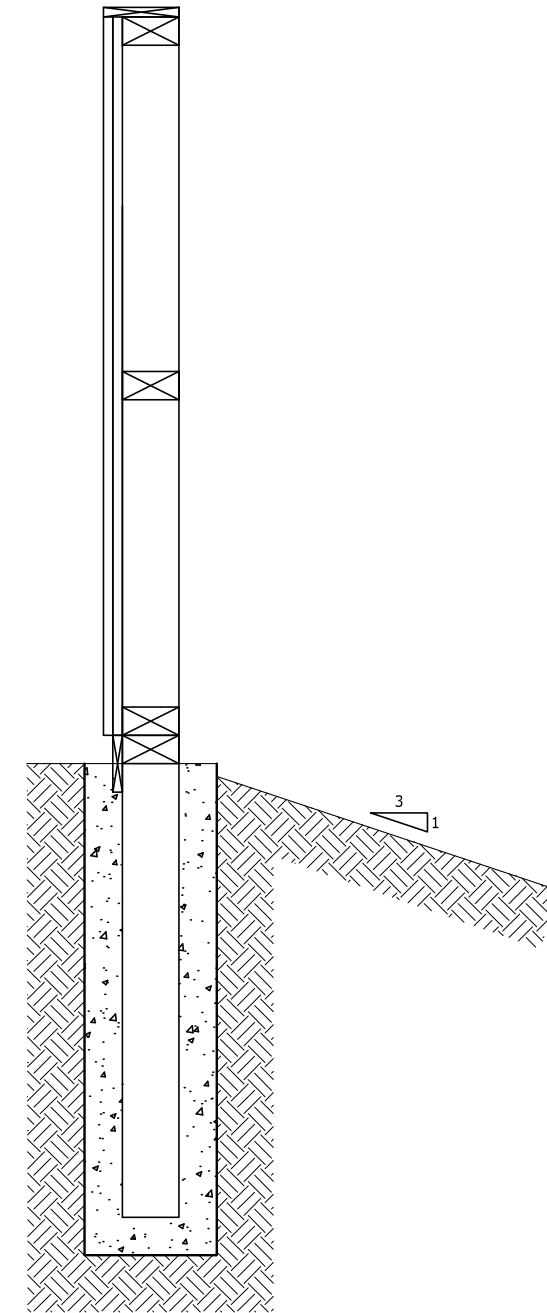

NOISE WALL TYPICAL CROSS SECTION

SCALE 1:10 - A1
1:20 - A3

NOTES:

- TIMBER TREATMENT:
POSTS H5
ALL FENCE MEMBERS H4
TOP RAIL H3.2
- ALL TIMBER IS RADIATA PINE.
- ALL POSTS ARE EMBEDDED IN 20 MPa CONCRETE, 350 DIA, WITH A MINIMUM 100mm CONCRETE IN BASE OF HOLES.
- BATTENS TO BE FIXED TO PALINGS WITH SCREWS. TOP RAIL IS FIXED WITH SCREWS. ALL OTHER FIXINGS STANDARD FENCE FIXINGS.
- ALL FITTINGS ARE GALVANISED.
- ALL TIMBER IS ROUGH SAWN.

ORIGINATOR:	RXD	DATE:	18.05.16	SIGNED:		PLOT BY:	HEH
DRAWN:	HEH	DATE:	18.05.16	SIGNED:		PLOT DATE:	31.05.16
CHECKED:	GPR	DATE:	30.05.16	SIGNED:		SURVEY BY:	
APPROVED:	GPR	DATE:	18.05.16	SIGNED:		SURVEY DATE:	
BY	DATE	GPR	30.05.16				

ASSOCIATION OF CONSULTING ENGINEERS NEW ZEALAND
ISO 9001 QUALITY ASSURED
THIS DRAWING AND DESIGN REMAINS THE PROPERTY OF, AND MAY NOT BE REPRODUCED OR ALTERED, WITHOUT THE WRITTEN PERMISSION OF HARRISON GRIERSON CONSULTANTS LIMITED. NO LIABILITY SHALL BE ACCEPTED FOR UNAUTHORISED USE OF THIS DRAWING.



TAURANGA OFFICE
LEVEL 1 HARRISON GRIERSON HOUSE
141 CAMERON ROAD TAURANGA 3110
T +64 7 578 0023
W www.harrisongrilson.com

PROJECT: **Summit**
THAE LAKES (2012) LTD, TAURANGA

TITLE: **STAGES 3CD
NOISE WALL DETAILS AS BUILT
TCC IP 101665**

ISSUE STATUS:		AS BUILT
PROJECT No:	1520-137966-01	SCALE: AS SHOWN
DRAWING No:	137966-AB501	REV B