

THIS DRAWING AND DESIGN REMAINS THE PROPERTY OF, AND MAY NOT BE REPRODUCED OR ALTERED, WITHOUT THE WRITTEN PERMISSION OF HARRISON GRIERSON CONSULTANTS LIMITED. NO LIABILITY SHALL BE ACCEPTED FOR UNAUTHORISED USE OF THIS DRAWING.

WASTEWATER MANHOLES							
ID	mN	mE	Lid Level	Inv Out	Inv In	Inv In	Inv In
ExSSMH 24/1	5817027.62	1873475.46	12.38		10.39		
SSMH 1/1	5817026.14	1873507.46	14.98	12.68	12.83	13.44	12.83
SSMH 1/2	5817023.80	1873539.10	17.13	15.32	15.40		
SSMH 1/3	5817072.72	1873566.95	18.01	15.89	15.96	15.96	
SSMH 1/4	5817100.45	1873555.79	17.94	16.64			
SSMH 2/1	5817056.86	1873509.69	15.08	13.78	13.83		
SSMH 2/2	5817095.41	1873522.97	15.27	14.18			
SSMH 3/1	5816991.77	1873508.89	15.23	13.77			
SSMH 4/1	5817051.85	1873580.50	19.84	17.66			


WASTEWATER LOT CONNECTIONS						
Lot	mN	mE	RL	Dia	Depth	
754	5817036.35	1873486.93	13.15	100	1.3	
763	5817036.39	1873510.42	15.32	100	1.5	
764	5817057.13	1873512.52	15.28	100	1.1	
765	5817076.53	1873518.64	15.38	100	1.4	
766	5817095.47	1873524.45	15.31	100	1.2	
767	5817103.53	1873554.47	17.80	100	0.9	
768	5817102.17	1873558.14	17.99	100	1.0	
769	5817082.15	1873567.78	19.01	100	1.5	
770	5817052.36	1873584.15	20.12	100	1.0	
771	5817048.97	1873581.38	19.99	100	1.1	
772	5817043.97	1873557.33	17.97	100	1.1	
773	5817023.78	1873546.20	17.65	100	0.9	
774	5817014.77	1873532.86	17.16	100	1.1	
775	5817015.70	1873516.35	15.74	100	1.4	
776	5816982.82	1873525.03	15.81	150	1.4	

NOTES

- WORKS HAVE BEEN CARRIED OUT IN ACCORDANCE WITH RC 16807.
- ORIGIN OF LEVELS FOR SURVEY: TCC BM 1021 (BP 14 DP 408042) RL=12.515m MOTURIKI DATUM.
- ALL WASTEWATER MAINS ARE 150mmØ NOVADRAIN (SN16) PIPE UNLESS SHOWN OTHERWISE.
- ALL LOT CONNECTIONS ARE 150mmØ RRJ NOVADRAIN (SN16) PIPE UNDER ROADS UNLESS SHOWN OTHERWISE.
- ALL 100mmØ PIPE IS RRJ NOVADRAIN (SN16) PIPE UNLESS SHOWN OTHERWISE.
- ABANDONED LOT CONNECTIONS HAVE BEEN CAPPED WITHIN THE ROAD RESERVE.
- PLEASE REFER TO ELECTRONIC ASBUILTS FOR FURTHER INFORMATION.

LEGEND:

- - - WASTEWATER
- - - EXISTING WASTEWATER
- - - ABANDONED LOT CONNECTION
- ⊙ MANHOLE
- ← FLOW DIRECTION

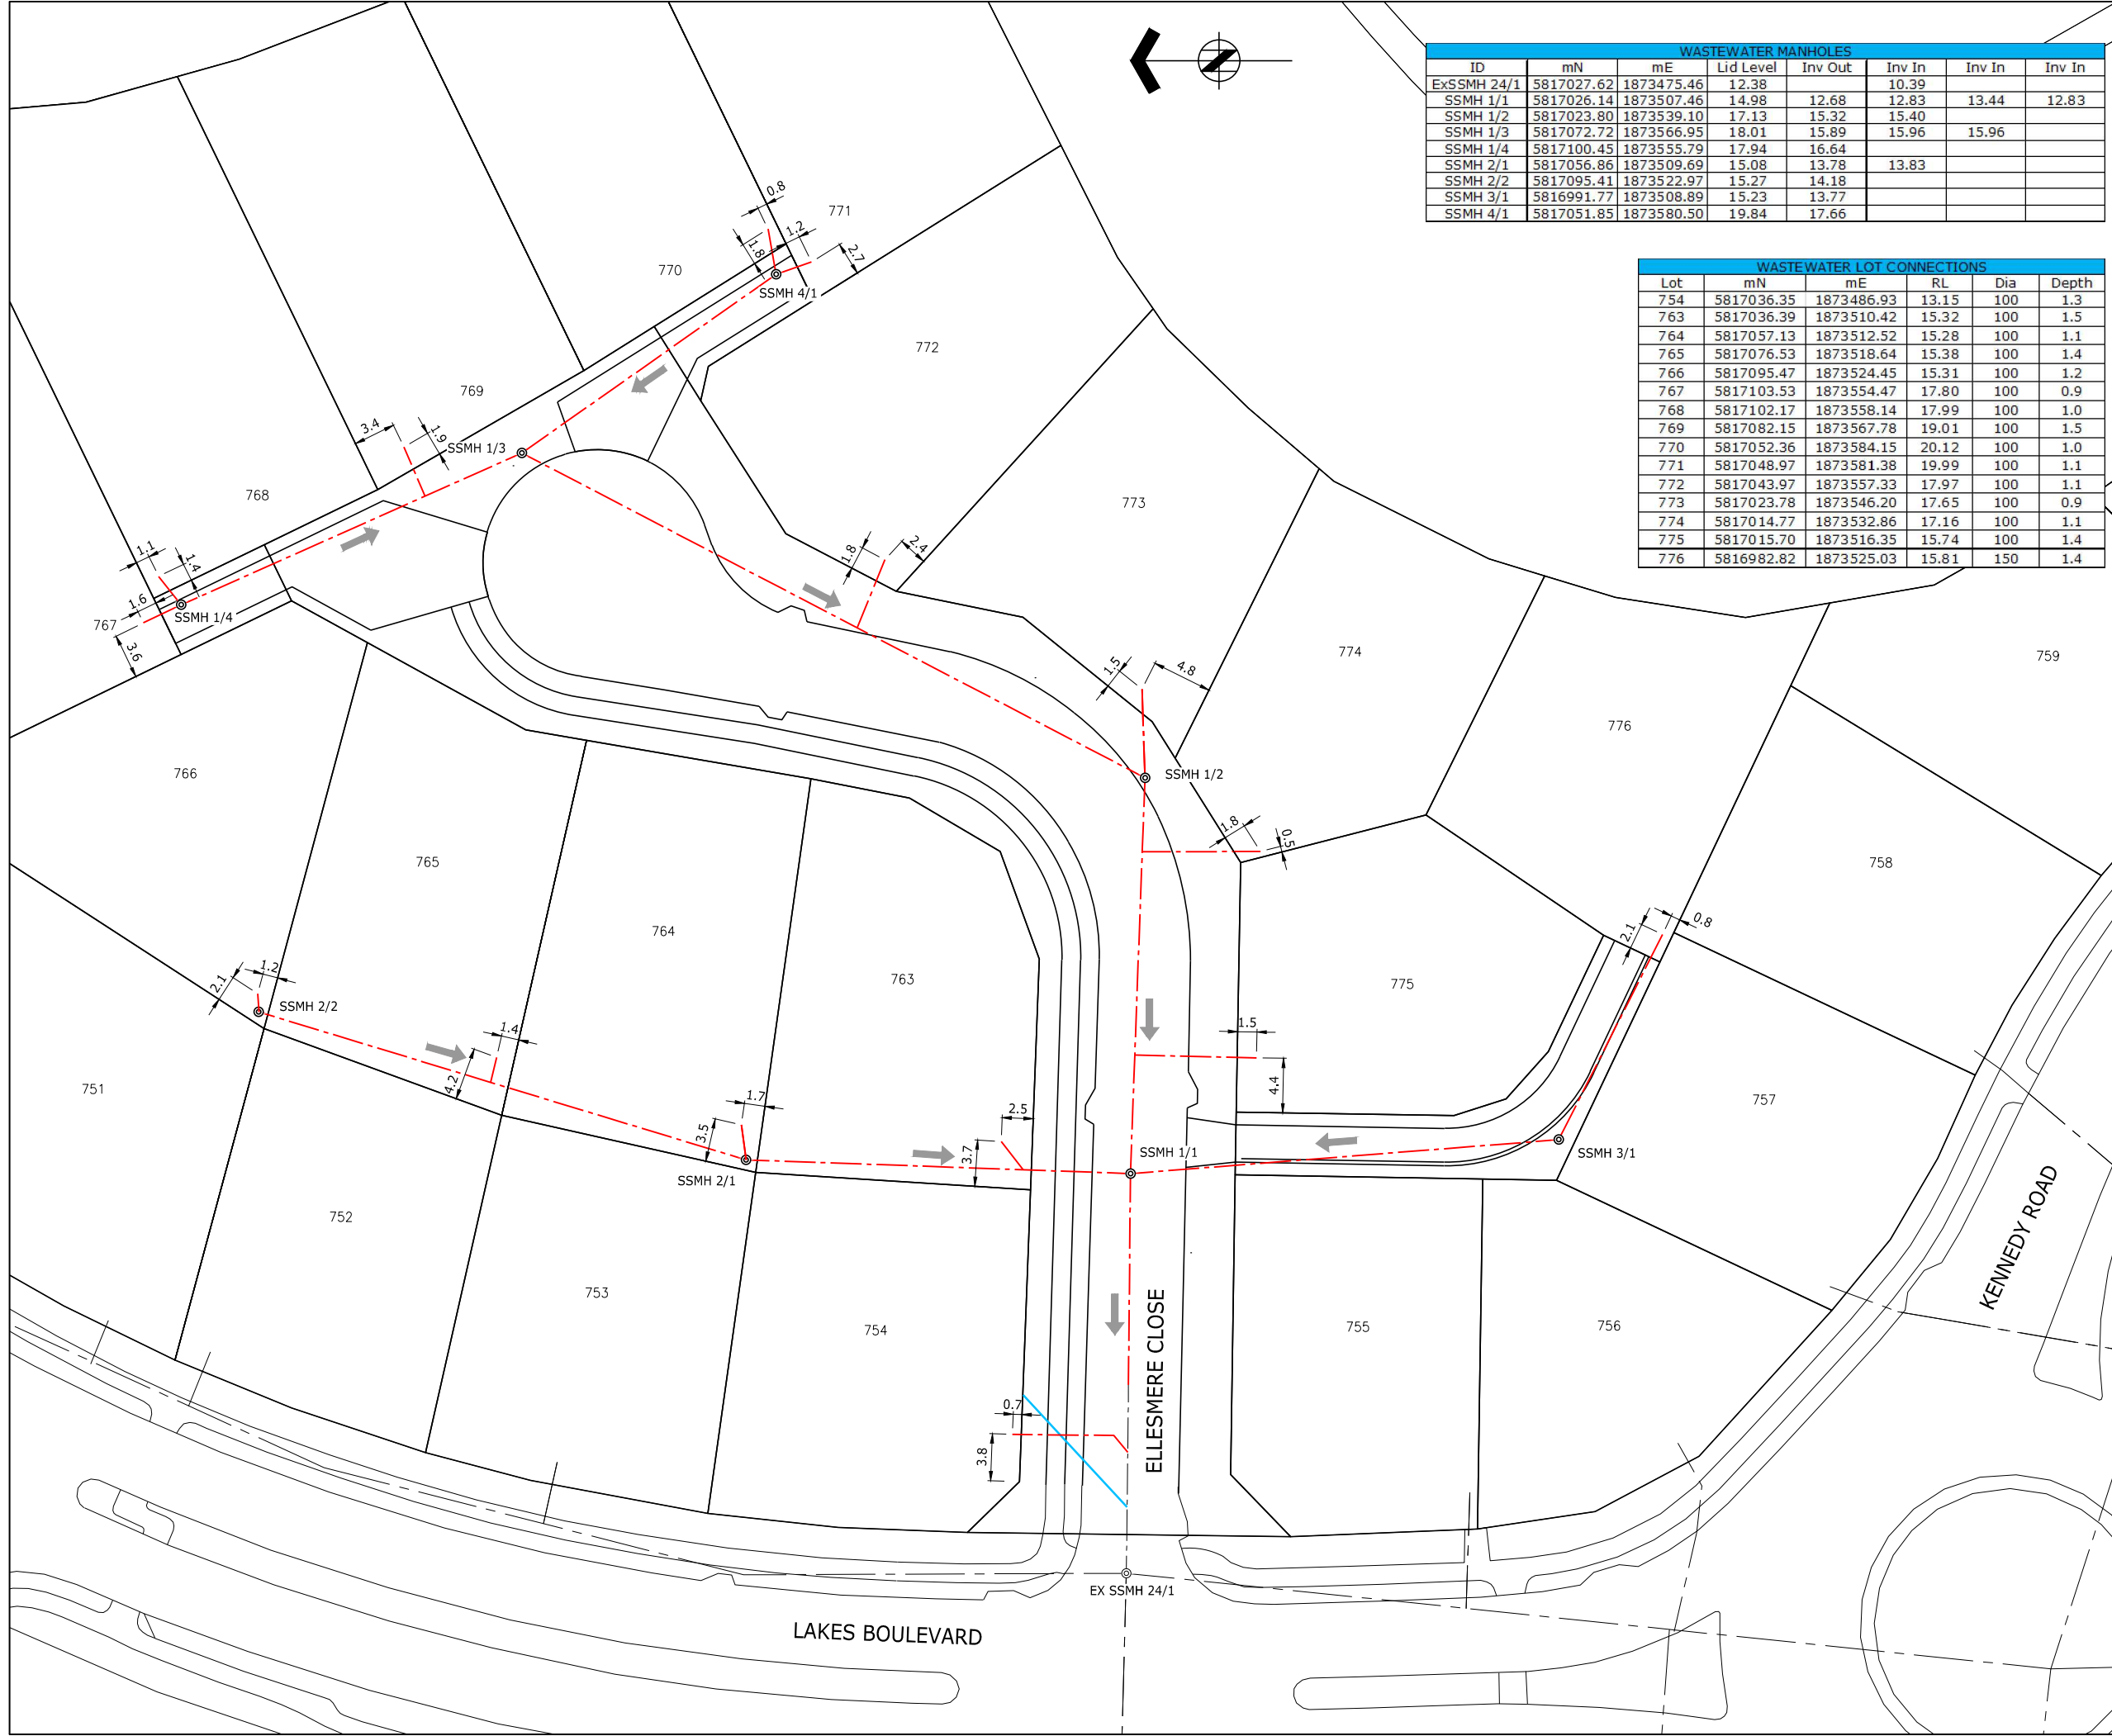

HARRISON GRIERSON
 Tauranga Office
 Level 1 Harrison Grierson House
 141 Cameron Road Tauranga 3110
 P +64 7 578 0023
 www.harrisingrierson.com

A	AS BUILT	DJH	09.05.13
REF	REVISIONS	BY	DATE

PROJECT:
**THE LAKES (2012) LTD
 TAURANGA**

TITLE:
**STAGE 2N
 WASTEWATER RETICULATION
 AS BUILT PLAN**

ORIGINATOR: RCH	DATE: 09.05.13	SIGNED:	PLOT BY: HJD
DRAWN: DJH	DATE: 09.05.13	SIGNED:	PLOT DATE: 13.05.13
CHECKED: MPD	DATE: 09.05.13	SIGNED:	SURVEY BY:
APPROVED: GPR	DATE: 09.05.13	SIGNED:	SURVEY DATE:

ISSUE STATUS:
AS BUILT

PROJECT No: 1520-132631-01	SCALES: 1:250 - A1 1:500 - A3	A1
DRAWING No:		REV

132631-2N-AB200
A