




NOISE WALL TYPICAL ELEVATION
SCALE 1:10 - A1
1:20 - A3

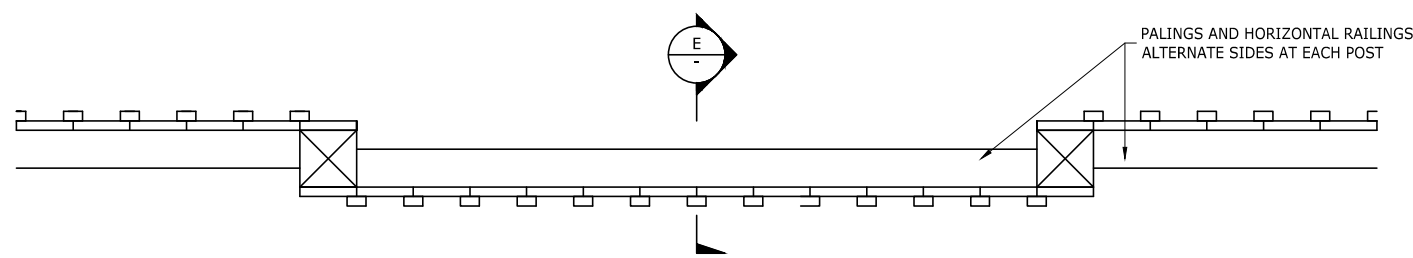

NOISE WALL TYPICAL PLAN VIEW
SCALE 1:10 - A1
1:20 - A3

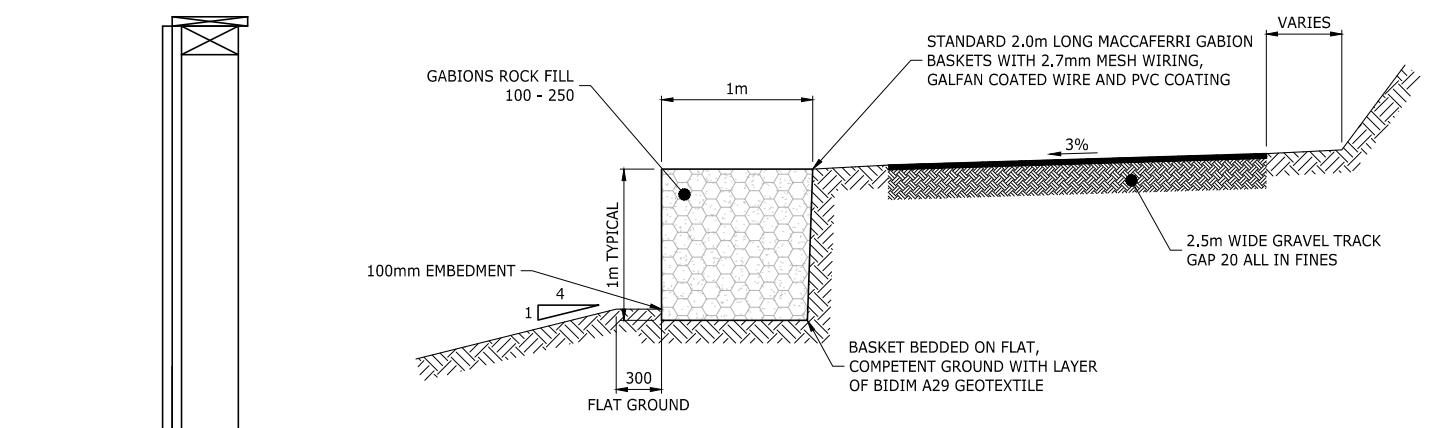

TYPICAL SHARED USE TRACK AND GABION WALL CROSS SECTION
SCALE 1:25 - A1
1:50 - A3

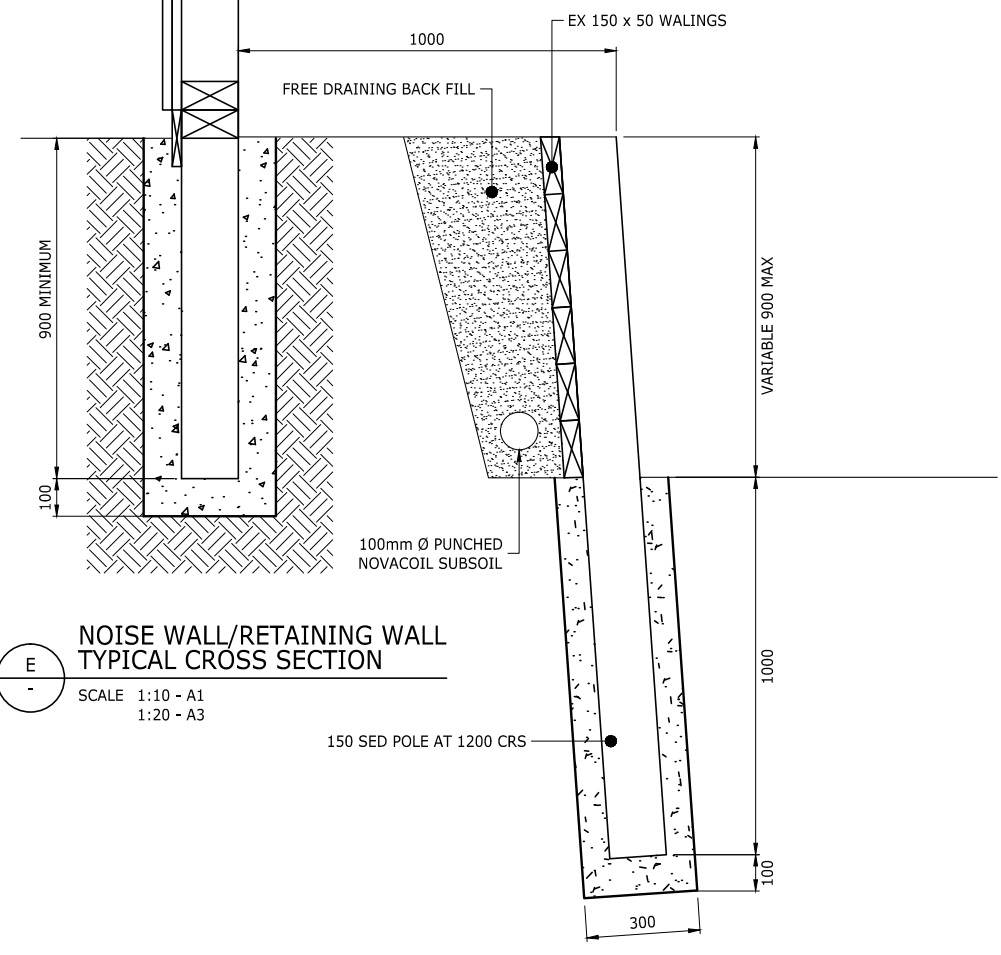

NOISE WALL/RETAINING WALL TYPICAL CROSS SECTION
SCALE 1:10 - A1
1:20 - A3

- NOTES:**
- TIMBER TREATMENT:
POSTS H5
ALL FENCE MEMBERS H4
TOP RAIL H3,2
WALINGS H5
 - ALL TIMBER RADIATA PINE, UNLESS OTHERWISE NOTED.
 - ALL SITE CUTS TREATED WITH METALEX, OR SIMILAR.
 - ALL POSTS HAVE MINIMUM EMBEDMENT DEPTH OF 800mm.
 - ALL POSTS EMBEDDED IN 20 MPA CONCRETE, 300 DIA, WITH A MINIMUM 100mm CONCRETE IN BASE OF HOLES.
 - BATTENS FIXED TO PALINGS WITH SCREWS. ALL OTHER FIXINGS STANDARD FENCE FIXINGS.
 - ALL FITTINGS GALVANISED.
 - ALL TIMBER ROUGH SAWN.

ORIGINATOR:	TSC	DATE:	15.12.15	SIGNED:		PLOT BY:	HEH
DRAWN:	HEH	DATE:	15.12.15	SIGNED:		PLOT DATE:	21.12.15
CHECKED:	RJM	DATE:	21.12.15	SIGNED:		SURVEY BY:	
APPROVED:	GPR	DATE:	15.12.15	SIGNED:		SURVEY DATE:	
BY:		DATE:	21.12.15	SIGNED:			

ASSOCIATION OF CONSULTING ENGINEERS NEW ZEALAND
ISO 9001 QUALITY ASSURED
THIS DRAWING AND DESIGN REMAINS THE PROPERTY OF, AND MAY NOT BE REPRODUCED OR ALTERED, WITHOUT THE WRITTEN PERMISSION OF HARRISON GRIERSON CONSULTANTS LIMITED. NO LIABILITY SHALL BE ACCEPTED FOR UNAUTHORISED USE OF THIS DRAWING.

HG
TAURANGA OFFICE
LEVEL 1 HARRISON GRIERSON HOUSE
141 CAMERON ROAD TAURANGA 3110
T +64 7 578 0023
W www.harrisongrierson.com

PROJECT: **Central**
THE LAKES (2012) LTD, TAURANGA

TITLE: **STAGE 2P2
NOISE WALL, RETAINING WALL AND
GABION BASKET AS BUILT DETAILS TCC IP 24551**

ISSUE STATUS:	AS BUILT	
PROJECT No:	1510-137878-01	SCALE: AS SHOWN
DRAWING No:	137878-AB500	REV B