



 
 






NOTES:

- LEVELS ARE IN TERMS OF THE MOTURIKI DATUM.
- ORIGIN OF LEVELS TCC BENCHMARK BM 1070 RL 55.865m.
- METHOD OF SURVEY: GPS
- ALL WORKS HAVE BEEN CARRIED OUT TO TCC IDC 2011 STANDARDS.
- STANDARD ROAD RESERVE FOOTPATHS ARE 1.5m WIDE 'RIVERLEA GOLD' EXPOSED AGGREGATE CONCRETE.
- ALL VEHICLE/PEDESTRIAN LETDOWNS AND PATH STUBS WITHIN ROAD RESERVE ARE 'RIVERLEA GOLD' EXPOSED AGGREGATE CONCRETE.
- ALL CONCRETE RIGHT OF WAYS ARE 'HALF BLACK' EXPOSED AGGREGATE.
- COUNCIL BENCHMARKS HAVE BEEN SUPPLIED BY TCC. FINAL LOCATIONS HAVE BEEN CONFIRMED ON SITE BY SURVEYOR.

LEGEND:

-  STREETLIGHT
-  STREETSIGN
-  'HALF BLACK' EXPOSED AGGREGATE CONCRETE
-  'RIVERLEA GOLD' EXPOSED AGGREGATE CONCRETE
-  K1 KERB LINE AND REFERENCE
-  TCC BENCHMARK
-  BERM/RESERVE GRASS
-  TREES (REFER SHEET AB402 FOR SPECIES)

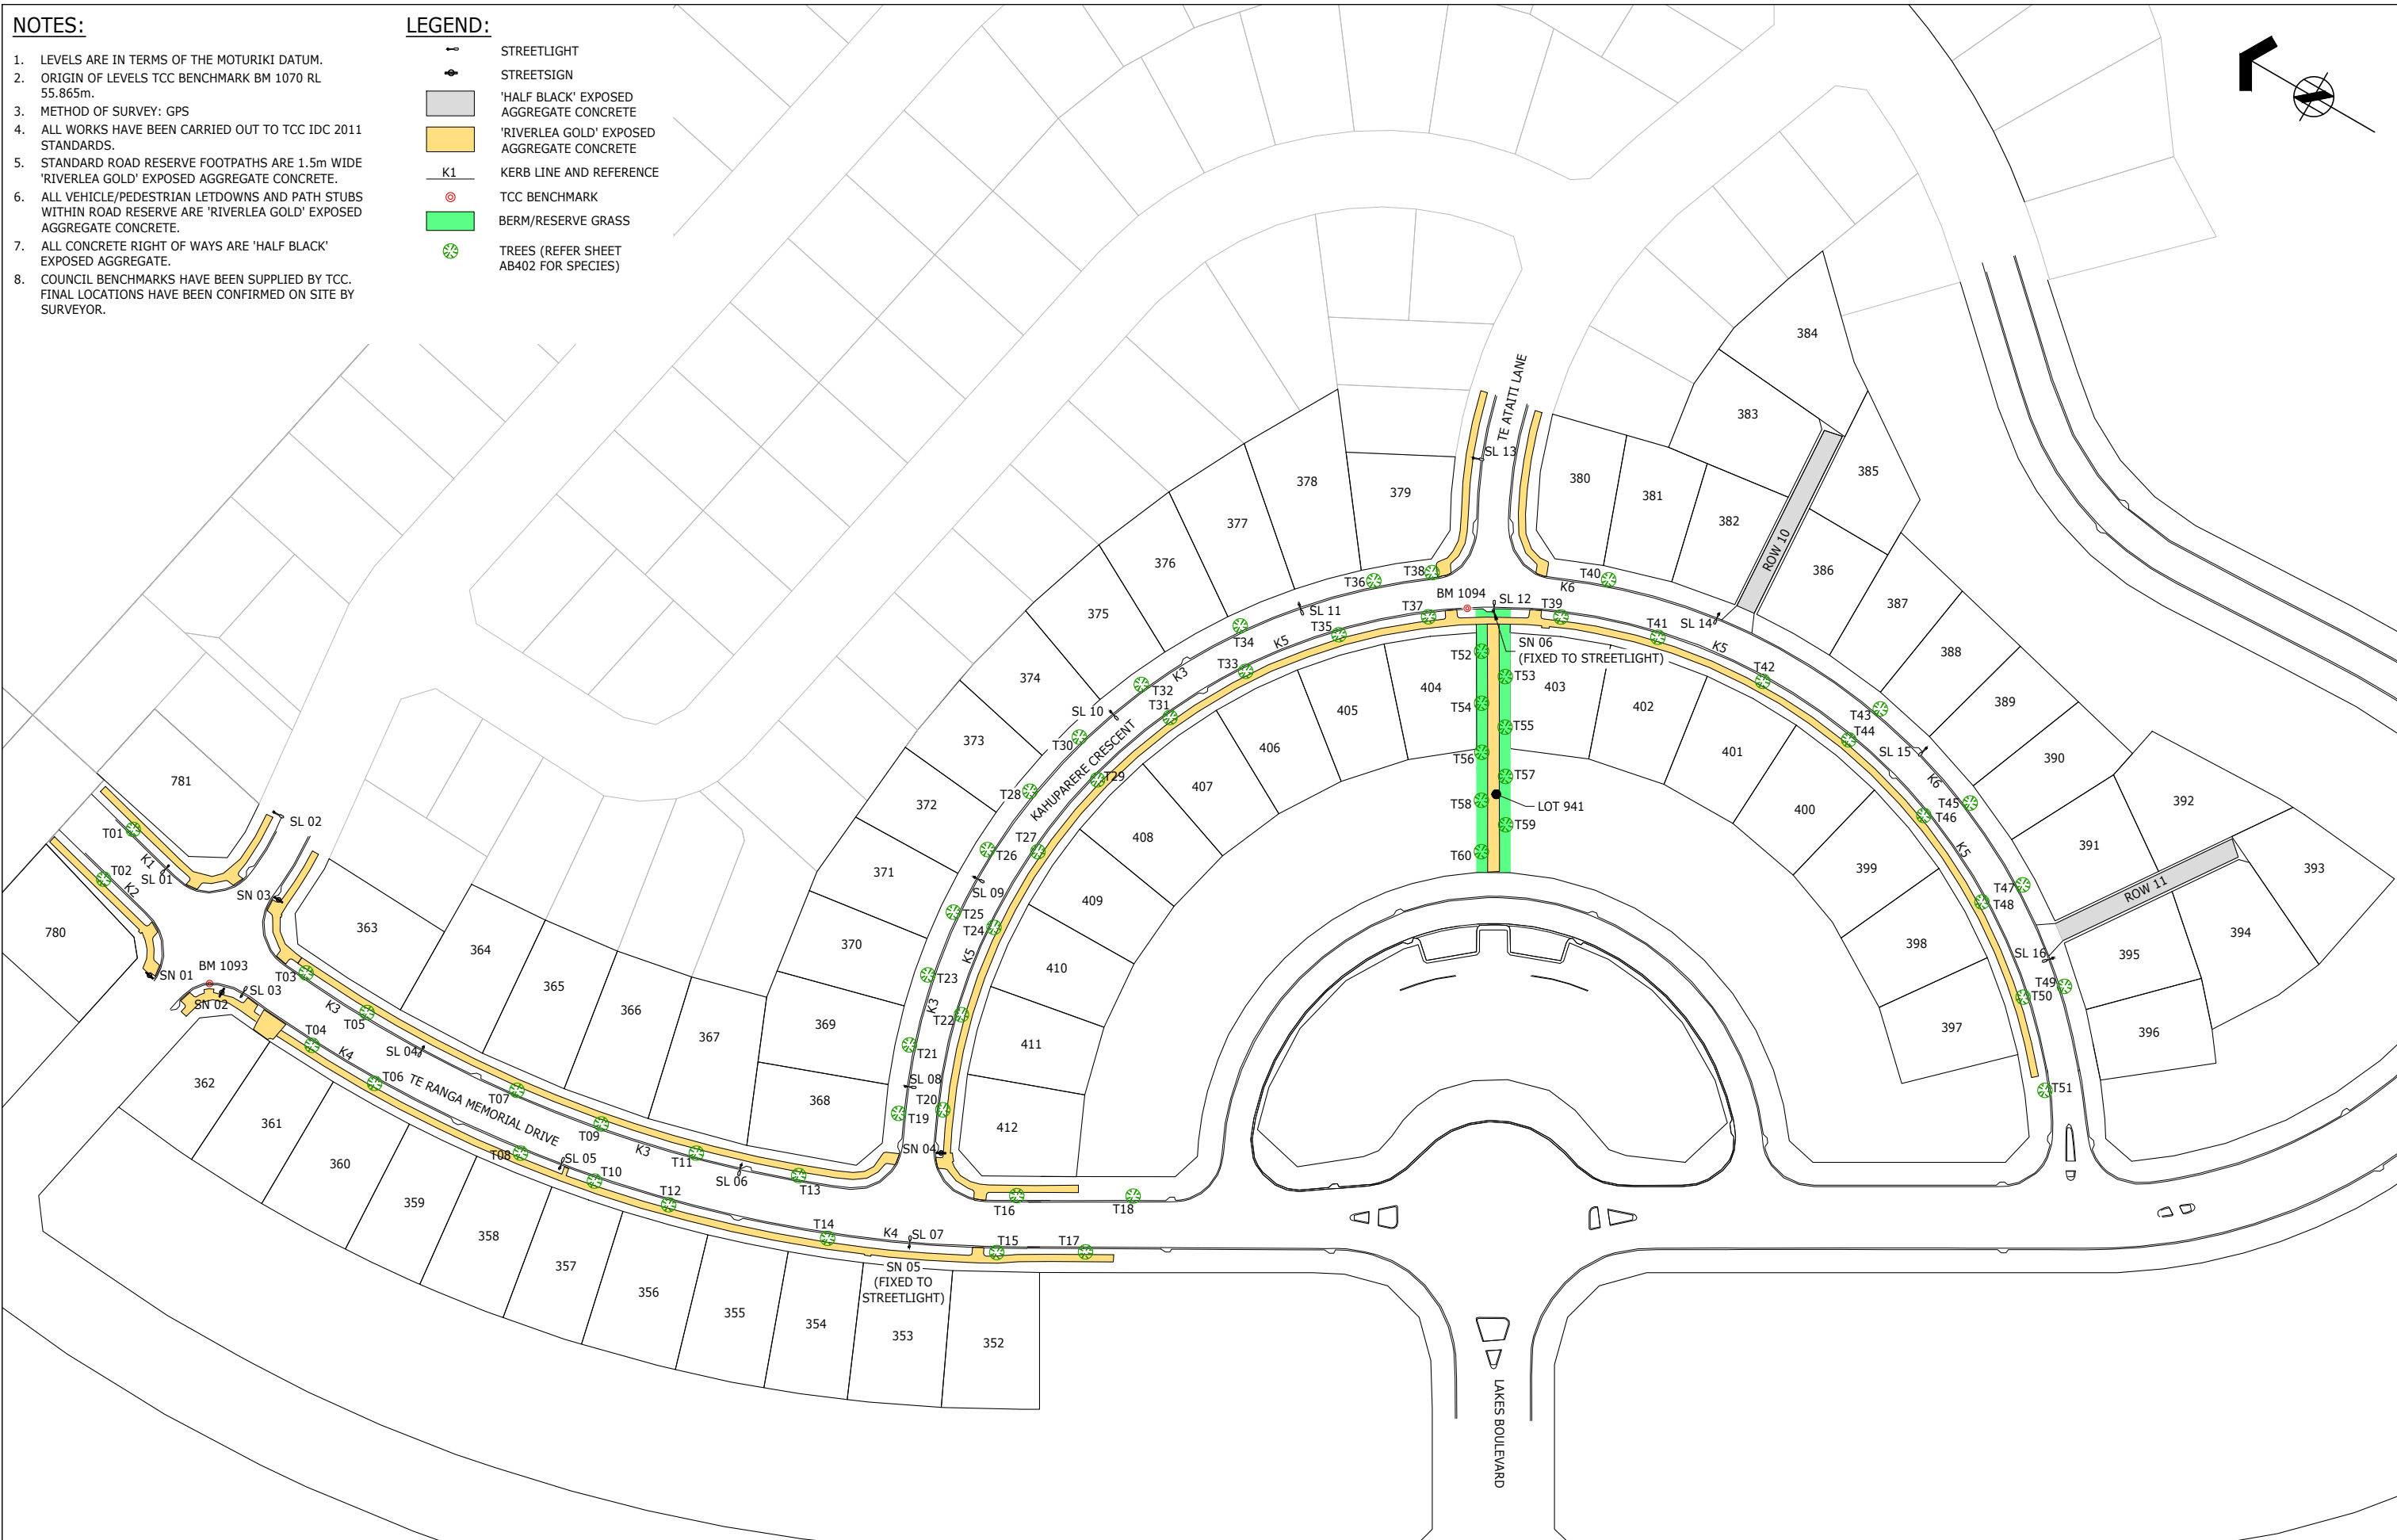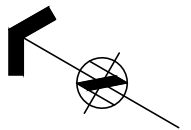

ORIGINATOR:	RXD	DATE:	12.09.16	SIGNED:	
DRAWN:	TRS	DATE:	12.09.16	SIGNED:	
CHECKED:	TCH	DATE:	28.09.16	SIGNED:	
APPROVED:	GPR	DATE:	12.09.16	SIGNED:	
BY:		DATE:	28.09.16	SIGNED:	

PLOT BY:	TRS	PLOT DATE:	26.09.16
SURVEY BY:		SURVEY DATE:	

ASSOCIATION OF CONSULTING ENGINEERS
NEW ZEALAND

ISO 9001 QUALITY ASSURED

THIS DRAWING AND DESIGN REMAINS THE PROPERTY OF, AND MAY NOT BE REPRODUCED OR ALTERED, WITHOUT THE WRITTEN PERMISSION OF HARRISON GRIERSON CONSULTANTS LIMITED. NO LIABILITY SHALL BE ACCEPTED FOR UNAUTHORISED USE OF THIS DRAWING.



TAURANGA OFFICE
LEVEL 1, 60 SPRING STREET
TAURANGA 3110
T +64 7 578 0023
W www.harrisongrierson.com

PROJECT:

Summit

THE LAKES (2012) LIMITED, TAURANGA

TITLE:

STAGES 3EM
STREETSCAPE AND TRANSPORTATION
AS BUILT PLAN SHEET 1
TCC IP 101696

ISSUE STATUS:		AS BUILT
PROJECT No:	1500-138804-01	SCALE: 1:625 - A1
DRAWING No:	138804-AB401	1:1250 - A3
REV	B	