



**NOTES:**

1. LEVELS ARE IN TERMS OF THE MOTURIKI DATUM.
2. ORIGIN OF LEVELS TCC BENCHMARK BM 1070 RL 55.865m.
3. METHOD OF SURVEY: GPS
4. ALL WORKS WERE CARRIED OUT TO TCC IDC 2011 STANDARDS.
5. ALL WASTEWATER MAINS ARE 150mm uPVC PIPES UNLESS SHOWN OTHERWISE.
6. ALL WASTEWATER MAINS ARE SN16 UNLESS SHOWN OTHERWISE.
7. ALL STORMWATER AND WASTEWATER CONNECTIONS ARE 100mm NB uPVC, UNLESS UNDER CARRIAGEWAY WHERE 150mm NB uPVC ARE USED.
8. ALL MANHOLES ARE 1050mm DIA UNLESS OTHERWISE SHOWN.
9. ALL DEEP DRAINAGE CONNECTIONS ARE RAMPED UP TO WITHIN 1.5m OF SURFACE.
10. ALL BURIED AS BUILT INFORMATION SUPPLIED BY HIGGINS CONTRACTORS LTD.

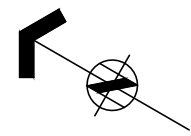

**LEGEND:**

- **WW** — AS BUILT WASTEWATER
- - - **WW** - - - EXISTING WASTEWATER
- AS BUILT WASTEWATER CONNECTION
- - - EXISTING WASTEWATER CONNECTION
- AS BUILT WASTEWATER MANHOLE
- EXISTING WASTEWATER MANHOLE
- ◊ AS BUILT WASTEWATER RODDING EYE
- FLOW DIRECTION

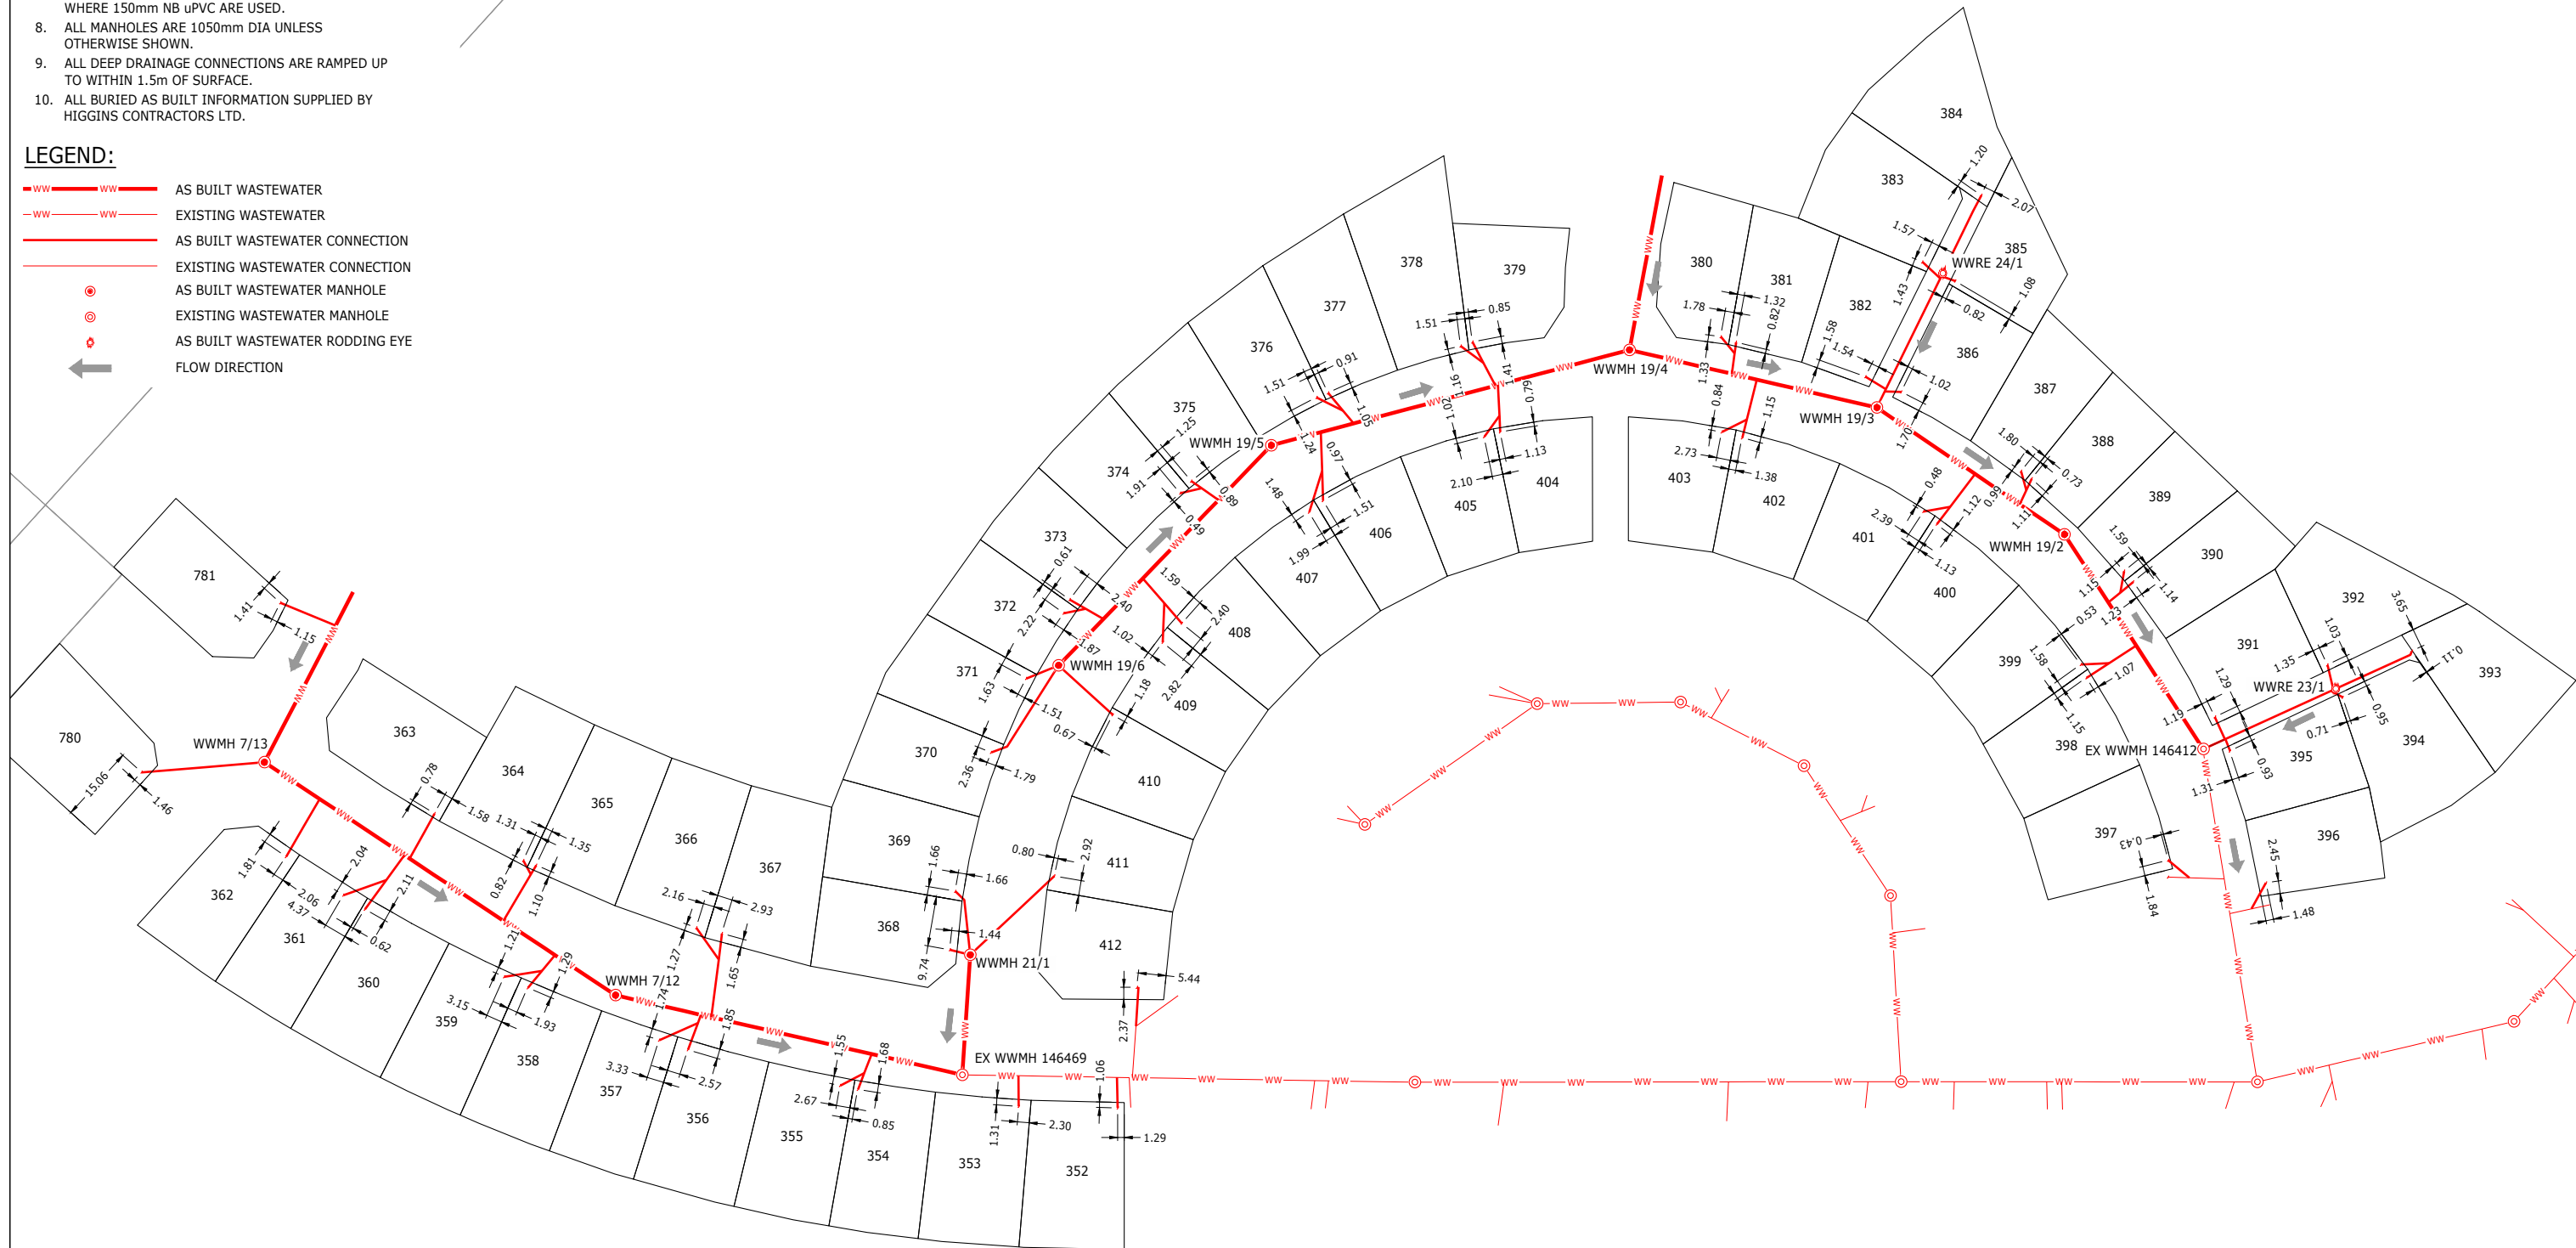

ORIGINATOR:	RXD	DATE:	12.09.16	SIGNED:		PLOT BY:	TRS
DRAWN:	TRS	DATE:	12.09.16	SIGNED:		PLOT DATE:	26.09.16
CHECKED:	TCH	DATE:	28.09.16	SIGNED:		SURVEY BY:	
APPROVED:	GPR	DATE:	28.09.16	SIGNED:		SURVEY DATE:	

ASSOCIATION OF CONSULTING ENGINEERS NEW ZEALAND

ISO 9001 QUALITY ASSURED

**HG**

TAURANGA OFFICE  
LEVEL 1, 60 SPRING STREET  
TAURANGA 3110  
T +64 7 578 0023  
W www.harringtonrierson.com

PROJECT:

**Summit**

THE LAKES (2012) LIMITED, TAURANGA

TITLE:

STAGES 3EM  
WASTEWATER RETICULATION AS BUILT PLAN  
SHEET 1  
TCC IP 101696

ISSUE STATUS:	AS BUILT	
PROJECT No:	1500-138804-01	SCALES: 1:625- A1 1:1250 - A3
DRAWING No:	138804-AB201	REV B