


POLE DIA (mm)	MIN. HOLE DIA (mm)	POLE LENGTH IN GROUND (m)	POLE LENGTH ABOVE GROUND (m)	POLE LENGTH TOTAL (m)
225	450	4.0	0.2	4.2

NOTES:  
1. Refer to Harrison Grierson drawing AB403 for location and extent of wall.



revision	rev	description	drawn	approved	date

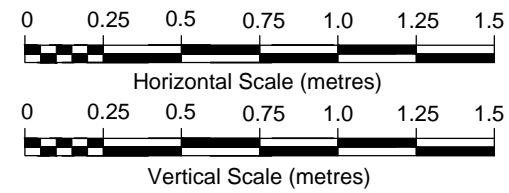

drawn	<b>SWH</b>
approved	<b>RBT</b>
date	<b>29/4/2015</b>
scale	<b>1:25</b>
original size	<b>A3</b>

client:	<b>The Lakes Ltd</b>		
project:	<b>The Lakes Stage Three Tauranga Stage 3 Retaining Wall</b>		
title:	<b>As Built Drawing</b>		
project no:	<b>GENZTAUC13086AF-AH</b>	figure no:	<b>2</b>
		rev:	<b>A</b>