


NOTES:

1. SLOTS CUT 120° LONG ABOVE THE SPRINGLINE, ALTERNATING EITHER SIDE OF THE DRAIN PIPE IN 0.5m INTERVALS.
2. REFER TO HARRISON GRIERSON DRAWING AB100 FOR LAYOUT DETAILS

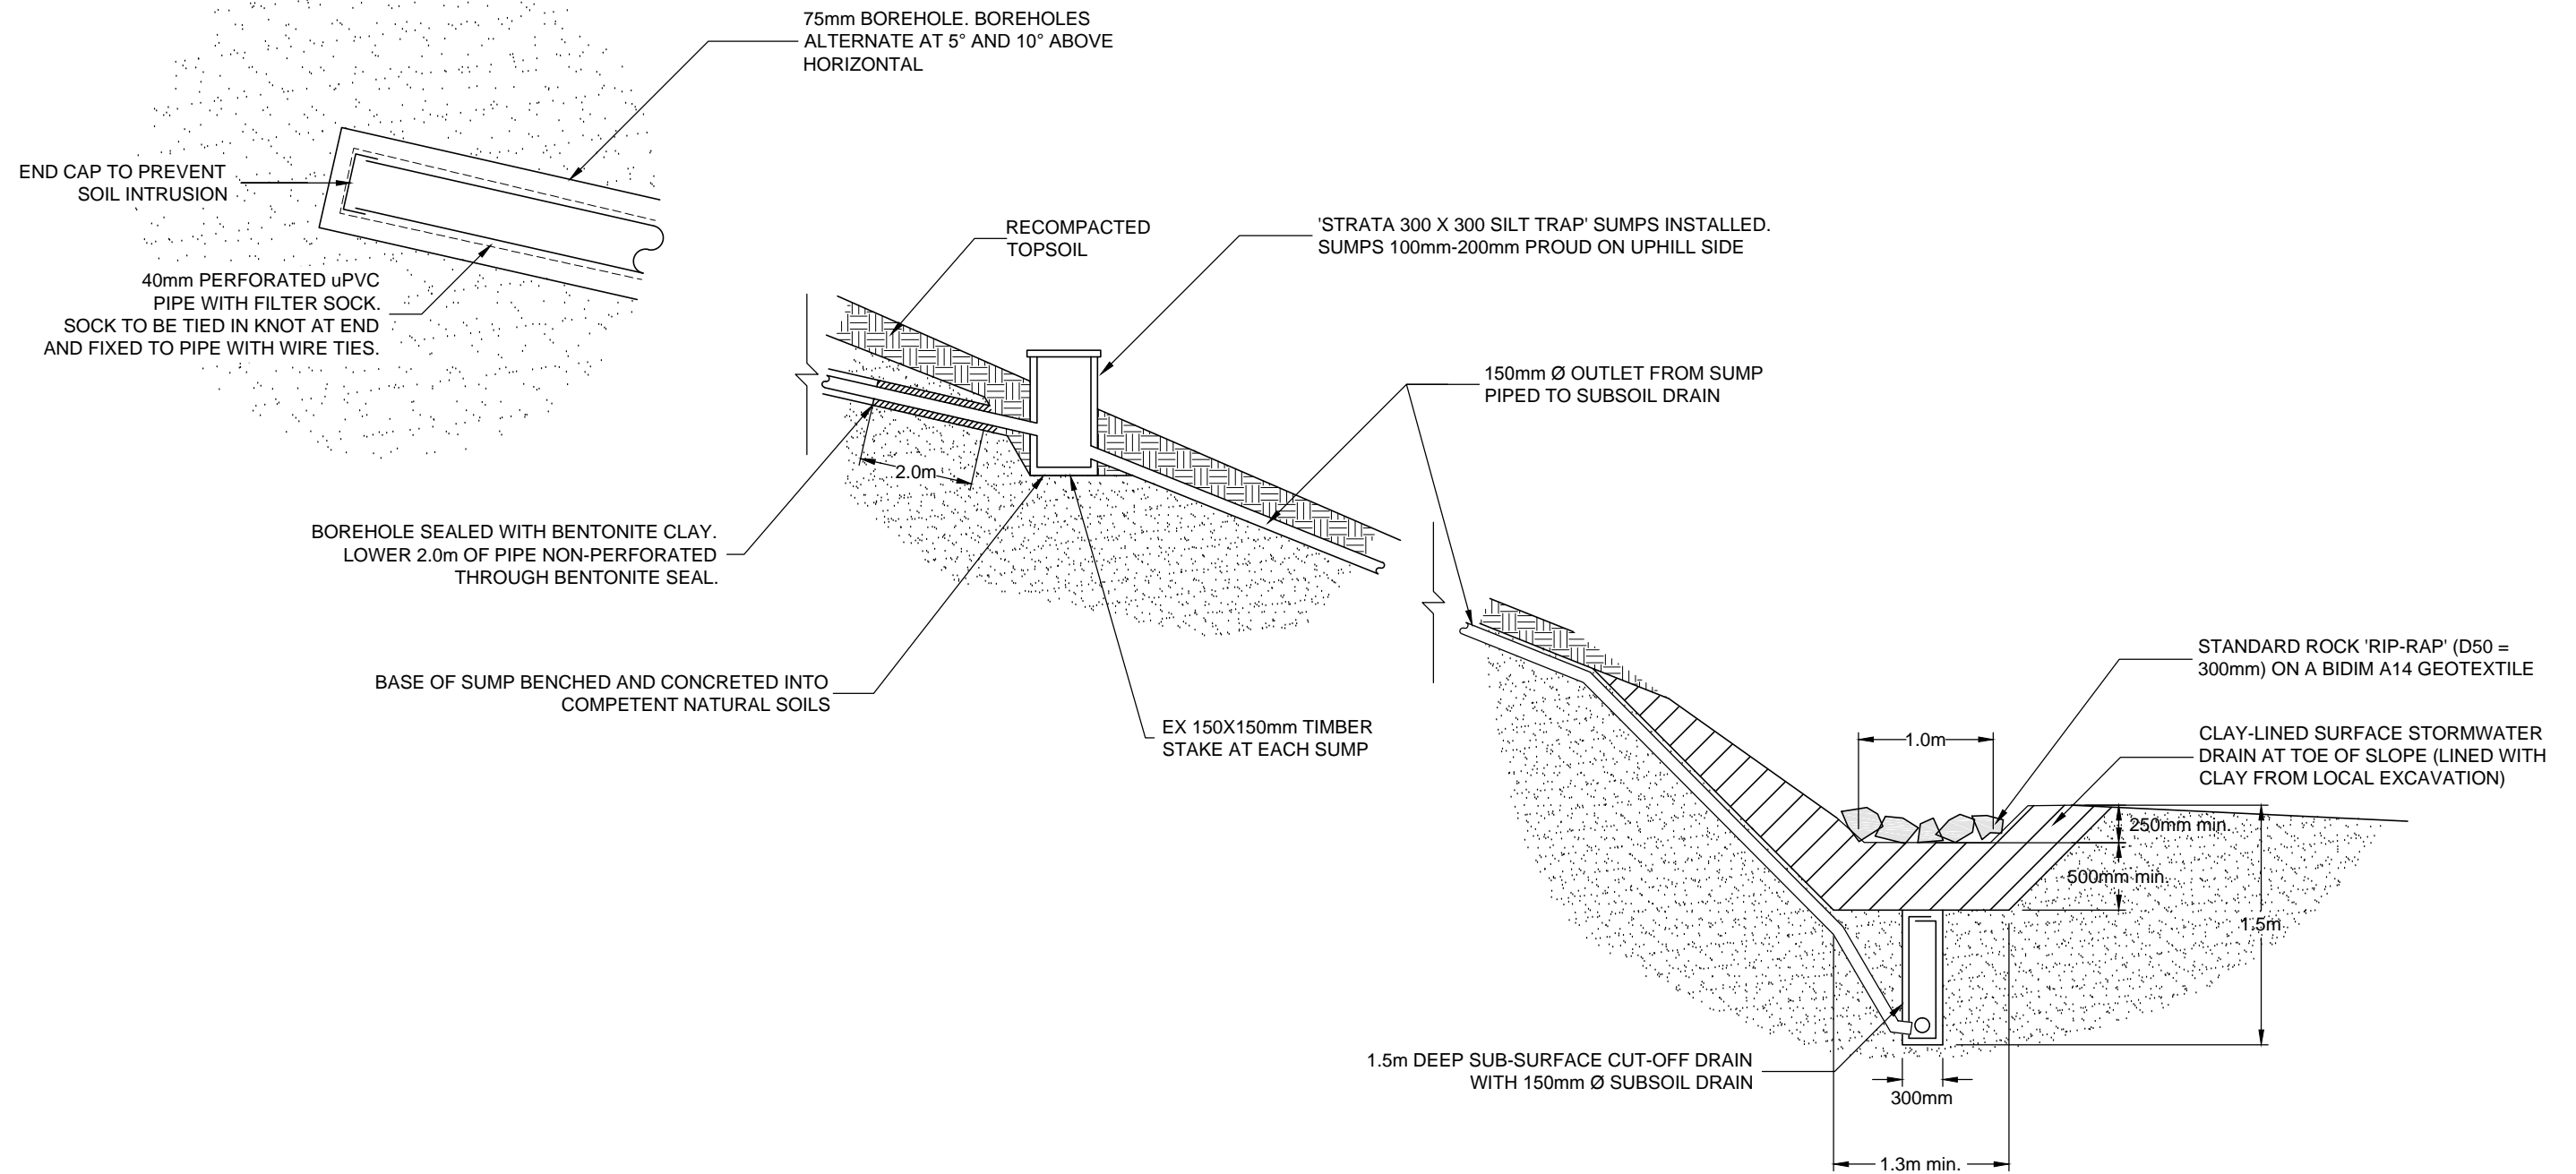

revision	rev	description	drawn	approved	date	drawn	AIP		client:	THE LAKES (2012) LTD				
						approved	RBT		project:	THE LAKES SUBDIVISION STAGE 3 - ZONE 1 WESTERN BATTER DRAINS				
						date	29/4/2015		title:	AS BUILT DRAWING				
						scale	NTS		project no:	GENZTAUC13086AF-A1	figure no:	2	rev:	B
						original size	A3							