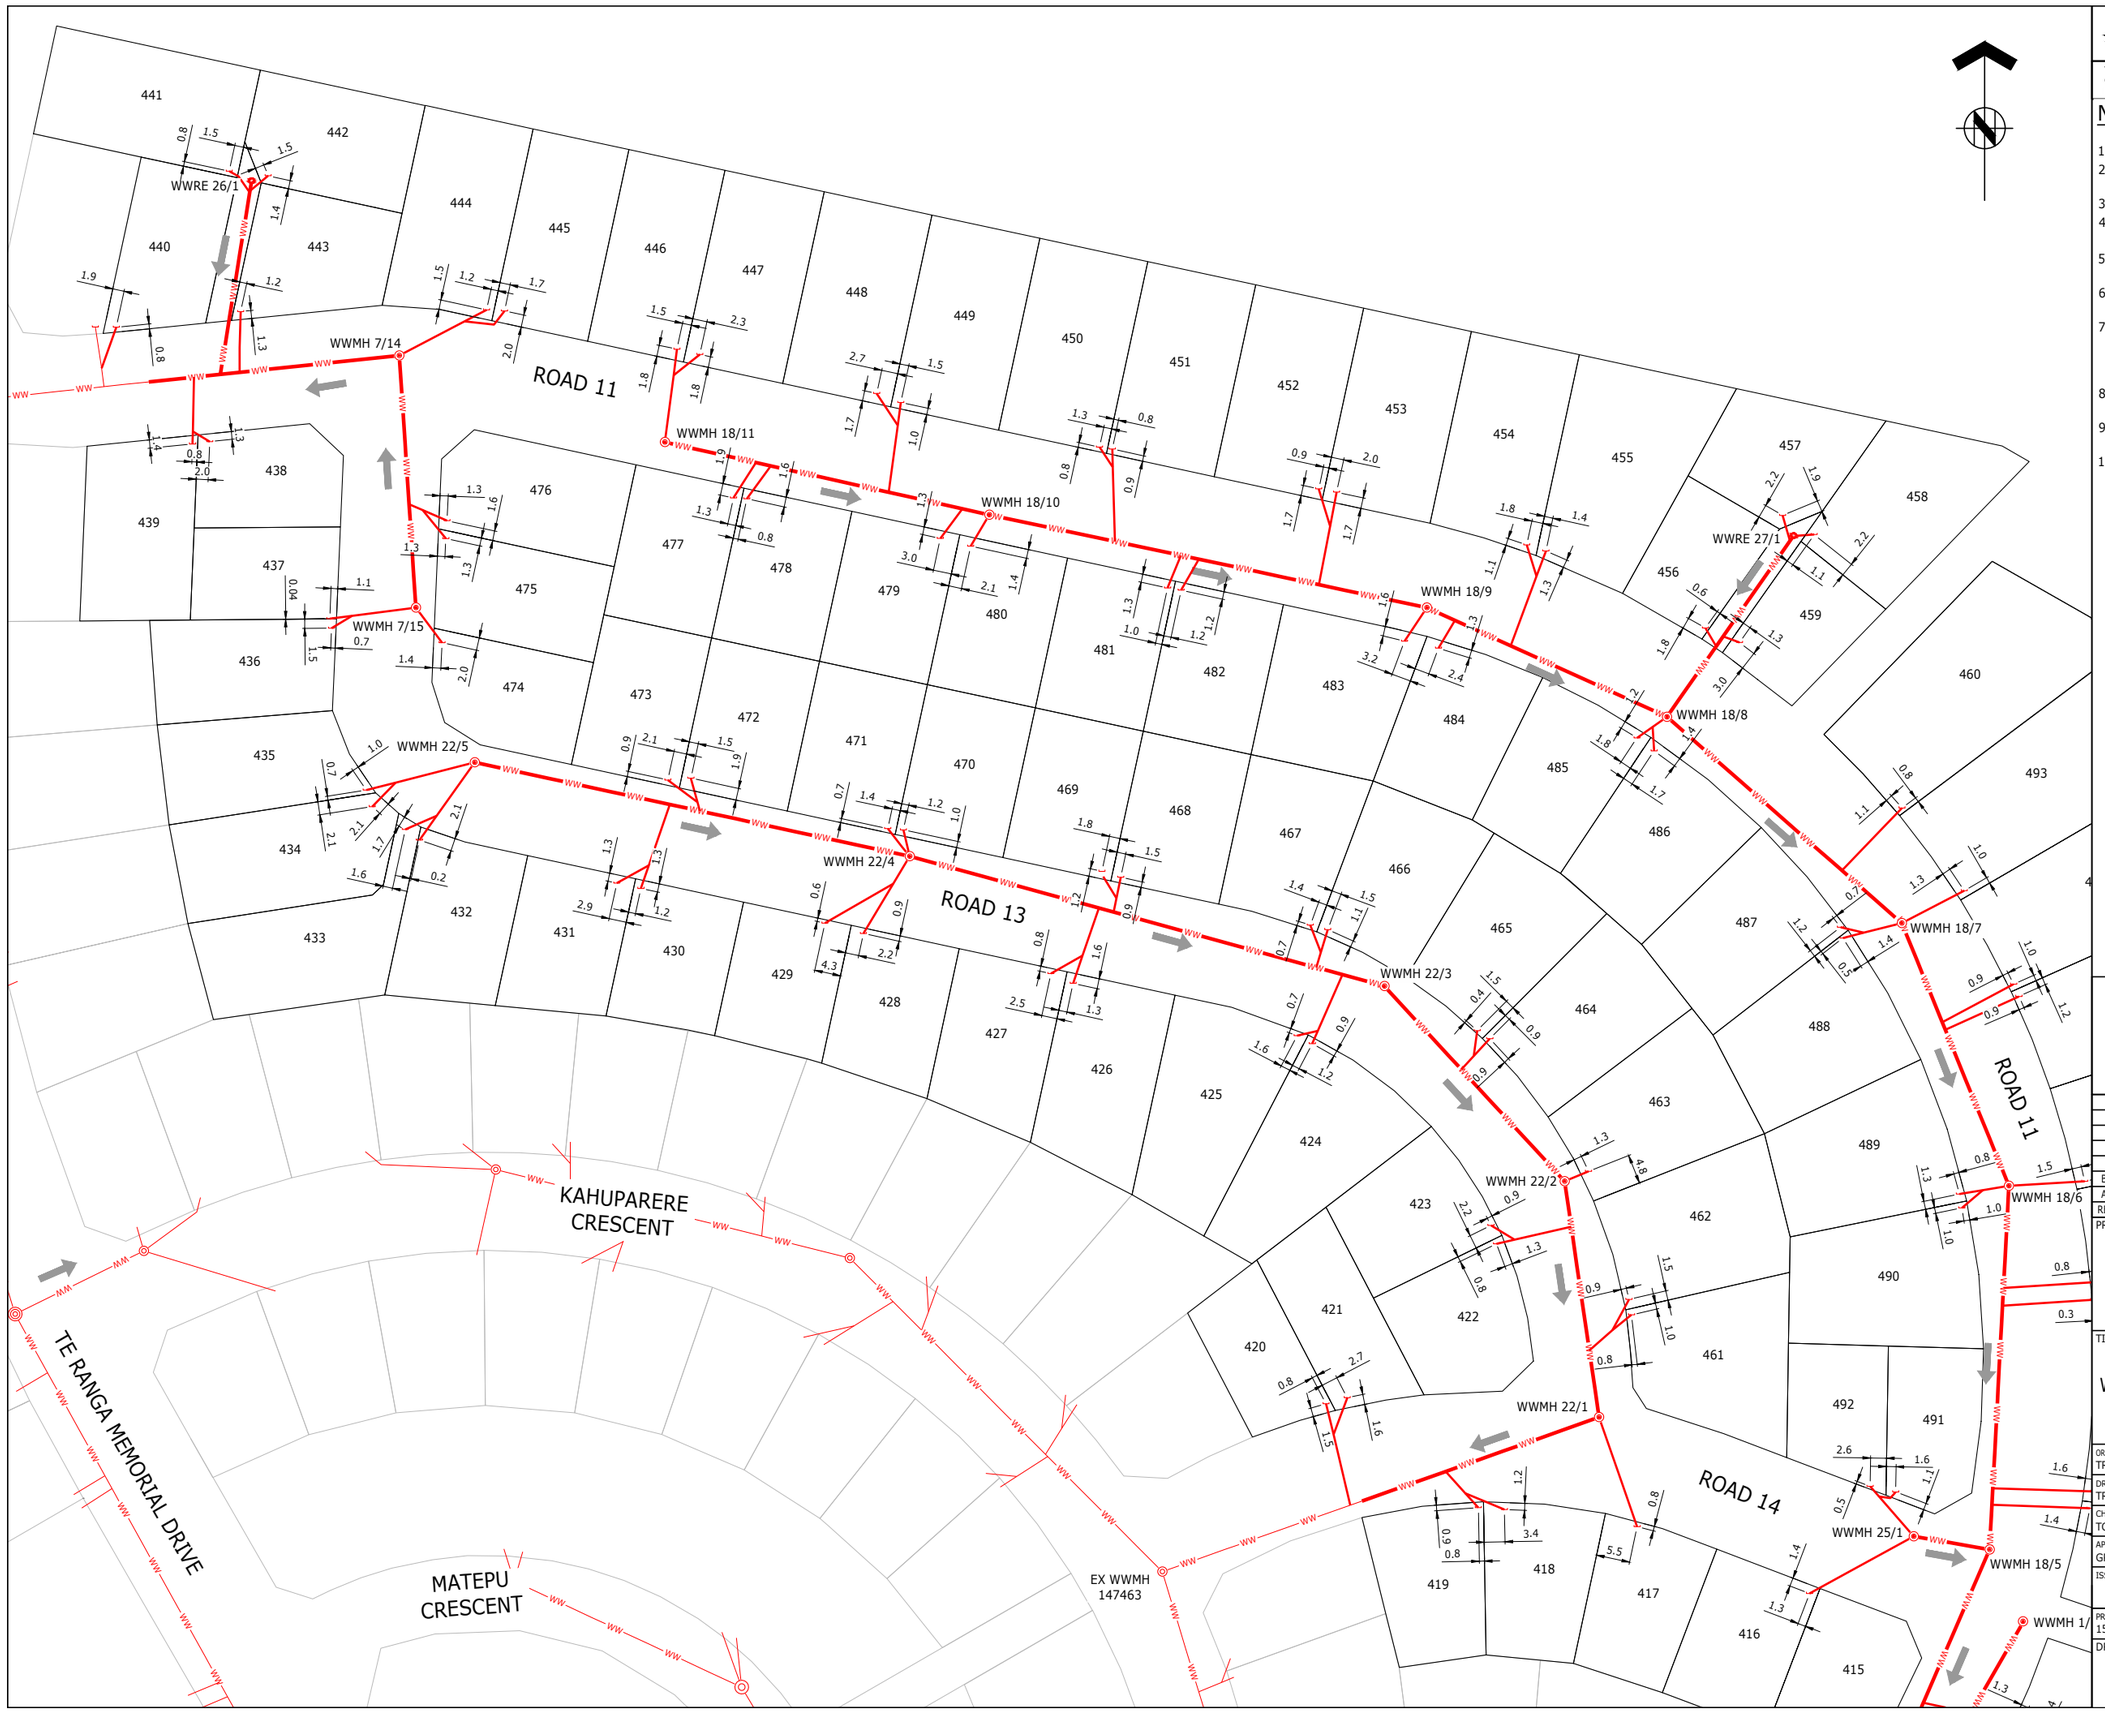

ASSOCIATION OF CONSULTING ENGINEERS NEW ZEALAND

ISO 9001 QUALITY ASSURED

THIS DRAWING AND DESIGN REMAINS THE PROPERTY OF, AND MAY NOT BE REPRODUCED OR ALTERED, WITHOUT THE WRITTEN PERMISSION OF HARRISON GRIERSON CONSULTANTS LIMITED. NO LIABILITY SHALL BE ACCEPTED FOR UNAUTHORISED USE OF THIS DRAWING.

NOTES:

1. LEVELS ARE IN TERMS OF THE MOTURIKI DATUM.
2. ORIGIN OF LEVELS TCC BENCHMARK BM 1070 RL 55.865m.
3. METHOD OF SURVEY: GPS
4. ALL WORKS WERE CARRIED OUT TO TCC IDC 2011 STANDARDS.
5. ALL WASTEWATER MAINS ARE 150mm uPVC PIPES UNLESS SHOWN OTHERWISE.
6. ALL WASTEWATER MAINS ARE SN16 UNLESS SHOWN OTHERWISE.
7. ALL WASTEWATER CONNECTIONS ARE 100mm NB uPVC, UNLESS UNDER CARRIAGEWAY WHERE 150mm NB uPVC ARE USED, AND LOTS 493-503, WHICH HAVE 150mm NB uPVC TO THE BOUNDARY.
8. ALL MANHOLES ARE 1050mm DIA UNLESS OTHERWISE SHOWN.
9. ALL DEEP DRAINAGE CONNECTIONS ARE RAMPED UP TO WITHIN 1.5m OF SURFACE.
10. ALL BURIED AS BUILT INFORMATION SUPPLIED BY HIGGINS CONTRACTORS LTD.

LEGEND:

- AS BUILT WASTEWATER
- EXISTING WASTEWATER
- AS BUILT WASTEWATER CONNECTION
- AS BUILT MANHOLE
- EXISTING MANHOLE
- AS BUILT RODDING EYE
- FLOW DIRECTION

TAURANGA OFFICE
LEVEL 1, 60 SPRING STREET
TAURANGA 3110
T +64 7 578 0023
W www.harrisongrierson.com

B	AS BUILT FINAL	TRS	22.02.17
A	AS BUILT DRAFT	TRS	08.02.17
REF	REVISIONS	BY	DATE

PROJECT:

Summit

THE LAKES (2012) LTD.

TITLE:

STAGES 3GH

WASTEWATER RETICULATION AS BUILT PLAN

SHEET 1

TCC IP 101696

ORIGINATOR: TRS	DATE: 08.02.17	SIGNED:	PLOT BY: TRS
DRAWN: TRS	DATE: 08.02.17	SIGNED:	PLOT DATE: 22.02.17
CHECKED: TCH	DATE: 22.02.17	SIGNED:	SURVEY BY:
APPROVED: GPR	DATE: 22.02.17	SIGNED:	SURVEY DATE:

ISSUE STATUS: AS BUILT

PROJECT No: 1500-138804-01

SCALES: 1:500 - A1, 1:1000 - A3

A1

DRAWING No: 138804-AB211

REV B