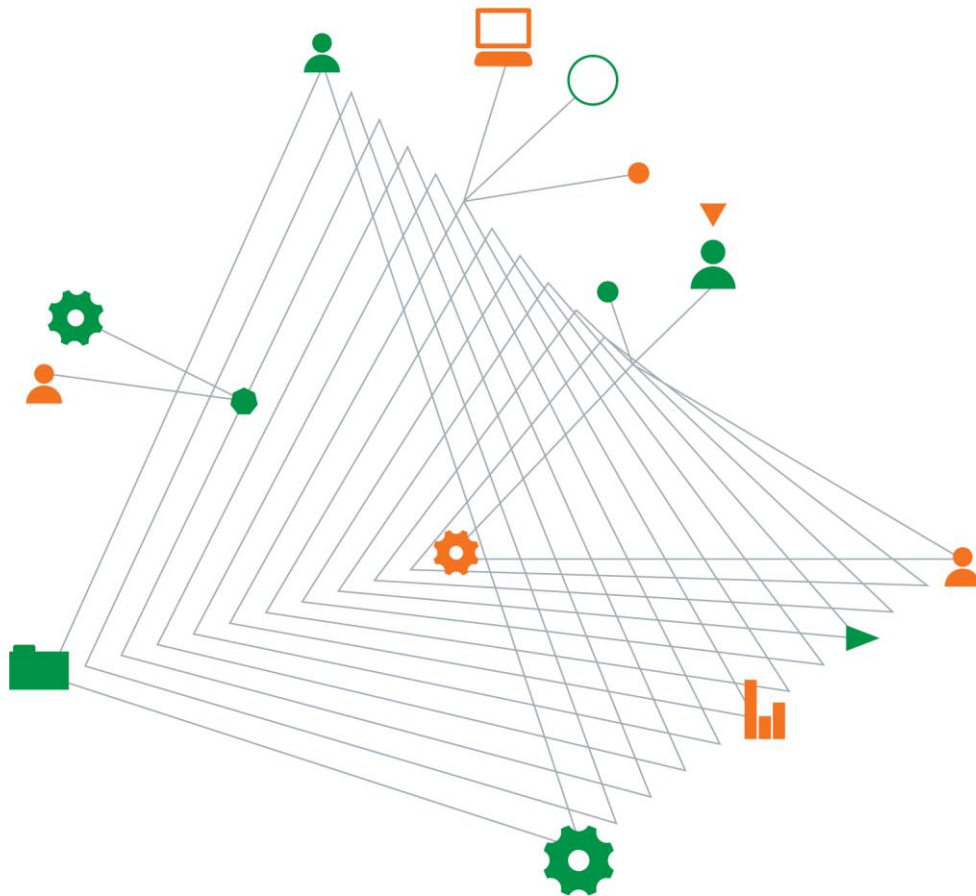


The Lakes (2012) Ltd

The Lakes - Stage 3I

Geotechnical Completion Report

19 January 2018



Experience
comes to life
when it is
powered by
expertise

This page has been left intentionally blank

The Lakes - Stage 3I

Prepared for
The Lakes (2012) Ltd
C/- Harrison Grierson Consultants Ltd
PO Box 13 025
Tauranga 3141
Tauranga

Prepared by
Coffey Services (NZ) Ltd
96 Cameron Road, Tauranga
Tauranga Central 3110 New Zealand
t: +64 7 577 42866081

19 January 2018

Document authorisation

Our ref: GENZTAUC13086AP-AM

For and on behalf of Coffey



Robert Telford
Associate Engineering Geologist

Quality information

Revision history

Revision	Description	Date	Author	Reviewer	Signatory
0	Draft for review	8/12/2018	RBT		
A	Final	19/1/2017	RBT	DAS	RBT

Distribution

Report Status	No. of copies	Format	Distributed to	Date
Final	1	PDF	The Lakes (2012) Ltd	19/1/2018
Final	1	PDF	Harrison Grierson Consultants Ltd	19/1/2018

Table of contents

1.	Introduction & Scope	1
2.	Description of Subdivision	1
3.	Related Reports.....	2
4.	Investigations Completed	2
5.	Earthworks Operations	3
5.1.	Plant	3
5.2.	Construction Programme	3
5.2.1.	2007 – 2008	3
5.2.2.	2014 to 2017 Earthworks Seasons	3
6.	Quality Control	4
6.1.	Site Preparation Observations	4
6.2.	Fill Control	4
6.2.1.	Compaction Control Criteria.....	4
6.2.2.	Test Results	4
7.	Engineering Evaluation	5
7.1.	Fill Quality.....	5
7.2.	Static Settlement	5
7.3.	Slope Stability.....	5
7.3.1.	Eastern Slope	5
7.3.2.	Western Slope.....	6
7.3.3.	Lot 537.....	6
7.4.	Liquefaction	6
7.5.	Maximum Excavation Depths.....	7
7.6.	Foundation Design & Bearing Capacity	7
7.6.1.	Lots 522 to 533, 535 and 536	7
7.6.2.	Remaining Lots	7
8.	Additional Works.....	7
8.1.	Western Slope Walkway	7
8.2.	Pond 2	8
8.3.	Noise Fence	8
8.4.	Lot 588	8
9.	Variable Ground Conditions	8
10.	Re-Subdivision	8
11.	Conclusion.....	9
12.	Limitations	9

Important information about your Coffey Report

Appendices

Appendix A - Figures

Appendix B - Geotechnical Suitability Statement & Geotechnical Data Summary Table

Appendix C - Pre Development Investigation Data

Appendix D - Post Development Investigation Data

Appendix E – Fill Test Summary Tables

Appendix F – Static Settlement Results

Appendix G – Harrison Grierson Drawings

1. Introduction & Scope

This Geotechnical Completion Report (GCR) has been prepared by Coffey Services (NZ) Ltd (Coffey) for the Lakes (2012) Limited following completion of earthworks for Stage 3I of the Lakes Subdivision and in general accordance with the conditions of Council resource consent number RC21332.

This GCR contains the results of site investigations together with as-built plans derived from Harrison Grierson Consultants Ltd (HGCL) topographical data. It describes bulk earthworks completed during the 2007-2008, 2014-2015, 2015-2016 and 2016-2017 earthworks seasons. It also summarises minor works completed within the development area such as walking tracks, a debris bund and a permanent stormwater pond ('Pond 2').

The extent of earthworks observed by Coffey is shown on the appended plans (Figures 1 to 5, Appendix A). A Statement of Professional Opinion (Form G2) and Summary of Technical Data (Form G3) for the works described herein are also appended.

2. Description of Subdivision

Stage 3I of the Lakes subdivision is located near the intersection of Pyes Pa Road and Takitimu Drive (State Highway SH26) in Pyes Pa, Tauranga. The site location and original ground contours are shown on Figure 1 in Appendix A. Stage 3I consists a total of 85 lots new residential lots with associated reserves, roads and easements.

Before earthworks began, Stage 3I consisted of a low-lying valley orientated in a north-south direction parallel to Pyes Pa Road. The valley was bounded by steep slopes to the north, west and east. The valley originally extended to the south beyond the 3I boundary but this area was infilled during construction of Takitimu Drive (State Highway SH36). The southern boundary of Stage 3I is now marked by the highway.

During the 2007 to 2008 earthworks season, major works were undertaken within the Lakes area and to form the Takitimu Drive road alignment. These earthworks included placement of up to 15m of filling within the stage 3I area to form the current highway embankment. Cut and fill contours for these works are shown on Figure 2. The post earthworks ground surface (surveyed in 2010) is shown on Figure 3.

Earthworks recommenced in the summer of 2014-2015 with the placement of fill in the in the valley of Stage 3I. Filling continued during the 2015-2016 work season as further cut material was sourced from other stages within the Lakes Development. The ridge at the northern end of Stage 3I (referred to as the 'spur ridge' on the site plans) was excavated at this time. The total cut and fill contours from these work seasons are shown on Figure 4.

Earthworks were also carried out to form a permanent stormwater pond near the northern end of the stage (Pond 2), a debris bund along the toe of the eastern slope below Pyes Pa Road and a network of walking tracks on the slope to the west of the stage. Two earth-fill buttresses were also constructed below the collector road that accesses the site from the west. These structures are discussed in more detail elsewhere in this report.

Civil infrastructure for Stage 3I of the subdivision was installed in 2016 and 2017. The 2017 finished ground surface is shown on Figure 5.

3. Related Reports

The following documents were prepared prior to or during the design and development of Stage 3I:

1. *'Pyes Pa West Urbanisation Development, Tauranga – Geotechnical Assessment Report'*, report prepared by S&L Consultants Ltd (Ref: 16944, dated October 2003).
2. *'Geotechnical Investigation Report for the Lakes Subdivision – Stage 3 Zone 2 at Pyes Pa, Tauranga'*, report prepared by Coffey (Ref: GENZTAUC13086AK-AC, dated 7 April 2014).
3. *'Slip Debris Volume Calculations for Western Slope, The Lakes Subdivision Stage 3 – Zone 2'*, memo prepared by Coffey (Ref: GENZTAUC13086AK-AD, dated 27 March 2014).
4. *'The Lakes Stage 3 - Zone 3, Geotechnical Investigation Report (Addendum 1)'*, report prepared by Coffey (Ref: GENZTAUC13086AQ-AB, dated 10 July 2015).

The original geotechnical assessment for the Lakes subdivision was completed by S&L Consultants Ltd and contained an overview of geotechnical conditions for the entire Lakes project. The report concluded that the site was generally adequate for subdivision and residential development, subject to appropriate design and construction methods.

Subsequent geotechnical investigation reports by Coffey in April 2014 and July 2015 summarised additional investigations that were completed to specifically assess the Stage 3 area. These investigations generally confirmed the S&L conclusion that the site was adequate for subdivision. The Coffey assessments provided additional detail around potential slope stability risks, likely static settlements beneath the proposed fill areas and the risk of earthquake induced liquefaction within the development.

4. Investigations Completed

Geotechnical investigations have been undertaken on this and adjacent sites during each stage of the Lakes subdivision's design and construction. The investigations used for this report are listed below. Logs of each investigation are included in Appendix C.

2013 - 2014

- Four machine boreholes drilled to a maximum depth of 20.0m across the site. Standard Penetration Tests (SPT) were carried out at 1.5m intervals (Coffey, MH302 to MH305 on Figure 3);
- Thirteen Cone Penetrometer Tests to depths between 6.5 and 15.0 meters below the existing ground level using a truck mounted rig supplied by Geotech Drilling Limited (Coffey, CPT301 to CPT313 on Figure 3);
- Twenty-one trial pits excavated to a maximum depth of 5.8m depth to assess near surface soils and, particularly peat lenses within the floor of the Stage 3I valley (Coffey, TP301 to TP305 and TP308 to TP323 on Figure 3);
- Eight hand-auger boreholes drilled to a maximum depth of 5.0m (Coffey, HA304 to HA308, HA311 to HA312 and HA314 on Figure 3);

2015

- Fourteen hand-auger boreholes drilled to a maximum depth of 5.2m (Coffey, HA01-AQ to HA11-AQ and HA13-AQ to HA15-AQ on Figure 3).

On completion of the bulk earthworks in 2016, Coffey drilled a total of 162 hand-auger boreholes to assess finished subgrade conditions within the new lots. The locations of these boreholes are shown

on Figure 5. Although labels are not shown on the plan, the boreholes are numbered according to the relevant lot number. For example, the hand auger borehole on Lot 532 is referred to as HAL532. Boreholes located on the boundary between two lots are referenced with the lot number of both lots (e.g. HA152-153). Logs of these boreholes are included in Appendix D.

5. Earthworks Operations

5.1. Plant

Earthworks during the 2007-2008 season were completed by Bob Hicks Earthmovers Ltd. The earthworks contractor for the 2014-2017 period was JMC Civil Construction Ltd (JMC) and civil infrastructure was installed by Higgins Group Holdings Ltd (Higgins).

The main items of plant used during each of the bulk earthworks phase comprised motor-scrapers and bulldozer or tractor towed 'scoops', hydraulic excavators, bulldozers, articulated all-terrain dump trucks (ADT's) and sheep's-foot rollers.

5.2. Construction Programme

5.2.1. 2007 – 2008

Under ownership of Grasshopper Farms Ltd, earthworks during this period included filling of up to 15m under the lots at the southern extent of Stage 3I. This fill formed part of the construction for the Takitimu Drive road alignment. The fill materials were sourced from outside the Stage 3I area.

Fill compaction testing for the highway was carried out by Coffey.

5.2.2. 2014 to 2017 Earthworks Seasons

In 2012 ownership of the Lakes subdivision passed from Grasshopper Farms Ltd to The Lakes (2012) Ltd. Earthworks under The Lakes direction began in 2014. The early works included the excavation of peat lenses and colluvial soils which were identified by Coffey's site investigations. From late 2014, filling commenced in the valley with material sourced from other earthworks stages within the Lakes Development. Filling continued during early 2015 and into the 2015-2016 earthwork period that followed. In total up to 5m of fill was placed across the valley floor as shown on Figure 4.

In October and November of 2015, topsoil stripping of the western slope in the vicinity of the earth fill buttresses and the spur ridge to the north of Stage 3I took place, followed by the excavation of the spur ridge into the summer of 2015-2016. Although not shown on Figure 4, some lots in the area of the spur ridge were excavated below finished ground level and then filled to current levels. Reference should be made to the borehole logs in Appendix D to confirm specific ground conditions in this area.

The two buttress fills were constructed on the western slope during March and April of 2016. Minor excavations were also carried out above these buttresses to reduce overall slope gradients. Cut and fill depths from these earthworks can be seen on Figure 4.

Construction of the debris bund along the eastern site boundary took place in stages from late 2015, beginning at the northern end of Stage 3I. The fill contour depths between the toe of the eastern slope and the adjacent lot boundaries can be seen in Figure 4 and the extent of the completed debris bund is shaded on Figure 5.

The installation of civil infrastructure and the construction of the western slope walking tracks were completed by Higgins in 2017.

6. Quality Control

6.1. Site Preparation Observations

During 2014-2017, Coffey undertook regular observations of fill areas to ensure topsoil, vegetation or unsuitable materials had been removed before filling. Coffey also provided laboratory testing services for the earlier earthworks during construction of the Takitimu Drive embankment.

6.2. Fill Control

The fill placed within Stage 3I in the 2007-2008 earthworks season was tested using a Nuclear Density Meter (NDM), laboratory moisture content and undrained shear strength tests. NDM tests from 2014 onwards were undertaken by Fulton Hogan on behalf of JMC Limited. Undrained shear strength tests or Dynamic Cone Penetration Tests (DCP or 'Scala') were also carried out, depending on the fill being tested.

The locations of tests completed in 2007-2008 are shown on Figure 2, with test results represented with the letter 'A' (e.g. A-319). Tests undertaken from 2014 onwards are shown on Figure 4, with test results represented with the letter 'B' (e.g. B-157).

6.2.1. Compaction Control Criteria

The compaction control criteria for this project were specified using the 'minimum allowable shear strength and maximum allowable air voids' method as defined below:

- Air voids percentage (defined in NZS 4402:1986 and as measured by NDM) targeting an average value less than 10% over any 10 consecutive tests and maximum single value no greater than 12%.
- Undrained shear strength measured by hand held shear vane calibrated using the NZGS 2001 method. A single undrained shear strength 'test' was defined as the average of four individual shear vane readings at each NDM location. The target test values were an average value greater than 150kPa and minimum single value no less than 140kPa.

6.2.2. Test Results

Summary tables showing the results of the laboratory fill tests for bulk earthworks at Stage 3I are included in Appendix E and the locations of the tests are shown on Figures 2 and 4. The majority of tests met or exceeded the compaction control criteria given above. Failed tests are shown in red on the relevant figures.

All tests undertaken during the 2007-2008 earthworks period were deemed to have met the above criteria. Fourteen tests during the 2014-2017 season did not meet the required test values.

Following the failed results the filling at test locations B-37, B-60A, B-61A, B-64A, B-70 and B-71 was reworked and retested. The filling at test locations B-45, B-137, B-255, B-259, B-260, B-263, B-290 and B-292 was observed by Coffey using either test pits or hand-auger boreholes. It was concluded that the 'failed' results in these areas were due to variable sand content within the fill leading to inaccurate shear strength or DCP results.

7. Engineering Evaluation

7.1. Fill Quality

Based on the appended earth fill quality control test data and reliance on the diligence of the bulk earthworks contractor at times when engineering staff were not present on site, results indicate that the compaction control criteria were generally met during the bulk earthworks periods.

It should be understood however that, due to the variability of the source materials used, it is possible that discrete pockets or layers of less than optimally compacted fill or sensitive natural soils may be encountered within individual lots. Any questionable or unsuitable ground conditions encountered during construction and/or during the normal Council site inspections must be brought to the attention of a geotechnical engineer.

7.2. Static Settlement

Most of the Stage 3I area is located on engineered filling placed over variable alluvial soils. Static settlements beneath the filling were monitored at a total of eleven survey points shown as 'SM1' to 'SM11' on Figure 4. The monitoring points consisted of steel rods attached to plates installed at the base of the filling. Plots of the data for these points are provided in Appendix F.

The individual points were surveyed for a period of at least 6 months and until the data at each location indicated consolidation settlements were effectively complete (i.e. 'T90'). Most points were then monitored for a further 6 to 12 months to assess the long term 'creep' or residual settlements at each location.

The data indicate that total settlements beneath the majority of the filled area ranged from approximately 20mm to 90mm (SM1 to SM9) over the monitoring period. At the northern end of the site, pre-subdivision analyses indicated that Lots 532, 543 and 544 may be affected by significant differential settlements as these lots spanned across the boundary between filling and excavated ground. These lots were therefore surcharged with 2m of loose fill (equivalent to approximately 25kPa) between March 2016 and February 2017. Data from SM10 and SM11 indicate the filling and surcharge induced up to 150mm of total settlement within these lots.

The probable long-term residual settlements (i.e. 'creep') at each of the monitoring locations have been assessed by extrapolating the settlement data out for a period of 50 years. These calculations indicate likely total residual settlements within Stage 3I will be less than 50mm. Differential settlements within each of the new lots are expected to be less than 25mm per 6m horizontal length and within the maximum limits required by the New Zealand Building Code and Tauranga City Council Infrastructure Development Code.

7.3. Slope Stability

The stability of slopes within and adjacent to Stage 3I was assessed during the initial pre-subdivision site investigation. Three possible areas of instability were identified and are discussed below.

7.3.1. Eastern Slope

This slope rises approximately 15m above the site's eastern boundary to Pyes Pa Road. Along most of its length the slope below Pyes Pa Road is in its natural or pre-subdivision state and was not significantly altered as part of this development. The southern end was cut into an approximately 1V:2.5H (22°) batter during construction of the nearby highway in 2007-2008. The northern end was also cut into a 1V:2.5H batter with an approximately 10m wide bench half-way up during the 2015-2016 work season.

Several previous landslides were identified along the natural part of the eastern slope during the site assessment in 2014. Subsequent analyses indicated this slope may have a low factor of safety during

elevated groundwater (i.e. storm) and seismic conditions. A debris bund consisting of nominally compacted earth fill was therefore constructed at the foot of this slope to reduce the risk to adjacent lots. The completed bund is shown on Figure 5.

The cut batters at the northern and southern ends of the slope are considered adequately stable for residential development below this slopes. No additional protection measures were considered necessary in these areas.

7.3.2. Western Slope

This approximately 35m high escarpment rises to the west of the site and up to previous stages of the Lakes subdivision. This slope is also understood to have a low factor of safety under elevated groundwater and seismic conditions. However, analyses by Coffey during the planning stages of Stage 3I indicated that, in the event of instability, the debris from this slope would likely be contained within the stream channel at the foot of the escarpment. The debris would not be expected to impact on the nearby properties.

This slope also underlies the collector road connecting Stage 3I with the previous Lakes stages. Analyses indicated that parts of the slope below the road were overly steep in their previous state and were not sufficiently stable to support this key access. Two earth-fill buttresses were therefore designed in this area and were constructed from engineered fill during the Stage 3I works. The buttress fills are shown on Figure 4. The steeper natural slopes above these buttresses were also re-graded (cut) to a more stable slope angle.

Stability calculations indicated that the buttress fills and minor regrading of the natural slopes were sufficient to achieve minimum factors of safety of 1.5 under prevailing groundwater conditions, 1.2 under elevated groundwater conditions and 1.0 under seismic loads as required by the TCC IDC.

7.3.3. Lot 537

Lot 537 at the northern end of the development is located above a steep slope which falls approximately 5m to the Nanako Stream. Any future development works including construction or filling within 5m of the crest of this slope must be approved by a geotechnical engineer (TCC Category 1 or 2). A Building Restriction Line (BRL) has been defined on this lot and is shown on Figure 5 to illustrate this area.

Stormwater from paved or impermeable surfaces including roofs and driveways on this lot must also be directed away from the slope and BRL.

7.4. Liquefaction

The Geotechnical Investigation Report for this stage of the Lakes subdivision concluded that there was a low risk of significant liquefaction within Stage 3I during a 1 in 25 year return period earthquake (equivalent to the Serviceability Limit State of 'SLS' event for residential development). There is a moderate to high risk of liquefaction during a 1 in 500 year event (i.e. the Ultimate Limit State or 'ULS' earthquake) within lots underlain by alluvial soils.

However, the finished lots which may be affected by liquefaction are now underlain by between 2m and 5m of engineered filling. This crust of non-liquefiable material would be expected to reduce the effects of liquefaction as observed at the ground surface and the majority of the new lots are therefore considered adequate for dwellings designed to current New Zealand standards and NZS 3604.

The exception to this is the lots adjacent to Pond 2 (Lots 522 to 533, 535 and 536), where the analyses indicated a possible risk of horizontal ground deformation or 'lateral spreading' around the pond embankments. The dwellings on these lots should be supported on specifically designed foundations which are capable of safely supporting up to 500mm of horizontal stretching beneath the building platform. Foundation design recommendations are given in Section 7.6 below.

7.5. Maximum Excavation Depths

Based on the results of the earthworks testing and subsequent post-subdivision testing by Coffey, the finished subgrade conditions within Stage 3I are considered adequate for residential development with excavations to a maximum of 1.5m depth below current ground level.

Any future development which entails excavations of more than 1.5m depth below current ground levels must be subject to additional investigation and assessment by a TCC Category 1 or 2 Geo-Professional at the design/building consent stage. The additional analyses should confirm the bearing capacity of founding soils and parameters for the specific design of retaining walls where required.

7.6. Foundation Design & Bearing Capacity

7.6.1. Lots 522 to 533, 535 and 536

As discussed above, dwellings on Lots 522 to 533, 535 and 536 must be supported by specifically designed foundations which can safely support up to 500mm of horizontal ground stretching in the event of a ULS earthquake. Solutions may include the 'enhanced foundation slab' options developed for the TC2 area of the Canterbury Rebuild.

These foundations may be designed for a geotechnical ultimate bearing capacity of 300kPa.

7.6.2. Remaining Lots

Subject to the maximum excavation depths discussed in Section 7.5, the subgrade conditions beneath the remaining lots are adequate for shallow foundations designed in accordance with NZS 3604 or for 'waffle-slab' type foundations (e.g. Rib-raft). A geotechnical ultimate bearing capacity of 300kPa may be assumed for these foundations.

8. Additional Works

In addition to the bulk earthworks, several minor structures have also been constructed within the development area and for which Coffey provided geotechnical advice or observations. These structures are summarised below.

8.1. Western Slope Walkway

A network of pedestrian walkways have been constructed on the western slope to connect Stage 3I with previous stages of the Lakes subdivision. The walkways are shown on Harrison Grierson drawings ref: 139618-AB401 to -404 Appendix G. Typical cross sections and construction details are shown on drawing 137845-01-668.

The northern section of the walkway (approx. CH490m to CH650m on drawing AB404) follows the alignment of a pre-existing farm track. Construction of this section required only minor earthworks to level the existing track and to install stormwater drainage. Stormwater from the drains is directed to a series of culverts beneath the path and then piped to disposal points below any steep slopes.

The middle walkway section (approx. CH490m to CH300m on drawing AB404) was formed across the foot of a steep slope and does not follow a pre-existing alignment. The width of the track on this section has therefore been reduced to 0.75m to minimise excavations into the slope which may otherwise lead to instability. As shown on drawing 668 (detail B) the path has been graded so that stormwater 'sheet-flows' off the track and is not concentrated on the slope below.

The southern walkway section (CH0 to CH300 on drawing AB404) follows a natural, gently sloping bench or terrace approximately mid-way up the western slope. This portion of the walkway required only minor earthworks to create a level surface with minimal excavation into the slope.

8.2. Pond 2

The completed structure for Pond 2 is shown on HGCL drawings 135952-AB401 to –AB403 and –AB411 in Appendix G. The southern and eastern pond embankments were constructed from non-structural filling placed during the main Stage 3I earthworks. The northern end of the pond was excavated into natural soils. The western pond embankment was formed from engineered fill.

The original pond design include a clay core along the embankment length. Testing and observations by Coffey however indicated that the general fill materials used were placed and compacted to achieve an acceptably low permeability for the pond design. The clay core was therefore not installed.

Settlements below the western embankment were monitored at three locations for a period of six months from April to October 2016. The monitoring points are shown as SM12 to SM14 on Figure 4 and the surveyed data for these points are presented in Appendix F. The results show the embankment did not settle significantly over the survey period. Future long-term settlements below the pond embankment are also expected to be minimal.

8.3. Noise Fence

A timber noise-fence has been constructed along the boundaries of Lots 577 to 588 and the adjacent highway. This fence was designed by others. It is understood that the as-built drawings and completion documents will be provided by Harrison Grierson.

The fence has been designed and built with a 50mm to 100mm gap at ground level to avoid collecting or concentrating stormwater from the batter below the highway. Future owners will need to maintain this gap.

8.4. Lot 588

As well as the noise-fence, an approximately 3m high timber pole retaining wall has been constructed around the western and northern boundaries of Lot 588. This wall was designed by Coffey. The design calculations included a 12kPa surcharge to account for future development or vehicle loads on this site.

Coffey has undertaken observations and testing during the construction of the retaining wall. A separate construction report and producer statement (PS4 – Construction) will be provided in due course to be added to the property file.

9. Variable Ground Conditions

It should be understood that due to the volcanic nature of the natural soils on this site, it is possible that local soil conditions may vary from those discussed above. It is therefore important that any potentially soft or unsuitable soils encountered in the foundation excavations are brought to the attention of a geotechnical professional.

10. Re-Subdivision

Per the Section DS-10.12 of the TCC IDC, any re-subdivision or infill subdivision of the lots described in this report will need to be reviewed by a TCC Category 1 Geo-Professional prior to the resource consent application.

11. Conclusion

Based on the observations and investigations presented in this report and with reliance on the diligence of the earthworks contractors, it is concluded that the earthworks and subdivision of Stage 3I of the Lakes development has been completed in general accordance with previous recommendations, NZS 4431 and the Tauranga City Council Infrastructure Development Code.

12. Limitations

This report has been prepared solely for the use of the client, The Lakes (2012) Limited, their professional advisers and the relevant Territorial Authorities in relation to the specific project described herein. No liability is accepted in respect of its use for any other purpose or by any other person or entity. All future owners of this property should seek professional geotechnical advice to satisfy themselves as to its ongoing suitability for their intended use.

The opinions, recommendations and comments given in this report result from the application of normal methods of site investigation. As the post construction factual evidence has been obtained solely from boreholes and test pits, which by their nature only provide information about a relatively small volume of subsoils, there may be special conditions pertaining to this site which have not been disclosed by the investigation and which have not been taken into account in the report.

For and on behalf of Coffey

Report Prepared By:



R TELFORD

Associate Engineering Geologist
TCC Category 1 Engineering Geologist

Report Reviewed By:



D SULLIVAN

Principal Geotechnical Engineer
BSc, MBA, CE (Calif.), MIPENZ, CPEng, TCC Category 1 Geotechnical Engineer
CPEng No. 1025183

Important information about your **Coffey** Report

As a client of Coffey you should know that site subsurface conditions cause more construction problems than any other factor. These notes have been prepared by Coffey to help you interpret and understand the limitations of your report.

Your report is based on project specific criteria

Your report has been developed on the basis of your unique project specific requirements as understood by Coffey and applies only to the site investigated. Project criteria typically include the general nature of the project; its size and configuration; the location of any structures on the site; other site improvements; the presence of underground utilities; and the additional risk imposed by scope-of-service limitations imposed by the client. Your report should not be used if there are any changes to the project without first asking Coffey to assess how factors that changed subsequent to the date of the report affect the report's recommendations. Coffey cannot accept responsibility for problems that may occur due to changed factors if they are not consulted.

Subsurface conditions can change

Subsurface conditions are created by natural processes and the activity of man. For example, water levels can vary with time, fill may be placed on a site and pollutants may migrate with time. Because a report is based on conditions which existed at the time of subsurface exploration, decisions should not be based on a report whose adequacy may have been affected by time. Consult Coffey to be advised how time may have impacted on the project.

Interpretation of factual data

Site assessment identifies actual subsurface conditions only at those points where samples are taken and when they are taken. Data derived from literature and external data source review, sampling and subsequent laboratory testing are interpreted by geologists, engineers or scientists to provide an opinion about overall site conditions, their likely impact on the proposed development and recommended actions. Actual conditions may differ from those inferred to exist, because no professional, no matter how qualified, can reveal what is hidden by

earth, rock and time. The actual interface between materials may be far more gradual or abrupt than assumed based on the facts obtained. Nothing can be done to change the actual site conditions which exist, but steps can be taken to reduce the impact of unexpected conditions. For this reason, owners should retain the services of Coffey through the development stage, to identify variances, conduct additional tests if required, and recommend solutions to problems encountered on site.

Your report will only give preliminary recommendations

Your report is based on the assumption that the site conditions as revealed through selective point sampling are indicative of actual conditions throughout an area. This assumption cannot be substantiated until project implementation has commenced and therefore your report recommendations can only be regarded as preliminary. Only Coffey, who prepared the report, is fully familiar with the background information needed to assess whether or not the report's recommendations are valid and whether or not changes should be considered as the project develops. If another party undertakes the implementation of the recommendations of this report there is a risk that the report will be misinterpreted and Coffey cannot be held responsible for such misinterpretation.

Your report is prepared for specific purposes and persons

To avoid misuse of the information contained in your report it is recommended that you confer with Coffey before passing your report on to another party who may not be familiar with the background and the purpose of the report. Your report should not be applied to any project other than that originally specified at the time the report was issued.

Important information about your **Coffey** Report

Interpretation by other design professionals

Costly problems can occur when other design professionals develop their plans based on misinterpretations of a report. To help avoid misinterpretations, retain Coffey to work with other project design professionals who are affected by the report. Have Coffey explain the report implications to design professionals affected by them and then review plans and specifications produced to see how they incorporate the report findings.

Data should not be separated from the report*

The report as a whole presents the findings of the site assessment and the report should not be copied in part or altered in any way.

Logs, figures, drawings, etc. are customarily included in our reports and are developed by scientists, engineers or geologists based on their interpretation of field logs (assembled by field personnel) and laboratory evaluation of field samples. These logs etc. should not under any circumstances be redrawn for inclusion in other documents or separated from the report in any way.

Geoenvironmental concerns are not at issue

Your report is not likely to relate any findings, conclusions, or recommendations about the potential for hazardous materials existing at the site unless specifically required to do so by the client. Specialist equipment, techniques, and personnel are used to perform a geoenvironmental assessment. Contamination can create major health, safety and environmental risks. If you have no information about the potential for your site to be contaminated or create an environmental hazard, you are advised to contact Coffey for information relating to geoenvironmental issues.

Rely on Coffey for additional assistance

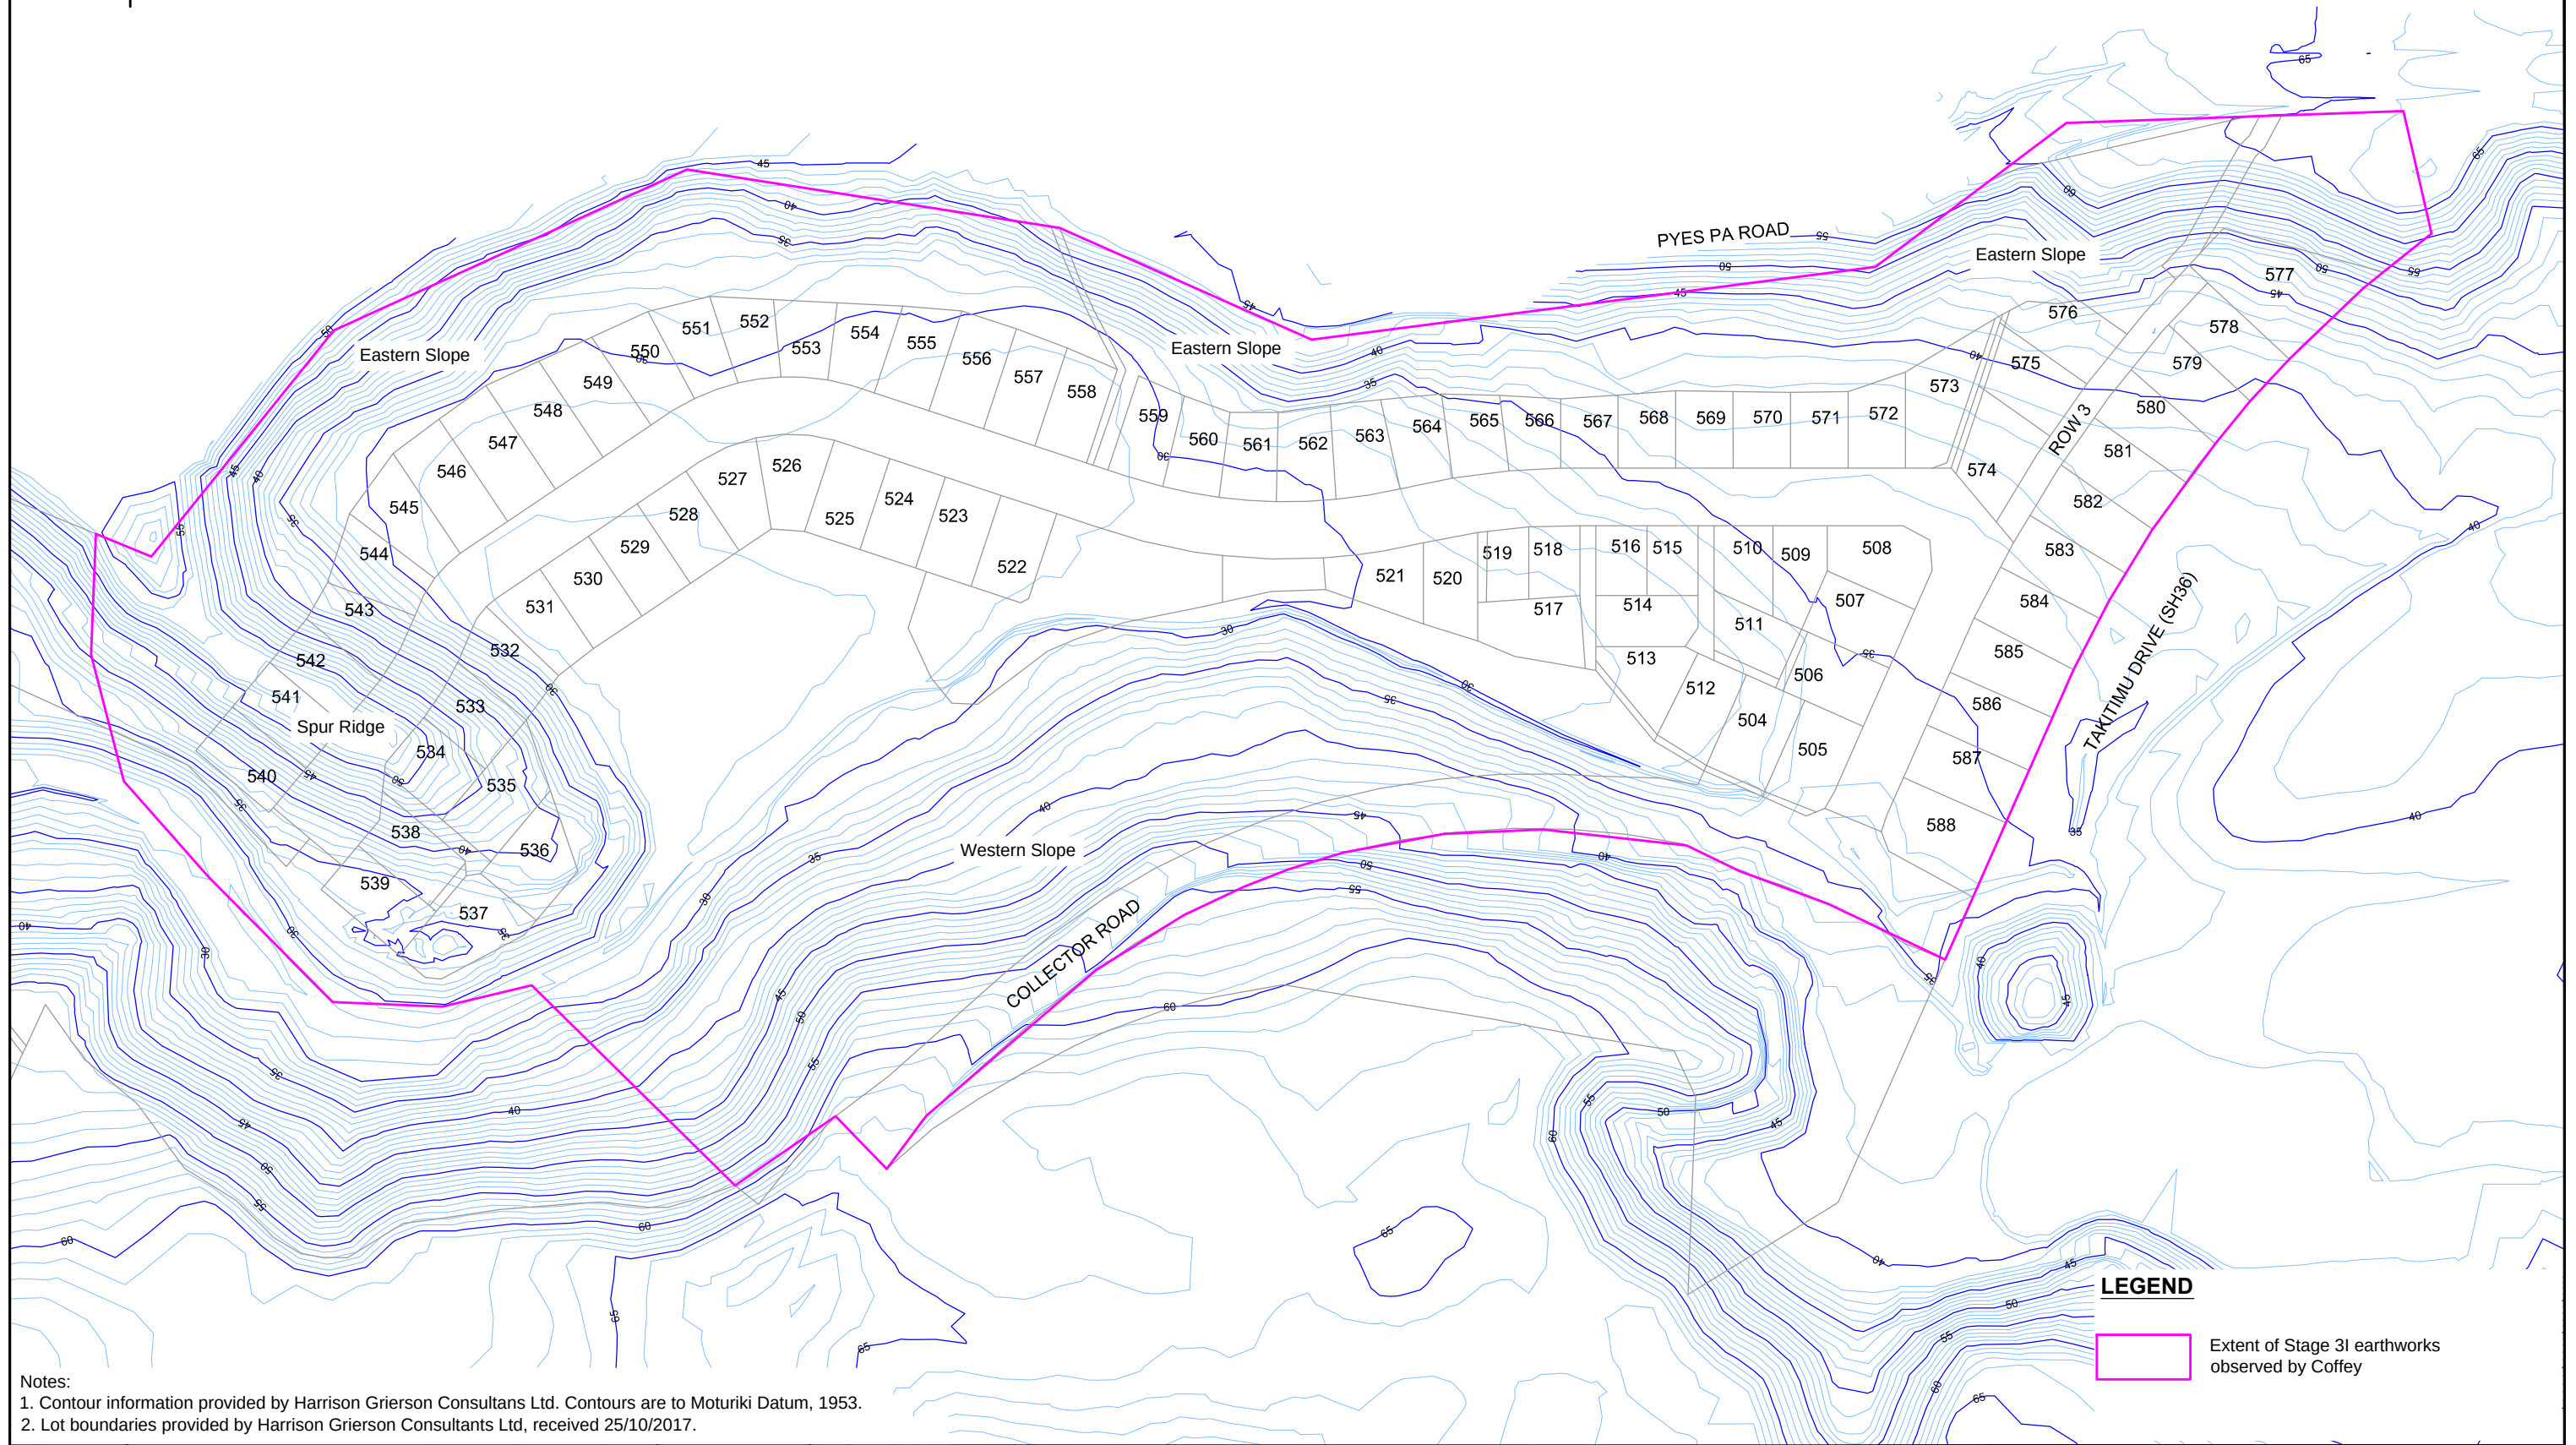
Coffey is familiar with a variety of techniques and approaches that can be used to help reduce risks for all parties to a project, from design to construction. It is common that not all approaches will be necessarily dealt with in your site assessment report due to concepts proposed at that time. As the project progresses through design towards construction, speak with Coffey to develop alternative approaches to problems that may be of genuine benefit both in time and cost.

Responsibility

Reporting relies on interpretation of factual information based on judgement and opinion and has a level of uncertainty attached to it, which is far less exact than the design disciplines. This has often resulted in claims being lodged against consultants, which are unfounded. To help prevent this problem, a number of clauses have been developed for use in contracts, reports and other documents. Responsibility clauses do not transfer appropriate liabilities from Coffey to other parties but are included to identify where Coffey's responsibilities begin and end. Their use is intended to help all parties involved to recognise their individual responsibilities. Read all documents from Coffey closely and do not hesitate to ask any questions you may have.

* For further information on this aspect reference should be made to "Guidelines for the Provision of Geotechnical information in Construction Contracts" published by the Institution of Engineers Australia, National headquarters, Canberra, 1987.

Appendix A - Figures



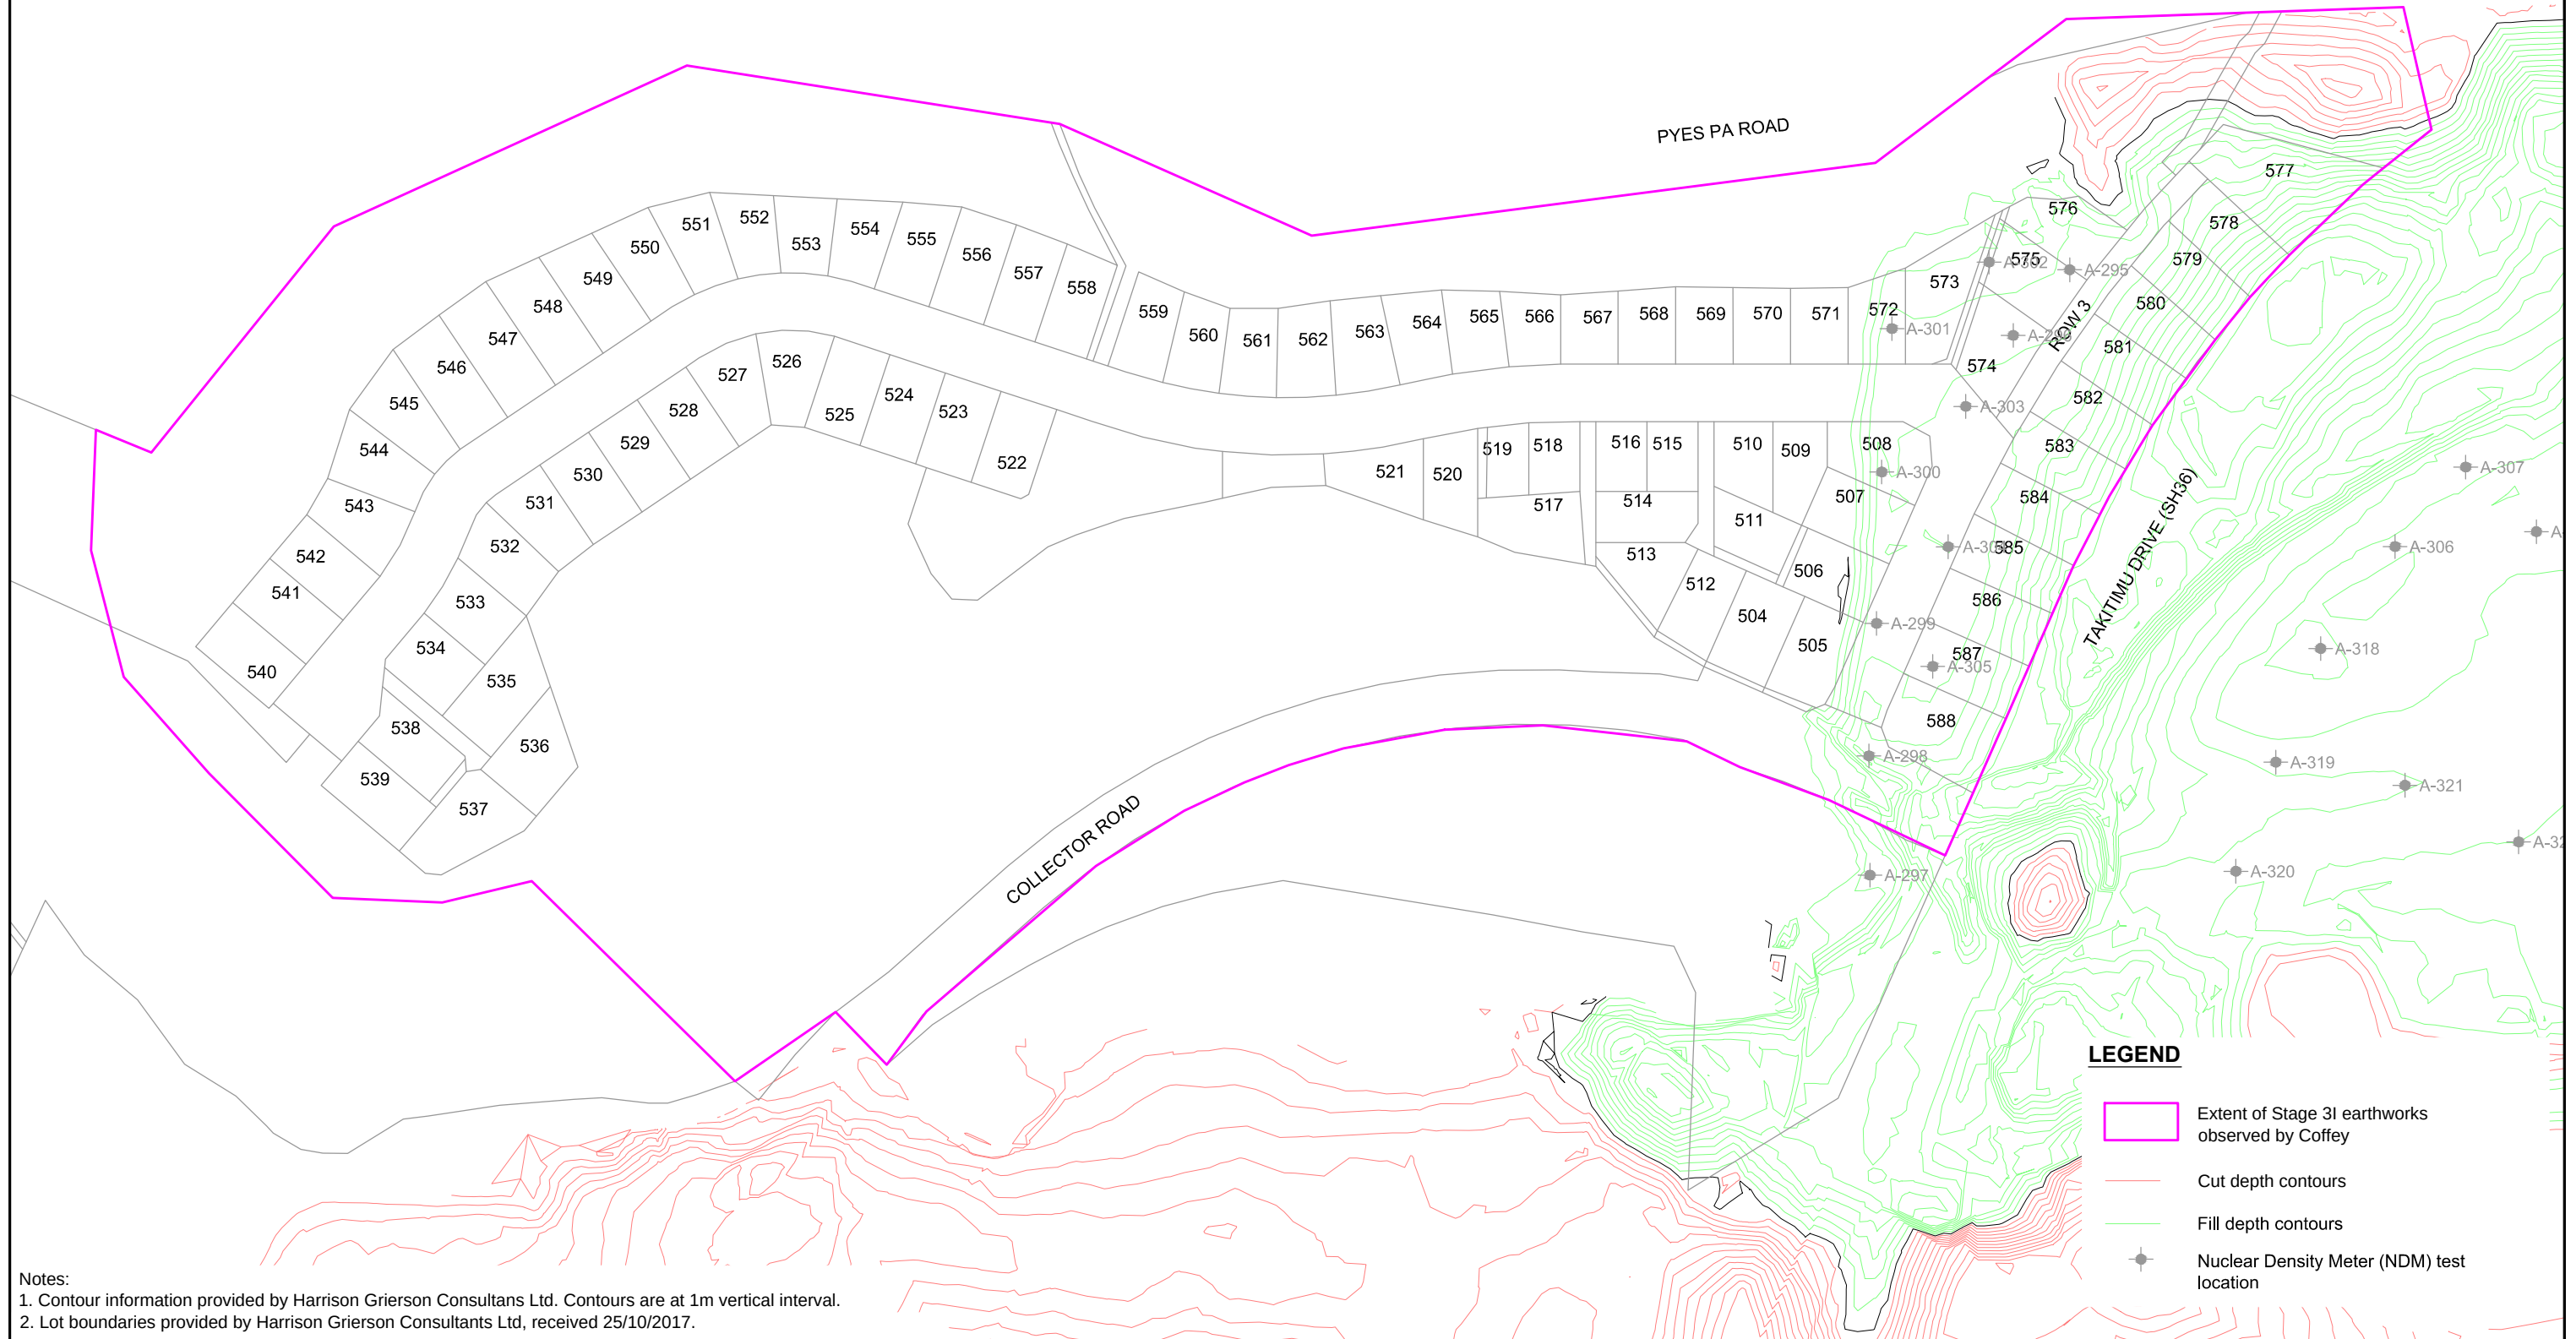
Notes:

1. Contour information provided by Harrison Grierson Consultants Ltd. Contours are to Moturiki Datum, 1953.
2. Lot boundaries provided by Harrison Grierson Consultants Ltd, received 25/10/2017.

LEGEND

 Extent of Stage 3I earthworks observed by Coffey

revision	rev	description		drawn	approved	date		030.060.090.0120.0 Horizontal Scale (metres) 030.060.090.0120.0 Vertical Scale (metres)	drawn		coffey A TETRA TECH COMPANY	client: The Lakes (2012) Ltd		
						approved			project: The Lakes Subdivision Stage 3I Earthworks Completion Report					
						date			title: Original (2007) Contours					
	A	Final		RBT	DAS	14/12/2017			scale	1:2000		project no: GENZTAUC13086AP-AM		
	0	Draft		RBT		7/12/2017			original size	A3		figure no: 1	rev: A	

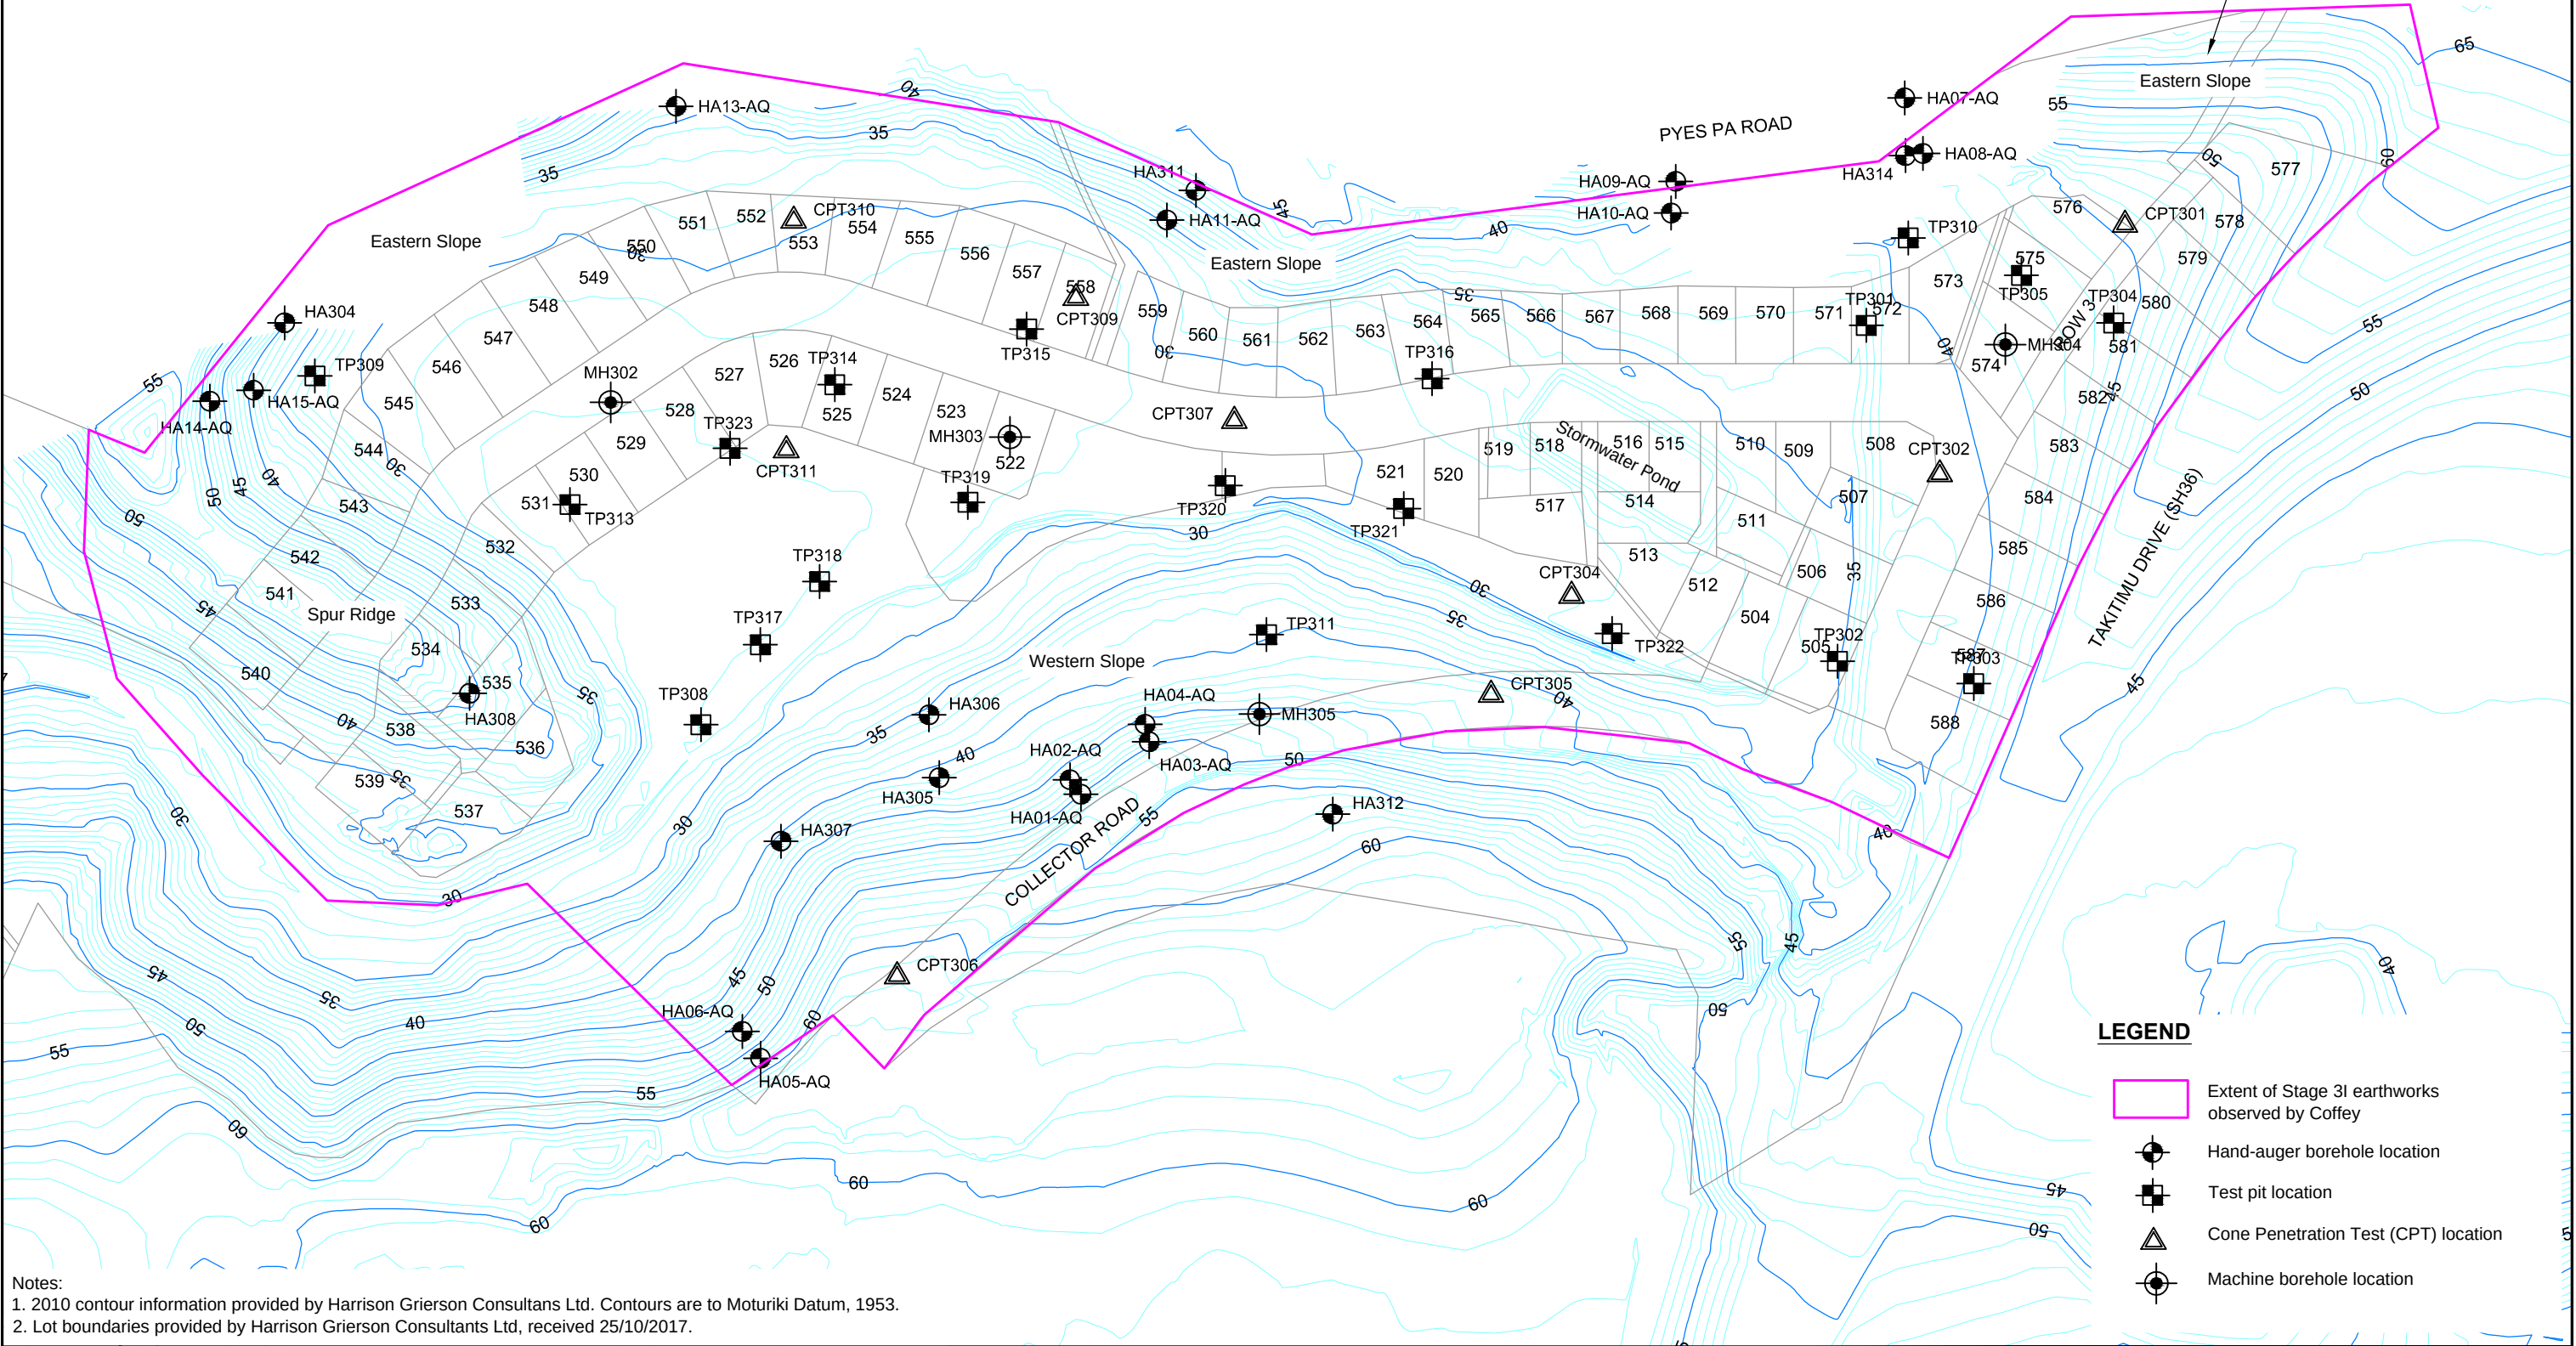


Notes:
1. Contour information provided by Harrison Grierson Consultants Ltd. Contours are at 1m vertical interval.
2. Lot boundaries provided by Harrison Grierson Consultants Ltd, received 25/10/2017.

revision	rev	description				drawn	approved	date		030.060.090.0120.0 Horizontal Scale (metres) 030.060.090.0120.0 Vertical Scale (metres)	drawn		coffey A TETRA TECH COMPANY	client: The Lakes (2012) Ltd			
											approved			project: The Lakes Subdivision Stage 3I Earthworks Completion Report			
											date			title: 2007 - 2010 Earthworks			
	A	Final					RBT	DAS	14/12/2017		scale	1:2000		project no: GENZTAUC13086AP-AM			
	0	Draft					RBT		7/12/2017		original size	A3		figure no: 2	rev: A		



1V:2.5H batter formed during highway construction in 2007-2008.

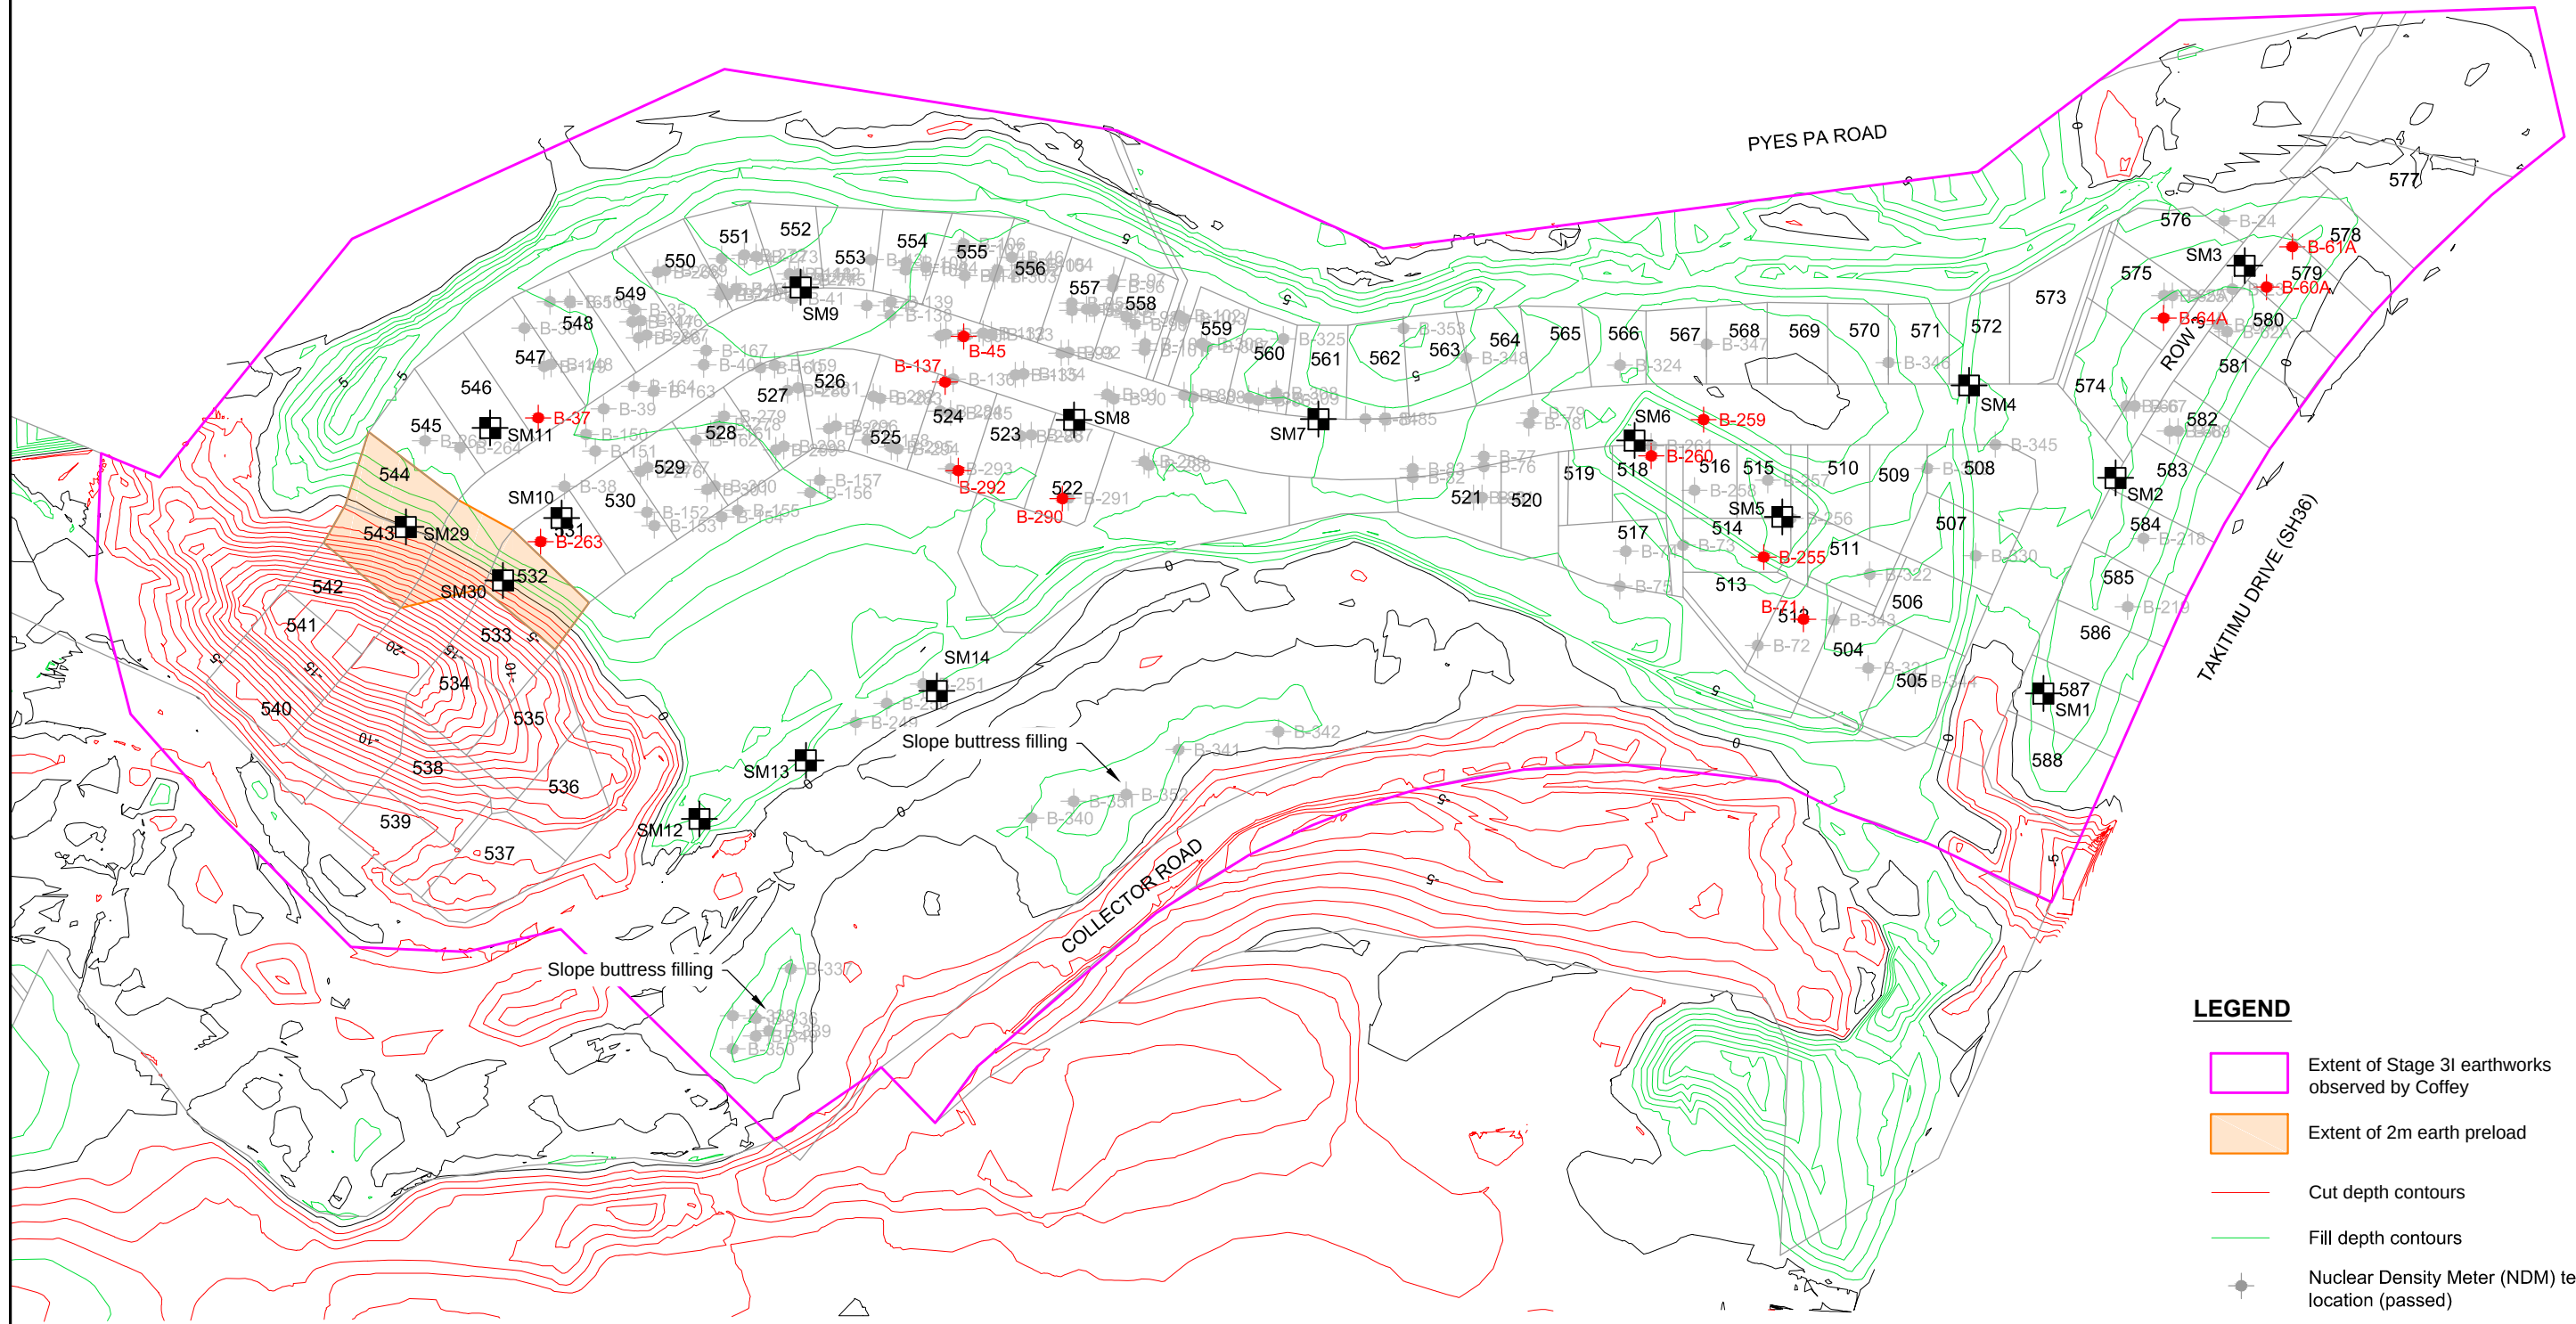


Notes:
1. 2010 contour information provided by Harrison Grierson Consultants Ltd. Contours are to Moturiki Datum, 1953.
2. Lot boundaries provided by Harrison Grierson Consultants Ltd, received 25/10/2017.

LEGEND

- Extent of Stage 3I earthworks observed by Coffey
- Hand-auger borehole location
- Test pit location
- Cone Penetration Test (CPT) location
- Machine borehole location

revision	rev	description	drawn	approved	date	030.060.090.0120.0 Horizontal Scale (metres) 030.060.090.0120.0 Vertical Scale (metres)	drawn	RBT	coffey A TETRA TECH COMPANY	client: The Lakes (2012) Ltd		
							approved			project: The Lakes Subdivision Stage 3I Earthworks Completion Report		
							date			title: 2010 Contours		
	A	Final	RBT	DAS	14/12/2017		scale	1:2000		project no: GENZTAUC13086AP-AMfigure no: 3		
	0	Draft	RBT		7/12/2017		original size	A3		rev: A		



- LEGEND**
- Extent of Stage 3I earthworks observed by Coffey
 - Extent of 2m earth preload
 - Cut depth contours
 - Fill depth contours
 - Nuclear Density Meter (NDM) test location (passed)
 - Nuclear Density Meter (NDM) test location (failed)

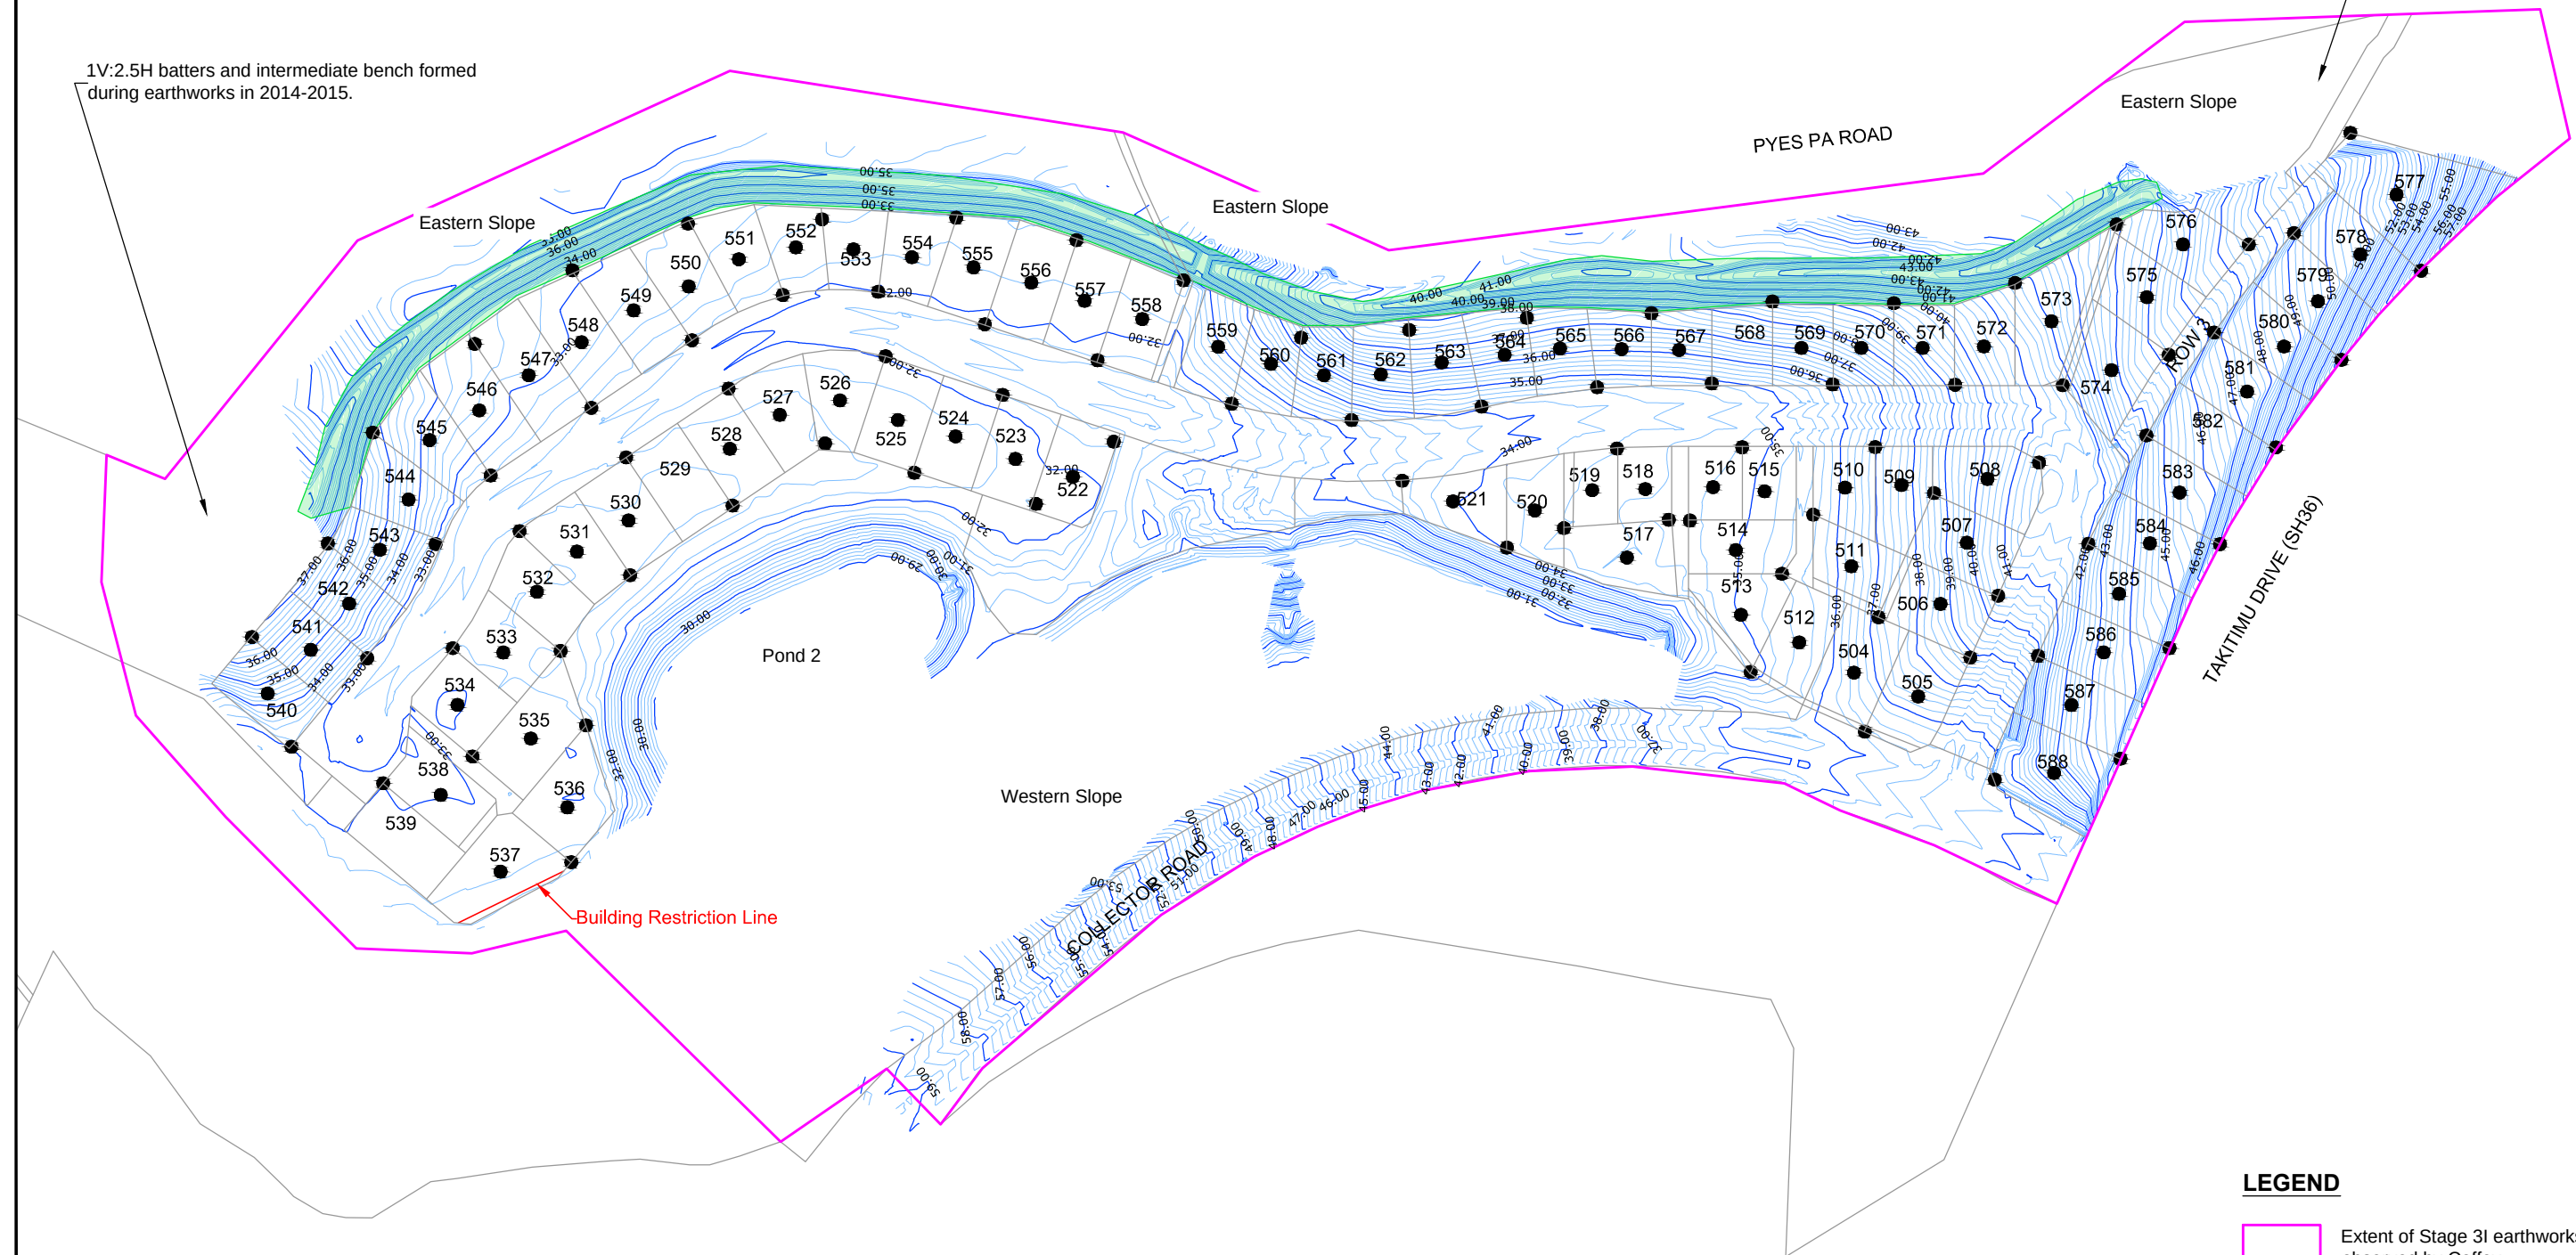
Notes:
1. Contour information provided by Harrison Grierson Consultants Ltd. Contours are at 1m vertical interval.
2. Lot boundaries provided by Harrison Grierson Consultants Ltd, received 25/10/2017.

revision	rev	description	drawn	approved	date	030.060.090.0120.0 Horizontal Scale (metres) 030.060.090.0120.0 Vertical Scale (metres)	drawn		coffey A TETRA TECH COMPANY	client: The Lakes (2012) Ltd		
							approved			project: The Lakes Subdivision Stage 3I Earthworks Completion Report		
							date			title: 2010 - 2017 Earthworks		
	A	Final	RBT	DAS	14/12/2017		scale	1:2000		project no: GENZTAUC13086AP-AM	figure no: 4	rev: A
	0	Draft	RBT		7/12/2017		original size	A3				



1V:2.5H batters and intermediate bench formed during earthworks in 2014-2015.

1V:2.5H batter formed during highway construction in 2007-2008.

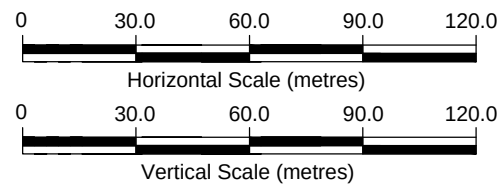


LEGEND

- Extent of Stage 3I earthworks observed by Coffey
- Eastern slope debris bund (approx. only - has not been surveyed)
- Hand-auger borehole location

Notes:
1. 2017 contour information provided by Harrison Grierson Consultants Ltd. Contours are to Moturiki Datum, 1953.
2. Lot boundaries provided by Harrison Grierson Consultants Ltd, received 25/10/2017.

revision	rev	description				drawn	approved	date
	A	Final				RBT	DAS	14/12/2017
	0	Draft				RBT		7/12/2017



drawn	ODS
approved	
date	21/11/2017
scale	1:2000
original size	A3



A TETRA TECH COMPANY

client:	The Lakes (2012) Ltd		
project:	The Lakes Subdivision Stage 3I Geotechnical Completion Report		
title:	2017 Contour Plan		
project no:	GENZTAUC13086AP-AM	figure no:	5
		rev:	A

Appendix B - Geotechnical Suitability Statement & Geotechnical Data Summary Table

CERTIFICATION

G2

STATEMENT OF PROFESSIONAL OPINION AS TO THE GEOTECHNICAL SUITABILITY OF LAND FOR BUILDING

NAME OF SUBDIVISION	
COUNCIL FILE NUMBER RC No:	
ENGINEER RESPONSIBLE FOR DEVELOPMENT:	
QUALIFICATIONS:	

I Rob Telford of Coffey Services (NZ) Ltd
(Full Name) (Name & Address of Firm)

Hereby confirm that;

1. I am a professional person, appropriately qualified with experience in geotechnical engineering to ascertain the suitability of the land for building development and was retained as the Soils Engineer to the above development.
2. An appropriate level of site investigation and construction supervision has been carried out under my direction and is described in my development evaluation report dated: 7 April 2014
3. In my professional opinion, not to be construed as a guarantee, I consider that;
 - a) ~~Every part~~ of the area shown in my report dated 19/1/2018 of each new allotment is suitable for the erection thereon of the building types appropriate to the zoning of the land, provided that: refer to Geotechnical Completion Report ref: 773-TR66E13086AP-AM dated 19/1/2018
 - b) The earth fills shown on the attached Plan No. Fig. 1 to 5 have been placed in accordance with the requirements of the Infrastructure Development Code.
 - c) The completed works give due regard to all land slope and foundation stability considerations.
 - d) ~~The filled ground is suitable for the erection thereon of residential buildings not requiring specific design in terms of NZS 3604: 2011 and related documents provided that:~~ Refer to Geotechnical Completion Report dated 19/1/2018
 - e) ~~The original ground not affected by filling is suitable for the erection thereon of residential buildings not requiring specific design in terms of NZS 3604: 2011 and related documents provided that:~~ Refer to Geotechnical Completion Report dated 19/1/2018
4. This professional opinion is furnished to the Council and the owner for their purpose alone, on the express condition that it will not be relied upon by any other person and does not remove the necessity for the normal inspection of foundation conditions at the time of erection for any dwelling.

Signed R Telford

Date 19/1/2018



Tauranga City

PRODUCER STATEMENT
SUITABILITY OF LAND FOR BUILDING DEVELOPMENT

INFRASTRUCTURE DEVELOPMENT CODE

G2

VERSION 1
July 2011

1

DP No:	Lot 1001 DP486181	Property Address	310 Lakes Boulevard, Pyes Pa	RC No:	21332
--------	-------------------	------------------	------------------------------	--------	-------

Lot No:	Area (m ²)	Subsurface data						Foundations		Building Restriction Line	S/W Specific Design	S/W Soakage	S/W Reticulate	Designated Building Platform	Minimum Building Platform	Compressible Soils	On-Site Effluent Disposal	Consent Notice	Comments
		Shear Strength (kPa)	Subdivision Filling		Natural Topography Unworked	Natural Topography Earthworked		Conventional Shallow Foundation to NZS 3604:2011	Specific Design										
		at 0.5m depth	Y/N	Depth (m)	Y/N	Y/N	Depth (m)	Y/N/NA	Y/N/NA										

515	350	158 – 196	Y	4	Y	N	-	Y	N	N	N	N	Y	N	N	N	N	Y	Suitable for standard foundations designed in accordance with NZS 3604 or 'waffle-slab' type foundations, for a geotechnical ultimate bearing capacity of 300kPa. Additional geotechnical review required if excavation depth >1.5m, per Section 7.5 of Coffey GCR ref: GENZTAUC13086AP-AM.
516	350	157 - >247	Y	3	Y	N	-	Y	N	N	N	N	Y	N	N	N	N	Y	
517	807	179 - >247	Y	3	Y	N	-	Y	N	N	N	N	Y	N	N	N	N	Y	
518	356	153 – 179	Y	3	Y	N	-	Y	N	N	N	N	Y	N	N	N	N	Y	
519	358	153 – UTP	Y	3	Y	N	-	Y	N	N	N	N	Y	N	N	N	N	Y	
520	507	179 – UTP	Y	2	Y	N	-	Y	N	N	N	N	Y	N	N	N	N	Y	
521	533	147 - >247	Y	3	Y	N	-	Y	N	N	N	N	Y	N	N	N	N	Y	
522	548	>213 – UTP	Y	3	Y	N	-	N	Y	N	N	N	Y	N	N	N	N	Y	Specifically designed foundations per Section 7.6.1 of Coffey GCR ref: GENZTAUC13086AP-AM. Additional geotechnical review required if excavation depth >1.5m, per Section 7.5 of Coffey GCR ref: GENZTAUC13086AP-AM.
523	550	>213 – UTP	Y	3	Y	N	-	N	Y	N	N	N	Y	N	N	N	N	Y	
524	550	140 – >213	Y	3	Y	N	-	N	Y	N	N	N	Y	N	N	N	N	Y	
525	548	>213	Y	3	Y	N	-	N	Y	N	N	N	Y	N	N	N	N	Y	



SUMMARY OF GOTECHNICAL DATA FOR INDIVIDUAL LOTS

INFRASTRUCTURE DEVELOPMENT CODE

G3

VERSION 1

Julv 2011

1

DP No:	Lot 1001 DP486181	Property Address	310 Lakes Boulevard, Pyes Pa	RC No:	21332
--------	-------------------	------------------	------------------------------	--------	-------

Lot No:	Area (m ²)	Subsurface data						Foundations		Building Restriction Line	S/W Specific Design	S/W Soakage	S/W Reticulate	Designated Building Platform	Minimum Building Platform	Compressible Soils	On-Site Effluent Disposal	Consent Notice	Comments
		Shear Strength (kPa)	Subdivision Filling		Natural Topography Unworked	Natural Topography Earthworked		Conventional Shallow Foundation to NZS 3604:2011	Specific Design										
		at 0.5m depth	Y/N	Depth (m)	Y/N	Y/N	Depth (m)	Y/N/NA	Y/N/NA										

526	530	>213 - >247	Y	3	Y	N	-	N	Y	N	N	N	Y	N	N	N	N	Y	Specifically designed foundations per Section 7.6.1 of Coffey GCR ref: GENZTAUC13086AP-AM. Additional geotechnical review required if excavation depth >1.5m, per Section 7.5 of Coffey GCR ref: GENZTAUC13086AP-AM.
527	540	215 - >247	Y	4	Y	N	-	N	Y	N	N	N	Y	N	N	N	N	Y	
528	549	143 - >224	Y	4	Y	N	-	N	Y	N	N	N	Y	N	N	N	N	Y	
529	550	143 - 247	Y	4	Y	N	-	N	Y	N	N	N	Y	N	N	N	N	Y	
530	550	199 - >247	Y	4	Y	N	-	N	Y	N	N	N	Y	N	N	N	N	Y	
531	524	>213 - >247	Y	4	Y	N	-	N	Y	N	N	N	Y	N	N	N	N	Y	
532	545	179 - >247	Y	4	N	Y	4	N	Y	N	N	N	Y	N	N	N	N	Y	
533	517	143 - 179 & DCP	Y	>2	N	Y	15	N	Y	N	N	N	Y	N	N	N	N	Y	Suitable for standard foundations designed in accordance with NZS 3604 or 'waffle-slab' type foundations, for a geotechnical ultimate bearing capacity of 300kPa. Additional geotechnical review required if excavation depth >1.5m, per Section 7.5 of Coffey GCR ref: GENZTAUC13086AP-AM.
534	523	DCP	Y	>2	N	Y	19	Y	N	N	N	N	Y	N	N	N	N	Y	



SUMMARY OF GOTECHNICAL DATA FOR INDIVIDUAL LOTS

INFRASTRUCTURE DEVELOPMENT CODE

G3

VERSION 1

Julv 2011

1

DP No:	Lot 1001 DP486181	Property Address	310 Lakes Boulevard, Pyes Pa	RC No:	21332
--------	-------------------	------------------	------------------------------	--------	-------

Lot No:	Area (m²)	Subsurface data					Foundations		Building Restriction Line	S/W Specific Design	S/W Soakage	S/W Reticulate	Designated Building Platform	Minimum Building Platform	Compressible Soils	On-Site Effluent Disposal	Consent Notice	Comments	
		Shear Strength (kPa) at 0.5m depth	Subdivision Filling		Natural Topography Unworked Y/N	Natural Topography Earthworked		Conventional Shallow Foundation to NZS 3604:2011 Y/N/NA											Specific Design Y/N/NA
			Y/N	Depth (m)		Y/N	Depth (m)												

535	699	DCP	Y	>2	N	Y	13	N	Y	N	N	N	Y	N	N	N	N	Y	Specifically designed foundations per Section 7.6.1 of Coffey GCR ref: GENZTAUC13086AP-AM.
536	618	193 & DCP	Y	>2	N	Y	8	N	Y	N	N	N	Y	N	N	N	N	Y	Additional geotechnical review required if excavation depth >1.5m, per Section 7.5 of Coffey GCR ref: GENZTAUC13086AP-AM.
537	739	150 & DCP	Y	>2	N	Y	4	Y	N	Y	N	N	Y	N	N	N	N	Y	Suitable for standard foundations designed in accordance with NZS 3604 or 'waffle-slab' type foundations, for a geotechnical ultimate bearing capacity of 300kPa. Additional geotechnical review required if excavation depth >1.5m, per Section 7.5 of Coffey GCR ref: GENZTAUC13086AP-AM. Development subject to BRL restrictions per Section 7.3.3 of Coffey GCR ref: GENZTAUC13086AP-AM.
538	590	150 & DCP	Y	>2	N	Y	17	Y	N	N	N	N	Y	N	N	N	N	Y	Suitable for standard foundations designed in accordance with NZS 3604 or 'waffle-slab' type foundations, for a geotechnical ultimate bearing capacity of 300kPa. Additional geotechnical review required if excavation depth >1.5m, per Section 7.5 of Coffey GCR ref: GENZTAUC13086AP-AM.



SUMMARY OF GOTECHNICAL DATA FOR INDIVIDUAL LOTS

INFRASTRUCTURE DEVELOPMENT CODE

G3

VERSION 1

Julv 2011

1

DP No:	Lot 1001 DP486181	Property Address	310 Lakes Boulevard, Pyes Pa	RC No:	21332
--------	-------------------	------------------	------------------------------	--------	-------

Lot No:	Area (m ²)	Subsurface data						Foundations		Building Restriction Line	S/W Specific Design	S/W Soakage	S/W Reticulate	Designated Building Platform	Minimum Building Platform	Compressible Soils	On-Site Effluent Disposal	Consent Notice	Comments
		Shear Strength (kPa)	Subdivision Filling		Natural Topography Unworked	Natural Topography Earthworked		Conventional Shallow Foundation to NZS 3604:2011	Specific Design										
		at 0.5m depth	Y/N	Depth (m)	Y/N	Y/N	Depth (m)	Y/N/NA	Y/N/NA										

539	576	DCP	Y	>2	N	Y	4	Y	N	N	N	N	Y	N	N	N	N	Y	Suitable for standard foundations designed in accordance with NZS 3604 or 'waffle-slab' type foundations, for a geotechnical ultimate bearing capacity of 300kPa. Additional geotechnical review required if excavation depth >1.5m, per Section 7.5 of Coffey GCR ref: GENZTAUC13086AP-AM.
540	540	DCP	Y	>2	N	Y	12	Y	N	N	N	N	Y	N	N	N	N	Y	
541	540	DCP	Y	>2	N	Y	20	Y	N	N	N	N	Y	N	N	N	N	Y	
542	540	>213 - >247 & DCP	Y	1	N	Y	20	Y	N	N	N	N	Y	N	N	N	N	Y	
543	543	>213 - >247	Y	>2	N	Y	13	Y	N	N	N	N	Y	N	N	N	N	Y	
544	543	196 - >213 & DCP	Y	4	Y	N	-	Y	N	N	N	N	Y	N	N	N	N	Y	
545	592	>213 & DCP	Y	4	Y	N	-	Y	N	N	N	N	Y	N	N	N	N	Y	
546	686	161 - >213 & DCP	Y	4	Y	N	-	Y	N	N	N	N	Y	N	N	N	N	Y	
547	699	UTP & DCP	Y	4	Y	N	-	Y	N	N	N	N	Y	N	N	N	N	Y	
548	677	>247 - UTP & DCP	Y	4	Y	N	-	Y	N	N	N	N	Y	N	N	N	N	Y	



SUMMARY OF GOTECHNICAL DATA FOR INDIVIDUAL LOTS

INFRASTRUCTURE DEVELOPMENT CODE

G3

VERSION 1

Julv 2011

1

DP No:	Lot 1001 DP486181	Property Address	310 Lakes Boulevard, Pyes Pa	RC No:	21332
--------	-------------------	------------------	------------------------------	--------	-------

Lot No:	Area (m ²)	Subsurface data						Foundations		Building Restriction Line	S/W Specific Design	S/W Soakage	S/W Reticulate	Designated Building Platform	Minimum Building Platform	Compressible Soils	On-Site Effluent Disposal	Consent Notice	Comments
		Shear Strength (kPa)	Subdivision Filling		Natural Topography Unworked	Natural Topography Earthworked		Conventional Shallow Foundation to NZS 3604:2011	Specific Design										
		at 0.5m depth	Y/N	Depth (m)	Y/N	Y/N	Depth (m)	Y/N/NA	Y/N/NA										

560	461	>215 – UTP	Y	3	Y	N	-	Y	N	N	N	N	Y	N	N	N	N	Y	Suitable for standard foundations designed in accordance with NZS 3604 or 'waffle-slab' type foundations, for a geotechnical ultimate bearing capacity of 300kPa. Additional geotechnical review required if excavation depth >1.5m, per Section 7.5 of Coffey GCR ref: GENZTAUC13086AP-AM.
561	452	192 – 231	Y	4	Y	N	-	Y	N	N	N	N	Y	N	N	N	N	Y	
562	507	165 - >247	Y	5	Y	N	-	Y	N	N	N	N	Y	N	N	N	N	Y	
563	529	164 – UTP	Y	6	Y	N	-	Y	N	N	N	N	Y	N	N	N	N	Y	
564	493	>213 - UTP	Y	5	Y	N	-	Y	N	N	N	N	Y	N	N	N	N	Y	
565	451	140 - >247	Y	3	Y	N	-	Y	N	N	N	N	Y	N	N	N	N	Y	
566	401	140 – UTP	Y	2	Y	N	-	Y	N	N	N	N	Y	N	N	N	N	Y	
567	400	224 – UTP	Y	1	Y	N	-	Y	N	N	N	N	Y	N	N	N	N	Y	
568	424	UTP	Y	1	Y	N	-	Y	N	N	N	N	Y	N	N	N	N	Y	
569	434	>213 – UTP & DCP	Y	1	Y	N	-	Y	N	N	N	N	Y	N	N	N	N	Y	



SUMMARY OF GOTECHNICAL DATA FOR INDIVIDUAL LOTS

INFRASTRUCTURE DEVELOPMENT CODE

G3

VERSION 1

Julv 2011

1

DP No:	Lot 1001 DP486181	Property Address	310 Lakes Boulevard, Pyes Pa	RC No:	21332
--------	-------------------	------------------	------------------------------	--------	-------

Lot No:	Area (m ²)	Subsurface data						Foundations		Building Restriction Line	S/W Specific Design	S/W Soakage	S/W Reticulate	Designated Building Platform	Minimum Building Platform	Compressible Soils	On-Site Effluent Disposal	Consent Notice		Comments
		Shear Strength (kPa)	Subdivision Filling		Natural Topography Unworked	Natural Topography Earthworked		Conventional Shallow Foundation to NZS 3604:2011	Specific Design											
		at 0.5m depth	Y/N	Depth (m)	Y/N	Y/N	Depth (m)	Y/N/NA	Y/N/NA											

570	429	175 & DCP	Y	2	Y	N	-	Y	N	N	N	N	Y	N	N	N	N	Y	Suitable for standard foundations designed in accordance with NZS 3604 or 'waffle-slab' type foundations, for a geotechnical ultimate bearing capacity of 300kPa. Additional geotechnical review required if excavation depth >1.5m, per Section 7.5 of Coffey GCR ref: GENZTAUC13086AP-AM.
571	429	175 - >213 & DCP	Y	3	Y	N	-	Y	N	N	N	N	Y	N	N	N	N	Y	
572	486	198 - UTP & DCP	Y	5	Y	N	-	Y	N	N	N	N	Y	N	N	N	N	Y	
573	800	198 - UTP	Y	4	Y	N	-	Y	N	N	N	N	Y	N	N	N	N	Y	
574	681	>247 - UTP	Y	7	Y	N	-	Y	N	N	N	N	Y	N	N	N	N	Y	
575	607	196 - UTP	Y	6	Y	N	-	Y	N	N	N	N	Y	N	N	N	N	Y	
576	572	209 - >247	Y	6	Y	N	-	Y	N	N	N	N	Y	N	N	N	N	Y	Suitable for standard foundations designed in accordance with NZS 3604 or 'waffle-slab' type foundations, for a geotechnical ultimate bearing capacity of 300kPa. Additional geotechnical review required if excavation depth >1.5m, per Section 7.5 of Coffey GCR ref: GENZTAUC13086AP-AM.
577	1208	144 - UTP	Y	15	Y	N	-	Y	N	N	N	N	Y	N	N	N	N	Y	



SUMMARY OF GOTECHNICAL DATA FOR INDIVIDUAL LOTS

INFRASTRUCTURE DEVELOPMENT CODE

G3

VERSION 1

Julv 2011

1

DP No:	Lot 1001 DP486181	Property Address	310 Lakes Boulevard, Pyes Pa	RC No:	21332
--------	-------------------	------------------	------------------------------	--------	-------

Lot No:	Area (m ²)	Subsurface data						Foundations		Building Restriction Line	S/W Specific Design	S/W Soakage	S/W Reticulate	Designated Building Platform	Minimum Building Platform	Compressible Soils	On-Site Effluent Disposal	Consent Notice	Comments
		Shear Strength (kPa)	Subdivision Filling		Natural Topography Unworked	Natural Topography Earthworked		Conventional Shallow Foundation to NZS 3604:2011	Specific Design										
		at 0.5m depth	Y/N	Depth (m)	Y/N	Y/N	Depth (m)	Y/N/NA	Y/N/NA										

578	630	144 - >213	Y	16	Y	N	-	Y	N	N	N	N	Y	N	N	N	N	Y	Suitable for standard foundations designed in accordance with NZS 3604 or 'waffle-slab' type foundations, for a geotechnical ultimate bearing capacity of 300kPa. Additional geotechnical review required if excavation depth >1.5m, per Section 7.5 of Coffey GCR ref: GENZTAUC13086AP-AM.
579	622	125 - >213	Y	15	Y	N	-	Y	N	N	N	N	Y	N	N	N	N	Y	
580	598	125 - >213	Y	15	Y	N	-	Y	N	N	N	N	Y	N	N	N	N	Y	
581	630	161 - 231	Y	15	Y	N	-	Y	N	N	N	N	Y	N	N	N	N	Y	
582	610	161 - >247	Y	13	Y	N	-	Y	N	N	N	N	Y	N	N	N	N	Y	
583	610	196 - >247	Y	12	Y	N	-	Y	N	N	N	N	Y	N	N	N	N	Y	
584	629	122 - 196	Y	11	Y	N	-	Y	N	N	N	N	Y	N	N	N	N	Y	
585	612	83 - >247	Y	12	Y	N	-	Y	N	N	N	N	Y	N	N	N	N	Y	
586	630	83 - UTP	Y	11	Y	N	-	Y	N	N	N	N	Y	N	N	N	N	Y	
587	630	>182 - 222	Y	10	Y	N	-	Y	N	N	N	N	Y	N	N	N	N	Y	



SUMMARY OF GOTECHNICAL DATA FOR INDIVIDUAL LOTS

INFRASTRUCTURE DEVELOPMENT CODE

G3

VERSION 1

Julv 2011

1

DP No:	Lot 1001 DP486181	Property Address	310 Lakes Boulevard, Pyes Pa	RC No:	21332
--------	-------------------	------------------	------------------------------	--------	-------

Lot No:	Area (m²)	Subsurface data						Foundations		Building Restriction Line	S/W Specific Design	S/W Soakage	S/W Reticulate	Designated Building Platform	Minimum Building Platform	Compressible Soils	On-Site Effluent Disposal	Consent Notice	Comments
		Shear Strength (kPa)	Subdivision Filling		Natural Topography Unworked	Natural Topography Earthworked		Conventional Shallow Foundation to NZS 3604:2011	Specific Design										
		at 0.5m depth	Y/N	Depth (m)	Y/N	Y/N	Depth (m)	Y/N/NA	Y/N/NA										

588	830	107 - >182	Y	10	Y	N	-	Y	N	N	N	N	Y	N	N	N	N	Y	Suitable for standard foundations designed in accordance with NZS 3604 or 'waffle-slab' type foundations, for a geotechnical ultimate bearing capacity of 300kPa. Additional geotechnical review required if excavation depth >1.5m, per Section 7.5 of Coffey GCR ref: GENZTAUC13086AP-AM.
-----	-----	------------	---	----	---	---	---	---	---	---	---	---	---	---	---	---	---	---	--

Key:

DCP – Dynamic Cone Penetration Test

UTP – Unable To Penetrate



SUMMARY OF GOTECHNICAL DATA FOR INDIVIDUAL LOTS

INFRASTRUCTURE DEVELOPMENT CODE

G3

VERSION 1

Julv 2011

1

Appendix C - Pre Development Investigation Data

Engineering Log - Machine Borehole

Sheet 1 of 4
Project No: **GENZTAUC13086AK**

Client: **THE LAKES LTD (2012)**

Date started: **14.1.2014**

Principal:

Date completed: **14.1.2014**

Project: **STAGE 3 - ZONE 2**

Logged by: **KMJ**

Machine Borehole

Checked by: **RBT**

Location: **South of Spur Ridge**

Drill model & mounting: T2 Tractor Mount		Easting: 369029.196 m		Slope: -90°		R.L. Surface: 28 m		Vane No:	
Hole diameter: mm		Drilling fluid:		Northing: 799744.166 m		Bearing:		Datum: x/y = BOPC2000, z = Moturiki	
drilling information				material substance						rock mass defects	
stratigraphy	method	support	notes samples, tests, etc	RL	depth metres	graphic log	core recovery	classification symbol	Material Description Soil name; plasticity or grading, colour, secondary components. Moisture, sensitivity, strength. Structure, bedding, cementation, defects. Origin, additional observations. Rock name; grain size & type, colour, fabric, inclusions & minor components. Weathering, moisture, strength, defects.	moisture condition	consistency/ density index	weathering alteration	estimated strength	estimated strength	vane shear (remoulded /peak) kPa	recovery %	RQD %	defect spacing mm	defect description number, type, orientation, shape, roughness, aperture, infill description (refer to defect description explanation sheet) particular general	
ALLUVIAL DEPOSITS	TS	TT	C		27.5	0.5		OL	Organic SILT, no plasticity, black-brown, organic odor, rootlets.	M	VS	
									ML											Sandy SILT, no plasticity, grey, orange streaks, strong organic odor, rootlets; sand is fine grained.	
																				- becoming brown-grey, decreasing sand content	
									27.0											1.0	
																																				26.5	1.5	
																																																				SM	Silty SAND, fine to medium grained, grey, sub-angular, black specks, sensitive.	W	L	
																																																					- becoming white-grey	
																																																					26.0															2.0	
																																																																																				SM	Silty SAND, fine to medium grained, pale grey, black specks.	M-W																										
																																																																																					- increasing silt content																											
25.5	2.5	
																		ML	SILT, low plasticity, grey-white, black specks, occasional orange staining, sensitive; minor fine sand.	
																			- increasing sand content	
									25.0										3.0	
																																			ML	SILT, low plasticity, grey-white, minor black specks.	
																																				- increasing sand content	
																																				24.5															3.5	
																																																					ML															Sandy SILT, no plasticity, mottled green-grey, organic odor; sand is fine grained.	
																																																																				- increasing sand content	
																																																																				24.0															4.0																													

method AD auger drilling OB open barrel TT triple tube W washbore support N nil C casing vane shear (kPa) ● remoulded × peak >>× peak greater than 200kPa UTP unable to penetrate	classification symbols and soil description based on Field Description of Soil and Rock, New Zealand Geotechnical Society Inc 2005 notes, samples, tests U ₅₀ undisturbed sample 50mm diameter U ₆₃ undisturbed sample 63mm diameter D disturbed sample N* SPT - sample recovered Nc SPT with solid cone Bs bulk sample E environmental sample	water ▼ 10/1/98 water level on date shown ▶ water inflow ◀ partial drill fluid loss ▶ complete drill fluid loss moisture D dry M moist W wet S saturated	consistency/ density index VS very soft S soft F firm St stiff VSt very stiff H hard VL very loose L loose MD medium dense D dense VD very dense	weathering UW unweathered SW slightly weathered MW moderately weathered HW highly weathered CW completely weathered RS residual soil rock mass strength EW extremely weak VW very weak W weak MS moderately strong S strong VS very strong ES extremely strong
--	---	---	--	--

Engineering Log - Machine Borehole

Sheet 2 of 4
Project No: **GENZTAUC13086AK**

Client: **THE LAKES LTD (2012)**

Date started: **14.1.2014**

Principal:

Date completed: **14.1.2014**Project: **STAGE 3 - ZONE 2**

Logged by: **KMJ**

Machine Borehole

Checked by: **RBT**

Location: **South of Spur Ridge**

Checked by: ***RBT***

Drill model & mounting: T2 Tractor Mount										Easting: 369029.196 m										Slope: -90°										R.L. Surface: 28 m										Vane No:																													
Hole diameter: mm										Drilling fluid:										Northing: 799744.166 m										Bearing:										Datum: x/y = BOPC2000, z = Moturiki																													
drilling information										material substance										rock mass defects	
stratigraphy method support water notes samples, tests, etc RL depth metres										Material Description Soil name; plasticity or grading, colour, secondary components. Moisture, sensitivity, strength. Structure, bedding, cementation, defects. Origin, additional observations. Rock name: grain size & type, colour, fabric, inclusions & minor components. Weathering, moisture, strength, defects. moisture condition consistency/density index weathering alteration estimated strength vane shear (remoulded /peak) kPa										defect description number, type, orientation, shape, roughness, aperture, infill description (refer to defect description explanation sheet) particular general	
ALLUVIAL DEPOSITS										ML (cont) SM ML SM ML SM ML										M-W W M-W W M-W W M-W S										S VL-L VS L S										100 80 80 67 67										30 100 300 1000 3000										recovery % RQD % defect spacing mm									
method AD OB TT W support N C vane shear (kPa) ● × >>>> UTP										classification symbols and soil description based on Field Description of Soil and Rock, New Zealand Geotechnical Society Inc 2005 notes, samples, tests U ₅₀ U ₆₃ D N* Nc Bs E										water 10/1/98 water level on date shown water inflow partial drill fluid loss complete drill fluid loss moisture D M W S										consistency/ density index VS S F St VSt H VL L MD D VD										weathering UW SW MW HW CW RS rock mass strength EW VW W MS S VS ES																													

Engineering Log - Machine Borehole

Sheet 3 of 4
Project No: **GENZTAUC13086AK**

Client: **THE LAKES LTD (2012)**

Date started: **14.1.2014**

Principal:

Date completed: **14.1.2014**

Project: **STAGE 3 - ZONE 2**

Logged by: **KMJ**

Machine Borehole

Location: **South of Spur Ridge**

Checked by: **RBT**

Drill model & mounting: T2 Tractor Mount		Easting: 369029.196 m		Slope: -90°		R.L. Surface: 28 m		Vane No:											
Hole diameter: mm		Drilling fluid:		Northing: 799744.166 m		Bearing:		Datum: x/y = BOPC2000, z = Moturiki											
drilling information				material substance				rock mass defects											
stratigraphy	method	support	notes samples, tests, etc	RL	depth metres	graphic log	classification symbol	Material Description Soil name; plasticity or grading, colour, secondary components. Moisture, sensitivity, strength. Structure, bedding, cementation, defects. Origin, additional observations. Rock name; grain size & type, colour, fabric, inclusions & minor components. Weathering, moisture, strength, defects.	moisture condition	consistency/ density index	weathering alteration	estimated strength	vane shear (remoulded /peak) kPa	recovery %	RQD %	defect spacing mm	defect description number, type, orientation, shape, roughness, aperture, infill description (refer to defect description explanation sheet)		
ALLUVIAL DEPOSITS	TT	C	SPT 8,12,18 N*=30	16.5	11.5	[Symbol: ML (cont)]	ML (cont)	Sandy SILT, no plasticity, pale grey, occasional yellow staining; sand is very fine grained. (continued)	W	S									
				16.0	12.0														
				15.5	12.5														
				15.0	13.0														
				14.5	13.5														
				14.0	14.0														
				13.5	14.5														
				13.0	15.0														
				12.5	15.5														
				12.0	16.0														
11.5	16.5																		
method				classification symbols and soil description				water				consistency/ density index				weathering			
AD auger drilling OB open barrel TT triple tube W washbore support N nil C casing vane shear (kPa) ● remoulded × peak >>× peak greater than 200kPa UTP unable to penetrate				based on Field Description of Soil and Rock, New Zealand Geotechnical Society Inc 2005 notes, samples, tests U ₅₀ undisturbed sample 50mm diameter U ₆₃ undisturbed sample 63mm diameter D disturbed sample N* SPT - sample recovered Nc SPT with solid cone Bs bulk sample E environmental sample				10/1/98 water level on date shown water inflow partial drill fluid loss complete drill fluid loss moisture D dry M moist W wet S saturated				VS very soft S soft F firm St stiff VSt very stiff H hard VL very loose L loose MD medium dense D dense VD very dense				UW unweathered SW slightly weathered MW moderately weathered HW highly weathered CW completely weathered RS residual soil rock mass strength EW extremely weak VW very weak W weak MS moderately strong S strong VS very strong ES extremely strong			

Engineering Log - Machine Borehole

Client: **THE LAKES LTD (2012)**

Principal:

Project: **STAGE 3 - ZONE 2**

Machine Borehole

Location: **South of Spur Ridge**

Sheet 4 of 4

Project No: **GENZTAUC13086AK**Date started: **14.1.2014**Date completed: **14.1.2014**

Logged by: **KMJ**

Checked by: **RBT**

[illegible]

Engineering Log - Machine Borehole

Client: **THE LAKES LTD (2012)**

Principal:

Project: **STAGE 3 - ZONE 2**

Machine Borehole

Location: **Base of Gully**

Sheet 1 of 4

Project No: **GENZTAUC13086AK**Date started: **13.1.2014**Date completed: **13.1.2014**

Logged by: **KMJ**

Checked by: ***RBT***

[illegible]

Engineering Log - Machine Borehole

Sheet 2 of 4
Project No: **GENZTAUC13086AK**

Client: **THE LAKES LTD (2012)**

Date started: **13.1.2014**

Principal:

Date completed: **13.1.2014**

Project: **STAGE 3 - ZONE 2**

Logged by: **KMJ**

Machine Borehole

Checked by: **RBT**

Location: **Base of Gully**

Drill model & mounting: T2 Tractor Mount		Easting: 369014.764 m		Slope: -90°		R.L. Surface: 28 m		Vane No:																			
Hole diameter: mm		Drilling fluid:		Northing: 799618.011 m		Bearing:		Datum: x/y = BOPC2000, z = Moturiki																			
drilling information				material substance				rock mass defects																			
stratigraphy	method	support	notes samples, tests, etc	RL	depth metres	graphic log	core recovery	classification symbol	Material Description Soil name; plasticity or grading, colour, secondary components. Moisture, sensitivity, strength. Structure, bedding, cementation, defects. Origin, additional observations. Rock name; grain size & type, colour, fabric, inclusions & minor components. Weathering, moisture, strength, defects.	moisture condition	consistency/ density index	weathering alteration	EW	VW	W	MS	S	VS	ES	vane shear (remoulded /peak) kPa	recovery %	RQD %	defect spacing mm	defect description number, type, orientation, shape, roughness, aperture, infill description (refer to defect description explanation sheet)			
ALLUVIAL DEPOSIT	TT	C	SPT 3,4,6 N*=10	22.0	6.0	XXXXXX	ML (cont)		SILT, non to low plasticity, white-grey, black specks, some green staining. (continued)	M-W	S										100						
				21.5	6.5	XXXXXX	SW		SAND, fine to coarse grained, blue-grey, black inclusions, some coarse gravel. - 100mm silt layer		MD											100					
				21.0	7.0	XXXXXX			- increasing silt content																		
				20.5	7.5	XXXXXX	SW		Silty SAND, fine to coarse grained, angular to sub-angular, mottled grey & orange & pink & black; silt is pink-orange, low plasticity.	W-S	L-MD																
				20.0	8.0	XXXXXX																					
				19.5	8.5	XXXXXX																					
				19.0	9.0	XXXXXX																					
				18.5	9.5	XXXXXX																					
				18.0	10.0	XXXXXX																					
				17.5	10.5	XXXXXX																					
17.0	11.0	XXXXXX																									
method AD auger drilling OB open barrel TT triple tube W washbore support N nil C casing vane shear (kPa) ● remoulded × peak >>× peak greater than 200kPa UTP unable to penetrate				classification symbols and soil description based on Field Description of Soil and Rock, New Zealand Geotechnical Society Inc 2005 notes, samples, tests U ₅₀ undisturbed sample 50mm diameter U ₆₃ undisturbed sample 63mm diameter D disturbed sample N* SPT - sample recovered Nc SPT with solid cone Bs bulk sample E environmental sample				water ▼ 10/1/98 water level on date shown ▶ water inflow ◀ partial drill fluid loss ▶ complete drill fluid loss moisture D dry M moist W wet S saturated				consistency/ density index VS very soft S soft F firm St stiff VSt very stiff H hard VL very loose L loose MD medium dense D dense VD very dense				weathering UW unweathered SW slightly weathered MW moderately weathered HW highly weathered CW completely weathered RS residual soil rock mass strength EW extremely weak VW very weak W weak MS moderately strong S strong VS very strong ES extremely strong											

Engineering Log - Machine Borehole

Sheet 3 of 4
Project No: **GENZTAUC13086AK**

Client: **THE LAKES LTD (2012)**

Date started: **13.1.2014**

Principal:

Date completed: **13.1.2014**Project: **STAGE 3 - ZONE 2**

Logged by: **KMJ**

Machine Borehole

Checked by: **RBT**

Location: **Base of Gully**

[illegible]

Machine Borehole No. **MH303**

Engineering Log - Machine Borehole

Sheet 4 of 4
Project No: **GENZTAUC13086AK**

Client: **THE LAKES LTD (2012)**

Date started: **13.1.2014**

Principal:

Date completed: **13.1.2014**Project: **STAGE 3 - ZONE 2**

Logged by: **KMJ**

Machine Borehole

Checked by: **RBT**

Location: **Base of Gully**

Checked by:

[illegible]

Engineering Log - Machine Borehole

Sheet 1 of 4
Project No: **GENZTAUC13086AK**
Date started: **15.1.2014**
Date completed: **15.1.2014**
Logged by: **KMJ**
Checked by: **RBT**

Client: **THE LAKES LTD (2012)**
Principal:
Project: **STAGE 3 - ZONE 2**
Machine Borehole Location: **Central Area of Proposed Fill Area**

Drill model & mounting: T2 Tractor Mount					Easting: 369051.42 m					Slope: -90°					R.L. Surface: 41 m					Vane No:										
Hole diameter: mm					Drilling fluid:					Northing: 799314.24 m					Bearing:					Datum: x/y = BOPC2000, z = Moturiki										
drilling information					material substance										rock mass defects															
stratigraphy	method	support	water	notes samples, tests, etc	RL	depth metres	graphic log	core recovery	classification symbol	Material Description Soil name; plasticity or grading, colour, secondary components. Moisture, sensitivity, strength. Structure, bedding, cementation, defects. Origin, additional observations. Rock name; grain size & type, colour, fabric, inclusions & minor components. Weathering, moisture, strength, defects.	moisture condition	consistency/ density index	weathering alteration	estimated strength					vane shear (remoulded /peak) kPa	recovery %	RQD %	defect spacing mm	defect description							
														EW	VW	W	MS	S					VS	ES	25	50	75	100	125	150
FILL	TT	C				40.5	0.5		ML	SILT, non to low plasticity, brown, mottled pink-orange, rootlets, trace sand & black inclusions.	M	F-St																		
						40.0	1.0		ML	SILT, low plasticity, pink-brown, black specks, brown mottling.		St																		
						39.5	1.5			- becoming pink orange-brown, pink mottling																				
						39.0	2.0	SPT 2,3,3 N*=6		- white silt pocket, 20mm, with organic/manganese core in the pocket																				
						38.5	2.5			- 10mm fine sand lenses																				
						38.0	3.0			- becoming dark brown																				
						37.5	3.5			- becoming mottling dark brown & brown																				
						37.0	4.0			- some brown fine sand																				
						36.5	4.5			- orange-brown with pink-white silt pockets, black specks																				
						36.0	5.0	SPT 3,4,4 N*=8		- becoming moist to wet	M-W																			
ALLUVIAL DEPOSITS					35.5	5.5		ML	- creamy pink-orange, black mottles																					
									- 100mm buried topsoil, no plasticity, black, organic odor	M	S-F																			
method					classification symbols and soil description					water					consistency/ density index					weathering										
AD auger drilling					based on Field Description of Soil and Rock, New Zealand Geotechnical Society Inc 2005					10/1/98 water level on date shown					VS very soft					UW unweathered										
OB open barrel										water inflow					S soft					SW slightly weathered										
TT triple tube										partial drill fluid loss					F firm					MW moderately weathered										
W washbore										complete drill fluid loss					St stiff					HW highly weathered										
support															VSt very stiff					CW completely weathered										
N nil															H hard					RS residual soil										
C casing															VL very loose															
vane shear (kPa)															L loose															
● remoulded															MD medium dense															
x peak															D dense															
>>x peak greater than 200kPa															VD very dense															
UTP unable to penetrate																														
					notes, samples, tests					moisture										rock mass strength										
					U50 undisturbed sample 50mm diameter					D dry										EW extremely weak										
					U63 undisturbed sample 63mm diameter					M moist										VW very weak										
					D disturbed sample					W wet										W weak										
					N* SPT - sample recovered					S saturated										MS moderately strong										
					Nc SPT with solid cone															S strong										
					Bs bulk sample															VS very strong										
					E environmental sample															ES extremely strong										

Engineering Log - Machine Borehole

Sheet 2 of 4
Project No: **GENZTAUC13086AK**

Client: **THE LAKES LTD (2012)**

Date started: **15.1.2014**

Principal:

Date completed: **15.1.2014**Project: **STAGE 3 - ZONE 2**

Logged by: **KMJ**

Machine Borehole

Checked by: **RBT**

Location: **Central Area of Proposed Fill Area**

Checked by: **RBT**

[illegible]

Engineering Log - Machine Borehole

Sheet 3 of 4
Project No: **GENZTAUC13086AK**

Client: **THE LAKES LTD (2012)**

Date started: **15.1.2014**

Principal:

Date completed: **15.1.2014**Project: **STAGE 3 - ZONE 2**

Logged by: **KMJ**

Machine Borehole

Checked by: ***RBT***

Location: **Central Area of Proposed Fill Area**

[illegible]

Engineering Log - Machine Borehole

Sheet 4 of 4
Project No: **GENZTAUC13086AK**

Client: **THE LAKES LTD (2012)**

Date started: **15.1.2014**

Principal:

Date completed: **15.1.2014**Project: **STAGE 3 - ZONE 2**

Logged by: **KMJ**

Machine Borehole

Checked by: **RBT**

Location: **Central Area of Proposed Fill Area**

Checked by: ***RBT***

[illegible]

Engineering Log - Machine Borehole

Sheet 1 of 4
Project No: **GENZTAUC13086AK**

Client: **THE LAKES LTD (2012)**

Date started: **14.1.2014**

Principal:

Date completed: **14.1.2014**

Project: **STAGE 3 - ZONE 2**

Logged by: **KMJ**

Machine Borehole

Location: **Edge of Access Track**

Checked by: **RBT**

Drill model & mounting: T2 Tractor Mount		Easting: 368925.813 m		Slope: -90°		R.L. Surface: 46 m		Vane No:												
Hole diameter: mm		Drilling fluid:		Northing: 799541.213 m		Bearing:		Datum: x/y = BOPC2000, z = Moturiki												
drilling information				material substance				rock mass defects												
stratigraphy	method	support	water	notes samples, tests, etc	RL	depth metres	graphic log	core recovery	classification symbol	Material Description	moisture condition	consistency/density index	weathering alteration	estimated strength	vane shear (remoulded) (kPa)	recovery %	RQD %	defect spacing mm	defect description	
FILL	TT	C			45.5	0.5			GP	Gravel, coarse grained, grey with light green vanes.	M-W									
									ML	Gravelly SILT, no plasticity, grey mottled orange-brown, gravel is fine to medium grained	F									
									ML	SILT, non to low plasticity, brown, interbedded with black silt vanes.										
										- becoming black-brown from 0.8 to 1.0m										
VOLCANIC ASHES				SPT 1,1,1 N*=2	45.0	1.0			ML	SILT, non to low plasticity, orange-brown, trace sand.	S-F									
										- increasing sand content										
										- becoming grey-brown										
MATUA SUBGROUP				SPT 1,2,2 N*=4	44.5	1.5			ML	SILT, low plasticity, brown.										
				SPT 1,0,0 N*=0	44.0	2.0			ML	SILT, non to low plasticity, mottled black & orange-grey, orange streaks, abundant black mottles.										
										- orange-brown staining from 2.6 to 2.7m										
										- orange staining										
										- abundant dark orange-brown staining & inclusions										
				SPT 1,0,0 N*=0	43.5	2.5			ML	SILT, non to low plasticity, creamy pale orange-white, black specks, some orange staining	F									
										- becoming orange-brown with black vanes & specks; some fine sand										
										- abundant dark orange-black inclusions from 5.0 to 5.1m										
										- becoming yellow-white to yellow grey, black mottles, some fine sand										

Engineering Log - Machine Borehole

Sheet 2 of 4
Project No: **GENZTAUC13086AK**

Client: **THE LAKES LTD (2012)**

Date started: **14.1.2014**

Principal:

Date completed: **14.1.2014**

Project: **STAGE 3 - ZONE 2**

Logged by: **KMJ**

Machine Borehole

Checked by: **RBT**

Location: **Edge of Access Track**

Drill model & mounting: T2 Tractor Mount		Easting: 368925.813 m		Slope: -90°		R.L. Surface: 46 m		Vane No:	
Hole diameter: mm		Drilling fluid:		Northing: 799541.213 m		Bearing:		Datum: x/y = BOPC2000, z = Moturiki	
drilling information				material substance								rock mass defects	
stratigraphy	method	support	notes samples, tests, etc	RL	depth metres	graphic log	core recovery	classification symbol	Material Description Soil name; plasticity or grading, colour, secondary components. Moisture, sensitivity, strength. Structure, bedding, cementation, defects. Origin, additional observations. Rock name; grain size & type, colour, fabric, inclusions & minor components. Weathering, moisture, strength, defects.	moisture condition	consistency/ density index	weathering alteration	estimated strength					vane shear (remoulded /peak) kPa	recovery %	RQD %	defect spacing mm	defect description number, type, orientation, shape, roughness, aperture, infill description (refer to defect description explanation sheet) particular general	
MATUA SUBGROUP	TT	C		40.0	6.0	XXXXXX	XXXXXX	ML (cont)	SILT, low to medium plasticity, creamy pale orange-white, black specks, some orange staining (continued)	M-W	F								100	
																								SPT 1,0,1 N*=1	39.5	6.5	XXXXXX	XXXXXX	- becoming medium to high plasticity from 6.5 to 6.7m - abundant orange fine gravel	W	S-F	
																								39.0																					7.0	XXXXXX	XXXXXX	- 100mm silty sand layer, dark brown - becoming orange-brown to orange-grey - 100mm silty sand layer, dark brown - becoming wet	VS	
																																																															38.5	7.5	XXXXXX	XXXXXX	SILT/Sandy SILT, low plasticity, pink-brown, sensitive; sand is fine to medium grained, dark brown, angular to sub-angular. - interbedded silt and sandy silt from 7.9 to 8.5m	S	
																																																																																		38.0	8.0	XXXXXX	XXXXXX	SILT, low plasticity, pink-brown/orange-brown, minor black specks, some fine sand. - heavy orange staining & abundant black inclusions - 100mm dark brown, fine to medium grained sand layer	W	
																																																																																																					37.5	8.5	XXXXXX	XXXXXX	Sandy SILT, non to low plasticity, pink-brown/orange-brown; sand is fine to medium grained, mixed colours of black, orange & white.	VS-S	
																																																																																																																								37.0	9.0	XXXXXX	XXXXXX	- increasing sand content, trace fine gravel from 9.9 to 10.0m - fine to medium black/grey sand & coarse black gravel from 10.2 to 10.3m - sand content missing from 10.3 to 10.4m - abundant black mottles	W-S	
																																																																																																																																										36.5	9.5	XXXXXX	XXXXXX																																		
																																																																																																																																																													36.0	10.0	XXXXXX	XXXXXX															
35.0	11.0	XXXXXX	XXXXXX	
																				SPT 0,0,0 N*=0	

method AD auger drilling OB open barrel TT triple tube W washbore support N nil C casing vane shear (kPa) ● remoulded × peak >>× peak greater than 200kPa UTP unable to penetrate		classification symbols and soil description based on Field Description of Soil and Rock, New Zealand Geotechnical Society Inc 2005 notes, samples, tests U ₅₀ undisturbed sample 50mm diameter U ₆₃ undisturbed sample 63mm diameter D disturbed sample N* SPT - sample recovered Nc SPT with solid cone Bs bulk sample E environmental sample		water ▼ 10/1/98 water level on date shown ▶ water inflow ◀ partial drill fluid loss ▶ complete drill fluid loss moisture D dry M moist W wet S saturated		consistency/ density index VS very soft S soft F firm St stiff VSt very stiff H hard VL very loose L loose MD medium dense D dense VD very dense		weathering UW unweathered SW slightly weathered MW moderately weathered HW highly weathered CW completely weathered RS residual soil rock mass strength EW extremely weak VW very weak W weak MS moderately strong S strong VS very strong ES extremely strong	
--	--	---	--	---	--	--	--	--	--

Engineering Log - Machine Borehole

Sheet 3 of 4
Project No: **GENZTAUC13086AK**

Client: **THE LAKES LTD (2012)**

Date started: **14.1.2014**

Principal:

Date completed: **14.1.2014**

Project: **STAGE 3 - ZONE 2**

Logged by: **KMJ**

Machine Borehole

Location: **Edge of Access Track**

Checked by: **RBT**

Drill model & mounting: T2 Tractor Mount		Easting: 368925.813 m		Slope: -90°		R.L. Surface: 46 m		Vane No:														
Hole diameter: mm		Drilling fluid:		Northing: 799541.213 m		Bearing:		Datum: x/y = BOPC2000, z = Moturiki														
drilling information				material substance				rock mass defects														
stratigraphy	method	support	notes samples, tests, etc	RL	depth metres	graphic log	classification symbol	Material Description Soil name; plasticity or grading, colour, secondary components. Moisture, sensitivity, strength. Structure, bedding, cementation, defects. Origin, additional observations. Rock name; grain size & type, colour, fabric, inclusions & minor components. Weathering, moisture, strength, defects.	moisture condition	consistency/ density index	weathering alteration	estimated strength	vane shear (remoulded 125 / peak) kPa	recovery %	RQD %	defect spacing mm	defect description number, type, orientation, shape, roughness, aperture, infill description (refer to defect description explanation sheet)					
MATUA SUBGROUP	TT	C	14/01/2014	34.5	11.5	XXXXXX	ML (cont)	SILT, low plasticity, pink-brown to orange-brown, black specks, sensitive; with some fine to medium sand. (continued)	W-S	VS-S					100							
							SPT 1,1,2 N*=3	34.0	12.0	XXXXXX	SM	Silty SAND, fine to medium grained, angular to sub-angular, yellow-brown, orange staining, black specks. - decreasing sand content till 12.5m		VL								
											33.5	12.5	XXXXXX									
														33.0	13.0	XXXXXX	ML	SILT, low to medium plasticity, pale pink-white to pale grey-white. - 20mm fine sand lenses		S		
							SPT 0,0,1 N*=1	32.5	13.5	XXXXXX	ML	Sandy SILT, low plasticity, pale pink-grey, with green staining; sand is fine to coarse grained. - interbedded silt and sand lenses		W								
											32.0	14.0	XXXXXX									
														31.5	14.5	XXXXXX	GM	Silty Gravel, fine to coarse grained, grey to blue-grey, with fine to medium grained sand, orange staining				
							SPT 2,2,3 N*=5	31.0	15.0	XXXXXX	ML	Sandy SILT/Silty SAND, no plasticity, sand is fine grained, pale grey, black specks.										
											30.5	15.5	XXXXXX									
														30.0	16.0	XXXXXX	SM	Silty SAND, fine grained, grey, black specks. - becoming sensitive		VL-L		
TE RANGA IGNIMBRITE				29.5	16.5	XXXXXX																
method AD auger drilling OB open barrel TT triple tube W washbore support N nil C casing vane shear (kPa) ● remoulded × peak >>× peak greater than 200kPa UTP unable to penetrate				classification symbols and soil description based on Field Description of Soil and Rock, New Zealand Geotechnical Society Inc 2005 notes, samples, tests U ₅₀ undisturbed sample 50mm diameter U ₆₃ undisturbed sample 63mm diameter D disturbed sample N* SPT - sample recovered Nc SPT with solid cone Bs bulk sample E environmental sample				water ▼ 10/1/98 water level on date shown ▶ water inflow ◀ partial drill fluid loss ▶ complete drill fluid loss moisture D dry M moist W wet S saturated				consistency/ density index VS very soft S soft F firm St stiff VSt very stiff H hard VL very loose L loose MD medium dense D dense VD very dense weathering UW unweathered SW slightly weathered MW moderately weathered HW highly weathered CW completely weathered RS residual soil rock mass strength EW extremely weak VW very weak W weak MS moderately strong S strong VS very strong ES extremely strong										

Engineering Log - Machine Borehole

Client: **THE LAKES LTD (2012)**

Principal:

Project: **STAGE 3 - ZONE 2**

Machine Borehole

Machine Borehole
Location: **Edge of Access Track**

Sheet 4 of 4

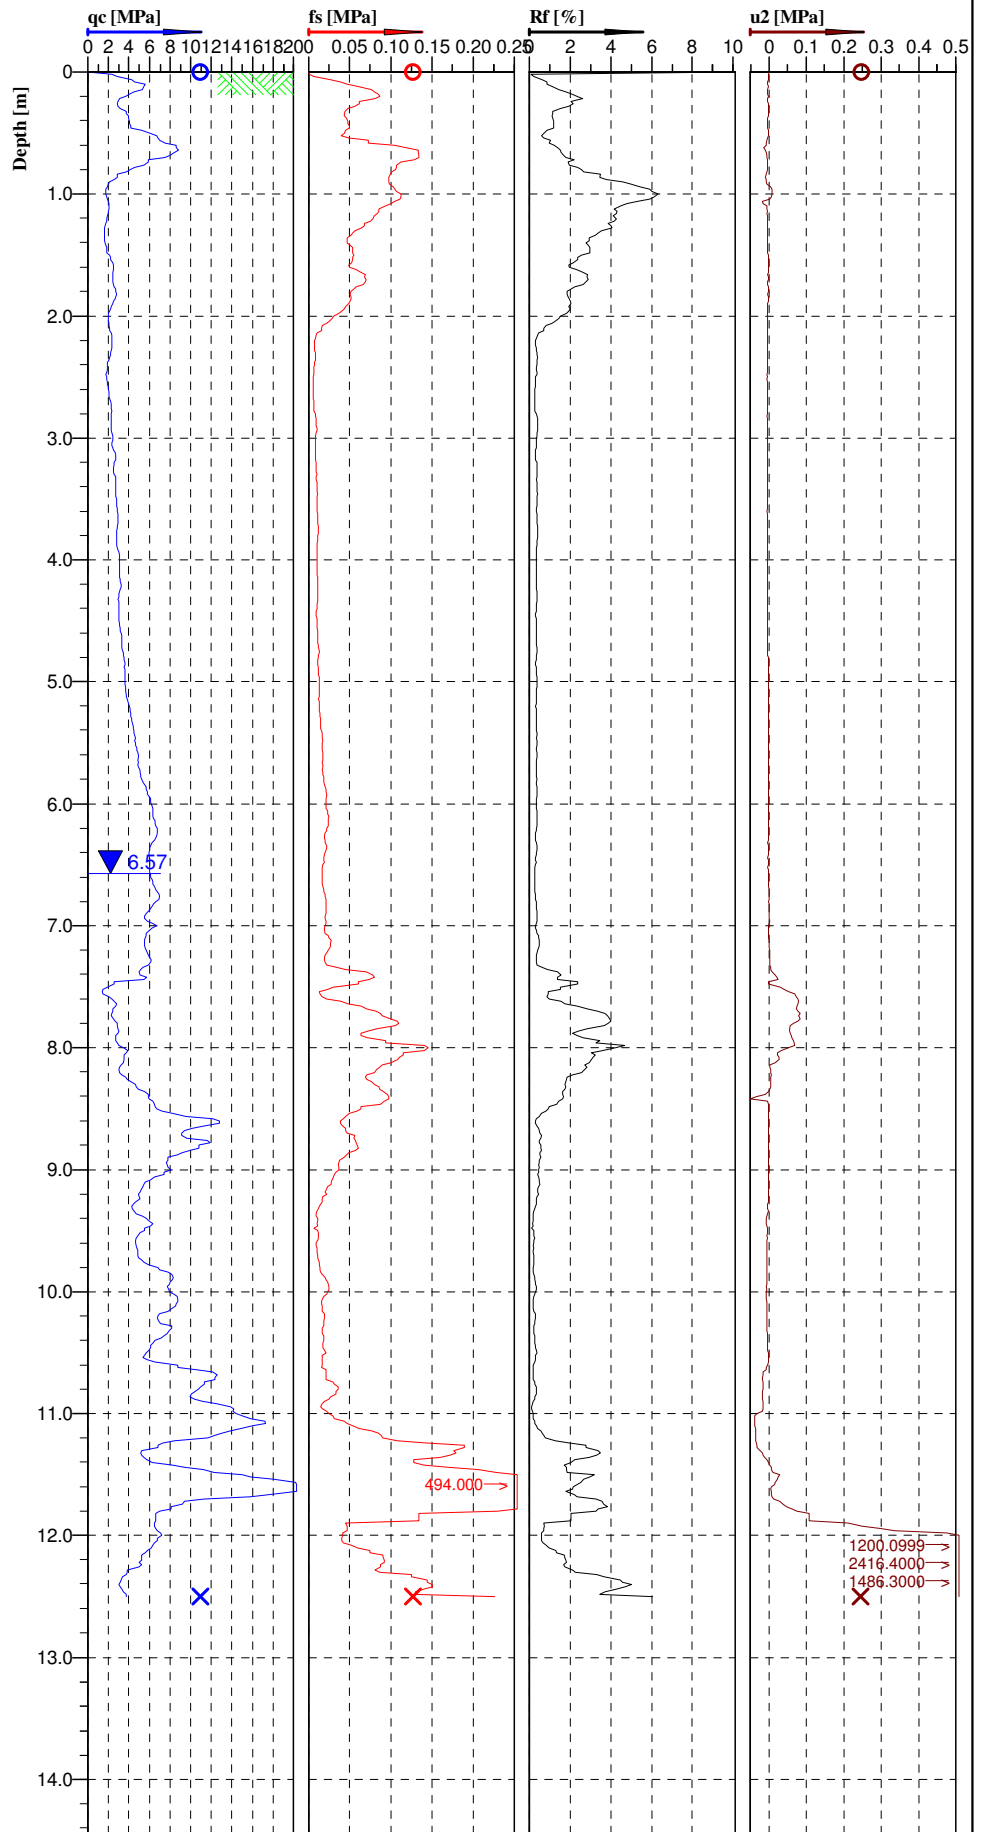
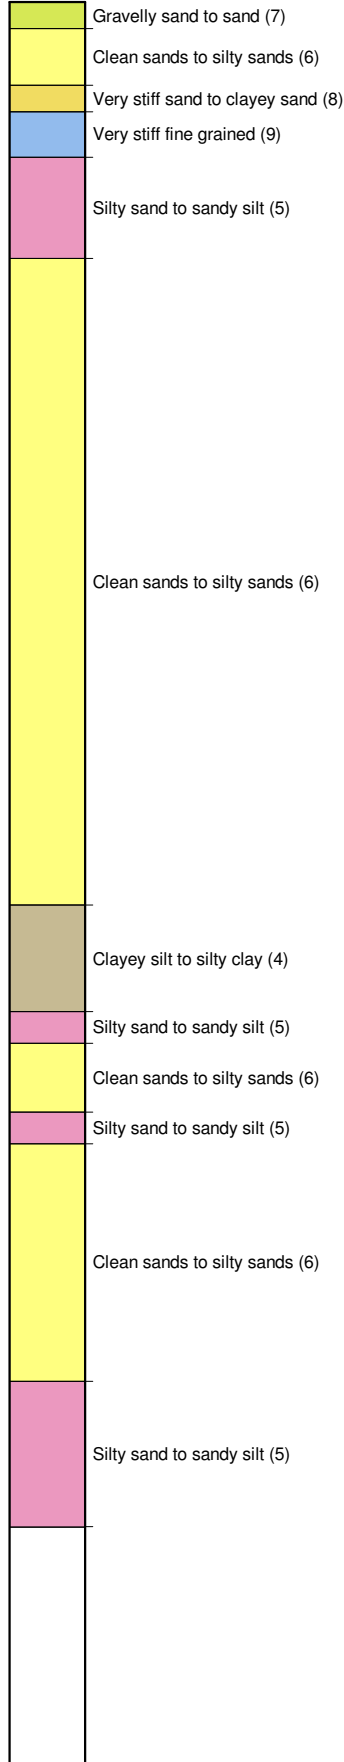
Project No: **GENZTAUC13086AK**Date started: **14.1.2014**Date completed: **14.1.2014**

Logged by: **KMJ**

Checked by: ***RBT***

[illegible]

**Classification by
Robertson 1990**

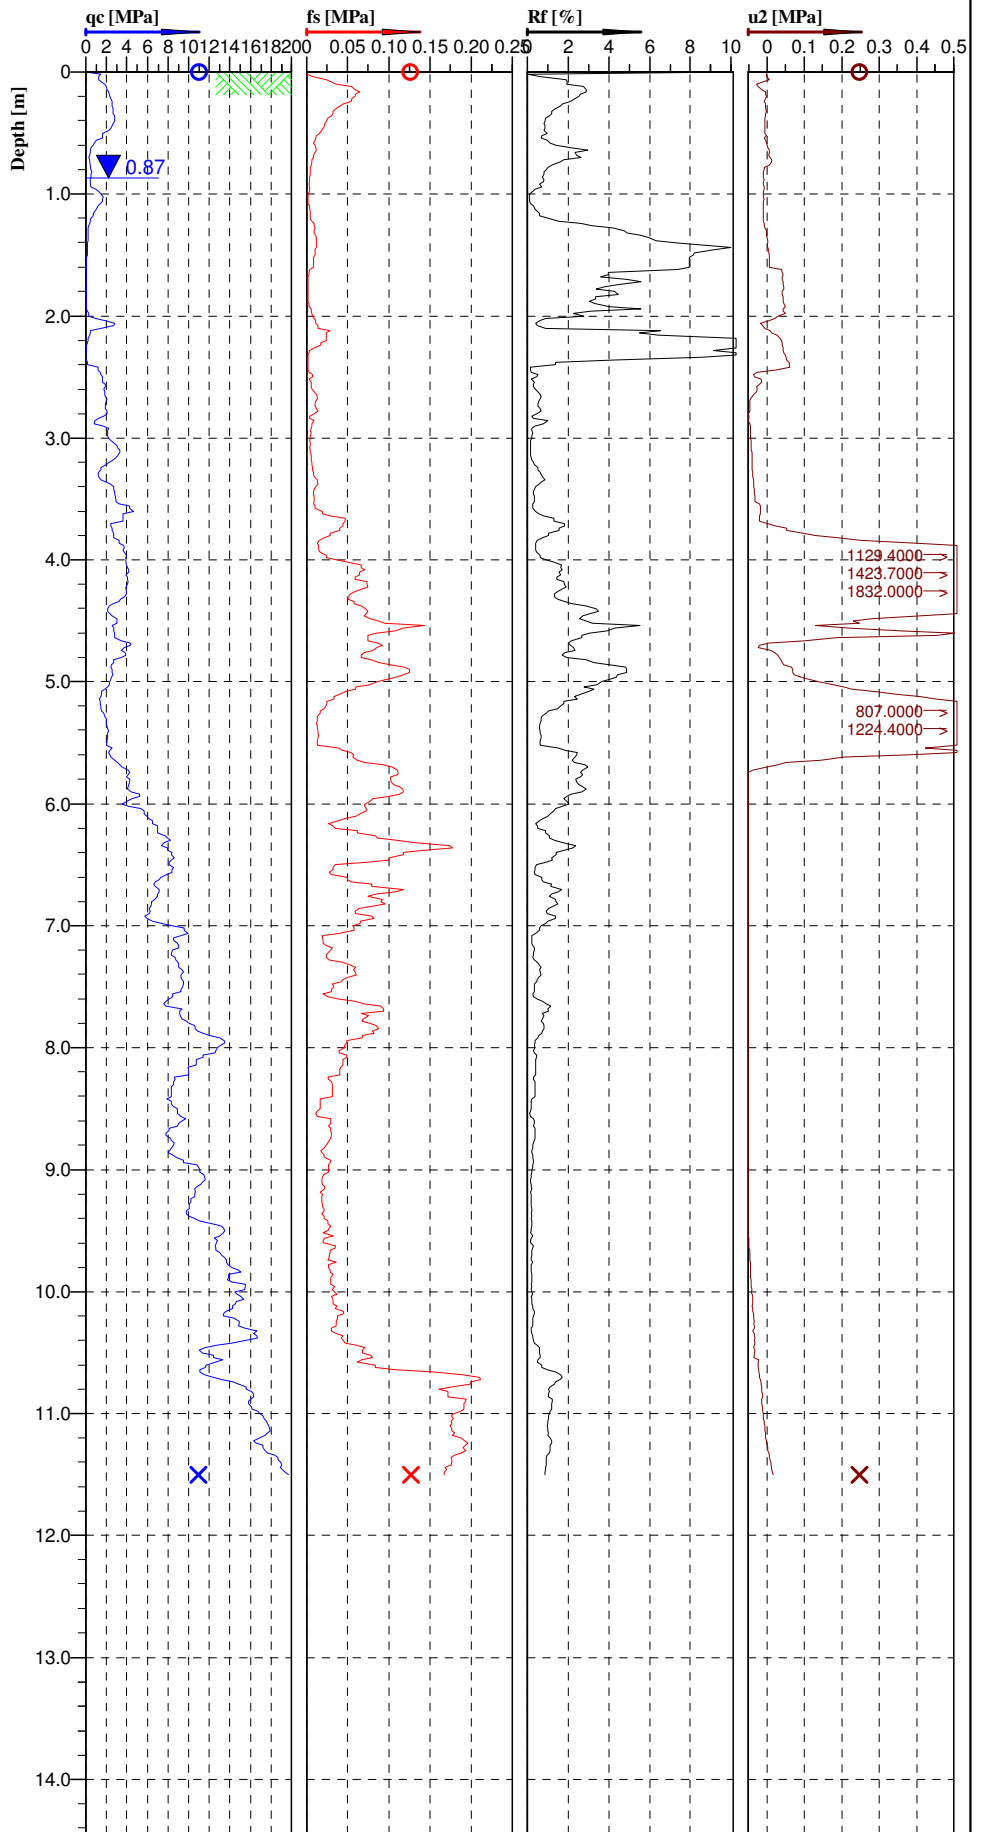
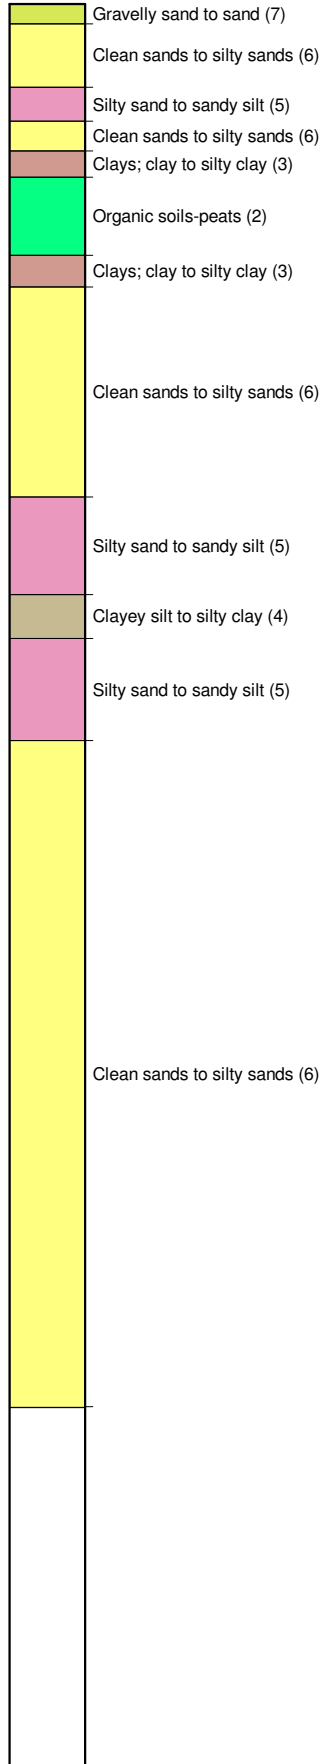


Cone No: 4623 100KN
Tip area [cm2]: 10
Sleeve area [cm2]: 150



Location: TAURANGA	Position: X: 0.00 m, Y: 0.00 m	Ground level: 0.00	Test no: 303
Project ID:	Client: COFFEY GEOTECHNICS	Date: 1/7/2014	Scale: 1 : 62
Project: 354 PYES PA RD SITE	Page: 1/1	Fig:	
File: CPT 303.CPT			

**Classification by
Robertson 1990**



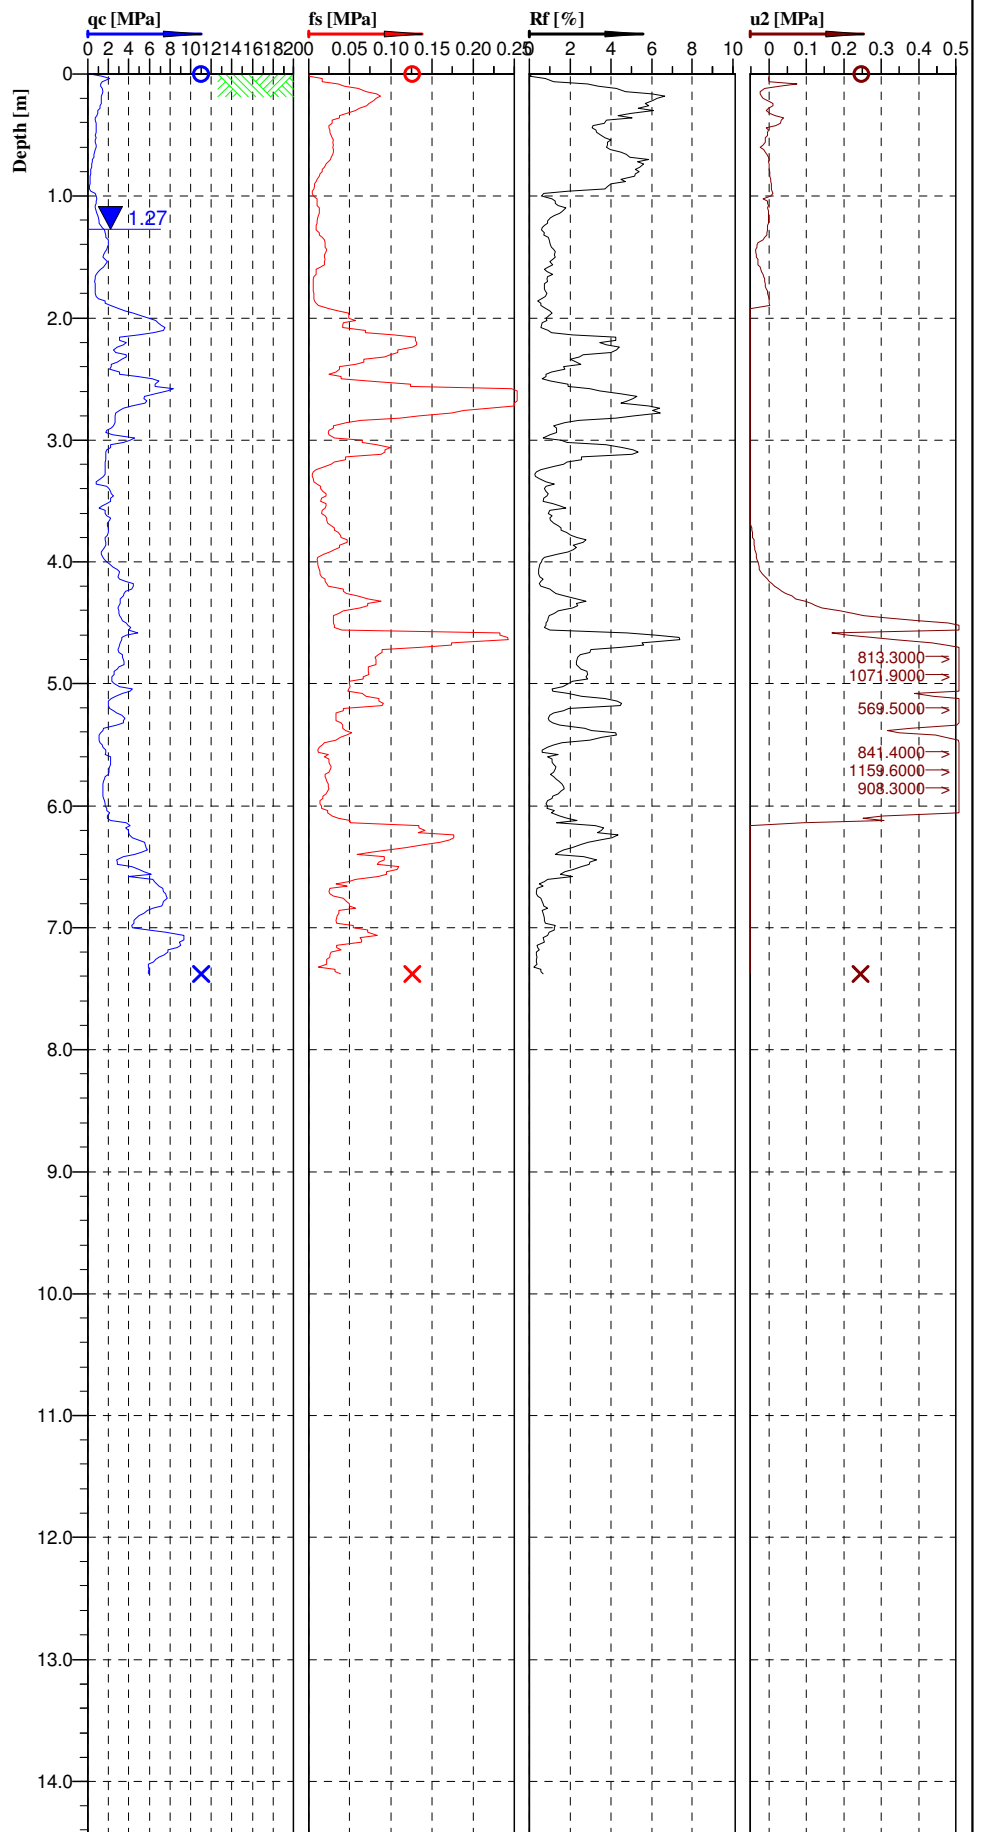
Cone No: 4623 100KN
Tip area [cm2]: 10
Sleeve area [cm2]: 150



Location: TARUANGA	Position: X: 0.00 m, Y: 0.00 m	Ground level: 0.00	Test no: 308
Project ID:	Client: COFFEY GEOTECHNICS	Date: 1/7/2014	Scale: 1 : 62
Project: 354 PYES PA RD SITE	Page: 1/1	Fig:	
	File: CPT 308.CPT		

**Classification by
Robertson 1990**

Gravelly sand to sand (7)
Very stiff fine grained (9)
Clayey silt to silty clay (4)
Clays; clay to silty clay (3)
Silty sand to sandy silt (5)
Clean sands to silty sands (6)
Silty sand to sandy silt (5)
Clean sands to silty sands (6)
Silty sand to sandy silt (5)
Very stiff fine grained (9)
Silty sand to sandy silt (5)
Clean sands to silty sands (6)
Silty sand to sandy silt (5)
Clean sands to silty sands (6)



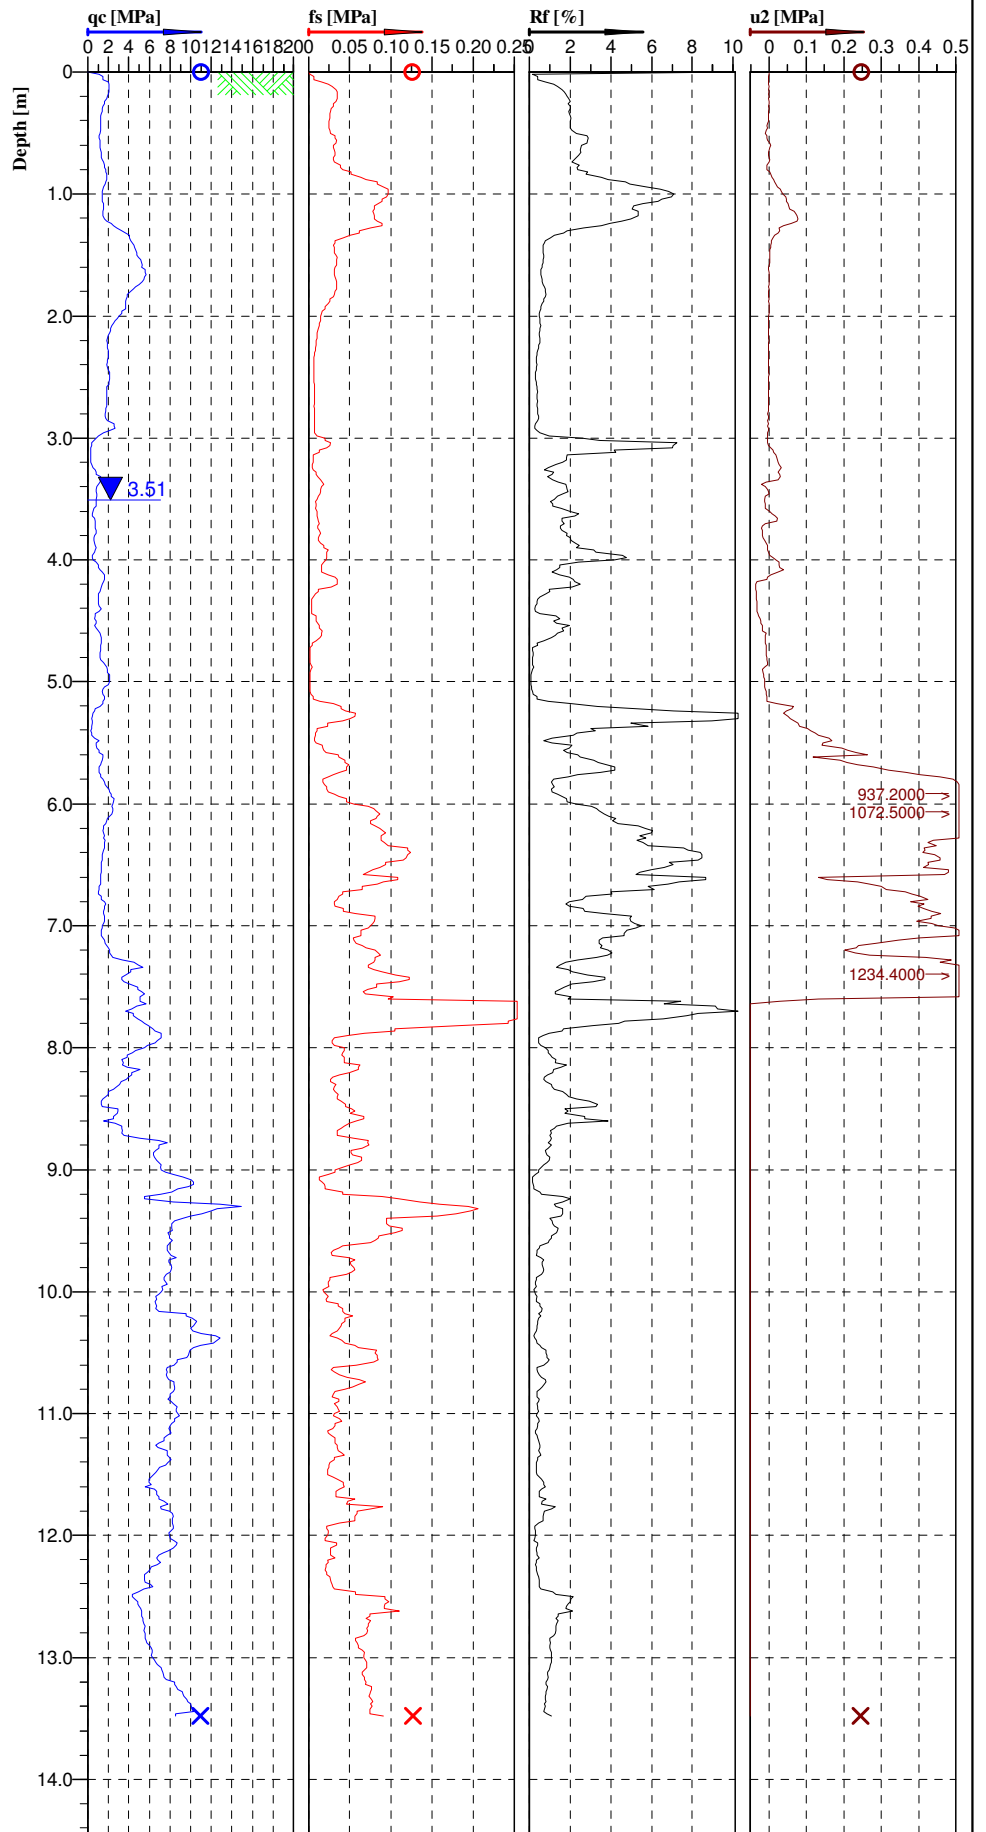
Cone No: 4623 100KN
Tip area [cm2]: 10
Sleeve area [cm2]: 150



Location: TAURANGA	Position: X: 0.00 m, Y: 0.00 m	Ground level: 0.00	Test no: 309
Project ID:	Client: COFFEY GEOTECHNICS	Date: 1/7/2014	Scale: 1 : 62
Project: 354 PYES PA RD SITE		Page: 1/1	Fig:
		File: CPT 309.CPT	

**Classification by
Robertson 1990**

Gravelly sand to sand (7)
Clean sands to silty sands (6)
Silty sand to sandy silt (5)
Very stiff fine grained (9)
Clean sands to silty sands (6)
Silty sand to sandy silt (5)
Clays; clay to silty clay (3)
Clayey silt to silty clay (4)
Clays; clay to silty clay (3)
Clayey silt to silty clay (4)
Silty sand to sandy silt (5)
Clayey silt to silty clay (4)
Silty sand to sandy silt (5)
Clays; clay to silty clay (3)
Silty sand to sandy silt (5)
Clays; clay to silty clay (3)
Silty sand to sandy silt (5)
Clean sands to silty sands (6)
Silty sand to sandy silt (5)
Clean sands to silty sands (6)

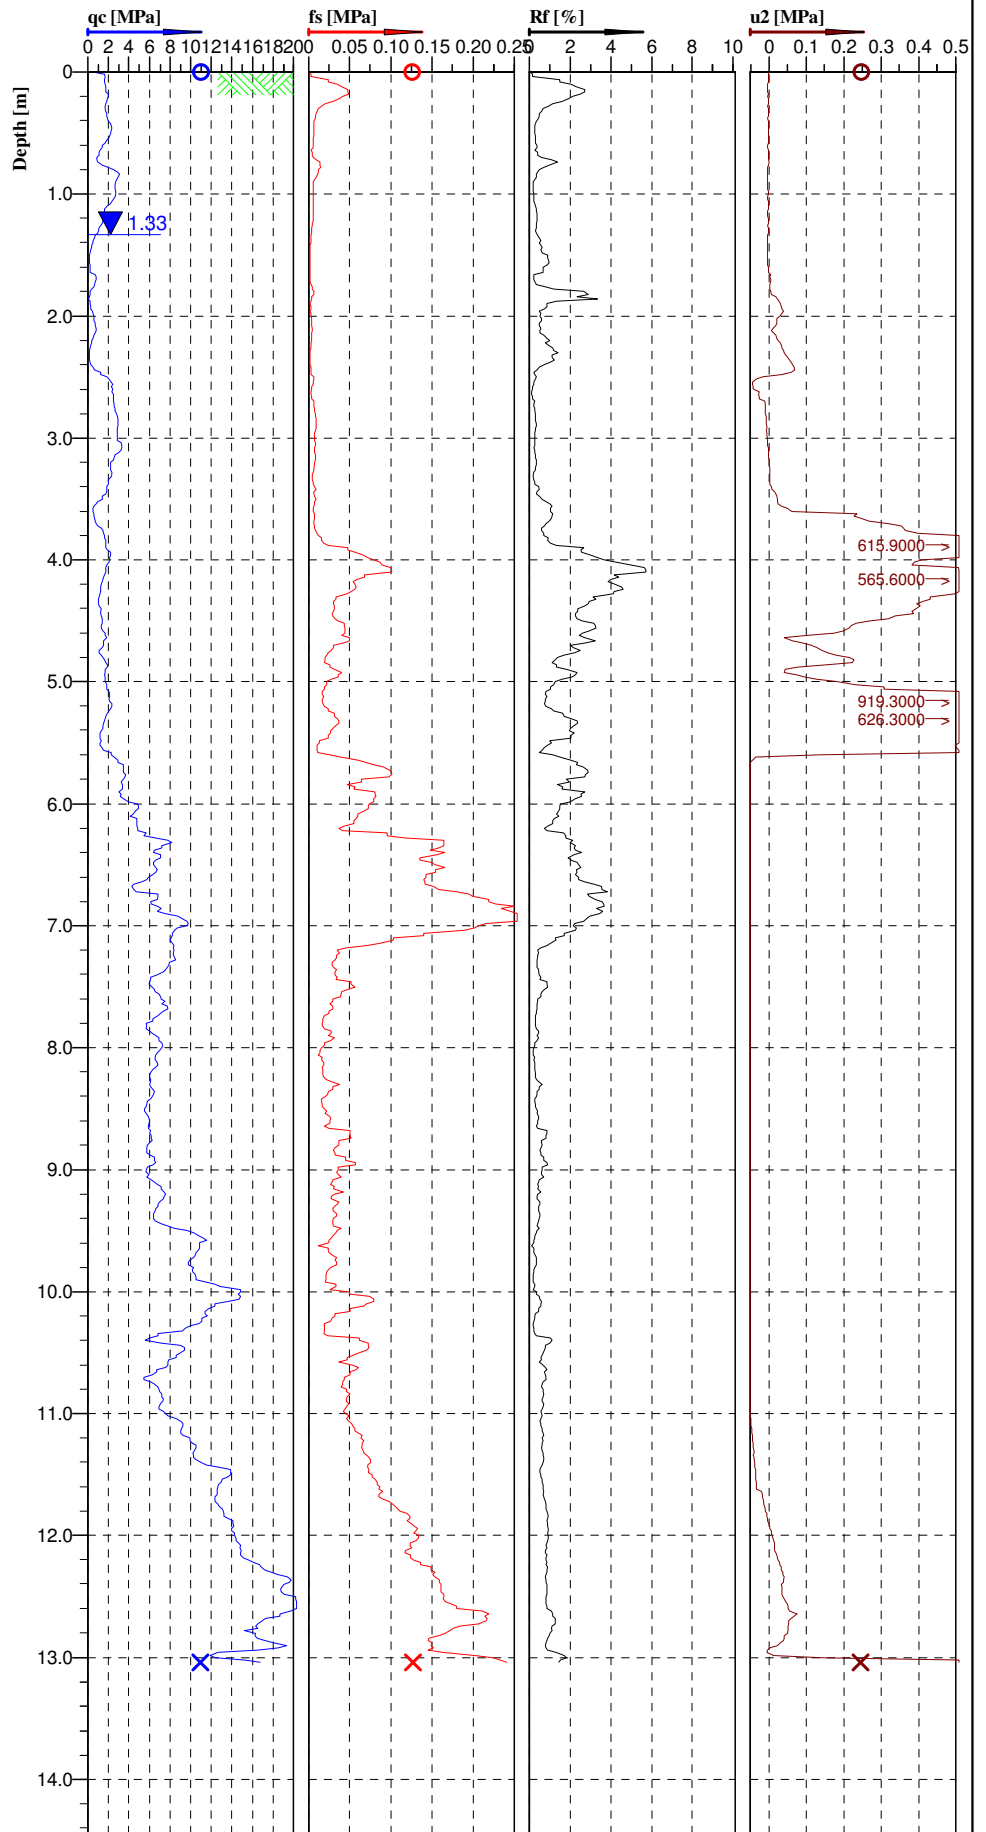
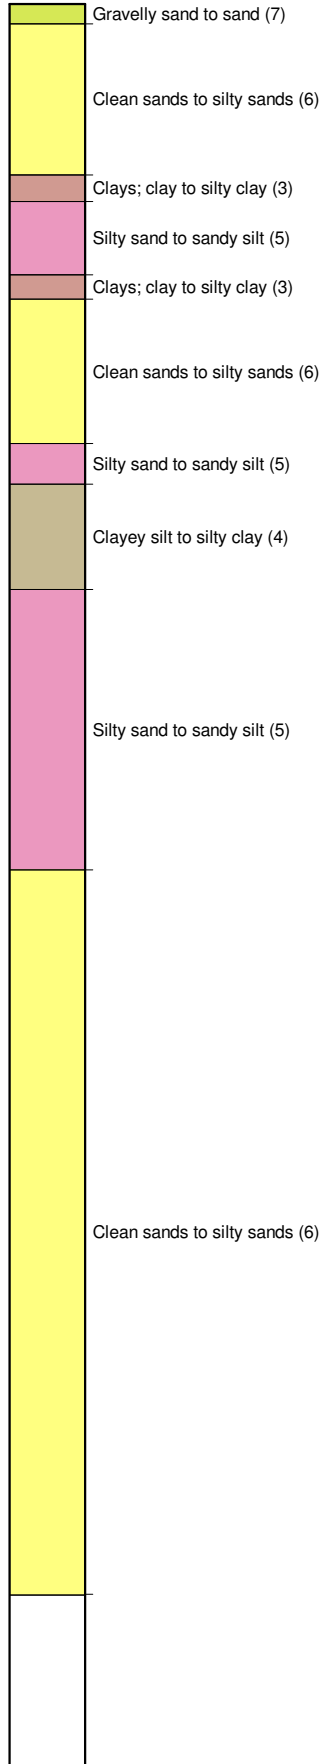


Cone No: 4623 100KN
Tip area [cm2]: 10
Sleeve area [cm2]: 150



Location: TAURANGA	Position: X: 0.00 m, Y: 0.00 m	Ground level: 0.00	Test no: 310
Project ID:	Client: COFFEY GEOTECHNICS	Date: 1/7/2014	Scale: 1 : 62
Project: 354 PYES PA RD SITE	Page: 1/1	Fig:	
File: CPT 310.CPT			

**Classification by
Robertson 1990**



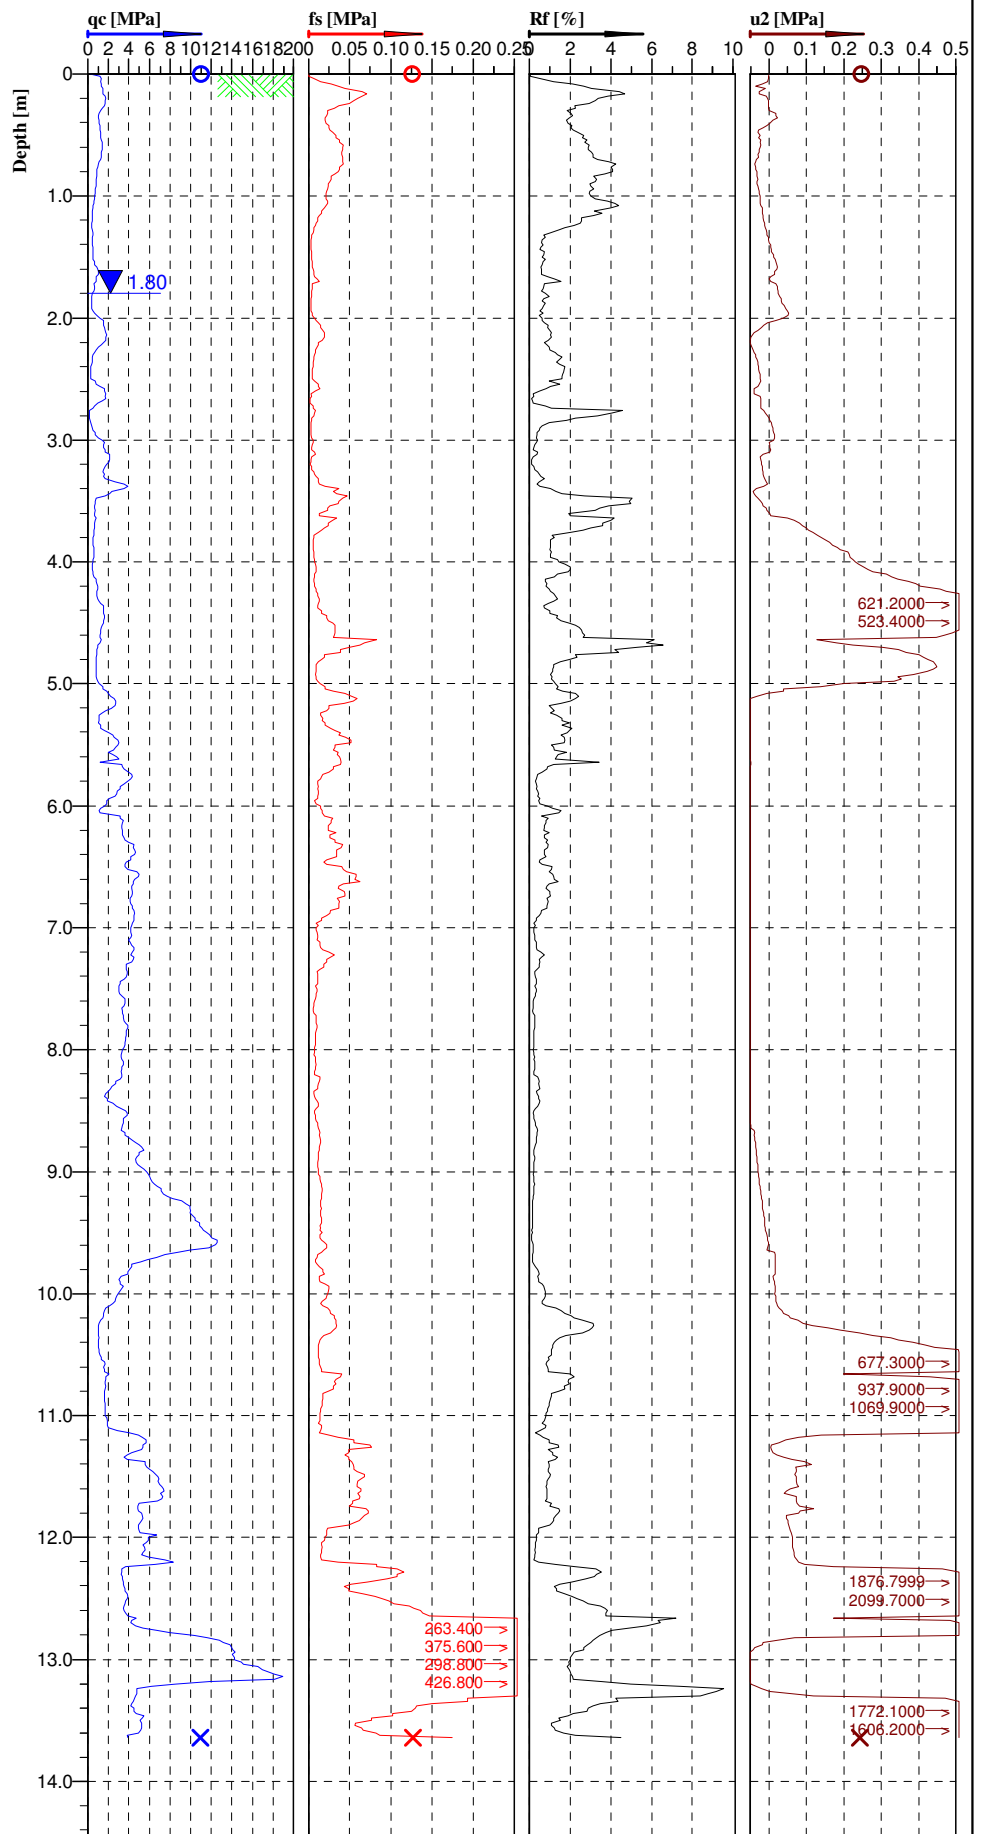
Cone No: 4623 100KN
Tip area [cm²]: 10
Sleeve area [cm²]: 150



Location: TAURANGA	Position: X: 0.00 m, Y: 0.00 m	Ground level: 0.00	Test no: 311
Project ID:	Client: COFFEY GEOTECHNICS	Date: 1/7/2014	Scale: 1 : 62
Project: 354 PYES PA RD SITE	Page: 1/1	Fig:	
		File: CPT 311.CPT	

**Classification by
Robertson 1990**

Very stiff sand to clayey sand (8)
Silty sand to sandy silt (5)
Clayey silt to silty clay (4)
Silty sand to sandy silt (5)
Clays; clay to silty clay (3)
Clean sands to silty sands (6)
Clays; clay to silty clay (3)
Clayey silt to silty clay (4)
Silty sand to sandy silt (5)
Clayey silt to silty clay (4)
Silty sand to sandy silt (5)
Clean sands to silty sands (6)
Silty sand to sandy silt (5)
Clean sands to silty sands (6)
Silty sand to sandy silt (5)
Clean sands to silty sands (6)
Silty sand to sandy silt (5)
Clean sands to silty sands (6)
Silty sand to sandy silt (5)
Clays; clay to silty clay (3)
Clayey silt to silty clay (4)
Silty sand to sandy silt (5)
Clean sands to silty sands (6)
Clayey silt to silty clay (4)
Silty sand to sandy silt (5)



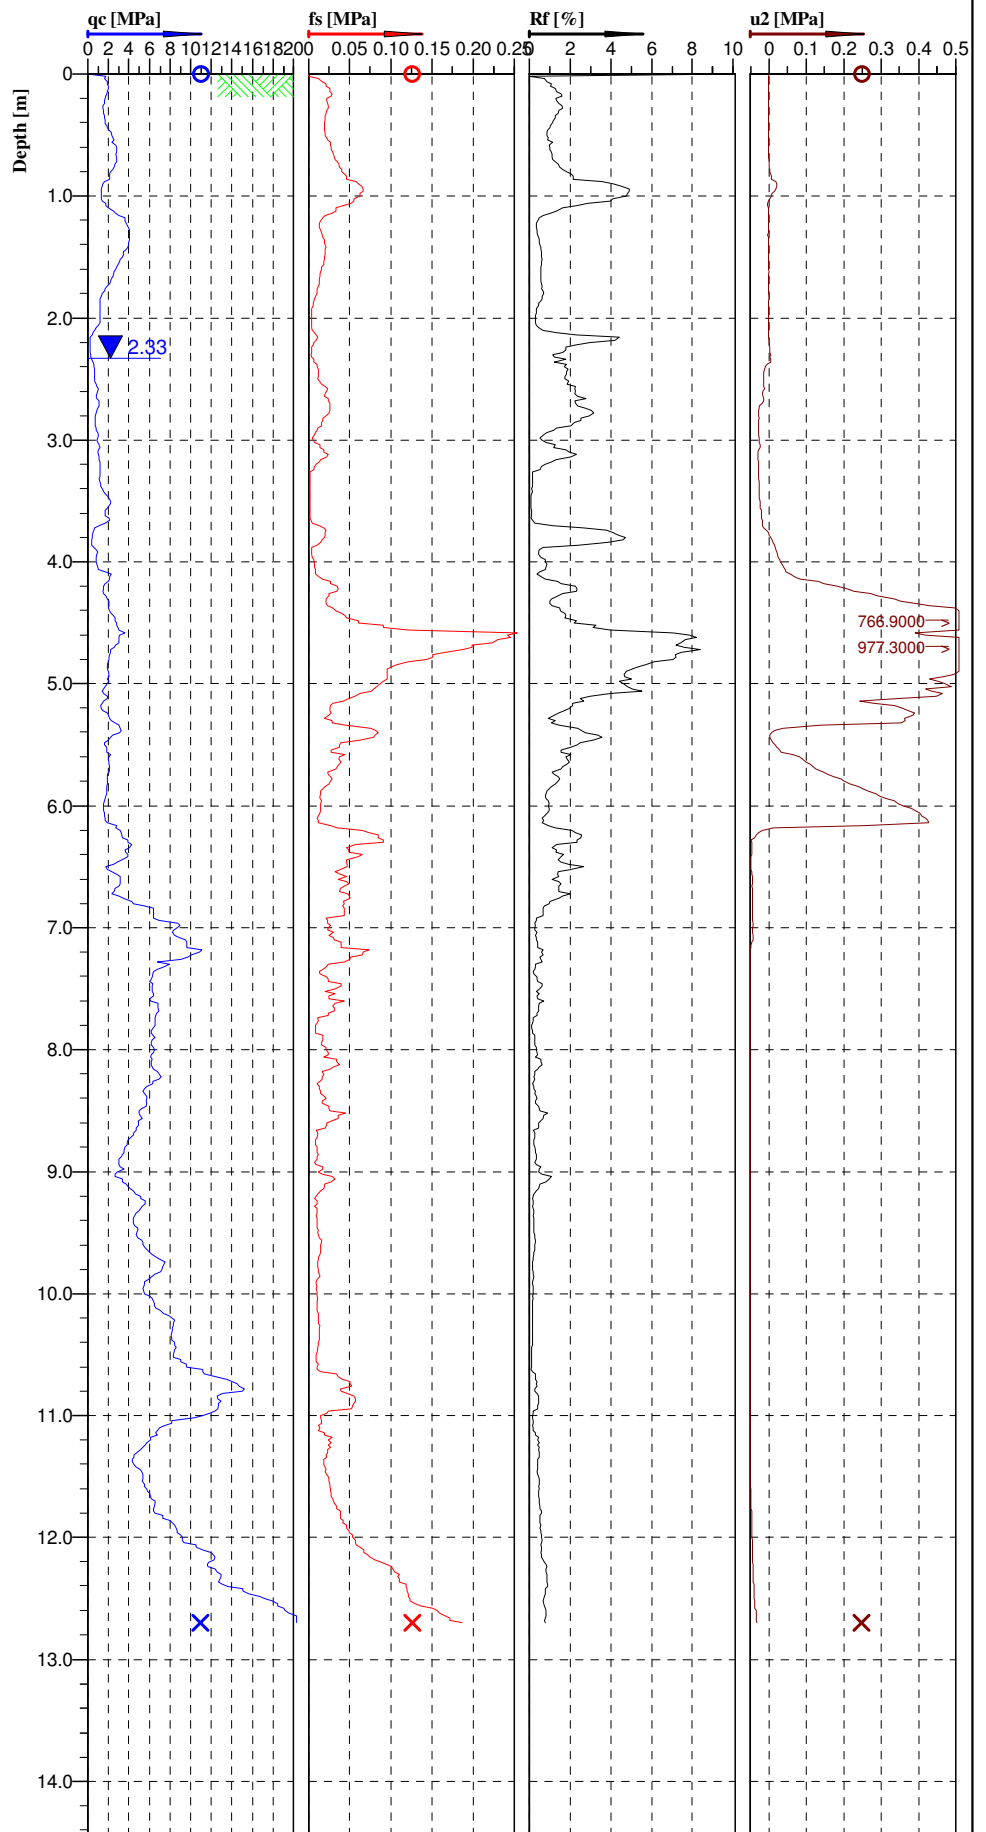
Cone No: 4623 100KN
Tip area [cm2]: 10
Sleeve area [cm2]: 150



Location: TAURANGA	Position: X: 0.00 m, Y: 0.00 m	Ground level: 0.00	Test no: 312
Project ID:	Client: COFFEY GEOTECHNICS	Date: 1/7/2014	Scale: 1 : 62
Project: 354 PYES PA RD SITE		Page: 1/1	Fig:
		File: CPT 312.CPT	

**Classification by
Robertson 1990**

Gravelly sand to sand (7)
Clean sands to silty sands (6)
Clayey silt to silty clay (4)
Clean sands to silty sands (6)
Silty sand to sandy silt (5)
Clays; clay to silty clay (3)
Clayey silt to silty clay (4)
Silty sand to sandy silt (5)
Clean sands to silty sands (6)
Silty sand to sandy silt (5)
Clays; clay to silty clay (3)
Silty sand to sandy silt (5)
Clayey silt to silty clay (4)
Silty sand to sandy silt (5)
Clean sands to silty sands (6)
Silty sand to sandy silt (5)
Clean sands to silty sands (6)



Cone No: 4623 100KN
Tip area [cm²]: 10
Sleeve area [cm²]: 150



Location: TAURANGA	Position: X: 0.00 m, Y: 0.00 m	Ground level: 0.00	Test no: 313
Project ID:	Client: COFFEY GEOTECHNICS	Date: 1/7/2014	Scale: 1 : 62
Project: 354 PYES PA RD SITE	Page: 1/1	Fig:	
File: CPT 313.CPT			

Engineering Log - Trial Pit

Client: **THE LAKES LTD (2012)**

Principal:

Project: **STAGE 3 - ZONE 2**

Trial pit location: **SE of Pipe Stockpile**

Trial Pit No. **TP301**

Sheet 1 of 1

Project No: **GENZTAUC13086AK**

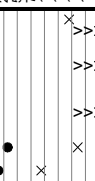
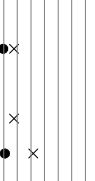
Date started: **12.12.2013**

Date completed: **12.12.2013**

Logged by: **GJN**

Checked by: **RBT**

Equipment type: 20t CAT Pit Orientation: N-S Easting: 369053.82 m R.L. Surface: 37 m
Excavation dimensions: 4.5m long 2.2m wide Vane No: DR4523 Northing: 799353.69 m Datum: ~~xy~~ = BOPC2000, z = Moturiki

excavation information					material substance						
stratigraphy	water	notes samples, tests, etc	RL	depth metres	graphic log	classification symbol	Material Description Soil name; plasticity or grading, colour, secondary components. Moisture, sensitivity, strength. Structure, bedding, cementation, defects. Origin, additional observations. Rock name, grain size & type, colour, fabric, inclusions & minor components. Weathering, moisture, strength, defects.	moisture condition	consistency/ density index	vane shear (remoulded (peak) kPa)	structure and additional observations
FILL	groundwater not encountered		36	1		ML	Sandy SILT, no plasticity, orange mottled white,	M-W	VSt-H		
						ML	Sandy SILT, no plasticity, black; organic odor & fibre.				
						ML	Sandy SILT, no plasticity, orange,				
						ML	Sandy SILT, no plasticity, mottled pink-brown				
			35	2		SM	Silty SAND, fine to medium grained, grey	F-St			
			34	3							
			33	4							
AD			33	4		SP	SAND, fine to medium grained, light grey, trace silt				
			32	5			EOBH @ 4.2m, hole collapsed AD = ALLUVIAL DEPOSITS Test pit TP301 terminated at 4.2 metres.				
			31	6							

Sketch

classification symbols and
soil description
based on New Zealand Geotechnical Society Inc 2005

notes, samples, tests

U₅₀ undisturbed sample 50mm diameter
U₆₃ undisturbed sample 63mm diameter
D disturbed sample
Bs bulk sample
E environmental sample
R refusal

vane shear (kPa)

● remoulded
x peak
>>x peak greater than 200kPa
UTP unable to penetrate

water

10/1/98 water level
on date shown
water inflow
water outflow

moisture

D dry
M moist
W wet
S saturated

consistency/ density index

VS very soft VL very loose
S soft L loose
F firm MD medium dense
St stiff D dense
VSt very stiff VD very dense
H hard

Engineering Log - Trial Pit

Client: **THE LAKES LTD (2012)**

Principal:

Project: **STAGE 3 - ZONE 2**

Trial pit location: **NW Corner of Proposed Fill Area**

Trial Pit No. **TP302**

Sheet 1 of 1

Project No: **GENZTAUC13086AK**

Date started: **12.12.2013**

Date completed: **12.12.2013**

Logged by: **GJN**

Checked by: **RBT**

Equipment type: 20t CAT Pit Orientation: N-S Easting: 368949.29 m R.L. Surface: 35 m
Excavation dimensions: 4.5m long 2.2m wide Vane No: DR4523 Northing: 799362.67 m Datum: ~~xy~~ = BOPC2000, z = Moturiki

excavation information					material substance						
stratigraphy	water	notes samples, tests, etc	RL	depth metres	graphic log	classification symbol	Material Description Soil name; plasticity or grading, colour, secondary components. Moisture, sensitivity, strength. Structure, bedding, cementation, defects. Origin, additional observations. Rock name, grain size & type, colour, fabric, inclusions & minor components. Weathering, moisture, strength, defects.	moisture condition	consistency/ density index	vane shear (remoulded /peak) kPa	structure and additional observations
FILL			34	1		ML	Sandy SILT, no plasticity, mottled orange-white, brown.	D-M	F	25	
									H	75	
ALLUVIAL DEPOSITS			33	2		SP	50mm black layer (possibly buried topsoil) SAND, fine to medium grained, poorly graded, light brown, trace gravel.			100	
			32	3			becoming moist to wet becoming dark orange-white	M-W		125	
							becoming grey, fine grained seepage			150	
	12/12/2013		31	4			EOBH @ 3.8m, hole collapsed, increasing water inflow Test pit TP302 terminated at 3.8 metres.			175	
			30	5							
			29	6							

Sketch

classification symbols and
soil description
based on New Zealand Geotechnical Society Inc 2005

notes, samples, tests

U₅₀ undisturbed sample 50mm diameter
U₆₃ undisturbed sample 63mm diameter
D disturbed sample
Bs bulk sample
E environmental sample
R refusal

vane shear (kPa)

● remoulded
× peak
>>× peak greater than 200kPa
UTP unable to penetrate

water

10/1/98 water level
on date shown
water inflow
water outflow

moisture

D dry
M moist
W wet
S saturated

consistency/ density index

VS very soft VL very loose
S soft L loose
F firm MD medium dense
St stiff D dense
VSt very stiff VD very dense
H hard

Engineering Log - Trial Pit

Client: **THE LAKES LTD (2012)**

Principal:

Project: **STAGE 3 - ZONE 2**

Trial pit location: **SW Corner of Proposed Fill Area**

Trial Pit No. **TP303**

Sheet 1 of 1

Project No: **GENZTAUC13086AK**

Date started: **12.12.2013**

Date completed: **12.12.2013**

Logged by: **GJN**

Checked by: **RBT**

Equipment type: 20t CAT Pit Orientation: N-S Easting: 368942.31 m R.L. Surface: 40.5 m

Excavation dimensions: 4.5m long 2.2m wide Vane No: DR4523 Northing: 799320.25 m Datum: ~~xy~~ = BOPC2000, z = Moturiki

excavation information					material substance						
stratigraphy	water	notes samples, tests, etc	RL	depth metres	graphic log	classification symbol	Material Description Soil name; plasticity or grading, colour, secondary components. Moisture, sensitivity, strength. Structure, bedding, cementation, defects. Origin, additional observations. Rock name, grain size & type, colour, fabric, inclusions & minor components. Weathering, moisture, strength, defects.	moisture condition	consistency/ density index	vane shear (remoulded (peak) kPa)	structure and additional observations
FILL	12/12/2013	▼	40	1		ML	Sandy SILT, no plasticity, mottled pink-brown, white.	M	VSt-H	●	
			39	2			- black staining			×	
			38	3			- minor water inflow			×	
			37	4						×	
			36	5						×	
			35	6			EOBH @ 4.8m, target depth. Test pit TP303 terminated at 4.8 metres.				
			34								

Sketch

classification symbols and
soil description
based on New Zealand Geotechnical Society Inc 2005

notes, samples, tests

U₅₀ undisturbed sample 50mm diameter
U₆₃ undisturbed sample 63mm diameter
D disturbed sample
Bs bulk sample
E environmental sample
R refusal

vane shear (kPa)

● remoulded
× peak
>>× peak greater than 200kPa
UTP unable to penetrate

water

10/1/98 water level
on date shown
▶ water inflow
◀ water outflow

moisture

D dry
M moist
W wet
S saturated

consistency/ density index

VS very soft VL very loose
S soft L loose
F firm MD medium dense
St stiff D dense
VSt very stiff VD very dense
H hard

Engineering Log - Trial Pit

Client: **THE LAKES LTD (2012)**

Principal:

Project: **STAGE 3 - ZONE 2**

Trial pit location: **SE Corner of Proposed Fill Area**

Trial Pit No. **TP304**

Sheet 1 of 1

Project No: **GENZTAUC13086AK**

Date started: **12.12.2013**

Date completed: **12.12.2013**

Logged by: **GJN**

Checked by: **RBT**

Equipment type: 20t CAT Pit Orientation: N-S Easting: 369054.59 m R.L. Surface: 44 m
Excavation dimensions: 4.5m long 2.2m wide Vane No: DR4523 Northing: 799276.71 m Datum: ~~xy~~ = BOPC2000, z = Moturiki

excavation information					material substance				
stratigraphy	water	notes samples, tests, etc	RL	depth metres	graphic log	classification symbol	Material Description Soil name; plasticity or grading, colour, secondary components. Moisture, sensitivity, strength. Structure, bedding, cementation, defects. Origin, additional observations. Rock name, grain size & type, colour, fabric, inclusions & minor components. Weathering, moisture, strength, defects.	moisture condition	consistency/ density index
UNCONTROLLED FILL	12/12/2013		43	1		ML	Sandy SILT, no plasticity, orange-pink.	M-W	F
			42	2		ML	- water inflow, 50mm sand lense		
ENGINEERED FILL			41	3		ML	Sandy SILT, no plasticity, orange-pink, with orange-black silt pocket (embankment fill).	H	
			40	4		ML	- silt pocket, orange-black, no plasticity		
			39	5		ML	EOBH @ 4.8m, target depth.		
			38	6			Test pit TP304 terminated at 4.8 metres.		

Sketch

classification symbols and
soil description
based on New Zealand Geotechnical Society Inc 2005

notes, samples, tests

U₅₀ undisturbed sample 50mm diameter
U₆₃ undisturbed sample 63mm diameter
D disturbed sample
Bs bulk sample
E environmental sample
R refusal

vane shear (kPa)

● remoulded
× peak
>>× peak greater than 200kPa
UTP unable to penetrate

water

10/1/98 water level
on date shown
water inflow
water outflow

moisture

D dry
M moist
W wet
S saturated

consistency/ density index

VS very soft VL very loose
S soft L loose
F firm MD medium dense
St stiff D dense
VSt very stiff VD very dense
H hard

Engineering Log - Trial Pit

Client: **THE LAKES LTD (2012)**

Principal:

Project: **STAGE 3 - ZONE 2**

Trial pit location: **Eastern End of Proposed Fill Area**

Trial Pit No. **TP305**

Sheet 1 of 1

Project No: **GENZTAUC13086AK**

Date started: **12.12.2013**

Date completed: **12.12.2013**

Logged by: **GJN**

Checked by: **RBT**

Equipment type: 20t CAT Pit Orientation: N-S Easting: 369069.39 m R.L. Surface: 42 m
Excavation dimensions: 4.5m long 2.2m wide Vane No: DR4523 Northing: 799305.38 m Datum: ~~xy~~ = BOPC2000, z = Moturiki

excavation information					material substance				
stratigraphy	water	notes samples, tests, etc	RL	depth metres	graphic log	classification symbol	Material Description Soil name; plasticity or grading, colour, secondary components. Moisture, sensitivity, strength. Structure, bedding, cementation, defects. Origin, additional observations. Rock name, grain size & type, colour, fabric, inclusions & minor components. Weathering, moisture, strength, defects.	moisture condition	consistency/ density index
ALLUVIAL DEPOSITS	BT	groundwater not encountered	41	1		ML	Sandy SILT, non plastic, liquid limit, pink orange, mottled brown.	M	VSt-H
			40	2		OL	- some black organic pockets		
			39	3		ML	- old telephone wire Sandy SILT non plastic liquid limit, brown orange.		
			38	4		SM	Silty SAND, fine to medium grained, white, with cobbles & gravels of completely weathered pumice.		St-Vst
			37	5					
			36	6			EOBH @ 5.2m, target depth. Test pit TP305 terminated at 5.2 metres.		

Sketch

classification symbols and
soil description
based on New Zealand Geotechnical Society Inc 2005

notes, samples, tests

U₅₀ undisturbed sample 50mm diameter
U₆₃ undisturbed sample 63mm diameter
D disturbed sample
Bs bulk sample
E environmental sample
R refusal

vane shear (kPa)

● remoulded
× peak
>>× peak greater than 200kPa
UTP unable to penetrate

water

10/1/98 water level
on date shown
▶ water inflow
◀ water outflow

moisture

D dry
M moist
W wet
S saturated

consistency/ density index

VS very soft VL very loose
S soft L loose
F firm MD medium dense
St stiff D dense
VSt very stiff VD very dense
H hard

Engineering Log - Trial Pit

Client: **THE LAKES LTD (2012)**

Principal:

Project: **STAGE 3 - ZONE 2**

Trial pit location: **Base of Section C-C**

Trial Pit No. **TP308**

Sheet 1 of 1

Project No: **GENZTAUC13086AK**

Date started: **10.1.2014**

Date completed: **10.1.2014**

Logged by: **AP**

Checked by: **RBT**

Equipment type: 20t CAT Pit Orientation: E-W Easting: 368941.002 m R.L. Surface: 27 m
Excavation dimensions: 4.5m long 2.2m wide Vane No: DR4523 Northing: 799953.274 m Datum: ~~xy~~ = BOPC2000, z = Moturiki

excavation information					material substance									
stratigraphy	water	notes samples, tests, etc	RL	depth metres	graphic log	classification symbol	Material Description Soil name; plasticity or grading, colour, secondary components. Moisture, sensitivity, strength. Structure, bedding, cementation, defects. Origin, additional observations. Rock name, grain size & type, colour, fabric, inclusions & minor components. Weathering, moisture, strength, defects.	moisture condition	consistency/ density index	vane shear (remoulded (peak) kPa)	structure and additional observations			
ALLUVIAL DEPOSITS			26	1		OL	Sandy SILT, no plasticity, black, organic odour; sand is fine grained. (TOPSOIL)	D-M			Groundwater inflow at 1.5m			
			25	2		SW PT	Silty SAND, fine to coarse, orange brown, subangular to subrounded. Dry to moist. PEAT, moderately decomposed branches and logs, approximately 75% of soil volume. Dark brown black, strong organic odour.	M-W						
			24	3		ML	SILT some sand, non plastic, pale grey white with blue green staining.							
			23	4							Hard digging at 3.8m			
			22	5										
			21	6		SW	SAND, some gravel, medium to coarse, blue grey. Saturated. Gravels fine to medium.				Easy digging at 4.8m			
							Test pit TP308 terminated at 5.5 metres.							

Sketch

classification symbols and
soil description
based on New Zealand Geotechnical Society Inc 2005

notes, samples, tests

U₅₀ undisturbed sample 50mm diameter
U₆₃ undisturbed sample 63mm diameter
D disturbed sample
Bs bulk sample
E environmental sample
R refusal

vane shear (kPa)

● remoulded
× peak
>>× peak greater than 200kPa
UTP unable to penetrate

water

10/1/98 water level
on date shown
▶ water inflow
◀ water outflow

moisture

D dry
M moist
W wet
S saturated

consistency/ density index

VS very soft VL very loose
S soft L loose
F firm MD medium dense
St stiff D dense
VSt very stiff VD very dense
H hard

Engineering Log - Trial Pit

Client: **THE LAKES LTD (2012)**

Principal:

Project: **STAGE 3 - ZONE 2**

Trial pit location: **Base of Section E-E**

Trial Pit No. **TP309**

Sheet 1 of 1

Project No: **GENZTAUC13086AK**

Date started: **10.1.2014**

Date completed: **10.1.2014**

Logged by: **AP**

Checked by: **RBT**

Equipment type: 20t CAT Pit Orientation: E-W Easting: 369038.885 m R.L. Surface: 35 m
Excavation dimensions: 4.5m long 2.2m wide Vane No: DR4523 Northing: 799836.544 m Datum: ~~xy~~ = BOPC2000, z = Moturiki

excavation information					material substance				
stratigraphy	water	notes samples, tests, etc	RL	depth metres	graphic log	classification symbol	Material Description Soil name: plasticity or grading, colour, secondary components. Moisture, sensitivity, strength. Structure, bedding, cementation, defects. Origin, additional observations. Rock name, grain size & type, colour, fabric, inclusions & minor components. Weathering, moisture, strength, defects.	moisture condition	consistency/ density index
VOLCANIC ASHES			34	1		OL	Sandy SILT, no plasticity, black, organic odour; sand is fine grained. (TOPSOIL)	D-M	
						SW	SAND, some silt, fine to coarse, orange. Dry.		
			33	2		SW	SAND, trace silt, fine to coarse, pale yellow brown. Dry to moist.		
			32	3			- Layered deposits dip parallel to slope (i.e. draped ashes)		
			31	4		SW	Sand, trace silt, fine to coarse, pale grey. Moist, pumiceous.	M	
			30	5			- layering with yellow medium to coarse sand with limonite staining.	M-W	
			29	6		SW	Silty SAND, fine to coarse, grey sub angular to sub rounded. Wet to saturated, pumiceous. Test pit TP309 terminated at 5.8 metres.		

Sketch

classification symbols and
soil description
based on New Zealand Geotechnical Society Inc 2005

notes, samples, tests

U₅₀ undisturbed sample 50mm diameter
U₆₃ undisturbed sample 63mm diameter
D disturbed sample
Bs bulk sample
E environmental sample
R refusal

vane shear (kPa)

● remoulded
× peak
××× peak greater than 200kPa
UTP unable to penetrate

water

10/1/98 water level
on date shown
water inflow
water outflow

moisture

D dry
M moist
W wet
S saturated

consistency/ density index

VS very soft VL very loose
S soft L loose
F firm MD medium dense
St stiff D dense
VSt very stiff VD very dense
H hard

Engineering Log - Trial Pit

Client: **THE LAKES LTD (2012)**

Principal:

Project: **STAGE 3 - ZONE 2**

Trial pit location: **Base of Section H-H**

Trial Pit No. **TP310**

Sheet 1 of 1

Project No: **GENZTAUC13086AK**

Date started: **10.1.2014**

Date completed: **10.1.2014**

Logged by: **GJN**

Checked by: **RBT**

Equipment type: 20t CAT Pit Orientation: E-W Easting: 369080.399 m R.L. Surface: 40 m
Excavation dimensions: 4.5m long 2.2m wide Vane No: Northing: 799340.217 m Datum: ~~xy~~ = BOPC2000, z = Moturiki

excavation information					material substance						
stratigraphy	water	notes samples, tests, etc	RL	depth metres	graphic log	classification symbol	Material Description Soil name: plasticity or grading, colour, secondary components. Moisture, sensitivity, strength. Structure, bedding, cementation, defects. Origin, additional observations. Rock name, grain size & type, colour, fabric, inclusions & minor components. Weathering, moisture, strength, defects.	moisture condition	consistency/ density index	vane shear (remoulded (peak) kPa)	structure and additional observations
VOLCANIC ASHES	groundwater not encountered		39	1		SW	SAND with trace gravel and cobbles, fine to medium, angular to sub-angular, white. Dry to moist, pumiceous. Cobbles 60 to 80mm, pumiceous.	D-M			
			38	2							
			37	3							
			36	4			(Refusal) Test pit TP310 terminated at 3 metres.				Too hard to excavate with clearing bucket
			35	5							
			34	6							

Sketch

classification symbols and
soil description
based on New Zealand Geotechnical Society Inc 2005

notes, samples, tests

U₅₀ undisturbed sample 50mm diameter
U₆₃ undisturbed sample 63mm diameter
D disturbed sample
Bs bulk sample
E environmental sample
R refusal

vane shear (kPa)

● remoulded
× peak
>>× peak greater than 200kPa
UTP unable to penetrate

water

10/1/98 water level
on date shown
water inflow
water outflow

moisture

D dry
M moist
W wet
S saturated

consistency/ density index

VS very soft VL very loose
S soft L loose
F firm MD medium dense
St stiff D dense
VSt very stiff VD very dense
H hard

Engineering Log - Trial Pit

Client: **THE LAKES LTD (2012)**

Principal:

Project: **STAGE 3 - ZONE 2**

Trial pit location: **Below Access Road - Section D-D**

Trial Pit No. **TP311**

Sheet 1 of 1

Project No: **GENZTAUC13086AK**

Date started: **10.1.2014**

Date completed: **10.1.2014**

Logged by: **AP**

Checked by: **RBT**

Equipment type: 20t CAT Pit Orientation: E-W Easting: 368956.902 m R.L. Surface: 40 m
Excavation dimensions: 4.5m long 2.2m wide Vane No: DR4523 Northing: 799540.004 m Datum: ~~xy~~ = BOPC2000, z = Moturiki

excavation information					material substance							
stratigraphy	water	notes samples, tests, etc	RL	depth metres	graphic log	classification symbol	Material Description Soil name; plasticity or grading, colour, secondary components. Moisture, sensitivity, strength. Structure, bedding, cementation, defects. Origin, additional observations. Rock name, grain size & type, colour, fabric, inclusions & minor components. Weathering, moisture, strength, defects.	moisture condition	consistency/ density index	vane shear (remoulded /peak) kPa	structure and additional observations	
ALLUVIAL TERRACE DEPOSITS			39	1		OL	Sandy SILT, no plasticity, black, organic odour; sand is fine grained. (TOPSOIL)	D-M	F	25 50 100 150 175		
						ML	Sandy SILT, no plasticity, orange. Dry to moist, sensitive. Sand is fine to coarse.	M		●	x	
						ML	Sandy SILT, no plasticity, pale orange. Moist, sensitive. Sand is fine to medium.		VSt	●	x	
			38	2		SW	SAND minor silt, fine to coarse, pale orange. Moist to wet.	M-W		●	x	
VOLCANIC ASHES			37	3								
			36	4		SW	SAND, medium to coarse, pale brown white. Moist to wet.					
			35	5			- sand layering with pale brown fine to coarse sand.					
			34	6			(Target depth) Test pit TP311 terminated at 5.4 metres.					

Sketch

classification symbols and
soil description
based on New Zealand Geotechnical Society Inc 2005

notes, samples, tests

U₅₀ undisturbed sample 50mm diameter
U₆₃ undisturbed sample 63mm diameter
D disturbed sample
Bs bulk sample
E environmental sample
R refusal

vane shear (kPa)

• remoulded
x peak
>>x peak greater than 200kPa
UTP unable to penetrate

water

10/1/98 water level
on date shown
▶ water inflow
◀ water outflow

moisture

D dry
M moist
W wet
S saturated

consistency/ density index

VS very soft VL very loose
S soft L loose
F firm MD medium dense
St stiff D dense
VSt very stiff VD very dense
H hard

Engineering Log - Trial Pit

Client: **THE LAKES LTD (2012)**

Principal:

Project: **STAGE 3 - ZONE 2**

Trial pit location: **Base of Gully**

Trial Pit No. **TP312**

Sheet 1 of 1

Project No: **GENZTAUC13086AK**

Date started: **10.1.2014**

Date completed: **10.1.2014**

Logged by: **AP**

Checked by: **RBT**

Equipment type: 20t CAT Pit Orientation: E-W Easting: 369019.722 m R.L. Surface: 27 m
Excavation dimensions: 4.5m long 2.2m wide Vane No: DR4523 Northing: 799614.268 m Datum: ~~xy~~ = BOPC2000, z = Moturiki

excavation information				material substance							
stratigraphy	water	notes samples, tests, etc	RL	depth metres	graphic log	classification symbol	Material Description Soil name; plasticity or grading, colour, secondary components. Moisture, sensitivity, strength. Structure, bedding, cementation, defects. Origin, additional observations. Rock name, grain size & type, colour, fabric, inclusions & minor components. Weathering, moisture, strength, defects.	moisture condition	consistency/ density index	vane shear (remoulded (peak) kPa)	structure and additional observations
ALLUVIAL DEPOSITS	▶		26	1		OL	Sandy SILT, no plasticity, black, organic odour; sand is fine grained. (TOPSOIL)	M	VSt	25	Groundwater seepage/inflow a 1.0m
						ML	Sandy SILT, low plasticity, grey. Moist, sensitive. Sand is fine to medium. - increasing sand content below 0.8m depth, limonite staining.			50	
						PT	PEAT, dark brown black, moderately decomposed logs and branches. Strong organic odour.	W-S		100	
			25	2		SW	SAND, trace silt, fine, grey, subrounder to subangular. Wet to saturated, organic inclusions (approximately 20%).			125	
			24	3						150	
			23	4		ML	SILT, trace sand, non plastic, grey with blue green staining. Moist to wet.	M-W		175	
			22	5							Digging becoming hard
			21	6			Test pit TP312 terminated at 5.5 metres.				

Sketch

classification symbols and
soil description
based on New Zealand Geotechnical Society Inc 2005

notes, samples, tests

U₅₀ undisturbed sample 50mm diameter
U₆₃ undisturbed sample 63mm diameter
D disturbed sample
Bs bulk sample
E environmental sample
R refusal

vane shear (kPa)

• remoulded
× peak
××× peak greater than 200kPa
UTP unable to penetrate

water

10/1/98 water level
on date shown
▶ water inflow
◀ water outflow

moisture

D dry
M moist
W wet
S saturated

consistency/ density index

VS very soft VL very loose
S soft L loose
F firm MD medium dense
St stiff D dense
VSt very stiff VD very dense
H hard

Engineering Log - Trial Pit

Client: **THE LAKES LTD (2012)**

Principal:

Project: **STAGE 3 - ZONE 2**

Trial pit location: **Base of Gully**

Trial Pit No. **TP313**

Sheet 1 of 1

Project No: **GENZTAUC13086AK**

Date started: **10.1.2014**

Date completed: **10.1.2014**

Logged by: **GJN**

Checked by: **RBT**

Equipment type: 20t CAT Pit Orientation: E-W Easting: 368998.034 m R.L. Surface: 28 m
Excavation dimensions: 4.5m long 2.2m wide Vane No: DR4523 Northing: 799758.139 m Datum: ~~xy~~ = BOPC2000, z = Moturiki

excavation information					material substance								
stratigraphy	water	notes samples, tests, etc	RL	depth metres	graphic log	classification symbol	Material Description Soil name: plasticity or grading, colour, secondary components. Moisture, sensitivity, strength. Structure, bedding, cementation, defects. Origin, additional observations. Rock name, grain size & type, colour, fabric, inclusions & minor components. Weathering, moisture, strength, defects.	moisture condition	consistency/ density index	vane shear (remoulded (peak) kPa)	structure and additional observations		
ALLUVIAL DEPOSITS			27	1		OL	Sandy SILT, no plasticity, black, organic odour; sand is fine grained. (TOPSOIL)	M	F-St		Groundwater seepage/inflow a 2.5m		
						ML	Silty SAND, fine, grey brown. Moist, minor limonite staining.	W					
							Sandy SILT trace gravel, non plastic, grey brown. Wet, limonite staining, rootlets (fine), gravels are pumiceous.						
					26	2							
25	3		SW	- becoming wet to saturated at 2.5m depth. Silty SAND, trace gravel, fine to coarse, white with brown and orange staining. Saturated, gravels are fine to medium, pumiceous. - becomes pale yellow white at 3.0m	S								
		24	4										
		23	5		SW	Silty SAND, some gravel, fine to medium, blue grey. Staurated. (Target depth) Test pit TP313 terminated at 4.6 metres.							
		22	6										

Sketch

classification symbols and
soil description
based on New Zealand Geotechnical Society Inc 2005

notes, samples, tests

U₅₀ undisturbed sample 50mm diameter
U₆₃ undisturbed sample 63mm diameter
D disturbed sample
Bs bulk sample
E environmental sample
R refusal

vane shear (kPa)

● remoulded
× peak
>>× peak greater than 200kPa
UTP unable to penetrate

water

10/1/98 water level
on date shown
▶ water inflow
◀ water outflow

moisture

D dry
M moist
W wet
S saturated

consistency/ density index

VS very soft VL very loose
S soft L loose
F firm MD medium dense
St stiff D dense
VSt very stiff VD very dense
H hard

Engineering Log - Trial Pit

Client: **THE LAKES LTD (2012)**

Principal:

Project: **STAGE 3 - ZONE 2**

Trial pit location: **Base of Gully**

Trial Pit No. **TP314**

Sheet 1 of 1

Project No: **GENZTAUC13086AK**

Date started: **10.1.2014**

Date completed: **10.1.2014**

Logged by: **AP**

Checked by: **RBT**

Equipment type: 20t CAT Pit Orientation: E-W Easting: 369035.352 m R.L. Surface: 28 m
Excavation dimensions: 4.5m long 2.2m wide Vane No: DR4523 Northing: 799675.712 m Datum: ~~xy~~ = BOPC2000, z = Moturiki

excavation information					material substance						
stratigraphy	water	notes samples, tests, etc	RL	depth metres	graphic log	classification symbol	Material Description Soil name; plasticity or grading, colour, secondary components. Moisture, sensitivity, strength. Structure, bedding, cementation, defects. Origin, additional observations. Rock name, grain size & type, colour, fabric, inclusions & minor components. Weathering, moisture, strength, defects.	moisture condition	consistency/ density index	vane shear (remoulded /peak) kPa	structure and additional observations
ALLUVIAL DEPOSITS	▶					OL	Sandy SILT, no plasticity, black, organic odour; sand is fine grained. (TOPSOIL)	M	F-St	25	
						ML	Sandy SILT, nonplastic, brown. Moist, some rootlets.			50	●
						ML	SILT, minor sand, low plasticity, brown. Moist to wet.	M-W		100	●
						ML	Sandy SILT, non plastic, pale grey with orange staining. Moist to wet, sensitive.			150	●
									VSt	175	●
			27	1							
			26	2							
			25	3							
			24	4		ML	Sandy SILT, non plastic blue grey. Wet, sands fine.	S			
			23	5		SM	Silty SAND, fine to coarse, grey blue, subangular. Wet.				
			22	6		GW	Gravelly SAND, fine to coarse, dark grey green with brown staining, Angular gravel. (Target depth) Test pit TP314 terminated at 5.5 metres.				
											Groundwater seepage/inflow a 2.5m

Sketch

classification symbols and
soil description
based on New Zealand Geotechnical Society Inc 2005

notes, samples, tests

U₅₀ undisturbed sample 50mm diameter
U₆₃ undisturbed sample 63mm diameter
D disturbed sample
Bs bulk sample
E environmental sample
R refusal

vane shear (kPa)

● remoulded
× peak
>>× peak greater than 200kPa
UTP unable to penetrate

water

10/1/98 water level
on date shown
▶ water inflow
◀ water outflow

moisture

D dry
M moist
W wet
S saturated

consistency/ density index

VS very soft VL very loose
S soft L loose
F firm MD medium dense
St stiff D dense
VSt very stiff VD very dense
H hard

Engineering Log - Trial Pit

Client: **THE LAKES LTD (2012)**

Principal:

Project: **STAGE 3 - ZONE 2**

Trial pit location: **Base of Gully**

Trial Pit No. **TP315**

Sheet 1 of 1

Project No: **GENZTAUC13086AK**

Date started: **24.1.2014**

Date completed: **24.1.2014**

Logged by: **KMJ**

Checked by: **RBT**

Equipment type: 20t CAT Pit Orientation: E-W Easting: 369052.664 m R.L. Surface: 29 m
Excavation dimensions: 3m long 1.5m wide Vane No: SL588 Northing: 799615.101 m Datum: ~~xy~~ = BOPC2000, z = Moturiki

excavation information					material substance				
stratigraphy	water	notes samples, tests, etc	RL	depth metres	graphic log	classification symbol	Material Description Soil name: plasticity or grading, colour, secondary components. Moisture, sensitivity, strength. Structure, bedding, cementation, defects. Origin, additional observations. Rock name, grain size & type, colour, fabric, inclusions & minor components. Weathering, moisture, strength, defects.	moisture condition	consistency/ density index
TS	ALLUVIAL DEPOSIT	23/01/2014	28.5	0.5		OL	Organic SILT, no plasticity, black, rootlets, organic odor (TOPSOIL).	M	F-St
			28.0	1.0		ML	Sandy SILT, non to low plasticity, white-grey, orange mottles, sand is fine grained.		
			27.5	1.5					
			27.0	2.0			- becoming orange-brown with orange mottling	M-W	
			26.5	2.5					
			26.0	3.0		SP	SAND, fine grained, grey.		
			25.5	3.5			EOBH @ 3.0m, target depth. TS= TOPSOIL Test pit TP315 terminated at 3 metres.		
			25.0	4.0					

Sketch

classification symbols and
soil description
based on New Zealand Geotechnical Society Inc 2005

notes, samples, tests

U₅₀ undisturbed sample 50mm diameter
U₆₃ undisturbed sample 63mm diameter
D disturbed sample
Bs bulk sample
E environmental sample
R refusal

vane shear (kPa)

● remoulded
× peak
××× peak greater than 200kPa
UTP unable to penetrate

water

10/1/98 water level
on date shown
water inflow
water outflow

moisture

D dry
M moist
W wet
S saturated

consistency/ density index

VS very soft VL very loose
S soft L loose
F firm MD medium dense
St stiff D dense
VSt very stiff VD very dense
H hard

Engineering Log - Trial Pit

Client: **THE LAKES LTD (2012)**

Principal:

Project: **STAGE 3 - ZONE 2**

Trial pit location: **Base of Gully, North of Sediment Pond**

Trial Pit No. **TP316**

Sheet 1 of 1

Project No: **GENZTAUC13086AK**

Date started: **10.1.2014**

Date completed: **10.1.2014**

Logged by: **AP**

Checked by: **RBT**

Equipment type: 20t CAT Pit Orientation: E-W Easting: 369036.594 m R.L. Surface: 32 m
Excavation dimensions: 4.5m long 2.2m wide Vane No: DR4523 Northing: 799488.445 m Datum: ~~xy~~ = BOPC2000, z = Moturiki

excavation information					material substance						
stratigraphy	water	notes samples, tests, etc	RL	depth metres	graphic log	classification symbol	Material Description Soil name; plasticity or grading, colour, secondary components. Moisture, sensitivity, strength. Structure, bedding, cementation, defects. Origin, additional observations. Rock name, grain size & type, colour, fabric, inclusions & minor components. Weathering, moisture, strength, defects.	moisture condition	consistency/ density index	vane shear (remoulded (peak) kPa)	structure and additional observations
ALLUVIAL DEPOSITS			31	1		OL	Sandy SILT, no plasticity, black, organic odour; sand is fine grained. (TOPSOIL)	M	St	25	Hole collapsing below 2.0m depth Groundwater seepage/inflow a 4.0m
						SW	SAND some silt, fine to coarse, pale brown. Moist to wet.	M-W		75	
			30	2		SW	SAND some silt, fine to coarse, pale brown. Wet to saturated. Limonite staining	W-S		100	
			29	3		ML	Silty SAND with some minor clay, fine to coarse, subrounded to subangular. Pale grey.			125	
			28	4			- becoming pale brown, increasing fines content, limonite staining.			150	
			27	5			- becoming sandy fine to coarse, trace fine gravels, pale grey.			175	
			26	6			(Target depth) Test pit TP316 terminated at 5 metres.				

Sketch

classification symbols and
soil description
based on New Zealand Geotechnical Society Inc 2005

notes, samples, tests

U₅₀ undisturbed sample 50mm diameter
U₆₃ undisturbed sample 63mm diameter
D disturbed sample
Bs bulk sample
E environmental sample
R refusal

vane shear (kPa)

● remoulded
× peak
>>× peak greater than 200kPa
UTP unable to penetrate

water

10/1/98 water level
on date shown
▶ water inflow
◀ water outflow

moisture

D dry
M moist
W wet
S saturated

consistency/ density index

VS very soft VL very loose
S soft L loose
F firm MD medium dense
St stiff D dense
VSt very stiff VD very dense
H hard

Engineering Log - Trial Pit

Client: **THE LAKES LTD (2012)**

Principal:

Project: **STAGE 3 - ZONE 2**

Trial pit location: **Base of Gully - Stream Edge**

Trial Pit No. **TP317**

Sheet 1 of 1

Project No: **GENZTAUC13086AK**

Date started: **24.1.2014**

Date completed: **24.1.2014**

Logged by: **KMJ**

Checked by: **RBT**

Equipment type: 20t CAT Pit Orientation: E-W Easting: 368954.447 m R.L. Surface: 28 m
Excavation dimensions: 10m long 1.5m wide Vane No: SL588 Northing: 799697.977 m Datum: ~~xy~~ = BOPC2000, z = Moturiki

excavation information					material substance				
stratigraphy	water	notes samples, tests, etc	RL	depth metres	graphic log	classification symbol	Material Description Soil name; plasticity or grading, colour, secondary components. Moisture, sensitivity, strength. Structure, bedding, cementation, defects. Origin, additional observations. Rock name, grain size & type, colour, fabric, inclusions & minor components. Weathering, moisture, strength, defects.	moisture condition	consistency/ density index
TS						ML	Sandy SILT, no plasticity, black, organic odor, rootlets; sand is fine grained (TOPSOIL).	D-M	F-St
AD			27.5	0.5		SM	Silty SAND, fine to coarse grained, oragne-brown, sub-angular.		
PEAT			27.0	1.0		OL	Organic SILT, no plasticity, black, organic odor, with tree branches & organic inclusions (PEAT).		
			26.5	1.5					
AD		23/01/2014	26.0	2.0		ML	Sandy SILT/Silty SAND, no plasticity, white-grey, orange staining; sand is fine grained, abundant tree branches.	W-S	
			25.5	2.5			EOBH @ 2.3m, target depth. TS= TOPSOIL AD= ALLUVIAL DEPOSITS Test pit TP317 terminated at 2.3 metres.		
			25.0	3.0					
			24.5	3.5					
			24.0	4.0					

Sketch

classification symbols and
soil description
based on New Zealand Geotechnical Society Inc 2005

notes, samples, tests

U₅₀ undisturbed sample 50mm diameter
U₆₃ undisturbed sample 63mm diameter
D disturbed sample
Bs bulk sample
E environmental sample
R refusal

vane shear (kPa)

● remoulded
× peak
××× peak greater than 200kPa
UTP unable to penetrate

water

10/1/98 water level
on date shown
water inflow
water outflow

moisture

D dry
M moist
W wet
S saturated

consistency/ density index

VS very soft VL very loose
S soft L loose
F firm MD medium dense
St stiff D dense
VSt very stiff VD very dense
H hard

Engineering Log - Trial Pit

Client: **THE LAKES LTD (2012)**

Principal:

Project: **STAGE 3 - ZONE 2**

Trial pit location: **Base of Gully - Stream Edge**

Trial Pit No. **TP318**

Sheet 1 of 1

Project No: **GENZTAUC13086AK**

Date started: **24.1.2014**

Date completed: **24.1.2014**

Logged by: **KMJ**

Checked by: **RBT**

Equipment type: 20t CAT Pit Orientation: E-W Easting: 368974.098 m R.L. Surface: 28 m
Excavation dimensions: 19m long 1.5m wide Vane No: SL588 Northing: 799679.552 m Datum: ~~xy~~ = BOPC2000, z = Moturiki

excavation information					material substance						
stratigraphy	water	notes samples, tests, etc	RL	depth metres	graphic log	classification symbol	Material Description Soil name; plasticity or grading, colour, secondary components. Moisture, sensitivity, strength. Structure, bedding, cementation, defects. Origin, additional observations. Rock name, grain size & type, colour, fabric, inclusions & minor components. Weathering, moisture, strength, defects.	moisture condition	consistency/ density index	vane shear (remoulded /peak) kPa	structure and additional observations
TS			27.5	0.5		ML	Sandy SILT, no plasticity, organic odor, rootlets, sand is fine to medium grained (TOPSOIL).	M-W	St	25	
PEAT						ML	Sandy SILT, non to low plasticity, pale-grown, with peat inclusions.			50	
						OL	Organic SILT, no plasticity, black, with brown & grey staining, some fine sand.			100	
										125	
										150	
AD	23/01/2014 ▼	26.5	1.5		ML	SILT, low plasticity, grey-white, abundant tree branches, minor fine sand.	W	St	175		
26.0	2.0		25								
25.5	2.5		50								
			25.0	3.0			EOBH @ 2.0m, target depth. TS= TOPSOIL AD= ALLUVIAL DEPOSITS Test pit TP318 terminated at 2 metres.				
			24.5	3.5							
			24.0	4.0							

Engineering Log - Trial Pit

Client: **THE LAKES LTD (2012)**

Principal:

Project: **STAGE 3 - ZONE 2**

Trial pit location: **Base of Gully - Stream Edge**

Trial Pit No. **TP319**

Sheet 1 of 1

Project No: **GENZTAUC13086AK**

Date started: **24.1.2014**

Date completed: **24.1.2014**

Logged by: **KMJ**

Checked by: **RBT**

Equipment type: 20t CAT Pit Orientation: E-W Easting: 368998.748 m R.L. Surface: 26 m
Excavation dimensions: 8m long 1.5m wide Vane No: SL588 Northing: 799633.397 m Datum: ~~xy~~ = BOPC2000, z = Moturiki

excavation information					material substance						
stratigraphy	water	notes samples, tests, etc	RL	depth metres	graphic log	classification symbol	Material Description Soil name; plasticity or grading, colour, secondary components. Moisture, sensitivity, strength. Structure, bedding, cementation, defects. Origin, additional observations. Rock name, grain size & type, colour, fabric, inclusions & minor components. Weathering, moisture, strength, defects.	moisture condition	consistency/ density index	vane shear (remoulded (peak) kPa)	structure and additional observations
TS						OL	Sandy SILT, no plasticity, rootlets, dar-brown to black, organic odor, some fine sand (TOPSOIL).	M	St		
P			25.5	0.5		OL	Organic SILT, no plasticity, black, organic odor.				
ALLUVIAL DEPOSIT 23/01/2014			25.0	1.0		ML	Sandy SILT, non to low plasticity, pale orange-brown, sand is fine grained.	M-W			
			24.5	1.5		ML	Sandy SILT, low plasticity, pale grey-white; minor clay, tree branches. - orange staining	W			
			24.0	2.0		SM	Silty SAND, fine to medium grained, blue-grey, abundant tree branches.				
			23.5	2.5			EOBH @ 2.3m, target depth. TS= TOPSOIL P= PEAT Test pit TP319 terminated at 2.3 metres.				
			23.0	3.0							
			22.5	3.5							
			22.0	4.0							

Sketch

classification symbols and
soil description
based on New Zealand Geotechnical Society Inc 2005

notes, samples, tests

U₅₀ undisturbed sample 50mm diameter
U₆₃ undisturbed sample 63mm diameter
D disturbed sample
Bs bulk sample
E environmental sample
R refusal

vane shear (kPa)

● remoulded
× peak
××× peak greater than 200kPa
UTP unable to penetrate

water

10/1/98 water level
on date shown
water inflow
water outflow

moisture

D dry
M moist
W wet
S saturated

consistency/ density index

VS very soft VL very loose
S soft L loose
F firm MD medium dense
St stiff D dense
Vst very stiff VD very dense
H hard

Engineering Log - Trial Pit

Trial Pit No. **TP320**

Sheet 1 of 1

Project No: **GENZTAUC13086AK**

Client: **THE LAKES LTD (2012)**

Date started: **24.1.2014**

Principal:

Date completed: **24.1.2014**Project: **STAGE 3 - ZONE 2**

Logged by: **KMJ**

Trial pit location: **Base of Gully - Stream Edge**

Checked by: **RBT**

Equipment type: 20t CAT			Pit Orientation: E-W			Easting: 369003.944 m			R.L. Surface: 26.5 m					
Excavation dimensions: 8m long			1.5m wide			Vane No: SL588			Northing: 799553.254 m			Datum: x/y = BOPC2000, z = Moturiki		
excavation information					material substance									
stratigraphy	water	notes samples, tests, etc	RL	depth metres	graphic log	classification symbol	Material Description Soil name; plasticity or grading, colour, secondary components. Moisture, sensitivity, strength. Structure, bedding, cementation, defects. Origin, additional observations. Rock name, grain size & type, colour, fabric, inclusions & minor components. Weathering, moisture, strength, defects.	moisture condition	consistency/ density index	vane shear (remoulded /peak) kPa	structure and additional observations			
TS	ALLUVIAL DEPOSITS 23/01/2014 ▼		26.0	0.5		OL	Sandy SILT, no plasticity, sand is fine to medium, organic odor, rootlets (TOPSOIL).	M	St	●	x			
						ML	SILT, low plasticity, creamy orange-brown, minor black specks, orange mottles; minor fine sand. - becoming pale orange-brown							
25.5				1.0		OL	Organic SILT, no plasticity, black.	M-W		●	x			
						ML	Sandy SILT, no plasticity, grey. - brown, black staining, sand is fine grained.							
25.0				1.5		ML	Sandy SILT/Silty SAND, non to low plasticity, white-grey to blue-grey, sand is fine grained. - increasing sand content	W		●	x			
24.5				2.0										
24.0	2.5					EOBH @ 2.2m, target depth. TS= TOPSOIL Test pit TP320 terminated at 2.2 metres.								
23.5	3.0													
23.0	3.5													
22.5	4.0													

Sketch

classification symbols and
soil description

based on New Zealand Geotechnical Society Inc 2005

notes, samples, tests

U₅₀ undisturbed sample 50mm diameter

U₆₃ undisturbed sample 63mm diameter

D disturbed sample

Bs bulk sample

E environmental sample

R refusal

vane shear (kPa)

● remoulded

x peak

>>x peak greater than 200kPa

UTP unable to penetrate

water

10/1/98 water level on date shown

water inflow

water outflow

moisture

D dry

M moist

W wet

S saturated

consistency/ density index

VS very soft

S soft

F firm

St stiff

VSt very stiff

H hard

VL very loose

L loose

MD medium dense

D dense

VD very dense

Engineering Log - Trial Pit

Client: **THE LAKES LTD (2012)**

Principal:

Project: **STAGE 3 - ZONE 2**

Trial pit location: **Base of Gully - Stream Edge**

Trial Pit No. **TP321**

Sheet 1 of 1

Project No: **GENZTAUC13086AK**

Date started: **24.1.2014**

Date completed: **24.1.2014**

Logged by: **KMJ**

Checked by: **RBT**

Equipment type: 20t CAT Pit Orientation: E-W Easting: 368996.81 m R.L. Surface: 29 m
Excavation dimensions: 5m long 1.5m wide Vane No: SL588 Northing: 799497.73 m Datum: ~~xy~~ = BOPC2000, z = Moturiki

excavation information					material substance						
stratigraphy	water	notes samples, tests, etc	RL	depth metres	graphic log	classification symbol	Material Description Soil name; plasticity or grading, colour, secondary components. Moisture, sensitivity, strength. Structure, bedding, cementation, defects. Origin, additional observations. Rock name, grain size & type, colour, fabric, inclusions & minor components. Weathering, moisture, strength, defects.	moisture condition	consistency/ density index	vane shear (remoulded (peak) kPa)	structure and additional observations
TS			28.5	0.5		OL	Organic SILT, no plasticity, black (TOPSOIL).	M	St		hole collapsed from 0.5m, not stable
						OL	Sandy SILT, no plasticity, grey, organic odor, rootlets.				
						SM	Silty SAND, fine to medium grained, grey-white, fine to medium grained, black staining, tree branches, organic odor.				
						ML	Sandy SILT, no plasticity, grey-white, orange staining.				
ALLUVIAL DEPOSITS			28.0	1.0							
			27.5	1.5							
			27.0	2.0							
			26.5	2.5			EOBH @ 2.5m, target depth. TS= TOPSOIL Test pit TP321 terminated at 2.5 metres.				
			26.0	3.0							
			25.5	3.5							
			25.0	4.0							

Sketch

classification symbols and
soil description
based on New Zealand Geotechnical Society Inc 2005

notes, samples, tests

U₅₀ undisturbed sample 50mm diameter
U₆₃ undisturbed sample 63mm diameter
D disturbed sample
Bs bulk sample
E environmental sample
R refusal

vane shear (kPa)

● remoulded
× peak
××× peak greater than 200kPa
UTP unable to penetrate

water

10/1/98 water level
on date shown
water inflow
water outflow

moisture

D dry
M moist
W wet
S saturated

consistency/ density index

VS very soft VL very loose
S soft L loose
F firm MD medium dense
St stiff D dense
VSt very stiff VD very dense
H hard

Engineering Log - Trial Pit

Client: **THE LAKES LTD (2012)**

Principal:

Project: **STAGE 3 - ZONE 2**

Trial pit location: **Base of Gully - Stream Edge**

Trial Pit No. **TP322**

Sheet 1 of 1

Project No: **GENZTAUC13086AK**

Date started: **24.1.2014**

Date completed: **24.1.2014**

Logged by: **KMJ**

Checked by: **RBT**

Equipment type: 20t CAT Pit Orientation: E-W Easting: 368957.893 m R.L. Surface: 28 m
Excavation dimensions: 8m long 1.5m wide Vane No: SL588 Northing: 799432.837 m Datum: ~~xy~~ = BOPC2000, z = Moturiki

excavation information					material substance						
stratigraphy	water	notes samples, tests, etc	RL	depth metres	graphic log	classification symbol	Material Description Soil name; plasticity or grading, colour, secondary components. Moisture, sensitivity, strength. Structure, bedding, cementation, defects. Origin, additional observations. Rock name, grain size & type, colour, fabric, inclusions & minor components. Weathering, moisture, strength, defects.	moisture condition	consistency/ density index	vane shear (remoulded (peak) kPa)	structure and additional observations
ALLUVIAL DEPOSITS	groundwater not encountered		27.5	0.5		OL	Sandy SILT, no plasticity, pale grey-brown, organic odor, rootlets (TOPSOIL). becoming black, with grey staining	M	F-St	● x	
			27.0	1.0		ML	Sandy SILT, no plasticity, pale brown, occasional organic pockets; sand is fine.	M-W		● x	
			26.5	1.5		ML	SILT, no plasticity, grey-white, some fine sand, trace clay.	W	VSt	● x	
			26.0	2.0						● x	
			25.5	2.5			EOBH @ 2.3m, target depth. TS= TOPSOIL Test pit TP322 terminated at 2.3 metres.				
			25.0	3.0							
			24.5	3.5							
			24.0	4.0							

Sketch

classification symbols and
soil description
based on New Zealand Geotechnical Society Inc 2005

notes, samples, tests

U₅₀ undisturbed sample 50mm diameter
U₆₃ undisturbed sample 63mm diameter
D disturbed sample
Bs bulk sample
E environmental sample
R refusal

vane shear (kPa)

● remoulded
x peak
>>x peak greater than 200kPa
UTP unable to penetrate

water

10/1/98 water level
on date shown
water inflow
water outflow

moisture

D dry
M moist
W wet
S saturated

consistency/ density index

VS very soft VL very loose
S soft L loose
F firm MD medium dense
St stiff D dense
VSt very stiff VD very dense
H hard

Engineering Log - Trial Pit

Trial Pit No. **TP323**

Sheet 1 of 1

Project No: **GENZTAUC13086AK**

Client: **THE LAKES LTD (2012)**

Date started: **24.1.2014**

Principal:

Date completed: **24.1.2014**Project: **STAGE 3 - ZONE 2**

Logged by: **KMJ**

Trial pit location: **Base of Gully - Stream Edge**

Checked by: **RBT**

Equipment type: 20t CAT			Pit Orientation: E-W			Easting: 369015.603 m			R.L. Surface: 28 m				
Excavation dimensions: 3m long 1.5m wide			Vane No: SL588			Northing: 799707.456 m			Datum: x/y = BOPC2000, z = Moturiki				
excavation information					material substance								
stratigraphy	water	notes samples, tests, etc	RL	depth metres	graphic log	classification symbol	Material Description Soil name; plasticity or grading, colour, secondary components. Moisture, sensitivity, strength. Structure, bedding, cementation, defects. Origin, additional observations. Rock name, grain size & type, colour, fabric, inclusions & minor components. Weathering, moisture, strength, defects.	moisture condition	consistency/ density index	vane shear (remoulded /peak) kPa			structure and additional observations
TS						OL	Organic SILT, no plasticity, black, rootlets, organic odor (TOPSOIL).	M	F-St	25	50	75	
ALLUVIAL DEPOSITS	23/01/2014		27.5	0.5		ML	Sandy SILT, low plasticity, creamy orange mottling, pale brown, sand is fine grained.			●	×		
			27.0	1.0		SM	Silty SAND, fine grained, white-grey.	M-W					
			26.5	1.5									
			26.0	2.0									
			25.5	2.5									
			25.0	3.0						●	×		
			24.5	3.5			EOBH @ 3.0m, target depth. TS= TOPSOIL Test pit TP323 terminated at 3 metres.						
			24.0	4.0									
Sketch													
classification symbols and soil description based on New Zealand Geotechnical Society Inc 2005					vane shear (kPa) ● remoulded × peak >>× peak greater than 200kPa UTP unable to penetrate water ▼ 10/1/98 water level on date shown ▶ water inflow ◀ water outflow			moisture D dry M moist W wet S saturated		consistency/ density index VS very soft VL very loose S soft L loose F firm MD medium dense St stiff D dense VSt very stiff VD very dense H hard			
notes, samples, tests U ₅₀ undisturbed sample 50mm diameter U ₆₃ undisturbed sample 63mm diameter D disturbed sample Bs bulk sample E environmental sample R refusal													

Engineering Log - Hand Auger

Client: **THE LAKES LTD (2012)**

Principal:

Project: **STAGE 3 - ZONE 2**

Hand Auger location: **Mid-Point of Section H-H**

Hand Auger No. **HA304**

Sheet 1 of 1

Project No: **GENZTAUC13086AK**

Date started: **24.1.2014**

Date completed: **24.1.2014**

Logged by: **GJN**

Checked by: **RBT**

Dynamic penetrometer type: Easting: 369058.61 m Slope: -90° R.L. Surface: 45 m Vane No: SL588
Hole diameter: 50 mm Northing: 799853.72 m Bearing: Datum: x/y = BOPC2000, z = Moturiki

drilling information					material substance																							
stratigraphy	water	notes samples, tests, etc	RL	depth metres	graphic log	classification symbol	Material Description Soil name; plasticity or grading, colour, secondary components. Moisture, sensitivity, strength. Structure, bedding, cementation, defects. Origin, additional observations.	moisture condition	consistency/ density index	vane shear (remoulded /peak) kPa	penetration resistance test																	
											blows per 100 mm																	
											25	50	75	100	125	150	175	2	4	6	8	10	12	14	16	18		
COLLUVIUM			44	1		ML	Sandy SILT, non plastic, orange brown. Moist, fine rootlets.	M	F																			
						ML	Sandy SILT, non plastic, bark brown black. Moist, organic. [TOPSOIL]			●	×																	
						ML	Sandy SILT, non plastic, grey brown. Moist, sand is fine. - becoming orange brown below 1.2m depth.			●	×																	
VOLCANIC ASHES	groundwater not encountered		43	2		ML	SILT, some sand, non plastic, orange brown. Moist. - becoming brown at 2.1m depth. - sand content increasing below 2.5m depth.		VSt	●				×														
						SW	SAND, some silt, fine to medium, pale yellow orange. Moist. - becoming light grey white below 2.7m depth.			●			×															
TE RANGA IGNIMBRITE			42	3		SW	SAND, minor silt, fine to coarse, light brown white. Dry to moist, pumiceous.	D-M																				
			41	4																								
			40	5																								
			39	6			EOBH = Target Depth Borehole HA304 terminated at 5 metres.																					

classification symbols and soil description based on Field Description of Soil and Rock, New Zealand Geotechnical Society Inc 2005	vane shear (kPa) ● remoulded × peak >>× peak greater than 200kPa UTP unable to penetrate	water ▽ 10/1/98 water level on date shown ► water inflow ◄ water outflow	moisture D dry M moist W wet S saturated	consistency/ density index VS very soft S soft F firm St stiff VSt very stiff H hard VL very loose L loose MD medium dense D dense VD very dense
--	---	---	---	--

Engineering Log - Hand Auger

Client: **THE LAKES LTD (2012)**

Principal:

Project: **STAGE 3 - ZONE 2**

Hand Auger location: **Slope Below Access Road**

Hand Auger No. **HA305**

Sheet 1 of 1

Project No: **GENZTAUC13086AK**

Date started: **19.12.2013**

Date completed: **19.12.2013**

Logged by: **SLC**

Checked by: **RBT**

Dynamic penetrometer type: Easting: 368913.05 m Slope: -90° R.L. Surface: 41 m Vane No: DR2244
Hole diameter: 50 mm Northing: 799642.32 m Bearing: Datum: x/y = BOPC2000, z = Moturiki

drilling information					material substance	
stratigraphy	water	notes samples, tests, etc	RL	depth metres	graphic log	classification symbol	Material Description Soil name; plasticity or grading, colour, secondary components. Moisture, sensitivity, strength. Structure, bedding, cementation, defects. Origin, additional observations.	moisture condition	consistency/ density index	vane shear (remoulded /peak) kPa	penetration resistance test	
											25 50 75 100 125 150 175	blows per 100 mm	
											2	4	6	8	10	12	14	16	18	
TS	VOLCANIC ASHES	groundwater not encountered	40	1			Organic SILT, dry and friable, brown.	D	St- VSt	

classification symbols and soil description based on Field Description of Soil and Rock, New Zealand Geotechnical Society Inc 2005	vane shear (kPa) ● remoulded × peak >>× peak greater than 200kPa UTP unable to penetrate	water ▽ 10/1/98 water level on date shown ► water inflow ◄ water outflow	moisture D dry M moist W wet S saturated	consistency/ density index VS very soft S soft F firm St stiff VSt very stiff H hard VL very loose L loose MD medium dense D dense VD very dense
---	---	---	---	--

Engineering Log - Hand Auger

Client: **THE LAKES LTD (2012)**

Principal:

Project: **STAGE 3 - ZONE 2**

Hand Auger location: **Slope Below Access Road**

Hand Auger No. **HA306**

Sheet 1 of 1

Project No: **GENZTAUC13086AK**

Date started: **19.12.2013**

Date completed: **19.12.2013**

Logged by: **KMJ**

Checked by: **RBT**

Dynamic penetrometer type: Easting: 368932.62 m Slope: -90° R.L. Surface: 36 m Vane No: DR4523
Hole diameter: 50 mm Northing: 799645.48 m Bearing: Datum: x/y = BOPC2000, z = Moturiki

drilling information					material substance																		
stratigraphy	water	notes samples, tests, etc	RL	depth metres	graphic log	classification symbol	Material Description Soil name; plasticity or grading, colour, secondary components. Moisture, sensitivity, strength. Structure, bedding, cementation, defects. Origin, additional observations.	moisture condition	consistency/ density index	vane shear (remoulded /peak) kPa	penetration resistance test												
											2	4	6	8	10	12	14	16	18				
COLLUVIUM	VOLCANIC ASHES	groundwater not encountered	35	1		ML	Sandy SILT, no plasticity, black, organic odor; sand is fine grained. (COLLUVIUM)	D-M	F-ST														

classification symbols and
soil description
based on Field Description of Soil
and Rock, New Zealand
Geotechnical Society Inc 2005

vane shear (kPa)
● remoulded
× peak
>>× peak greater than 200kPa
UTP unable to penetrate

water
10/1/98 water level
on date shown
▶ water inflow
◀ water outflow

moisture
D dry
M moist
W wet
S saturated

consistency/ density index
VS very soft VL very loose
S soft L loose
F firm MD medium dense
St stiff D dense
VSt very stiff VD very dense
H hard

Engineering Log - Hand Auger

Client: **THE LAKES LTD (2012)**

Principal:

Project: **STAGE 3 - ZONE 2**

Hand Auger location: **Slope Below Access Road**

Hand Auger No. **HA307**

Sheet 1 of 1

Project No: **GENZTAUC13086AK**

Date started: **19.12.2013**

Date completed: **19.12.2013**

Logged by: **KMJ**

Checked by: **RBT**

Dynamic penetrometer type: Easting: 368893.28 m Slope: -90° R.L. Surface: 41 m Vane No: DR4523
Hole diameter: 50 mm Northing: 799691.58 m Bearing: Datum: x/y = BOPC2000, z = Moturiki

drilling information					material substance																								
stratigraphy	water	notes samples, tests, etc	RL	depth metres	graphic log	classification symbol	Material Description Soil name; plasticity or grading, colour, secondary components. Moisture, sensitivity, strength. Structure, bedding, cementation, defects. Origin, additional observations.	moisture condition	consistency/ density index	vane shear (remoulded /peak) kPa					penetration resistance test														
TS										blows per 100 mm																			
										25 50 75 100 125 150 175	2	4	6	8	10	12	14	16	18										
COLLUVIUM	groundwater not encountered		40	1		ML	Sandy SILT, no plasticity, black, organic odor; sand is fine grained. (TOPSOIL)	D	St																				
						ML	Sandy SILT, no plasticity, brown. - becoming orange-brown - low plasticity clay inclusion	D-M		●		×																	
										●		×																	
										●		×																	
VOLCANIC ASHES		39	2		ML	Sandy SILT, non to low plasticity, pale brown with black specks, possibly colluvium deposits. - increasing sand content - black & dark orange-brown inclusion - some medium sub-angular gravel & orange-black staining		St-Vst		●		×																	
										●		×																	
										●		×																	
										●		×																	
TI		38	3		ML	Sandy SILT, low plasticity, orange-brown, with dark-orange staining & orange streaks; some fine black gravel; white inclusion. - increasing medium plasticity clay content - heavy orange-black staining				●		×																	
										●		×																	
		37	4		ML	Sandy SILT, non to low plasticity, pale orange-brown, black specks; sand is fine grained. - becoming pale-brown grey, medium plasticity				●			×																
						ML	Sandy SILT, low plasticity, pale-grey with black specks (completely weathered ignimbrite).																						
			36	5			EOBH = Refusal TS = TOPSOIL TI = TE RANGA IGNIMBRITE Borehole HA307 terminated at 4.6 metres.																						
			35	6																									

classification symbols and
soil description
based on Field Description of Soil
and Rock, New Zealand
Geotechnical Society Inc 2005

vane shear (kPa)
● remoulded
× peak
>>× peak greater than 200kPa
UTP unable to penetrate

water
10/1/98 water level
on date shown
▶ water inflow
◀ water outflow

moisture
D dry
M moist
W wet
S saturated

consistency/ density index
VS very soft VL very loose
S soft L loose
F firm MD medium dense
St stiff D dense
VSt very stiff VD very dense
H hard

Engineering Log - Hand Auger

Client: **THE LAKES LTD (2012)**

Principal:

Project: **STAGE 3 - ZONE 2**

Hand Auger location: **Mid Level of Steep Ridge**

Hand Auger No. **HA308**

Sheet 1 of 1

Project No: **GENZTAUC13086AK**

Date started: **19.12.2013**

Date completed: **19.12.2013**

Logged by: **SLC**

Checked by: **RBT**

Dynamic penetrometer type: Easting: 368939.31 m Slope: -90° R.L. Surface: 46 m Vane No: DR2244
Hole diameter: 50 mm Northing: 799788.53 m Bearing: Datum: x/y = BOPC2000, z = Moturiki

drilling information					material substance	
stratigraphy	water	notes samples, tests, etc	RL	depth metres	graphic log	classification symbol	Material Description Soil name; plasticity or grading, colour, secondary components. Moisture, sensitivity, strength. Structure, bedding, cementation, defects. Origin, additional observations.	moisture condition	consistency/ density index	vane shear (remoulded /peak) kPa	penetration resistance test	
TS										25 50 75 100 125 150 175	blows per 100 mm	
												2	4	6	8	10	12	14	16	18	
VOLCANIC ASHES	groundwater not encountered		45	1		ML	Organic SILT, dry and friable, brown.	D	VSt	

classification symbols and soil description based on Field Description of Soil and Rock, New Zealand Geotechnical Society Inc 2005	vane shear (kPa) ● remoulded × peak >>× peak greater than 200kPa UTP unable to penetrate	water ▽ 10/1/98 water level on date shown ▶ water inflow ◀ water outflow	moisture D dry M moist W wet S saturated	consistency/ density index VS very soft S soft F firm St stiff VSt very stiff H hard VL very loose L loose MD medium dense D dense VD very dense
--	--	---	--	---

Engineering Log - Hand Auger

Client: **THE LAKES LTD (2012)**

Principal:

Project: **STAGE 3 - ZONE 2**

Hand Auger location: **Crest of Section F-F**

Hand Auger No. **HA311**

Sheet 1 of 1

Project No: **GENZTAUC13086AK**

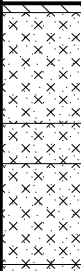
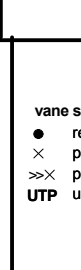
Date started: **10.1.2014**

Date completed: **10.1.2014**

Logged by: **GJN**

Checked by: **RBT**

Dynamic penetrometer type: Easting: 369095.9 m Slope: -90° R.L. Surface: 43 m Vane No: DR2244
Hole diameter: 50 mm Northing: 799562.27 m Bearing: Datum: x/y = BOPC2000, z = Moturiki

drilling information					material substance																									
stratigraphy	water	notes samples, tests, etc	RL	depth metres	graphic log	classification symbol	Material Description Soil name; plasticity or grading, colour, secondary components. Moisture, sensitivity, strength. Structure, bedding, cementation, defects. Origin, additional observations.	moisture condition	consistency/ density index	vane shear (remoulded /peak) kPa					penetration resistance test															
										25	50	75	100	125	150	175	blows per 100 mm													
																		2	4	6	8	10	12	14	16	18				
COLLUVIUM			42	1		ML	Sandy SILT, non plastic, dark drown black. Moist, rootlets. (TOPSOIL)	D-M	F-S																					
						ML	Sandy SILT, non plastic, orange brown. Dry to moist.			●	×																			
							- becoming brown at 0.5m depth.																							
						ML	SILT, non plastic, dark brown black with brown mottles. Dry to Moist.	M		●	×																			
ML	Sandy SILT, non plastic, orange brown. Moist. Sand is fine.	●	×																											
VA						ML	Sandy SILT, non plastic, orange brown. Moist.			●	×																			
UNWELED IGIMBRITE	groundwater not encountered		41	2		SM	Silty SAND, fine to coarse, orange yellow, subrounded to subangular. Dry to moist, pumiceous.	D-M																						
							- sand content increasing, becoming fine to medium.			●	×																			
							- becoming grey below 2.3m depth.																							
							- becoming moist to wet below 2.5m depth.																							
			40	3																										
			39	4																										
			38	5																										
			37	6			EOBH = Target Depth VA = Volcanic Ashes Borehole HA311 terminated at 5 metres.																							

classification symbols and soil description based on Field Description of Soil and Rock, New Zealand Geotechnical Society Inc 2005	vane shear (kPa) ● remoulded × peak >>× peak greater than 200kPa UTP unable to penetrate	water ▽ 10/1/98 water level on date shown ► water inflow ◄ water outflow	moisture D dry M moist W wet S saturated	consistency/ density index VS very soft S soft F firm St stiff VSt very stiff H hard VL very loose L loose MD medium dense D dense VD very dense
---	---	--	---	--

Engineering Log - Hand Auger

Client: **THE LAKES LTD (2012)**

Principal:

Project: **STAGE 3 - ZONE 2**

Hand Auger location: **Crest of Section D-D**

Hand Auger No. **HA312**

Sheet 1 of 1

Project No: **GENZTAUC13086AK**

Date started: **24.1.2014**

Date completed: **24.1.2014**

Logged by: **RBT**

Checked by: **RBT**

Dynamic penetrometer type: Easting: 368901.91 m Slope: -90° R.L. Surface: 52 m Vane No: DR2244
Hole diameter: 50 mm Northing: 799519.93 m Bearing: Datum: x/y = BOPC2000, z = Moturiki

drilling information					material substance	
stratigraphy	water	notes samples, tests, etc	RL	depth metres	graphic log	classification symbol	Material Description Soil name; plasticity or grading, colour, secondary components. Moisture, sensitivity, strength. Structure, bedding, cementation, defects. Origin, additional observations.	moisture condition	consistency/ density index	vane shear (remoulded /peak) kPa	penetration resistance test	
TS											blows per 100 mm	
											25	50	75	100	125	150	175	2	4	6	8	10	12	14	16	18	
YOUNGER ASHES	groundwater not encountered		51	1		ML	Highly organic SILT, with minor sand, non plastic, dark brown. Moist, rootlets.	M	St	

Engineering Log - Hand Auger

Client: **THE LAKES LTD (2012)**

Principal:

Project: **STAGE 3 - ZONE 2**

Hand Auger location: **Crest of Section H-H**

Hand Auger No. **HA314**

Sheet 1 of 1

Project No: **GENZTAUC13086AK**

Date started: **10.1.2014**

Date completed: **10.1.2014**

Logged by: **GJN**

Checked by: **RBT**

Dynamic penetrometer type: Easting: 369113.22 m Slope: -90° R.L. Surface: 55 m Vane No: DR2244
Hole diameter: 50 mm Northing: 799343.94 m Bearing: Datum: x/y = BOPC2000, z = Moturiki

drilling information					material substance																										
stratigraphy	water	notes samples, tests, etc	RL	depth metres	graphic log	classification symbol	Material Description Soil name; plasticity or grading, colour, secondary components. Moisture, sensitivity, strength. Structure, bedding, cementation, defects. Origin, additional observations.	moisture condition	consistency/ density index	vane shear (remoulded peak) kPa	penetration resistance test																				
												2	4	6	8	10	12	14	16	18											
COLLUVIUM	groundwater not encountered		54	1		OL	Sandy SILT, dark brown, friable. Dry to moist, rootlets. (TOPSOIL)	D-M	F-St	●	×																				
						ML	Sandy SILT, non plastic, orange mottled brown. Dry to moist. - becoming dry below 0.6m depth.																								
2					ML	Sandy SILT, non plastic, yellow orange. Dry - thin layer of buried topsoil, approximately 50mm thick.	D	VSt-H	●	>>>	>>>	●	×																		
4					SP	SAND, some silt, fine, grey brown. Dry, pumiceous. - becoming pink white	D	D	●	>>>	>>>	●	×																		
classification symbols and soil description based on Field Description of Soil and Rock, New Zealand Geotechnical Society Inc 2005	vane shear (kPa) ● remoulded × peak >>> peak greater than 200kPa UTP unable to penetrate	water ▽ 10/1/98 water level on date shown ► water inflow ◄ water outflow	moisture D dry M moist W wet S saturated	consistency/ density index VS very soft S soft F firm St stiff VSt very stiff H hard VL very loose L loose MD medium dense D dense VD very dense
--	---	---	---	--

Engineering Log - Hand Auger

client: **THE LAKES 2012 (LTD)**

principal:

project: **THE LAKES STAGE 3 ZONE 3**

location: **Top of slope below Collector Road**

Borehole ID. **HA01-AQ**

sheet: 1 of 1

project no. **GENZTAUC13086AQ**

date started: **28 Jan 2015**

date completed: **28 Jan 2015**

logged by: **DBC**

checked by: **RBT**

position: E: 368,908; N: 799,598 (BOPC2000)

surface elevation: 50 m (MOTUHT1953)

angle from horizontal: 90°

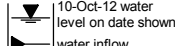
DCP id.:

drill model: Hand Auger

hole diameter : 50 mm

vane id.: 4523

drilling information				material substance									
method & support	penetration	water	samples & field tests	RL (m)	depth (m)	graphic log	classification symbol	material description	moisture condition	consistency / relative density	vane shear remoulded peak (kPa)	DCP (blows/100 mm)	structure and additional observations
AD	1			50				ORGANIC SILT: non plastic, orange brown.	D				TOPSOIL / COLLUVIUM
	2				0.5			SILT: non plastic, orange mottled brown, with abundant topsoil inclusions.	D	St			COLLUVIUM VS 67/ 12 kPa VS 84/ 16 kPa
	3				1.0			ORGANIC SILT: non plastic, black.	D to M	F			BURIED TOPSOIL / COLLUVIUM VS 50/ 14 kPa
								SILT: non plastic, orange brown.	D to M	S			COLLUVIUM VS 12/ 10 kPa
					1.5			SILT: non plastic, brown orange.	M	VSt			YOUNGER ASHES VS 113/ 25 kPa
					2.0			SILT: non plastic, pale brown orange, with some sand. - with a <100mm lense of loose grey SAND at 2.0m.	M	S			ROTOEHU ASH VS 12/ 10 kPa
					2.5			Silty CLAY: high plasticity, cream brown.	M	St			MATUA SUBGROUP VS 77/ 20 kPa
					3.0			Clayey SILT: medium to high liquid limit, cream grey. - becoming cream from 2.8m.	M	St			VS 84/ 14 kPa
					3.5			- becoming moderately plastic, cream streaked dark orange (oxidisation) from 3.0m.	M to W	H			VS 206/ 28 kPa
					4.0			SILT: low liquid limit, cream streaked dark orange, (oxidisation), with some clay. - becoming non to slightly plastic, cream pale grey, with minor clay from 3.2m.	M				VS >215/ 35 kPa
					4.5			- becoming non plastic with trace clay from 3.3m.	M to W				VS >215 kPa
					5.0			- becoming non to slightly plastic, cream pale grey streaked orange, with minor clay from 3.7m.	W	St			VS 89/ 35 kPa
								- becoming creamy pale grey streaked orange from 4.4m.	W				VS 54/ 16 kPa
								Clayey SILT: medium liquid limit, cream pale grey streaked orange.	M to W	St			
								Sandy SILT: low liquid limit, cream pale grey, with some clay.	W	VSt			
								Hand Auger HA01-AQ terminated at 5.2 m Target depth					VS 106/ 38 kPa

method AD auger drilling* AS auger screwing* HA hand auger W washbore HA hand auger	support M mud C casing N nil	samples & field tests B bulk disturbed sample D disturbed sample E environmental sample SS split spoon sample U## undisturbed sample ##mm diameter HP hand penetrometer (kPa) N standard penetration test (SPT) N* SPT - sample recovered Nc SPT with solid cone VS vane shear; peak/remoulded (kPa) R refusal HB hammer bouncing	classification symbol & soil description based on Unified Classification System	consistency / relative density VS very soft S soft F firm St stiff VSt very stiff H hard Fb friable VL very loose L loose MD medium dense D dense VD very dense
penetration  no resistance ranging to refusal	water 10-Oct-12 water level on date shown  water inflow water outflow	moisture D dry M moist W wet S saturated Wp plastic limit WL liquid limit		

* bit shown by suffix
e.g.
AD/T
B
T
V
bit shown by suffix
blank bit
TC bit
V bit

Engineering Log - Hand Auger

client: **THE LAKES 2012 (LTD)**

principal:

project: **THE LAKES STAGE 3 ZONE 3**

location: **Middle of slope below Collector Road**

Borehole ID. **HA02-AQ**

sheet: 1 of 1

project no. **GENZTAUC13086AQ**

date started: **28 Jan 2015**

date completed: **28 Jan 2015**

logged by: **DBC**

checked by: **RBT**

position: E: 368,912; N: 799,602 (BOPC2000)

surface elevation: 47 m (MOTUHT1953)

angle from horizontal: 90°

DCP id.:

drill model: Hand Auger

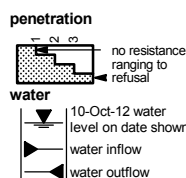
hole diameter : 50 mm

vane id.: 4523

drilling information				material substance									
method & support	penetration	water	samples & field tests	RL (m)	depth (m)	graphic log	classification symbol	material description	moisture condition	consistency / relative density	vane shear remoulded (kPa)	DCP (blows/100 mm)	structure and additional observations
HA	1			46.0	0.0			ORGANIC SILT: non plastic, brown.	D				TOPSOIL / COLLUVIUM
	2				0.5			SILT: non plastic, orange brown.	D	VSt			COLLUVIUM
	3							ORGANIC SILT: non plastic, dark brown.	D				VS 103/ 10 kPa
								SILT: non plastic, orange brown flecked cream.	D	F			BURIED TOPSOIL / COLLUVIUM
					1.0					VSt			YOUNGER ASHES
													VS 46/ 10 kPa
													VS 158/ 10 kPa
					1.5								VS 154/ 20 kPa
								SILT: low liquid limit, brown orange streaked pale grey, with some clay.	D to M	VSt			MATUA SUBGROUP
					2.0			Sandy SILT: non plastic, dark orange red, (oxidisation).	D to M	H			VS 101/ 20 kPa
									M				VS UTP
					2.5			SILT: non plastic to low liquid limit, orange brown, with abundant dark reddish black oxidised inclusions with some sand and some clay.	M	H			VS UTP
								Clayey SILT: low to medium liquid limit, orange brown, with abundant dark reddish black oxidised inclusions with some sand.	M to W	VSt			VS 189/ 16 kPa
					3.0								VS 156/ 18 kPa
								Sandy SILT: non plastic to low liquid limit, orange brown, with abundant dark reddish black oxidised inclusions with some clay.	W	VSt			VS 103/ 19 kPa
					3.5			Clayey SILT: medium liquid limit, brown orange, with minor dark reddish black oxidised inclusions with some sand.	W	VSt			VS 99/ 28 kPa
													VS 82/ 20 kPa
					4.0			SILT: non plastic, brown orange, with minor dark reddish black oxidised inclusions.	M	H			VS UTP
								Clayey SILT: medium liquid limit, brown orange, with minor dark reddish black oxidised inclusions with some sand.	M to W	St			VS 99/ 28 kPa
					4.5			- becoming brown orange with some sand. Hole squeezing.					
								SILT: non plastic, brown orange, with minor dark reddish black oxidised inclusions.	W to S	H			VS UTP
					5.0			Hand Auger HA02-AQ terminated at 5.0 m Target depth					

method	support	penetration	water	samples & field tests	classification symbol & soil description	consistency / relative density
AD auger drilling*	M mud			B bulk disturbed sample		VS very soft
AS auger screwing*	C casing			D disturbed sample		S soft
HA hand auger				E environmental sample		F firm
W washbore				SS split spoon sample		St stiff
HA hand auger				U## undisturbed sample ##mm diameter		VSt very stiff
				HP hand penetrometer (kPa)		H hard
				N standard penetration test (SPT)		Fb friable
				N* SPT - sample recovered		VL very loose
				Nc SPT with solid cone		L loose
				VS vane shear: peak/remoulded (kPa)		MD medium dense
				R refusal		D dense
				HB hammer bouncing		VD very dense
					moisture	
					D dry	
					M moist	
					W wet	
					S saturated	
					Wp plastic limit	
					WL liquid limit	

* bit shown by suffix
e.g. AD/T
B blank bit
T TC bit
V V bit



Engineering Log - Hand Auger

client: **THE LAKES 2012 (LTD)**

principal:

project: **THE LAKES STAGE 3 ZONE 3**

location: **Top of slope below Collector Road**

Borehole ID. **HA03-AQ**

sheet: 1 of 1

project no. **GENZTAUC13086AQ**

date started: **29 Jan 2015**

date completed: **29 Jan 2015**

logged by: **DBC**

checked by: **RBT**

position: E: 368,924; N: 799,577 (BOPC2000)

surface elevation: 49 m (MOTUHT1953)

angle from horizontal: 90°

DCP id.:

drill model: Hand Auger

hole diameter : 50 mm

vane id.: 4523

drilling information				material substance									
method & support	penetration	water	samples & field tests	RL (m)	depth (m)	graphic log	classification symbol	material description	moisture condition	consistency / relative density	vane shear (kPa)	DCP (blows/100 mm)	structure and additional observations
HA	1			48.0	0.5			ORGANIC SILT: non plastic, dark brown mottled orange brown.	D	VSt	⊕ ⊙		TOPSOIL / COLLUVIUM VS 113/ 12 kPa
	2			48.0	1.0			SILT: non plastic, orange brown flecked cream. - with trace clay from 0.9m. - becoming non to slightly plastic with minor clay from 1.2m.	D M	St VSt	⊕ ⊙		COLLUVIUM VS 69/ 15 kPa VS 180/ 11 kPa VS 119/ 18 kPa
	3			47.0	1.5			- becoming non plastic, brown orange with trace clay from 1.5m.		H	⊕ ⊙		VS >215 kPa
				47.0	2.0			SILT: non plastic to low liquid limit, pale brown orange, with minor clay. - becoming pale brown orange streaked orange brown with minor sand, minor clay and some black manganese nodules from 1.9m.	M	VSt	⊕ ⊙		MATUA SUBGROUP VS 140/ 28 kPa
				47.0	2.5			Sandy SILT: non plastic low liquid limit, pale brown orange streaked orange brown, with minor clay and some black manganese nodules.	M	VSt	⊕ ⊙		VS 139/ 31 kPa
				46.0	3.0			Clayey SILT: medium to high liquid limit, pale brown orange streaked orange brown, with minor sand and minor black manganese nodules.	M to W	VSt	⊕ ⊙		VS 144/ 24 kPa
				46.0	3.5			SILT: low liquid limit, pale brown orange streaked orange brown flecked dark grey, with minor sand and some clay.			⊕ ⊙		VS 160/ 31 kPa
				45.0	4.0			- with some sand, some clay and minor black manganese nodules from 3.6m.			⊕ ⊙		VS 154/ 27 kPa
				45.0	4.5			Sandy SILT: non plastic to low liquid limit, pale brown orange streaked orange brown flecked dark grey, with minor clay.	M to W	H	⊕ ⊙		VS 202/ 49 kPa
				44.0	5.0			SILT: low liquid limit, pale brown orange streaked orange brown flecked dark grey, with minor sand, some clay and minor black manganese nodules.	M to W	St VSt H	⊕ ⊙ ⊕ ⊙ ⊕ ⊙		VS 82/ 24 kPa VS 140/ 23 kPa
				44.0	5.0			Hand Auger HA03-AQ terminated at 5.0 m Target depth			⊕ ⊙		VS >215 kPa

method AD auger drilling* AS auger screwing* HA hand auger W washbore HA hand auger	support M mud C casing N nil	penetration  no resistance ranging to refusal water 10-Oct-12 water level on date shown water inflow water outflow	samples & field tests B bulk disturbed sample D disturbed sample E environmental sample SS split spoon sample U## undisturbed sample ##mm diameter HP hand penetrometer (kPa) N standard penetration test (SPT) N* SPT - sample recovered Nc SPT with solid cone VS vane shear; peak/remoulded (kPa) R refusal HB hammer bouncing	classification symbol & soil description based on Unified Classification System moisture D dry M moist W wet S saturated Wp plastic limit WL liquid limit	consistency / relative density VS very soft S soft F firm St stiff VSt very stiff H hard Fb friable VL very loose L loose MD medium dense D dense VD very dense
---	--	---	--	---	--

* bit shown by suffix
e.g.
AD/T
B
T
V
V bit

Engineering Log - Hand Auger

client: **THE LAKES 2012 (LTD)**

principal:

project: **THE LAKES STAGE 3 ZONE 3**

location: **Middle of slope below Collector Road**

Borehole ID. **HA04-AQ**

sheet: 1 of 1

project no. **GENZTAUC13086AQ**

date started: **29 Jan 2015**

date completed: **29 Jan 2015**

logged by: **DBC**

checked by: **RBT**

position: E: 368,930; N: 799,578 (BOPC2000)

surface elevation: 46 m (MOTUHT1953)

angle from horizontal: 90°

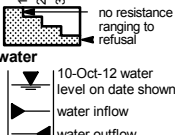
DCP id.:

drill model: Hand Auger

hole diameter : 50 mm

vane id.: 4523

drilling information				material substance									
method & support	penetration	water	samples & field tests	RL (m)	depth (m)	graphic log	classification symbol	material description	moisture condition	consistency / relative density	vane shear (kPa)	DCP (blows/100 mm)	structure and additional observations
					5.2			Hand Auger HA04-AQ terminated at 5.2 m Target depth					

method AD auger drilling* AS auger screwing* HA hand auger W washbore HA hand auger	support M mud C casing N nil	samples & field tests B bulk disturbed sample D disturbed sample E environmental sample SS split spoon sample U## undisturbed sample ##mm diameter HP hand penetrometer (kPa) N standard penetration test (SPT) N* SPT - sample recovered Nc SPT with solid cone VS vane shear; peak/remoulded (kPa) R refusal HB hammer bouncing	classification symbol & soil description based on Unified Classification System	consistency / relative density VS very soft S soft F firm St stiff VSt very stiff H hard Fb friable VL very loose L loose MD medium dense D dense VD very dense
* bit shown by suffix e.g. AD/T B blank bit T TC bit V V bit	penetration 		moisture D dry M moist W wet S saturated Wp plastic limit WL liquid limit	

Engineering Log - Hand Auger

client: **THE LAKES 2012 (LTD)**

principal:

project: **THE LAKES STAGE 3 ZONE 3**

location: **Top of slope below Collector Road**

Borehole ID. **HA05-AQ**

sheet: 1 of 1

project no. **GENZTAUC13086AQ**

date started: **29 Jan 2015**

date completed: **29 Jan 2015**

logged by: **SLC**

checked by: **RBT**

position: E: 368,826; N: 799,698 (BOPC2000)

surface elevation: 57 m (MOTUHT1953)

angle from horizontal: 90°

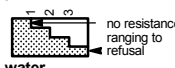
DCP id.:

drill model: Hand Auger

hole diameter : 50 mm

vane id.: SL588

drilling information				material substance									
method & support	penetration	water	samples & field tests	depth (m)	graphic log	classification symbol	material description	moisture condition	consistency / relative density	vane shear (kPa)	DCP (blows/100 mm)	structure and additional observations	
HA	1			0.0			ORGANIC SILT: non plastic, dark brown, minor fine grained sand.	D				TOPSOIL	
	2			0.5			SILT: non plastic, pale brown mottled brown, some black specks.	St				COLLUVIUM VS 55/ 14 kPa	
	3			1.0			SILT: non plastic, orange brown, trace fine grained sand.	D to M	St to VSt			VS 50/ 11 kPa VOLCANIC ASHES VS 78/ 22 kPa	
				1.5								VS 154/ 29 kPa	
				2.0			SILT: non plastic, brown.	M	VSt			VS 159/ 37 kPa	
				2.5			2.0 m: minor pale brown and black inclusions (accretionary lapilli).					MATUA SUBGROUP VS 147/ 29 kPa	
				3.0			Silty CLAY: medium to high plasticity, brown.					VS 147/ 27 kPa	
				3.5			2.5 m: becoming pale brown.					VS 103/ 21 kPa	
				4.0			2.8 m: becoming orange brown.					VS 138/ 31 kPa	
				4.5			Clayey SILT: low to medium liquid limit, pale brown mottled pale grey.					VS 144/ 22 kPa	
				5.0			3.2 m: becoming pale brown with pale pink mottles.					VS 126/ 22 kPa	
				5.5			3.5 m: 100mm silty sand lense (fine grained, pale brown with pale grey specks).	D to M	VSt			VS 124/ 42 kPa	
				6.0			INTERBEDDED SILTY SAND & CLAYEY SILT: Silty sand is fine grained and pale brown with black banding. Clayey SILT is low to medium plasticity and pale brown/pink brown. Bedding is 50mm to 150mm.	M	St to VSt			VS 160/ 17 kPa	
				6.5			Clayey SILT: low to medium liquid limit, pale pink brown.	M to W	St to VSt			VS 146/ 37 kPa	
				7.0								VS 101/ 14 kPa	
				7.5								VS 90/ 22 kPa	
				8.0			Hand Auger HA05-AQ terminated at 5.0 m Target depth						

method AD auger drilling* AS auger screwing* HA hand auger W washbore HA hand auger	support M mud C casing N nil	samples & field tests B bulk disturbed sample D disturbed sample E environmental sample SS split spoon sample U## undisturbed sample ##mm diameter HP hand penetrometer (kPa) N standard penetration test (SPT) N* SPT - sample recovered Nc SPT with solid cone VS vane shear: peak/remoulded (kPa) R refusal HB hammer bouncing	classification symbol & soil description based on Unified Classification System	consistency / relative density VS very soft S soft F firm St stiff VSt very stiff H hard Fb friable VL very loose L loose MD medium dense D dense VD very dense
* bit shown by suffix e.g. AD/T B blank bit T TC bit V V bit	penetration  no resistance ranging to refusal water 10-Oct-12 water level on date shown water inflow water outflow		moisture D dry M moist W wet S saturated Wp plastic limit WL liquid limit	

Engineering Log - Hand Auger

client: **THE LAKES 2012 (LTD)**

principal:

project: **THE LAKES STAGE 3 ZONE 3**

location: **Middle of slope below Collector Road**

Borehole ID. **HA06-AQ**

sheet: 1 of 1

project no. **GENZTAUC13086AQ**

date started: **29 Jan 2015**

date completed: **29 Jan 2015**

logged by: **SLC**

checked by: **RBT**

position: E: 368,834; N: 799,704 (BOPC2000)

surface elevation: 52 m (MOTUHT1953)

angle from horizontal: 90°

DCP id.:

drill model: Hand Auger

hole diameter : 50 mm

vane id.: SL588

drilling information				material substance									
method & support	penetration	water	samples & field tests	SS RL (m)	depth (m)	graphic log	classification symbol	material description	moisture condition	consistency / relative density	vane shear remoulded peak (kPa)	DCP (blows/100 mm)	structure and additional observations
HA	1							ORGANIC SILT: non plastic, dark brown.	D				TOPSOIL
	2				0.5			SILT: non plastic, pale orange brown, minor fine grained sand. 0.5 m: becoming orange brown.	F to VSt				COLLUVIUM VS 47/ 14 kPa
	3				1.0			1.0 m: becoming brown mottled dark brown and pale brown with black specks, dry to moist.	D to M				VS 42/ 11 kPa
					1.5			Clayey SILT: non plastic.	VSt				VS 79/ 17 kPa
					2.0			Sandy SILT: non plastic, brown, sand is fine grained.					VS 199/ 31 kPa
					2.5			Clayey SILT: non plastic to low liquid limit, dark brown.					VS 137/ 34 kPa
					3.0								VS 129/ 34 kPa
					3.5			Clayey Sandy SILT: low to medium liquid limit, dark brown with pale brown specks, sand is fine grained.	M				VS 137/ 39 kPa
					4.0			SILT: low liquid limit, brown mottled orange brown and dark brown, trace clay, minor fine grained sand.	VS				VS 110/ 22 kPa
					4.5			Sandy SILT: non plastic to low liquid limit, pale brown mottled pale grey, sand is fine to medium grained.					VS 141/ 26 kPa
					5.0			Hand Auger HA06-AQ terminated at 5.0 m Target depth					VS 110/ 31 kPa

method AD auger drilling* AS auger screwing* HA hand auger W washbore HA hand auger	support M mud C casing N nil	penetration  water 10-Oct-12 water level on date shown water inflow water outflow	samples & field tests B bulk disturbed sample D disturbed sample E environmental sample SS split spoon sample U## undisturbed sample ##mm diameter HP hand penetrometer (kPa) N standard penetration test (SPT) N* SPT - sample recovered Nc SPT with solid cone VS vane shear; peak/remoulded (kPa) R refusal HB hammer bouncing	classification symbol & soil description based on Unified Classification System moisture D dry M moist W wet S saturated Wp plastic limit WL liquid limit	consistency / relative density VS very soft S soft F firm St stiff VSt very stiff H hard Fb friable VL very loose L loose MD medium dense D dense VD very dense
---	--	---	--	---	--

* bit shown by suffix
e.g.
AD/T
B
T
V
V bit

Engineering Log - Hand Auger

client: **THE LAKES 2012 (LTD)**

principal:

project: **THE LAKES STAGE 3 ZONE 3**

location: **Top of slope below Pyes Pa Road**

Borehole ID. **HA07-AQ**

sheet: 1 of 1

project no. **GENZTAUC13086AQ**

date started: **05 Feb 2015**

date completed: **05 Feb 2015**

logged by: **DBC**

checked by: **RBT**

position: E: 369,127; N: 799,329 (BOPC2000)

surface elevation: 56 m (MOTUHT1953)

angle from horizontal: 90°

DCP id.:

drill model: Hand Auger

hole diameter : 50 mm

vane id.: 4523

drilling information				material substance									
method & support	penetration	water	samples & field tests	RL (m)	depth (m)	graphic log	classification symbol	material description	moisture condition	consistency / relative density	vane shear (kPa)	DCP (blows/100 mm)	structure and additional observations
AD	1			56				SILT: non plastic, brown orange mottled dark brown, with common topsoil inclusions.	M	S to F			COLLUVIUM
	2				0.5			- becoming brown orange from 0.4m.	D to M				VS 37/ 5 kPa
	3												VS 20/ 5 kPa
				-55	1.0								VS 15/ 0 kPa
													VS 37/ 24 kPa
					1.5			SILT: non plastic, brown orange.	D to M	St to VSt			YOUNGER ASHES
				-54	2.0								VS 70/ 25 kPa
													VS 135/ 16 kPa
					2.5								VS 90/ 23 kPa
				-53	3.0			SILT: non plastic, brown orange flecked black flecked cream, with trace clay.	M	St to VSt			MATUA SUBGROUP
													VS 84/ 23 kPa
					3.5								VS 108/ 33 kPa
				-52	4.0			- with some black manganese nodules and some white nodules from 4.0m.					VS 131/ 32 kPa
					4.5								VS 110/ 46 kPa
				-51	5.0			- becoming non to slightly plastic, creamy pink with minor clay from 4.9m.	M to W				VS 158/ 33 kPa
								Hand Auger HA07-AQ terminated at 5.2 m Target depth					VS 156/ 42 kPa

method AD auger drilling* AS auger screwing* HA hand auger W washbore HA hand auger	support M mud C casing N nil	samples & field tests B bulk disturbed sample D disturbed sample E environmental sample SS split spoon sample U## undisturbed sample ##mm diameter HP hand penetrometer (kPa) N standard penetration test (SPT) N* SPT - sample recovered Nc SPT with solid cone VS vane shear; peak/remoulded (kPa) R refusal HB hammer bouncing	classification symbol & soil description based on Unified Classification System	consistency / relative density VS very soft S soft F firm St stiff VSt very stiff H hard Fb friable VL very loose L loose MD medium dense D dense VD very dense
* bit shown by suffix e.g. AD/T B blank bit T TC bit V V bit	penetration  no resistance ranging to refusal water 10-Oct-12 water level on date shown water inflow water outflow		moisture D dry M moist W wet S saturated Wp plastic limit Wl liquid limit	

Engineering Log - Hand Auger

client: **THE LAKES 2012 (LTD)**

principal:

project: **THE LAKES STAGE 3 ZONE 3**

location: **Bottom of slope below Pyes Pa Road**

Borehole ID. **HA08-AQ**

sheet: 1 of 1

project no. **GENZTAUC13086AQ**

date started: **05 Feb 2015**

date completed: **05 Feb 2015**

logged by: **RBT**

checked by: **RBT**

position: E: 369,109; N: 799,329 (BOPC2000) surface elevation: 48 m (MOTUHT1953) angle from horizontal: 90° DCP id.:
drill model: Hand Auger hole diameter : 50 mm vane id.: 2244

drilling information							material substance									
method & support	penetration	water	samples & field tests	RL (m)	depth (m)	graphic log	classification symbol	material description	moisture condition	consistency / relative density	vane shear (kPa)		DCP (blows/ 100 mm)	structure and additional observations		
											remoulded peak	remoulded				
HA	1	N		48	0.0			SILT: non plastic, mottled greyish brown, friable with some organic inclusions.	D	F to St	50	100	2	COLLUVIUM		
	2										150	4				
	3										200	6				
N	1		Not Encountered	-47	1.0			- with occasional pale yellow white very weak gravel inclusions (weathered pumice) from 1.0m.	D to M	H	50	100	8	VS 43/ 18 kPa		

method AD auger drilling* AS auger screwing* HA hand auger W washbore HA hand auger	support M mud C casing N nil	samples & field tests B bulk disturbed sample D disturbed sample E environmental sample SS split spoon sample U## undisturbed sample ##mm diameter HP hand penetrometer (kPa) N standard penetration test (SPT) N* SPT - sample recovered Nc SPT with solid cone VS vane shear; peak/remoulded (kPa) R refusal HB hammer bouncing	classification symbol & soil description based on Unified Classification System	consistency / relative density VS very soft S soft F firm St stiff VSt very stiff H hard Fb friable VL very loose L loose MD medium dense D dense VD very dense
* bit shown by suffix e.g. AD/T B blank bit T TC bit V V bit	penetration  no resistance ranging to refusal water 10-Oct-12 water level on date shown water inflow water outflow		moisture D dry M moist W wet S saturated Wp plastic limit WL liquid limit	

Engineering Log - Hand Auger

client: **THE LAKES 2012 (LTD)**

principal:

project: **THE LAKES STAGE 3 ZONE 3**

location: **Top of slope of Pyes Pa Road**

Borehole ID. **HA09-AQ**

sheet: 1 of 1

project no. **GENZTAUC13086AQ**

date started: **30 Jan 2015**

date completed: **30 Jan 2015**

logged by: **DBC**

checked by: **RBT**

position: E: 369,099; N: 799,413 (BOPC2000)

surface elevation: 50 m (MOTUHT1953)

angle from horizontal: 90°

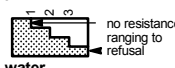
DCP id.:

drill model: Hand Auger

hole diameter : 50 mm

vane id.: 4523

drilling information				material substance									
method & support	penetration	water	samples & field tests	RL (m)	depth (m)	graphic log	classification symbol	material description	moisture condition	consistency / relative density	vane shear (kPa)	DCP (blows/100 mm)	structure and additional observations
HA	1 2 3	Not Encountered		50				ORGANIC SILT: non plastic, dark brown.	D	S			TOPSOIL / COLLUVIUM
					0.5					VS			Very loose topsoil continually falling into borehole throughout drilling, resulting in collapse at 3.2m.
					1.0								VS 20/ 10 kPa
					1.5			- with minor roots from 1.6m.		F to St			VS 0/ 0 kPa
					2.0			- becoming dark brown mottled brown orange from 1.9m.					VS 0/ 0 kPa
					2.5			- with minor rootlets from 2.4m.		VSt			VS 41/ 32 kPa
					3.0			SILT: non plastic, brown orange streaked pinkish white streaked black.	D	VSt			VS 54/ 27 kPa
					3.5			Hand Auger HA09-AQ terminated at 3.2 m Collapse					VS 130/ 46 kPa
					4.0								COLLUVIUM
					4.5								VS 106/ 49 kPa
					5.0								

method AD auger drilling* AS auger screwing* HA hand auger W washbore HA hand auger	support M mud C casing N nil	penetration  no resistance ranging to refusal water 10-Oct-12 water level on date shown water inflow water outflow	samples & field tests B bulk disturbed sample D disturbed sample E environmental sample SS split spoon sample U## undisturbed sample ##mm diameter HP hand penetrometer (kPa) N standard penetration test (SPT) N* SPT - sample recovered Nc SPT with solid cone VS vane shear; peak/remoulded (kPa) R refusal HB hammer bouncing	classification symbol & soil description based on Unified Classification System moisture D dry M moist W wet S saturated Wp plastic limit WL liquid limit	consistency / relative density VS very soft S soft F firm St stiff VSt very stiff H hard Fb friable VL very loose L loose MD medium dense D dense VD very dense
---	--	---	--	---	--

* bit shown by suffix
e.g.
AD/T
B blank bit
T TC bit
V V bit

Engineering Log - Hand Auger

client: **THE LAKES 2012 (LTD)**

principal:

project: **THE LAKES STAGE 3 ZONE 3**

location: **Bottom of slope below Pyes Pa Road**

Borehole ID. **HA10-AQ**

sheet: 1 of 1

project no. **GENZTAUC13086AQ**

date started: **30 Jan 2015**

date completed: **30 Jan 2015**

logged by: **DBC**

checked by: **RBT**

position: E: 369,089; N: 799,414 (BOPC2000)

surface elevation: 45 m (MOTUHT1953)

angle from horizontal: 90°

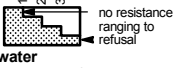
DCP id.:

drill model: Hand Auger

hole diameter : 50 mm

vane id.: 4523

drilling information				material substance									
method & support	penetration	water	samples & field tests	RL (m)	depth (m)	graphic log	classification symbol	material description	moisture condition	consistency / relative density	vane shear (kPa)	DCP (blows/100 mm)	structure and additional observations
AD	1			44	0.5			ORGANIC SILT: non plastic, dark brown. - becoming dark brown mottled brown orange from 0.3m.	D	VSt	50	2	TOPSOIL / COLLUVIUM VS 119/ 15 kPa VS 119/ 12 kPa VS 162/ 23 kPa VS 120/ 23 kPa
				43	1.5			SILT: non plastic, brown orange streaked dark brown.	D to M	St to VSt	100	4	COLLUVIUM VS 82/ 35 kPa VS 126/ 20 kPa
				42	2.5			- becoming brown orange streaked black streaked pale pinkish white from 2.3m. SILT: non plastic, black.	M	VSt	150	6	BURIED TOPSOIL / COLLUVIUM VS 193/ 27 kPa
				41	3.0			SILT: non plastic, brown orange streaked black streaked pale pinkish white.	M	VSt	200	8	COLLUVIUM VS 108/ 28 kPa
				40	4.0			- with minor gravel inclusions (fine gravel sized) from 3.8m. Sandy SILT: non plastic, pale brown orange.	D to M	VSt	250	10	MATUA SUBGROUP VS 120/ 36 kPa
					4.5			Silty SAND: fine to medium grained, pale brown orange.	D to M		300	12	VS >215 kPa
					5.0			Hand Auger HA10-AQ terminated at 5.2 m Target depth			350	14	VS 137/ 51 kPa
											400	16	VS 133/ 55 kPa

method AD auger drilling* AS auger screwing* HA hand auger W washbore HA hand auger	support M mud C casing N nil	samples & field tests B bulk disturbed sample D disturbed sample E environmental sample SS split spoon sample U## undisturbed sample ##mm diameter HP hand penetrometer (kPa) N standard penetration test (SPT) N* SPT - sample recovered Nc SPT with solid cone VS vane shear; peak/remoulded (kPa) R refusal HB hammer bouncing	classification symbol & soil description based on Unified Classification System	consistency / relative density VS very soft S soft F firm St stiff VSt very stiff H hard Fb friable VL very loose L loose MD medium dense D dense VD very dense
moisture D dry M moist W wet S saturated Wp plastic limit WL liquid limit	penetration  no resistance ranging to refusal 10-Oct-12 water level on date shown water inflow water outflow			

* bit shown by suffix
e.g.
AD/T
B blank bit
T TC bit
V V bit

Engineering Log - Hand Auger

Borehole ID.	HA11-AQ
sheet:	1 of 1
project no.	GENZTAUC13086AQ
date started:	30 Jan 2015
date completed:	30 Jan 2015
logged by:	SWH
checked by:	RBT

client: **THE LAKES 2012 (LTD)**

principal:

project: **THE LAKES STAGE 3 ZONE 3**

location: ***Middle of slope below Pyes Pa Road***

from horizontal: 90° DCP id.:
diameter : 50 mm vane id.: 2244

drilling information					material substance																																	
method & support	1 penetration	2	3	water	samples & field tests	3RL (m)	depth (m)	graphic log	classification symbol	material description	moisture condition	consistency / relative density	vane shear ⊕ remoulded ⊙ peak (kPa) 50 100 150 200	DCP (blows/ 100 mm)	2	4	6	8	structure and additional observations																			
HA N	1 2 3			Not Encountered		36	0.0		OL	SILT: non plastic, dark brown-black, some roots, trace of fine grained sand. Sandy SILT: fine grained, non plastic, brown.	D	F to St	⊕ ⊙						TOPSOIL																			
																			ML																	COLLUVIUM		
																																					VS 45/ 23 kPa	
																																					VS 62/ 23 kPa	
																																					VS 81/ 29 kPa	
																																					VS 110/ 37 kPa	
																																					VS 97/ 37 kPa	
																																						MATUA SUBGROUP
																																						VS 83/ 34 kPa
																																						VS 76/ 37 kPa
																		VS 60/ 37 kPa																				
																		VS 68/ 40 kPa																				
																		VS 86/ 43 kPa																				
																		VS 91/ 45 kPa																				
																		VS 83/ 48 kPa																				
																		VS 89/ 55 kPa																				
																		VS 86/ 55 kPa																				
																		VS 97/ 57 kPa																				
						31	5.0			Hand Auger HA11-AQ terminated at 5.0 m Target depth																												

method AD auger drilling* AS auger screwing* HA hand auger W washbore HA hand auger	support M mud N nil C casing	penetration no resistance ranging to refusal water 10-Oct-12 water level on date shown water inflow water outflow	samples & field tests B bulk disturbed sample D disturbed sample E environmental sample SS split spoon sample U## undisturbed sample ##mm diameter HP hand penetrometer (kPa) N standard penetration test (SPT) N* SPT - sample recovered Nc SPT with solid cone VS vane shear; peak/remoulded (kPa) R refusal HB hammer bouncing	classification symbol & soil description based on Unified Classification System	moisture D dry M moist W wet S saturated Wp plastic limit Wi liquid limit	consistency / relative density VS very soft S soft F firm St stiff VSst very stiff H hard Fb friable VL very loose L loose MD medium dense D dense VD very dense
---	---	---	--	---	--	---

Engineering Log - Hand Auger

client: **THE LAKES 2012 (LTD)**

principal:

project: **THE LAKES STAGE 3 ZONE 3**

location: **Bottom of slope below Pyes Pa Road**

Borehole ID. **HA13-AQ**

sheet: 1 of 1

project no. **GENZTAUC13086AQ**

date started: **30 Jan 2015**

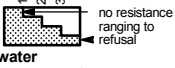
date completed: **30 Jan 2015**

logged by: **SWH**

checked by: **RBT**

position: E: 369,122; N: 799,724 (BOPC2000) surface elevation: 37 m (MOTUHT1953) angle from horizontal: 90° DCP id.:
drill model: Hand Auger hole diameter : 50 mm vane id.: 2244

drilling information				material substance									
method & support	penetration	water	samples & field tests	RL (m)	depth (m)	graphic log	classification symbol	material description	moisture condition	consistency / relative density	vane shear (kPa)	DCP (blows/100 mm)	structure and additional observations
HA	1			37			OL	SILT: non plastic, black, some roots, some fine grained sand.	D				TOPSOIL
	2				0.5		ML	SILT: non plastic, brown-orange.		S to F	⊕ ⊙		COLLUVIUM
	3										⊕ ⊙		VS 112/ 43 kPa
											⊕ ⊙		VS 29/ 18 kPa
					1.0			0.8 m: becoming dark brown-orange, with some fine to medium grained sand			⊕ ⊙		VS 34/ 18 kPa
											⊕ ⊙		VS 34/ 23 kPa
					1.5			SILT: non plastic, brown.		VSt	⊕ ⊙		VOLCANIC ASHES
											⊕ ⊙		VS 102/ 43 kPa
					2.0						⊕ ⊙		VS 120/ 50 kPa
											⊕ ⊙		VS 128/ 55 kPa
					2.5						⊕ ⊙		VS 139/ 57 kPa
								2.7 m: becoming pale brown-pale grey, with some black specks and a trace of fine grained sand			⊕ ⊙		VS 133/ 53 kPa
					3.0						⊕ ⊙		VS 123/ 55 kPa
					3.5						⊕ ⊙		VS 107/ 45 kPa
					4.0						⊕ ⊙		VS 97/ 37 kPa
					4.5						⊕ ⊙		VS 107/ 40 kPa
											⊕ ⊙		VS 128/ 53 kPa
					5.0			Hand Auger HA13-AQ terminated at 5.0 m Target depth			⊕ ⊙		VS 118/ 48 kPa

method AD auger drilling* AS auger screwing* HA hand auger W washbore HA hand auger	support M mud C casing N nil	samples & field tests B bulk disturbed sample D disturbed sample E environmental sample SS split spoon sample U## undisturbed sample ##mm diameter HP hand penetrometer (kPa) N standard penetration test (SPT) N* SPT - sample recovered Nc SPT with solid cone VS vane shear; peak/remoulded (kPa) R refusal HB hammer bouncing	classification symbol & soil description based on Unified Classification System	consistency / relative density VS very soft S soft F firm St stiff VSt very stiff H hard Fb friable VL very loose L loose MD medium dense D dense VD very dense
* bit shown by suffix e.g. AD/T B blank bit T TC bit V V bit	penetration  no resistance ranging to refusal water 10-Oct-12 water level on date shown water inflow water outflow		moisture D dry M moist W wet S saturated Wp plastic limit WL liquid limit	

Engineering Log - Hand Auger

client: **THE LAKES 2012 (LTD)**

principal:

project: **THE LAKES STAGE 3 ZONE 3**

location: **Top of slope below Pyes Pa Road**

Borehole ID. **HA14-AQ**

sheet: 1 of 1

project no. **GENZTAUC13086AQ**

date started: **30 Jan 2015**

date completed: **30 Jan 2015**

logged by: **DBC**

checked by: **RBT**

position: E: 369,030; N: 799,869 (BOPC2000)

surface elevation: 48 m (MOTUHT1953)

angle from horizontal: 90°

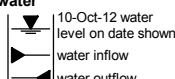
DCP id.:

drill model: Hand Auger

hole diameter : 50 mm

vane id.: 4523

drilling information				material substance									
method & support	penetration	water	samples & field tests	RL (m)	depth (m)	graphic log	classification symbol	material description	moisture condition	consistency / relative density	vane shear (kPa)	DCP (blows/100 mm)	structure and additional observations
AD	1			48				ORGANIC SILT: non plastic, dark brown mottled orange brown.	D				TOPSOIL / COLLUVIUM
AS	2				0.5			SILT: non plastic, orange brown flecked cream.	D to M	H			COLLUVIUM VS UTP
HA	3				1.0					F to St			VS 31/ 10 kPa
W								ORGANIC SILT: non plastic, black.	D to M	F			BURIED TOPSOIL / COLLUVIUM VS 45/ 19 kPa
HA					1.5			SILT: non plastic, brown orange.	M	F			COLLUVIUM VS 31/ 16 kPa
					2.0								VS 38/ 18 kPa
					2.5			SILT: non plastic, brown orange, with trace clay.	M	VSt			YOUNGER ASHES VS 130/ 44 kPa
					3.0			SILT: non plastic, brown orange, with trace clay, and minor dark grey and cream inclusions (course sand sized). - with some black manganese nodules and dark grey inclusions (fine to medium gravel sized) from 2.9m.	M	VSt			VOLCANIC ASHES VS 126/ 38 kPa
					3.5			Silty SAND: fine to medium grained, pale orange brown.	D to M	MD			VS 67/ 41 kPa
					4.0			Sandy SILT: non plastic to low liquid limit, pale orange brown, with minor clay.	M to W	VSt			VS 160/ 48 kPa
					4.5			SILT: non plastic to low liquid limit, pale orange brown, with some sand and minor clay.	M to W	St to VSt			VS 139/ 49 kPa
					5.0								VS 79/ 19 kPa
								Hand Auger HA14-AQ terminated at 5.2 m Target depth					VS 97/ 44 kPa

method AD auger drilling* AS auger screwing* HA hand auger W washbore HA hand auger	support M mud C casing N nil	samples & field tests B bulk disturbed sample D disturbed sample E environmental sample SS split spoon sample U## undisturbed sample ##mm diameter HP hand penetrometer (kPa) N standard penetration test (SPT) N* SPT - sample recovered Nc SPT with solid cone VS vane shear; peak/remoulded (kPa) R refusal HB hammer bouncing	classification symbol & soil description based on Unified Classification System	consistency / relative density VS very soft S soft F firm St stiff VSt very stiff H hard Fb friable VL very loose L loose MD medium dense D dense VD very dense
penetration  no resistance ranging to refusal	water  10-Oct-12 water level on date shown water inflow water outflow	moisture D dry M moist W wet S saturated Wp plastic limit WL liquid limit		

* bit shown by suffix
e.g.
AD/T
B
T
V
V bit

Engineering Log - Hand Auger

client: **THE LAKES 2012 (LTD)**

principal:

project: **THE LAKES STAGE 3 ZONE 3**

location: ***Middle of slope below Pyes Pa Road***

Borehole ID. **HA15-AQ**

sheet: 1 of 1

project no. **GENZTAUC13086AQ**

date started: **30 Jan 2015**

date completed: **30 Jan 2015**

logged by: **SWH**

checked by: **RBT**

position: E: 369,034; N: 799,856 (BOPC2000)

surface elevation: 39 m (MOTUHT1953)

angle from horizontal: 90°

DCP id.:

drill model: Hand Auger

hole diameter : 50 mm

vane id.: 2244

drilling information						material substance																
method & support		penetration		water		samples & field tests		RL (m)	depth (m)	graphic log	classification symbol	material description	moisture condition	consistency / relative density	vane shear ● remoulded ● peak (kPa) 50 100 150 200	DCP (blows/ 100 mm)	structure and additional observations					
method AD AS HA W HA	support M C	1 2 3	water	samples & field tests	RL (m)	depth (m)	graphic log	classification symbol	material description	moisture condition	consistency / relative density	vane shear ● remoulded ● peak (kPa) 50 100 150 200	DCP (blows/ 100 mm)	structure and additional observations								
															OL	SILT: non plastic, black, some roots, trace of sand.	D				TOPSOIL	
															ML	SILT: non plastic, brown.	F	⊕	⊙			COLLUVIUM VS 164/ 55 kPa
																0.8 m: becoming brown-orange, nonplastic to low plasticity	St to VSt	⊕	⊙			VS 46/ 20 kPa
																1.8 m: becoming dark brown-black	F	⊕	⊙			VS 89/ 37 kPa
																	St to VSt	⊕	⊙			VS 99/ 40 kPa
																	F	⊕	⊙			VS 107/ 43 kPa
																	St to VSt	⊕	⊙			VS 62/ 26 kPa
																	St to VSt	⊕	⊙			VOLCANIC ASHES
																	St to VSt	⊕	⊙			VS 97/ 45 kPa
		St to VSt	⊕	⊙			VS 107/ 40 kPa															
		St to VSt	⊕	⊙			VS 115/ 48 kPa															
		St to VSt	⊕	⊙			VS 112/ 40 kPa															
		St to VSt	⊕	⊙			VS 123/ 43 kPa															
		St to VSt	⊕	⊙			VS 99/ 45 kPa															
		St to VSt	⊕	⊙			VS 120/ 48 kPa															
		St to VSt	⊕	⊙			VS 136/ 53 kPa															
		St to VSt	⊕	⊙			VS 167/ 57 kPa															

Appendix D - Post Development Investigation Data

Engineering Log - Hand Auger

client: **THE LAKES (2012) LIMITED**

principal:

project: **THE LAKES, STAGE 3I GCR**

location: **CENTRE OF LOT 504**

Borehole ID. **HAL504**

sheet: 1 of 1

project no. **773-GENZTAUC13086A**

date started: **26 Oct 2017**

date completed: **26 Oct 2017**

logged by: **SBG**

checked by: **DBC**

position: Not Specified surface elevation: Not Specified angle from horizontal: 90° DCP id.:
drill model: Hand Auger drilling fluid: hole diameter : 50 mm vane id.:

drilling information				material substance									
method & support	penetration	water	samples & field tests	RL (m)	depth (m)	graphic log	classification symbol	material description	moisture condition	consistency / relative density	vane shear (kPa)	DCP (blows/100 mm)	structure and additional observations
1 2 3	1 2 3							0.0 m: Refused at 3 different locations due to gravel hardfill Hand Auger HAL504 terminated at 0.0 m Refusal					
		Not Encountered			0.5								
					1.0								
					1.5								
					2.0								
					2.5								
					3.0								
					3.5								
					4.0								
					4.5								

method AD auger drilling* AS auger screwing* HA hand auger W washbore HA hand auger * bit shown by suffix e.g. AD/T B blank bit T TC bit V V bit	support M mud C casing penetration  10-Oct-12 water level on date shown water inflow water outflow	samples & field tests B bulk disturbed sample D disturbed sample E environmental sample SS split spoon sample U## undisturbed sample ##mm diameter HP hand penetrometer (kPa) N standard penetration test (SPT) N* SPT - sample recovered Nc SPT with solid cone VS vane shear; peak/remoulded (kPa) R refusal HB hammer bouncing	classification symbol & soil description based on Unified Classification System moisture D dry M moist W wet S saturated Wp plastic limit Wl liquid limit	consistency / relative density VS very soft S soft F firm St stiff VSt very stiff H hard Fb friable VL very loose L loose MD medium dense D dense VD very dense
--	--	--	---	--

Engineering Log - Hand Auger

client: **THE LAKES (2012) LIMITED**

principal:

project: **THE LAKES, STAGE 3I GCR**

location: **BOUNDARY OF LOT 504 AND 505**

Borehole ID. **HAL504-505**

sheet: 1 of 1

project no. **773-GENZTAUC13086A**

date started: **26 Oct 2017**

date completed: **26 Oct 2017**

logged by: **SBG**

checked by: **DBC**

position: Not Specified surface elevation: Not Specified angle from horizontal: 90° DCP id.:
drill model: Hand Auger drilling fluid: hole diameter : 50 mm vane id.:

drilling information				material substance									
method & support	penetration	water	samples & field tests	RL (m)	depth (m)	graphic log	classification symbol	material description	moisture condition	consistency / relative density	vane shear (kPa)	DCP (blows/100 mm)	structure and additional observations
HA N	1 2 3	Not Encountered			0.5 1.0 1.5 2.0 2.5 3.0 3.5 4.0 4.5			0.0 m: Refused at 3 different locations due to gravel hardfill Hand Auger HAL504-505 terminated at 0.0 m Refusal					

method AD auger drilling* AS auger screwing* HA hand auger W washbore HA hand auger * bit shown by suffix e.g. B blank bit T TC bit V V bit	support M mud N nil C casing penetration  10-Oct-12 water level on date shown water inflow water outflow	samples & field tests B bulk disturbed sample D disturbed sample E environmental sample SS split spoon sample U## undisturbed sample ##mm diameter HP hand penetrometer (kPa) N standard penetration test (SPT) N* SPT - sample recovered Nc SPT with solid cone VS vane shear; peak/remoulded (kPa) R refusal HB hammer bouncing	classification symbol & soil description based on Unified Classification System moisture D dry M moist W wet S saturated Wp plastic limit Wl liquid limit	consistency / relative density VS very soft S soft F firm St stiff VSt very stiff H hard Fb friable VL very loose L loose MD medium dense D dense VD very dense
--	--	--	---	--

Engineering Log - Hand Auger

client: **THE LAKES (2012) LIMITED**

principal:

project: **THE LAKES, STAGE 3I GCR**

location: **CENTRE OF LOT 505**

Borehole ID. **HAL505**

sheet: 1 of 1

project no. **773-GENZTAUC13086A**

date started: **26 Oct 2017**

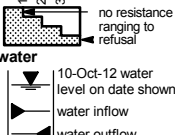
date completed: **26 Oct 2017**

logged by: **SBG**

checked by: **DBC**

position: Not Specified surface elevation: Not Specified angle from horizontal: 90° DCP id.:
drill model: Hand Auger drilling fluid: hole diameter : 50 mm vane id.:

drilling information					material substance									
method & support	penetration	water	samples & field tests	RL (m)	depth (m)	graphic log	classification symbol	material description	moisture condition	consistency / relative density	vane shear (kPa)	DCP (blows/100 mm)	structure and additional observations	
HA N	1 2 3	Not Encountered						0.0 m: Refused at 3 different locations due to gravel hardfill Hand Auger HAL505 terminated at 0.0 m Refusal					DCP REFUSAL	
					0.5									
					1.0									
					1.5									
					2.0									
					2.5									
					3.0									
					3.5									
					4.0									
					4.5									

method AD auger drilling* AS auger screwing* HA hand auger W washbore HA hand auger * bit shown by suffix e.g. AD/T B blank bit T TC bit V V bit	support M mud N nil C casing penetration  no resistance ranging to refusal	samples & field tests B bulk disturbed sample D disturbed sample E environmental sample SS split spoon sample U## undisturbed sample ##mm diameter HP hand penetrometer (kPa) N standard penetration test (SPT) N* SPT - sample recovered Nc SPT with solid cone VS vane shear; peak/remoulded (kPa) R refusal HB hammer bouncing	classification symbol & soil description based on Unified Classification System moisture D dry M moist W wet S saturated Wp plastic limit Wl liquid limit	consistency / relative density VS very soft S soft F firm St stiff VSt very stiff H hard Fb friable VL very loose L loose MD medium dense D dense VD very dense
---	--	--	---	--

Engineering Log - Hand Auger

client: **THE LAKES (2012) LIMITED**

principal:

project: **THE LAKES, STAGE 3I GCR**

location: **BOUNDARY OF LOT 504 506 AND 511**

Borehole ID. **HAL505-506**

sheet: 1 of 1

project no. **773-GENZTAUC13086A**

date started: **26 Oct 2017**

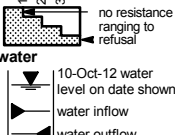
date completed: **26 Oct 2017**

logged by: **SBG**

checked by: **DBC**

position: Not Specified surface elevation: Not Specified angle from horizontal: 90° DCP id.:
drill model: Hand Auger drilling fluid: hole diameter : 50 mm vane id.:

drilling information				material substance									
method & support	penetration	water	samples & field tests	RL (m)	depth (m)	graphic log	classification symbol	material description	moisture condition	consistency / relative density	vane shear (kPa)	DCP (blows/100 mm)	structure and additional observations
HA	1 2 3	Not Encountered						ORGANIC SILT: non plastic, dark brown black.	D to M				TOPSOIL
					0.5			0.3 m: Refused at 3 different locations due to gravel hardfill Hand Auger HAL505-506 terminated at 0.3 m Refusal					
					1.0								
					1.5								
					2.0								
					2.5								
					3.0								
					3.5								
					4.0								
					4.5								

method AD auger drilling* AS auger screwing* HA hand auger W washbore HA hand auger * bit shown by suffix e.g. AD/T B blank bit T TC bit V V bit	support M mud C casing penetration  10-Oct-12 water level on date shown water inflow water outflow	samples & field tests B bulk disturbed sample D disturbed sample E environmental sample SS split spoon sample U## undisturbed sample ##mm diameter HP hand penetrometer (kPa) N standard penetration test (SPT) N* SPT - sample recovered Nc SPT with solid cone VS vane shear; peak/remoulded (kPa) R refusal HB hammer bouncing	classification symbol & soil description based on Unified Classification System moisture D dry M moist W wet S saturated Wp plastic limit WL liquid limit	consistency / relative density VS very soft S soft F firm St stiff VSt very stiff H hard Fb friable VL very loose L loose MD medium dense D dense VD very dense
---	--	--	---	--

Engineering Log - Hand Auger

client: **THE LAKES (2012) LIMITED**

principal:

project: **THE LAKES, STAGE 3I GCR**

location: **CENTRE OF LOT 506**

Borehole ID. **HAL506**

sheet: 1 of 1

project no. **773-GENZTAUC13086A**

date started: **26 Oct 2017**

date completed: **26 Oct 2017**

logged by: **PRM**

checked by: **DBC**

position: Not Specified surface elevation: Not Specified angle from horizontal: 90° DCP id.:
drill model: Hand Auger drilling fluid: hole diameter : 50 mm vane id.: 1447

drilling information					material substance									
method & support	penetration	water	samples & field tests	RL (m)	depth (m)	graphic log	classification symbol	material description	moisture condition	consistency / relative density	vane shear (kPa)	DCP (blows/100 mm)	structure and additional observations	
HA	1 2 3	Not Encountered	VS UTP VS UTP		0.5			ORGANIC SILT: non plastic, dark brown black.	M				TOPSOIL	
								SILT: non plastic, pale grey-brown, with minor fine grained sand.	H		VS UTP		FILL	
					1.0			refusal at three different locations due to hardfill gravels Hand Auger HAL506 terminated at 1.0 m Refusal			VS UTP			
					1.5									
					2.0									
					2.5									
					3.0									
					3.5									
					4.0									
					4.5									

method AD auger drilling* AS auger screwing* HA hand auger W washbore HA hand auger * bit shown by suffix e.g. AD/T B blank bit T TC bit V V bit	support M mud C casing penetration water 10-Oct-12 water level on date shown water inflow water outflow	samples & field tests B bulk disturbed sample D disturbed sample E environmental sample SS split spoon sample U## undisturbed sample ##mm diameter HP hand penetrometer (kPa) N standard penetration test (SPT) N* SPT - sample recovered Nc SPT with solid cone VS vane shear; peak/remoulded (kPa) R refusal HB hammer bouncing	classification symbol & soil description based on Unified Classification System moisture D dry M moist W wet S saturated Wp plastic limit WL liquid limit	consistency / relative density VS very soft S soft F firm St stiff VSt very stiff H hard Fb friable VL very loose L loose MD medium dense D dense VD very dense
--	---	--	---	--

Engineering Log - Hand Auger

client: **THE LAKES (2012) LIMITED**

principal:

project: **THE LAKES, STAGE 3I GCR**

location: **BOUNDARY OF LOT 506 AND 507**

Borehole ID. **HAL506-507**

sheet: 1 of 1

project no. **773-GENZTAUC13086AP**

date started: **26 Oct 2017**

date completed: **26 Oct 2017**

logged by: **SBG**

checked by: **DBC**

position: Not Specified surface elevation: Not Specified angle from horizontal: 90° DCP id.:
drill model: Hand Auger drilling fluid: hole diameter : 50 mm vane id.: DR2244

drilling information					material substance									
method & support	penetration		water	samples & field tests	RL (m)	depth (m)	graphic log	classification symbol	material description	moisture condition	consistency / relative density	vane shear ⊕ remoulded ⊙ peak (kPa) 0 50 100 150 200	DCP (blows/ 100 mm) 2 4 6 8 10	structure and additional observations
HA N	1	2	Not Encountered	VS 157/ 43 kPa		0.5			ORGANIC SILT: non plastic, dark brown black.	M	VSt			TOPSOIL
	3	VS 157/ 43 kPa				SILT: non plastic, brown orange mottled pale brown white, trace fine to medium grained sand, minor subangular gravel clasts.			⊕ ⊙				FILL	
				VS >182 kPa		1.0								
				VS 182/ 32 kPa		1.5						⊕ ⊙		
				VS 182/ 32 kPa		2.0			Hand Auger HAL506-507 terminated at 2.0 m Target depth			⊕ ⊙		
						2.5								
						3.0								
						3.5								
						4.0								
						4.5								

method AD auger drilling* AS auger screwing* HA hand auger W washbore HA hand auger	support M mud C casing N nil	samples & field tests B bulk disturbed sample D disturbed sample E environmental sample SS split spoon sample U## undisturbed sample ##mm diameter HP hand penetrometer (kPa) N standard penetration test (SPT) N* SPT - sample recovered Nc SPT with solid cone VS vane shear; peak/remoulded (kPa) R refusal HB hammer bouncing	classification symbol & soil description based on Unified Classification System	consistency / relative density VS very soft S soft F firm St stiff VSt very stiff H hard Fb friable VL very loose L loose MD medium dense D dense VD very dense
* bit shown by suffix e.g. AD/T B blank bit T TC bit V V bit	penetration no resistance ranging to refusal 10-Oct-12 water level on date shown water inflow water outflow		moisture D dry M moist W wet S saturated Wp plastic limit WL liquid limit	

Engineering Log - Hand Auger

client: **THE LAKES (2012) LIMITED**

principal:

project: **THE LAKES, STAGE 3I GCR**

location: **CENTRE OF LOT 507**

Borehole ID. **HAL507**

sheet: 1 of 1

project no. **773-GENZTAUC13086A**

date started: **26 Oct 2017**

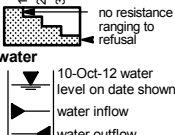
date completed: **26 Oct 2017**

logged by: **PRM**

checked by: **DBC**

position: Not Specified surface elevation: Not Specified angle from horizontal: 90° DCP id.:
drill model: Hand Auger drilling fluid: hole diameter : 50 mm vane id.:

drilling information					material substance									
method & support	penetration	water	samples & field tests	RL (m)	depth (m)	graphic log	classification symbol	material description	moisture condition	consistency / relative density	vane shear (kPa)	DCP (blows/100 mm)	structure and additional observations	
HA	N	Not Encountered			0.5			SILT: non plastic, brown orange mottled black, trace fine to medium grained sand, trace subangular gravel. refusal at 3 different locations due to gravel Hand Auger HAL507 terminated at 0.2 m Refusal	D to M				FILL	
					1.0									
					1.5									
					2.0									
					2.5									
					3.0									
					3.5									
					4.0									
					4.5									

method AD auger drilling* AS auger screwing* HA hand auger W washbore HA hand auger * bit shown by suffix e.g. AD/T B blank bit T TC bit V V bit	support M mud N nil C casing penetration  10-Oct-12 water level on date shown water inflow water outflow	samples & field tests B bulk disturbed sample D disturbed sample E environmental sample SS split spoon sample U## undisturbed sample ##mm diameter HP hand penetrometer (kPa) N standard penetration test (SPT) N* SPT - sample recovered Nc SPT with solid cone VS vane shear; peak/remoulded (kPa) R refusal HB hammer bouncing	classification symbol & soil description based on Unified Classification System moisture D dry M moist W wet S saturated Wp plastic limit Wl liquid limit	consistency / relative density VS very soft S soft F firm St stiff VSt very stiff H hard Fb friable VL very loose L loose MD medium dense D dense VD very dense
--	--	--	---	--

Engineering Log - Hand Auger

client: **THE LAKES (2012) LIMITED**

principal:

project: **THE LAKES, STAGE 3I GCR**

location: **BOUNDARY OF LOT 507 AND 508**

Borehole ID. **HAL507-508**

sheet: 1 of 1

project no. **773-GENZTAUC13086AP**

date started: **26 Oct 2017**

date completed: **26 Oct 2017**

logged by: **PRM**

checked by: **DBC**

position: Not Specified surface elevation: Not Specified angle from horizontal: 90° DCP id.:
drill model: Hand Auger drilling fluid: hole diameter : 50 mm vane id.: 1447

drilling information					material substance									
method & support	penetration	water	samples & field tests	RL (m)	depth (m)	graphic log	classification symbol	material description	moisture condition	consistency / relative density	vane shear (kPa)	DCP (blows/100 mm)	structure and additional observations	
HA	1		VS UTP		0.5			Sandy SILT: non plastic, pale brown, sand is fine grained, with minor gravel, and trace clay.	D	VSt to H			FILL	
	2		VS 204/25 kPa		1.0				M					
	3		VS 183/58 kPa		1.5									
			VS 162/45 kPa		2.0			Clayey SILT: low plasticity, pale brown, with some fine grained sand.		VSt				
			VS 158/42 kPa		2.0			Hand Auger HAL507-508 terminated at 2.0 m Target depth						
					2.5									
					3.0									
					3.5									
					4.0									
					4.5									

method AD auger drilling* AS auger screwing* HA hand auger W washbore HA hand auger	support M mud C casing N nil	samples & field tests B bulk disturbed sample D disturbed sample E environmental sample SS split spoon sample U## undisturbed sample ##mm diameter HP hand penetrometer (kPa) N standard penetration test (SPT) N* SPT - sample recovered Nc SPT with solid cone VS vane shear; peak/remoulded (kPa) R refusal HB hammer bouncing	classification symbol & soil description based on Unified Classification System	consistency / relative density VS very soft S soft F firm St stiff VSt very stiff H hard Fb friable VL very loose L loose MD medium dense D dense VD very dense
* bit shown by suffix e.g. AD/T B blank bit T TC bit V V bit	penetration 		moisture D dry M moist W wet S saturated Wp plastic limit Wl liquid limit	

Engineering Log - Hand Auger

client: **THE LAKES (2012) LIMITED**

principal:

project: **THE LAKES, STAGE 3I GCR**

location: **CENTRE OF LOT 508**

Borehole ID: **HAL508**

sheet: 1 of 1

project no: **773-GENZTAUC13086AP**

date started: **07 Dec 2017**

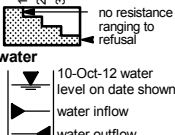
date completed: **07 Dec 2017**

logged by: **PRM**

checked by: **DBC**

position: Not Specified surface elevation: Not Specified angle from horizontal: 90° DCP id.:
drill model: Hand Auger drilling fluid: hole diameter : 50 mm vane id.: 4523

drilling information				material substance									
method & support	penetration	water	samples & field tests	RL (m)	depth (m)	graphic log	classification symbol	material description	moisture condition	consistency / relative density	vane shear remoulded (kPa)	DCP (blows/100 mm)	structure and additional observations
HA	1	Not Encountered	VS UTP		0.5			ORGANIC SILT: non plastic, dark brown mottled brown, with some fine to medium grained sand, trace clay. SILT: non plastic, brown mottled pale brown, with trace to minor fine to medium grained sand.	D	H	VS UTP		TOPSOIL
	2		VS UTP						D to M		VS UTP		FILL
	3		VS UTP						M		VS UTP		
			VS 175/42 kPa		1.0			0.8 m: with trace clay		VSt	VS UTP		
			VS 150/60 kPa					Clayey SILT: low plasticity, orange-brown mottled brown, with trace fine grained sand.					
			VS 90/45 kPa		1.5			SILT: non plastic, orange-brown. Clayey SILT: low plasticity, orange-brown mottled brown/dark brown. 1.5 m: becoming medium plasticity, mottled pale pink-brown		St			
			VS 87/47 kPa		2.0			Hand Auger HAL508 terminated at 2.0 m Target depth					
					2.5								
					3.0								
					3.5								
					4.0								
					4.5								

method AD auger drilling* AS auger screwing* HA hand auger W washbore HA hand auger	support M mud C casing N nil	penetration 	samples & field tests B bulk disturbed sample D disturbed sample E environmental sample SS split spoon sample U## undisturbed sample ##mm diameter HP hand penetrometer (kPa) N standard penetration test (SPT) N* SPT - sample recovered Nc SPT with solid cone VS vane shear; peak/remoulded (kPa) R refusal HB hammer bouncing	classification symbol & soil description based on Unified Classification System	consistency / relative density VS very soft S soft F firm St stiff VSt very stiff H hard Fb friable VL very loose L loose MD medium dense D dense VD very dense
moisture D dry M moist W wet S saturated Wp plastic limit WL liquid limit					

* bit shown by suffix
e.g.
AD/T
B blank bit
T TC bit
V V bit

Engineering Log - Hand Auger

client: **THE LAKES (2012) LIMITED**

principal:

project: **THE LAKES, STAGE 3I GCR**

location: **CORNER OF LOT 508**

Borehole ID. **HAL508c**

sheet: 1 of 1

project no. **773-GENZTAUC13086A**

date started: **07 Dec 2017**

date completed: **07 Dec 2017**

logged by: **PRM**

checked by: **DBC**

position: Not Specified surface elevation: Not Specified angle from horizontal: 90° DCP id.:
drill model: Hand Auger drilling fluid: hole diameter : 50 mm vane id.: 4523

drilling information				material substance									
method & support	penetration	water	samples & field tests	RL (m)	depth (m)	graphic log	classification symbol	material description	moisture condition	consistency / relative density	vane shear (kPa)	DCP (blows/100 mm)	structure and additional observations
HA N	1	Not Encountered	VS UTP		0.5			ORGANIC SILT: non plastic, dark brown mottled brown, with some fine to medium grained sand, trace clay.	D	VSt to H	VS UTP		TOPSOIL
	2							Clayey SILT: low plasticity, brown mottled pale brown, sand is fine grained.					
	3							Sandy SILT: non plastic, brown, sand is fine grained.					
								Clayey SILT: low plasticity, orange-brown mottled brown, with trace fine grained sand.					
								1.3 m: becoming pale brown mottled brown					
			VS 194/ 60 kPa		1.0								FILL Stiff to auger from 0.3m to 0.9m.
			VS 172/ 25 kPa		1.5								
			VS 184/ 37 kPa		2.0								
			VS 87/ 35 kPa		2.0								
					2.0			Hand Auger HAL508c terminated at 2.0 m Target depth		St			
					2.5								
					3.0								
					3.5								
					4.0								
					4.5								

method AD auger drilling* AS auger screwing* HA hand auger W washbore HA hand auger	support M mud C casing N nil	samples & field tests B bulk disturbed sample D disturbed sample E environmental sample SS split spoon sample U## undisturbed sample ##mm diameter HP hand penetrometer (kPa) N standard penetration test (SPT) N* SPT - sample recovered Nc SPT with solid cone VS vane shear; peak/remoulded (kPa) R refusal HB hammer bouncing	classification symbol & soil description based on Unified Classification System	consistency / relative density VS very soft S soft F firm St stiff VSt very stiff H hard Fb friable VL very loose L loose MD medium dense D dense VD very dense
* bit shown by suffix e.g. AD/T B blank bit T TC bit V V bit	penetration no resistance ranging to refusal water 10-Oct-12 water level on date shown water inflow water outflow		moisture D dry M moist W wet S saturated Wp plastic limit Wl liquid limit	

Engineering Log - Hand Auger

client: **THE LAKES (2012) LIMITED**

principal:

project: **THE LAKES, STAGE 3I GCR**

location: **CENTRE OF LOT 509**

Borehole ID. **HAL509**

sheet: 1 of 1

project no. **773-GENZTAUC13086A**

date started: **07 Dec 2017**

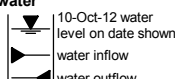
date completed: **07 Dec 2017**

logged by: **PRM**

checked by: **DBC**

position: Not Specified surface elevation: Not Specified angle from horizontal: 90° DCP id.:
drill model: Hand Auger drilling fluid: hole diameter : 50 mm vane id.: 4523

drilling information							material substance									
method & support	penetration			water	samples & field tests	RL (m)	depth (m)	graphic log	classification symbol	material description	moisture condition	consistency / relative density	vane shear ⊕ remoulded ⊙ peak (kPa)	DCP (blows/ 100 mm)	structure and additional observations	
HA	1	2	3	Not Encountered	VS UTP		0.5			ORGANIC SILT: non plastic, dark brown mottled brown, with some fine to medium grained sand, trace clay.	D	H			TOPSOIL	
														SILT: non plastic, pale brown, with minor fine grained sand.	D to M	
					VS 179/ 35 kPa		1.0			0.8 m: becoming orange-brown, trace clay	M	VSt	VS UTP		Stiff to auger from 0.7m to 1.0m.	
				VS 190/ 35 kPa					1.1 m: becoming brown mottled pale pink					⊕		⊙
					VS >224 kPa		1.5					H		⊕	⊙	
					VS 140/ 22 kPa		2.0			Silty CLAY: low plasticity, pale orange-brown mottled pale pink, with minor fine grained sand.		VSt	⊕	⊙		
										Hand Auger HAL509 terminated at 2.0 m Target depth						
							2.5									
							3.0									
							3.5									
							4.0									
							4.5									

method AD auger drilling* AS auger screwing* HA hand auger W washbore HA hand auger	support M mud C casing N nil	samples & field tests B bulk disturbed sample D disturbed sample E environmental sample SS split spoon sample U## undisturbed sample ##mm diameter HP hand penetrometer (kPa) N standard penetration test (SPT) N* SPT - sample recovered Nc SPT with solid cone VS vane shear; peak/remoulded (kPa) R refusal HB hammer bouncing	classification symbol & soil description based on Unified Classification System	consistency / relative density VS very soft S soft F firm St stiff VSt very stiff H hard Fb friable VL very loose L loose MD medium dense D dense VD very dense
* bit shown by suffix e.g. AD/T B blank bit T TC bit V V bit	penetration  water 		moisture D dry M moist W wet S saturated Wp plastic limit WI liquid limit	

Engineering Log - Hand Auger

client: **THE LAKES (2012) LIMITED**

principal:

project: **THE LAKES, STAGE 3I GCR**

location: **BOUNDARY OF LOT 509 AND 510**

Borehole ID. **HAL509-510**

sheet: 1 of 1

project no. **773-GENZTAUC13086AP**

date started: **26 Oct 2017**

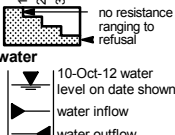
date completed: **26 Oct 2017**

logged by: **PRM**

checked by: **DBC**

position: Not Specified surface elevation: Not Specified angle from horizontal: 90° DCP id.:
drill model: Hand Auger drilling fluid: hole diameter : 50 mm vane id.: 1447

drilling information							material substance								
method & support	penetration			water	samples & field tests	RL (m)	depth (m)	graphic log	classification symbol	material description	moisture condition	consistency / relative density	vane shear ⊕ remoulded ⊙ peak (kPa)	DCP (blows/ 100 mm)	structure and additional observations
HA N	1	2	3	Not Encountered	VS UTP		0.5			SILT: non plastic, pale brown mottled dark brown/orange.	M	H	VS UTP		FILL
					VS 247 kPa		1.0			Sandy SILT: non plastic, brown mottled dark grey.				⊙	
					VS 129/ 21 kPa		1.5			Silty CLAY: low plasticity, pale brown mottled pale pink/brown, with minor fine grained sand.	VSt	⊕	⊙		
					VS 129/ 25 kPa					Silty CLAY: medium plasticity, pale pink mottled white-pink/ pale orange.		⊕	⊙		
					VS UTP					Clayey SILT: low plasticity, pale brown mottled brown, with minor fine to medium grained sand.			VS UTP		
						2.0				SILT: non plastic, brown, with minor fine to medium grained subangular gravel. shear vane UTP due to gravel hardfill Hand Auger HAL509-510 terminated at 1.9 m Refusal					
						2.5									
						3.0									
						3.5									
						4.0									
						4.5									

method AD auger drilling* AS auger screwing* HA hand auger W washbore HA hand auger	support M mud C casing N nil	penetration 	samples & field tests B bulk disturbed sample D disturbed sample E environmental sample SS split spoon sample U## undisturbed sample ##mm diameter HP hand penetrometer (kPa) N standard penetration test (SPT) N* SPT - sample recovered Nc SPT with solid cone VS vane shear; peak/remoulded (kPa) R refusal HB hammer bouncing	classification symbol & soil description based on Unified Classification System	consistency / relative density VS very soft S soft F firm St stiff VSt very stiff H hard Fb friable VL very loose L loose MD medium dense D dense VD very dense
moisture D dry M moist W wet S saturated Wp plastic limit WL liquid limit					

* bit shown by suffix
e.g. AD/T
B blank bit
T TC bit
V V bit

Engineering Log - Hand Auger

client: **THE LAKES (2012) LIMITED**

principal:

project: **THE LAKES, STAGE 3I GCR**

location: **CENTRE OF LOT 510**

Borehole ID. **HAL510**

sheet: 1 of 1

project no. **773-GENZTAUC13086A**

date started: **07 Dec 2017**

date completed: **07 Dec 2017**

logged by: **PRM**

checked by: **DBC**

position: Not Specified surface elevation: Not Specified angle from horizontal: 90° DCP id.:
drill model: Hand Auger drilling fluid: hole diameter : 50 mm vane id.: 4523

drilling information					material substance									
method & support	penetration	water	samples & field tests	RL (m)	depth (m)	graphic log	classification symbol	material description	moisture condition	consistency / relative density	vane shear (kPa)	DCP (blows/100 mm)	structure and additional observations	
HA	1 2 3	Not Encountered	VS UTP		0.5			ORGANIC SILT: non plastic, dark brown black. SILTY SAND: fine grained, brown mottled pale brown.	D				TOPSOIL	
									D to M				FILL	
					1.0			Hand Auger HAL510 terminated at 0.9 m Target depth		MD				
					1.5									
					2.0									
					2.5									
					3.0									
					3.5									
					4.0									
					4.5									

method AD auger drilling* AS auger screwing* HA hand auger W washbore HA hand auger	support M mud C casing N nil	samples & field tests B bulk disturbed sample D disturbed sample E environmental sample SS split spoon sample U## undisturbed sample ##mm diameter HP hand penetrometer (kPa) N standard penetration test (SPT) N* SPT - sample recovered Nc SPT with solid cone VS vane shear; peak/remoulded (kPa) R refusal HB hammer bouncing	classification symbol & soil description based on Unified Classification System	consistency / relative density VS very soft S soft F firm St stiff VSt very stiff H hard Fb friable VL very loose L loose MD medium dense D dense VD very dense
* bit shown by suffix e.g. AD/T B blank bit T TC bit V V bit	penetration water 10-Oct-12 water level on date shown water inflow water outflow		moisture D dry M moist W wet S saturated Wp plastic limit WL liquid limit	

Engineering Log - Hand Auger

client: **THE LAKES (2012) LIMITED**

principal:

project: **THE LAKES, STAGE 3I GCR**

location: **BOUNDARY OF LOT 510 AND 511**

Borehole ID. **HAL510-511**

sheet: 1 of 1

project no. **773-GENZTAUC13086AP**

date started: **26 Oct 2017**

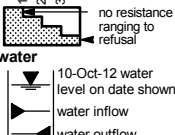
date completed: **26 Oct 2017**

logged by: **PRM**

checked by: **DBC**

position: Not Specified surface elevation: Not Specified angle from horizontal: 90° DCP id.:
drill model: Hand Auger drilling fluid: hole diameter : 50 mm vane id.: 1447

drilling information					material substance									
method & support	penetration	water	samples & field tests	RL (m)	depth (m)	graphic log	classification symbol	material description	moisture condition	consistency / relative density	vane shear (kPa)	DCP (blows/100 mm)	structure and additional observations	
HA	1 2 3	Not Encountered	VS UTP VS >247 kPa		0.5			ORGANIC SILT: non plastic, dark brown black. SILT: non plastic, pale brown, with minor fine to medium grained sand.	D D to M	H	VS UTP		TOPSOIL	FILL
					1.0			Clayey SILT: low plasticity, pale brown mottled brown, with trace fine grained sand.	M					
								Refusal on hardfill gravel at 1.0m at 2 locations Hand Auger HAL510-511 terminated at 1.0 m Refusal						

method AD auger drilling* AS auger screwing* HA hand auger W washbore HA hand auger * bit shown by suffix e.g. AD/T B blank bit T TC bit V V bit	support M mud C casing penetration  10-Oct-12 water level on date shown water inflow water outflow	samples & field tests B bulk disturbed sample D disturbed sample E environmental sample SS split spoon sample U## undisturbed sample ##mm diameter HP hand penetrometer (kPa) N standard penetration test (SPT) N* SPT - sample recovered Nc SPT with solid cone VS vane shear; peak/remoulded (kPa) R refusal HB hammer bouncing	classification symbol & soil description based on Unified Classification System moisture D dry M moist W wet S saturated Wp plastic limit WL liquid limit	consistency / relative density VS very soft S soft F firm St stiff VSt very stiff H hard Fb friable VL very loose L loose MD medium dense D dense VD very dense
---	--	--	---	--

Engineering Log - Hand Auger

client: **THE LAKES (2012) LIMITED**

principal:

project: **THE LAKES, STAGE 3I GCR**

location: **CENTRE OF LOT 511**

Borehole ID. **HAL511**

sheet: 1 of 1

project no. **773-GENZTAUC13086AP**

date started: **26 Oct 2017**

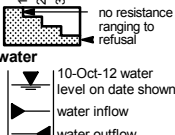
date completed: **26 Oct 2017**

logged by: **PRM**

checked by: **DBC**

position: Not Specified surface elevation: Not Specified angle from horizontal: 90° DCP id.:
drill model: Hand Auger drilling fluid: hole diameter : 50 mm vane id.: 1447

drilling information					material substance									
method & support	penetration	water	samples & field tests	RL (m)	depth (m)	graphic log	classification symbol	material description	moisture condition	consistency / relative density	vane shear remoulded peak (kPa)	DCP (blows/100 mm)	structure and additional observations	
HA	1	Not Encountered	VS UTP		0.5			ORGANIC SILT: non plastic, dark brown black.	D	VS to H			TOPSOIL	
	2		VS 183/39 kPa		1.0			SILT: non plastic, pale brown, with minor fine grained sand.	M				FILL	
	3		VS 227/55 kPa		1.5			Clayey SILT: low plasticity, pale brown mottled pale grey, with trace fine grained sand.						
					1.5			Sandy SILT: non plastic, pale brown, sand is fine to medium grained.						
					2.0			Hand Auger HAL511 terminated at 1.6 m Refusal						
					2.5									
					3.0									
					3.5									
					4.0									
					4.5									

method AD auger drilling* AS auger screwing* HA hand auger W washbore HA hand auger	support M mud C casing N nil	samples & field tests B bulk disturbed sample D disturbed sample E environmental sample SS split spoon sample U## undisturbed sample ##mm diameter HP hand penetrometer (kPa) N standard penetration test (SPT) N* SPT - sample recovered Nc SPT with solid cone VS vane shear; peak/remoulded (kPa) R refusal HB hammer bouncing	classification symbol & soil description based on Unified Classification System	consistency / relative density VS very soft S soft F firm St stiff VSst very stiff H hard Fb friable VL very loose L loose MD medium dense D dense VD very dense
* bit shown by suffix e.g. AD/T B blank bit T TC bit V V bit	penetration 		moisture D dry M moist W wet S saturated Wp plastic limit Wl liquid limit	

Engineering Log - Hand Auger

client: **THE LAKES (2012) LIMITED**

principal:

project: **THE LAKES, STAGE 3I GCR**

location: **CENTRE OF LOT 512**

Borehole ID. **HAL512**

sheet: 1 of 1

project no. **773-GENZTAUC13086A**

date started: **07 Dec 2017**

date completed: **07 Dec 2017**

logged by: **PRM**

checked by: **DBC**

position: Not Specified surface elevation: Not Specified angle from horizontal: 90° DCP id.:
drill model: Hand Auger drilling fluid: hole diameter : 50 mm vane id.: 4523

drilling information					material substance													
method & support	penetration	water	samples & field tests	RL (m)	depth (m)	graphic log	classification symbol	material description	moisture condition	consistency / relative density	vane shear ⊕ remoulded ⊙ peak (kPa)	DCP (blows/ 100 mm)	structure and additional observations					
HA Z	1	Not Encountered	VS UTP		0.5			ORGANIC SILT: non plastic, dark brown black.	D	H	⊕ remoulded ⊙ peak	50 100 150 200	2 4 6 8 10	TOPSOIL				
	SILT: non plastic, pale brown, with trace fine grained sand.							D to M	VS UTP									
	0.5 m: with minor fine grained sand							M							VS UTP			
	0.8 m: with trace fine grained sand															VS UTP		
																	VS UTP	
																		VS UTP
method AD auger drilling* AS auger screwing* HA hand auger W washbore HA hand auger	support M mud C casing N nil	samples & field tests B bulk disturbed sample D disturbed sample E environmental sample SS split spoon sample U## undisturbed sample ##mm diameter HP hand penetrometer (kPa) N standard penetration test (SPT) N* SPT - sample recovered Nc SPT with solid cone VS vane shear, peak/remoulded (kPa) R refusal HB hammer bouncing	classification symbol & soil description based on Unified Classification System	consistency / relative density VS very soft S soft F firm St stiff VSt very stiff H hard Fb friable VL very loose L loose MD medium dense D dense VD very dense
* bit shown by suffix e.g. AD/T B blank bit T TC bit V V bit	penetration  no resistance ranging to refusal 10-Oct-12 water level on date shown water inflow water outflow		moisture D dry M moist W wet S saturated Wp plastic limit WL liquid limit	

Engineering Log - Hand Auger

client: **THE LAKES (2012) LIMITED**

principal:

project: **THE LAKES, STAGE 3I GCR**

location: **BOUNDARY OF LOT 512 AND 513**

Borehole ID. **HAL512-513**

sheet: 1 of 1

project no. **773-GENZTAUC13086A**

date started: **26 Oct 2017**

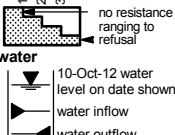
date completed: **26 Oct 2017**

logged by: **PRM**

checked by: **DBC**

position: Not Specified surface elevation: Not Specified angle from horizontal: 90° DCP id.:
drill model: Hand Auger drilling fluid: hole diameter : 50 mm vane id.: 1447

drilling information				material substance									
method & support	penetration	water	samples & field tests	RL (m)	depth (m)	graphic log	classification symbol	material description	moisture condition	consistency / relative density	vane shear remoulded (kPa)	DCP (blows/100 mm)	structure and additional observations
HA	1	Not Encountered	VS 179/ 21 kPa VS 217/ 29 kPa		0.5			ORGANIC SILT: non plastic, dark brown black. SILT: non plastic, brown mottled pale orange/dark brown, with trace subangular fine grained gravel. Clayey SILT: low plasticity, pale brown mottled pale orange, with minor fine to medium grained sand.	M	VSt	⊕ ⊙		TOPSOIL
					1.0					H	⊕ ⊙		FILL
					1.5			Refusal on gravel hardfill Hand Auger HAL512-513 terminated at 1.4 m Refusal					
					2.0								
					2.5								
					3.0								
					3.5								
					4.0								
					4.5								

method AD auger drilling* AS auger screwing* HA hand auger W washbore HA hand auger	support M mud C casing N nil	samples & field tests B bulk disturbed sample D disturbed sample E environmental sample SS split spoon sample U## undisturbed sample ##mm diameter HP hand penetrometer (kPa) N standard penetration test (SPT) N* SPT - sample recovered Nc SPT with solid cone VS vane shear; peak/remoulded (kPa) R refusal HB hammer bouncing	classification symbol & soil description based on Unified Classification System	consistency / relative density VS very soft S soft F firm St stiff VSt very stiff H hard Fb friable VL very loose L loose MD medium dense D dense VD very dense
* bit shown by suffix e.g. AD/T B blank bit T TC bit V V bit	penetration 		moisture D dry M moist W wet S saturated Wp plastic limit Wl liquid limit	

Engineering Log - Hand Auger

client: **THE LAKES (2012) LIMITED**

principal:

project: **THE LAKES, STAGE 3I GCR**

location: **CENTRE OF LOT 513**

Borehole ID. **HAL513**

sheet: 1 of 1

project no. **773-GENZTAUC13086AP**

date started: **26 Oct 2017**

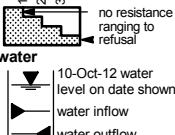
date completed: **26 Oct 2017**

logged by: **SBG**

checked by: **DBC**

position: Not Specified surface elevation: Not Specified angle from horizontal: 90° DCP id.:
drill model: Hand Auger drilling fluid: hole diameter : 50 mm vane id.: DR2244

drilling information					material substance								
method & support	penetration	water	samples & field tests	RL (m)	depth (m)	graphic log	classification symbol	material description SOIL TYPE: plasticity or particle characteristic, colour, secondary and minor components	moisture condition	consistency / relative density	vane shear ⊕ remoulded ⊙ peak (kPa)	DCP (blows/ 100 mm)	structure and additional observations
HA N	1	Not Encountered	VS >182 kPa		0.5			ORGANIC SILT: non plastic, dark brown black.	M	VSt to H			TOPSOIL
							SILTY SAND: fine to medium grained, pale brown grey.						
							SILT: non plastic, brown orange, trace fine to medium grained sand.	⊙					
							Clayey SILT: low plasticity, brown orange mottled black.	⊙					
							SILT: non plastic, brown orange mottled black white.	⊙					
			VS >182 kPa		2.0			Hand Auger HAL513 terminated at 2.0 m Target depth			⊙		
					2.5								
					3.0								
					3.5								
					4.0								
					4.5								

method AD auger drilling* AS auger screwing* HA hand auger W washbore HA hand auger	support M mud C casing N nil	penetration 	samples & field tests B bulk disturbed sample D disturbed sample E environmental sample SS split spoon sample U## undisturbed sample ##mm diameter HP hand penetrometer (kPa) N standard penetration test (SPT) N* SPT - sample recovered Nc SPT with solid cone VS vane shear; peak/remoulded (kPa) R refusal HB hammer bouncing	classification symbol & soil description based on Unified Classification System	consistency / relative density VS very soft S soft F firm St stiff VSt very stiff H hard Fb friable VL very loose L loose MD medium dense D dense VD very dense
moisture D dry M moist W wet S saturated Wp plastic limit WL liquid limit					

* bit shown by suffix
e.g.
AD/T
B blank bit
T TC bit
V V bit

Engineering Log - Hand Auger

client: **THE LAKES (2012) LIMITED**

principal:

project: **THE LAKES, STAGE 3I GCR**

location: **BOUNDARY OF LOT 513 AND 514**

Borehole ID. **HAL513-514**

sheet: 1 of 1

project no. **773-GENZTAUC13086A**

date started: **26 Oct 2017**

date completed: **26 Oct 2017**

logged by: **PRM**

checked by: **DBC**

position: Not Specified surface elevation: Not Specified angle from horizontal: 90° DCP id.:
drill model: Hand Auger drilling fluid: hole diameter : 50 mm vane id.: 1447

drilling information					material substance				
method & support	penetration	water	samples & field tests	RL (m)	depth (m)	graphic log	classification symbol	material description	moisture condition
HA	1 2 3	Not Encountered	VS 213/ 39 kPa VS 166/ 35 kPa		0.5			ORGANIC SILT: non plastic, dark brown black.	M
								SILT: non plastic, pale brown, with minor fine grained sand.	H
					1.0			Clayey SILT: low plasticity, pale brown mottled pale grey/pale orange, with minor fine grained sand. Refusal on gravel hardfill Hand Auger HAL513-514 terminated at 1.0 m Refusal	VSt
					1.5				
					2.0				
					2.5				
					3.0				
					3.5				
					4.0				
					4.5				

method AD auger drilling* AS auger screwing* HA hand auger W washbore HA hand auger	support M mud C casing N nil	samples & field tests B bulk disturbed sample D disturbed sample E environmental sample SS split spoon sample U## undisturbed sample ##mm diameter HP hand penetrometer (kPa) N standard penetration test (SPT) N* SPT - sample recovered Nc SPT with solid cone VS vane shear; peak/remoulded (kPa) R refusal HB hammer bouncing	classification symbol & soil description based on Unified Classification System	consistency / relative density VS very soft S soft F firm St stiff VSt very stiff H hard Fb friable VL very loose L loose MD medium dense D dense VD very dense
* bit shown by suffix e.g. AD/T B blank bit T TC bit V V bit	penetration water 10-Oct-12 water level on date shown water inflow water outflow		moisture D dry M moist W wet S saturated Wp plastic limit Wl liquid limit	

Engineering Log - Hand Auger

client: **THE LAKES (2012) LIMITED**

principal:

project: **THE LAKES, STAGE 3I GCR**

location: **CENTRE OF LOT 514**

Borehole ID. **HAL514**

sheet: 1 of 1

project no. **773-GENZTAUC13086AP**

date started: **07 Dec 2017**

date completed: **07 Dec 2017**

logged by: **PRM**

checked by: **DBC**

position: Not Specified surface elevation: Not Specified angle from horizontal: 90° DCP id.:
drill model: Hand Auger drilling fluid: hole diameter : 50 mm vane id.: VH4523

drilling information					material substance									
method & support	1 penetration	2 water	samples & field tests	RL (m)	depth (m)	graphic log	classification symbol	material description	moisture condition	consistency / relative density	vane shear remoulded peak (kPa)	DCP (blows/ 100 mm)	structure and additional observations	
HA	1		VS UTP		0.5			ORGANIC SILT: non plastic, dark brown black.	D	H			TOPSOIL	
	2		VS UTP					SILT: non plastic, pale brown, with minor fine grained sand.					FILL	
	3		VS 87/ 22 kPa		1.0			SILT: non plastic, grey-white, with trace clay.	M					
			VS UTP					SILT: non plastic, brown, sand is fine grained.		St				
					1.5			Clayey SILT: low plasticity, pale grey mottled orange.		VSt to H				
								Sandy SILT: non plastic, brown, sand is fine grained.						
								1.4 m: becoming grey-white						
					2.0			Hand Auger HAL514 terminated at 2.0 m Refusal						
					2.5									
					3.0									
					3.5									
					4.0									
					4.5									

method AD auger drilling* AS auger screwing* HA hand auger W washbore HA hand auger	support M mud C casing N nil	penetration  water 10-Oct-12 water level on date shown water inflow water outflow	samples & field tests B bulk disturbed sample D disturbed sample E environmental sample SS split spoon sample U## undisturbed sample ##mm diameter HP hand penetrometer (kPa) N standard penetration test (SPT) N* SPT - sample recovered Nc SPT with solid cone VS vane shear; peak/remoulded (kPa) R refusal HB hammer bouncing	classification symbol & soil description based on Unified Classification System moisture D dry M moist W wet S saturated Wp plastic limit WL liquid limit	consistency / relative density VS very soft S soft F firm St stiff VSt very stiff H hard Fb friable VL very loose L loose MD medium dense D dense VD very dense
---	--	---	--	---	--

* bit shown by suffix
e.g.
AD/T
B blank bit
T TC bit
V V bit

Engineering Log - Hand Auger

client: **THE LAKES (2012) LIMITED**

principal:

project: **THE LAKES, STAGE 3I GCR**

location: **CENTRE OF LOT 515**

Borehole ID. **HAL515**

sheet: 1 of 1

project no. **773-GENZTAUC13086A**

date started: **26 Oct 2017**

date completed: **26 Oct 2017**

logged by: **PRM**

checked by: **DBC**

position: Not Specified surface elevation: Not Specified angle from horizontal: 90° DCP id.:
drill model: Hand Auger drilling fluid: hole diameter : 50 mm vane id.: 1447

drilling information				material substance									
method & support	penetration	water	samples & field tests	RL (m)	depth (m)	graphic log	classification symbol	material description	moisture condition	consistency / relative density	vane shear (kPa)	DCP (blows/100 mm)	structure and additional observations
HA	1	Not Encountered	VS 158/35 kPa		0.5			ORGANIC SILT: non plastic, dark brown black.	M				TOPSOIL
	2							SILT: non plastic, brown, with minor fine grained sand.					FILL
	3		VS 140/45 kPa		1.0			Clayey SILT: low plasticity, brown mottled pale orange/grey.		VSt			
								SILT: non plastic, brown mottled grey, with minor fine grained sand.					
								SILTY SAND: fine grained, pale grey-white.					TE RANGA IGNIMBRITE
								Too stiff to auger further					
								Hand Auger HAL515 terminated at 1.2 m Refusal					
					1.5								
					2.0								
					2.5								
					3.0								
					3.5								
					4.0								
					4.5								

method AD auger drilling* AS auger screwing* HA hand auger W washbore HA hand auger	support M mud C casing N nil	samples & field tests B bulk disturbed sample D disturbed sample E environmental sample SS split spoon sample U## undisturbed sample ##mm diameter HP hand penetrometer (kPa) N standard penetration test (SPT) N* SPT - sample recovered Nc SPT with solid cone VS vane shear; peak/remoulded (kPa) R refusal HB hammer bouncing	classification symbol & soil description based on Unified Classification System	consistency / relative density VS very soft S soft F firm St stiff VSt very stiff H hard Fb friable VL very loose L loose MD medium dense D dense VD very dense
* bit shown by suffix e.g. AD/T B blank bit T TC bit V V bit	penetration 		moisture D dry M moist W wet S saturated Wp plastic limit Wl liquid limit	

Engineering Log - Hand Auger

client: **THE LAKES (2012) LIMITED**

principal:

project: **THE LAKES, STAGE 3I GCR**

location: **BOUNDARY OF LOT 515 AND 516**

Borehole ID. **HAL515-516**

sheet: 1 of 1

project no. **773-GENZTAUC13086A**

date started: **02 Nov 2017**

date completed: **02 Nov 2017**

logged by: **PRM**

checked by: **DBC**

position: Not Specified surface elevation: Not Specified angle from horizontal: 90° DCP id.:
drill model: Hand Auger drilling fluid: hole diameter : 50 mm vane id.: 1447

drilling information					material substance									
method & support	penetration	water	samples & field tests	RL (m)	depth (m)	graphic log	classification symbol	material description	moisture condition	consistency / relative density	vane shear remoulded peak (kPa)	DCP (blows/100 mm)	structure and additional observations	
HA	1	Not Encountered	VS UTP VS 196/ 45 kPa VS 199/ 58 kPa		0.5			ORGANIC SILT: non plastic, dark brown black.	D to M				TOPSOIL	
					1.0			Clayey SILT: low plasticity, grey mottled orange. 0.45 m: with minor fine grained sand	M	VSt	VS UTP		FILL	
					1.5			SILT: non plastic, brown, with trace fine grained sand.						
					1.5			SAND: fine grained, grey mottled pale brown.		D			TE RANGA IGNIMBRITE	
					1.5			Hand Auger HAL515-516 terminated at 1.3 m Refusal						

method AD auger drilling* AS auger screwing* HA hand auger W washbore HA hand auger	support M mud C casing N nil	samples & field tests B bulk disturbed sample D disturbed sample E environmental sample SS split spoon sample U## undisturbed sample ##mm diameter HP hand penetrometer (kPa) N standard penetration test (SPT) N* SPT - sample recovered Nc SPT with solid cone VS vane shear; peak/remoulded (kPa) R refusal HB hammer bouncing	classification symbol & soil description based on Unified Classification System	consistency / relative density VS very soft S soft F firm St stiff VSt very stiff H hard Fb friable VL very loose L loose MD medium dense D dense VD very dense
penetration 	water 10-Oct-12 water level on date shown water inflow water outflow	moisture D dry M moist W wet S saturated Wp plastic limit WL liquid limit		

* bit shown by suffix
e.g.
AD/T
B blank bit
T TC bit
V V bit

Engineering Log - Hand Auger

client: **THE LAKES (2012) LIMITED**

principal:

project: **THE LAKES, STAGE 3I GCR**

location: **CENTRE OF LOT 516**

Borehole ID. **HAL516**

sheet: 1 of 1

project no. **773-GENZTAUC13086A**

date started: **26 Oct 2017**

date completed: **26 Oct 2017**

logged by: **SBG**

checked by: **DBC**

position: Not Specified surface elevation: Not Specified angle from horizontal: 90° DCP id.:
drill model: Hand Auger drilling fluid: hole diameter : 50 mm vane id.: DR2244

drilling information					material substance										
method & support	penetration			water	samples & field tests	RL (m)	depth (m)	graphic log	classification symbol	material description	moisture condition	consistency / relative density	vane shear ⊕ remoulded ⊙ peak (kPa)	DCP (blows/ 100 mm)	structure and additional observations
HA N	1	2	3	Not Encountered	VS 157/ 46 kPa VS 172/ 29 kPa		0.5			ORGANIC SILT: non plastic, dark brown black.	D to M	VSt	⊕	⊙	TOPSOIL
			SILT: non plastic, brown orange, trace fine to medium grained sand.										FILL		
			Clayey SILT: low plasticity, pale brown grey brown, minor to some fine to medium grained sand.												
			SILT: non plastic, brown orange, trace clay, trace fine to medium grained sand.									MATUA SUBGROUP			
			SAND: fine to medium grained, grey brown black, trace silt.										DCP REFUSAL		
							2.0			Hand Auger HAL516 terminated at 2.0 m Target depth					
							2.5								
							3.0								
							3.5								
							4.0								
							4.5								

Engineering Log - Hand Auger

client: **THE LAKES (2012) LIMITED**

principal:

project: **THE LAKES, STAGE 3I GCR**

location: **BOUNDARY OF LOT 516 AND 517**

Borehole ID. **HAL516-517**

sheet: 1 of 1

project no. **773-GENZTAUC13086A**

date started: **02 Nov 2017**

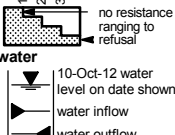
date completed: **02 Nov 2017**

logged by: **PRM**

checked by: **DBC**

position: Not Specified surface elevation: Not Specified angle from horizontal: 90° DCP id.:
drill model: Hand Auger drilling fluid: hole diameter : 50 mm vane id.: 1447

drilling information					material substance									
method & support	1 penetration	2 water	samples & field tests	RL (m)	depth (m)	graphic log	classification symbol	material description	moisture condition	consistency / relative density	vane shear (kPa)	DCP (blows/100 mm)	structure and additional observations	
HA	1	Not Encountered	VS UTP VS >247 kPa		0.5			ORGANIC SILT: non plastic, dark brown black.	M				TOPSOIL	
	2							Sandy SILT: non plastic, pale brown mottled pale orange, sand is fine to medium grained, with trace clay.		H	VS UTP		FILL	
	3		VS 125/32 kPa VS 90/34 kPa		1.0			Clayey SILT: low plasticity, brown.		VSt				
					1.5			Silty CLAY: low plasticity, pale grey-white mottled pale orange.		St				
					2.0			Sandy SILT: non plastic, brown mottled grey, sand is fine grained. SAND: fine grained, brown mottled orange brown, with trace silt.					DCP REFUSAL	
					2.5			Hand Auger HAL516-517 terminated at 2.0 m Refusal						
					3.0									
					3.5									
					4.0									
					4.5									

method AD auger drilling* AS auger screwing* HA hand auger W washbore HA hand auger	support M mud C casing N nil	samples & field tests B bulk disturbed sample D disturbed sample E environmental sample SS split spoon sample U## undisturbed sample ##mm diameter HP hand penetrometer (kPa) N standard penetration test (SPT) N* SPT - sample recovered Nc SPT with solid cone VS vane shear; peak/remoulded (kPa) R refusal HB hammer bouncing	classification symbol & soil description based on Unified Classification System	consistency / relative density VS very soft S soft F firm St stiff VSt very stiff H hard Fb friable VL very loose L loose MD medium dense D dense VD very dense
* bit shown by suffix e.g. AD/T B blank bit T TC bit V V bit	penetration 		moisture D dry M moist W wet S saturated Wp plastic limit Wl liquid limit	

Engineering Log - Hand Auger

client: **THE LAKES (2012) LIMITED**

principal:

project: **THE LAKES, STAGE 3I GCR**

location: **CENTRE OF LOT 517**

Borehole ID. **HAL517**

sheet: 1 of 1

project no. **773-GENZTAUC13086A**

date started: **02 Nov 2017**

date completed: **02 Nov 2017**

logged by: **PRM**

checked by: **DBC**

position: Not Specified surface elevation: Not Specified angle from horizontal: 90° DCP id.:
drill model: Hand Auger drilling fluid: hole diameter : 50 mm vane id.: VH1447

drilling information						material substance								structure and additional observations	
method & support	penetration		water	samples & field tests	RL (m)	depth (m)	graphic log	classification symbol	material description	moisture condition	consistency / relative density	vane shear ⊕ remoulded ⊙ peak (kPa) 0 20 40 60 80 100 120 140 160 180 200	DCP (blows/ 100 mm) 2 4 6 8 10		
HA N	1	2	Not Encountered	VS >247 kPa		0.5			ORGANIC SILT: non plastic, dark brown black.	M	H				TOPSOIL
				VS 140/ 25 kPa				SILT: non plastic, grey mottled pale orange, with trace to minor clay.					FILL		
				VS 147/ 42 kPa		1.0			SILTY SAND: fine to medium grained, pale grey mottled pale orange.	W	MD	⊕ ⊙			
				VS UTP VS 231/ 45 kPa		1.5			SILT: non plastic, brown.	M	VSt to H	⊕ ⊙ VS UTP			
						2.0			Hand Auger HAL517 terminated at 2.0 m Target depth						
						2.5									
						3.0									
						3.5									
						4.0									
						4.5									

method AD auger drilling* AS auger screwing* HA hand auger W washbore HA hand auger	support M mud C casing N nil	samples & field tests B bulk disturbed sample D disturbed sample E environmental sample SS split spoon sample U## undisturbed sample ##mm diameter HP hand penetrometer (kPa) N standard penetration test (SPT) N* SPT - sample recovered Nc SPT with solid cone VS vane shear; peak/remoulded (kPa) R refusal HB hammer bouncing	classification symbol & soil description based on Unified Classification System	consistency / relative density VS very soft S soft F firm St stiff VSt very stiff H hard Fb friable VL very loose L loose MD medium dense D dense VD very dense
* bit shown by suffix e.g. AD/T B blank bit T TC bit V V bit	penetration no resistance ranging to refusal	water 10-Oct-12 water level on date shown water inflow water outflow	moisture D dry M moist W wet S saturated Wp plastic limit WL liquid limit	

Engineering Log - Hand Auger

client: **THE LAKES (2012) LIMITED**

principal:

project: **THE LAKES, STAGE 3I GCR**

location: **BOUNDARY OF LOT 517-518**

Borehole ID. **HAL517-518**

sheet: 1 of 1

project no. **773-GENZTAUC13086AP**

date started: **02 Nov 2017**

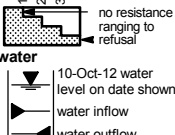
date completed: **02 Nov 2017**

logged by: **SBG**

checked by: **DBC**

position: Not Specified surface elevation: Not Specified angle from horizontal: 90° DCP id.:
drill model: Hand Auger drilling fluid: hole diameter : 50 mm vane id.: SL588

drilling information					material substance									
method & support	penetration	water	samples & field tests	RL (m)	depth (m)	graphic log	classification symbol	material description	moisture condition	consistency / relative density	vane shear (kPa)	DCP (blows/100 mm)	structure and additional observations	
HA	1	Not Encountered	VS 179/ 56 kPa		0.5			ORGANIC SILT: non plastic, dark brown black.	M	VSt			TOPSOIL	
	2		VS 132/ 31 kPa		1.0			SILT: non plastic, orange-brown, with trace fine grained sand.					FILL	
	3		VS 152/ 40 kPa		1.5			Silty CLAY: medium to high plasticity, grey-brown.						
			VS 92/ 46 kPa		2.0			SILT: non plastic, orange-brown mottled black, with trace fine grained sand.						
			VS UTP		2.0			1.0 m: with minor clay, and some fine to medium grained sand						
					2.0			Clayey SILT: low plasticity, orange-brown mottled dark brown/white.		St				
					2.0			Hand Auger HAL517-518 terminated at 2.0 m Target depth						
					2.5									
					3.0									
					3.5									
					4.0									
					4.5									

method AD auger drilling* AS auger screwing* HA hand auger W washbore HA hand auger	support M mud C casing N nil	samples & field tests B bulk disturbed sample D disturbed sample E environmental sample SS split spoon sample U## undisturbed sample ##mm diameter HP hand penetrometer (kPa) N standard penetration test (SPT) N* SPT - sample recovered Nc SPT with solid cone VS vane shear; peak/remoulded (kPa) R refusal HB hammer bouncing	classification symbol & soil description based on Unified Classification System	consistency / relative density VS very soft S soft F firm St stiff VSt very stiff H hard Fb friable VL very loose L loose MD medium dense D dense VD very dense
* bit shown by suffix e.g. AD/T B blank bit T TC bit V V bit	penetration 		moisture D dry M moist W wet S saturated Wp plastic limit Wl liquid limit	

Engineering Log - Hand Auger

client: **THE LAKES (2012) LIMITED**

principal:

project: **THE LAKES, STAGE 3I GCR**

location: **CENTRE OF LOT 518**

Borehole ID. **HAL518**

sheet: 1 of 1

project no. **773-GENZTAUC13086A**

date started: **02 Nov 2017**

date completed: **02 Nov 2017**

logged by: **SBG**

checked by: **DBC**

position: Not Specified surface elevation: Not Specified angle from horizontal: 90° DCP id.:
drill model: Hand Auger drilling fluid: hole diameter : 50 mm vane id.: SL588

drilling information					material substance								structure and additional observations	
method & support	penetration	water	samples & field tests	RL (m)	depth (m)	graphic log	classification symbol	material description	moisture condition	consistency / relative density	vane shear (kPa)	DCP (blows/100 mm)		
HA	1		VS 161/40 kPa		0.5			ORGANIC SILT: non plastic, dark brown black.	D to M	VSt			TOPSOIL	
	2							Sandy SILT: non plastic, orange-brown mottled white/dark brown.	M				FILL	
	3		VS 136/31 kPa		1.0			Silty CLAY: low to medium plasticity, grey-brown mottled black/dark brown, with minor fine grained sand.						
					1.5			SAND: fine to medium grained, grey-brown, with trace silt.	D				DCP REFUSAL	
					2.0			Hand Auger HAL518 terminated at 2.0 m Target depth						
					2.5									
					3.0									
					3.5									
					4.0									
					4.5									

method AD auger drilling* AS auger screwing* HA hand auger W washbore HA hand auger	support M mud C casing N nil	samples & field tests B bulk disturbed sample D disturbed sample E environmental sample SS split spoon sample U## undisturbed sample ##mm diameter HP hand penetrometer (kPa) N standard penetration test (SPT) N* SPT - sample recovered Nc SPT with solid cone VS vane shear; peak/remoulded (kPa) R refusal HB hammer bouncing	classification symbol & soil description based on Unified Classification System	consistency / relative density VS very soft S soft F firm St stiff VSt very stiff H hard Fb friable VL very loose L loose MD medium dense D dense VD very dense
* bit shown by suffix e.g. AD/T B blank bit T TC bit V V bit	penetration  no resistance ranging to refusal 10-Oct-12 water level on date shown water inflow water outflow		moisture D dry M moist W wet S saturated Wp plastic limit Wl liquid limit	

Engineering Log - Hand Auger

client: **THE LAKES (2012) LIMITED**

principal:

project: **THE LAKES, STAGE 3/ GCR**

location: **BOUNDARY OF LOT 518-519**

Borehole ID. **HAL518-519**

sheet: 1 of 1

project no. **773-GENZTAUC13086A**

date started: **02 Nov 2017**

date completed: **02 Nov 2017**

logged by: **PRM**

checked by: **DBC**

position: Not Specified				surface elevation: Not Specified				angle from horizontal: 90°				DCP id.:																	
drill model: Hand Auger				drilling fluid:				hole diameter : 50 mm				vane id.: 1447																	
drilling information						material substance																							
method & support		penetration		water		samples & field tests		RL (m)		depth (m)		graphic log		classification symbol		material description				moisture condition		consistency / relative density		vane shear		DCP (blows/ 100 mm)		structure and additional observations	
1 2 3		1 2 3														SOIL TYPE: plasticity or particle characteristic, colour, secondary and minor components								⊕ remoulded ⊕ peak (kPa) 50 100 150 200		2 4 6 8 10			
HA		N														ORGANIC SILT: non plastic, dark brown black mottled orange, trace fine to medium grained sand.				M								TOPSOIL	
																SILT: non plastic, brown.												FILL	
																Sandy SILT: non plastic, pale grey mottled pale orange/pale brown, sand is fine grained.				VSt									
																Silty CLAY: low to medium plasticity, pale grey mottled pale orange.													
																SILT: non plastic, brown.													
																SAND: fine grained, pale grey-white.												TE RANGA IGNIMBRITE	
																too stiff to auger further at 1.3 m													
																Hand Auger HAL518-519 terminated at 1.3 m Refusal													

Engineering Log - Hand Auger

client: **THE LAKES (2012) LIMITED**

principal:

project: **THE LAKES, STAGE 3I GCR**

location: **CENTRE OF LOT 519**

Borehole ID. **HAL519**

sheet: 1 of 1

project no. **773-GENZTAUC13086A**

date started: **02 Nov 2017**

date completed: **02 Nov 2017**

logged by: **SBG**

checked by: **DBC**

position: Not Specified surface elevation: Not Specified angle from horizontal: 90° DCP id.:
drill model: Hand Auger drilling fluid: hole diameter : 50 mm vane id.: 1447

drilling information				material substance									
method & support	penetration	water	samples & field tests	RL (m)	depth (m)	graphic log	classification symbol	material description	moisture condition	consistency / relative density	vane shear (kPa)	DCP (blows/100 mm)	structure and additional observations
HA	1		VS >247 kPa		0.5			ORGANIC SILT: non plastic, dark brown black mottled orange, trace fine to medium grained sand. SILT: non plastic, orange-brown, with minor clay.	D to M	H			TOPSOIL
	2		VS 231/ 51 kPa		1.0			Sandy SILT: non plastic, pale orange-brown.	M				FILL
	3		VS 183/ 29 kPa		1.5			SAND: fine to medium grained, grey.	VSt to H				DCP REFUSAL
					2.0			Hand Auger HAL519 terminated at 2.0 m Target depth					TE RANGA IGNIMBRITE
					2.5								
					3.0								
					3.5								
					4.0								
					4.5								

method AD auger drilling* AS auger screwing* HA hand auger W washbore HA hand auger	support M mud C casing N nil	samples & field tests B bulk disturbed sample D disturbed sample E environmental sample SS split spoon sample U## undisturbed sample ##mm diameter HP hand penetrometer (kPa) N standard penetration test (SPT) N* SPT - sample recovered Nc SPT with solid cone VS vane shear; peak/remoulded (kPa) R refusal HB hammer bouncing	classification symbol & soil description based on Unified Classification System	consistency / relative density VS very soft S soft F firm St stiff VSt very stiff H hard Fb friable VL very loose L loose MD medium dense D dense VD very dense
* bit shown by suffix e.g. AD/T B blank bit T TC bit V V bit	penetration  no resistance ranging to refusal 10-Oct-12 water level on date shown water inflow water outflow		moisture D dry M moist W wet S saturated Wp plastic limit WL liquid limit	

client: **THE LAKES (2012) LIMITED**

principal:

project: **THE LAKES, STAGE 3/ GCR**

location: **BOUNDARY OF LOT 519-520**

sheet: 1 of 1

project no. **773-GENZTAUC13086AP**

date started: **02 Nov 2017**

date completed: **02 Nov 2017**

logged by: **PRM**

checked by: **DBC**

position: Not Specified				surface elevation: Not Specified				angle from horizontal: 90°				DCP id.:															
drill model: Hand Auger				drilling fluid:				hole diameter : 50 mm				vane id.: 764															
drilling information						material substance																					
method & support		penetration		samples & field tests		RL (m)		depth (m)		graphic log		classification symbol		material description				moisture condition		consistency / relative density		vane shear		DCP (blows/ 100 mm)		structure and additional observations	
		1 2 3												SOIL TYPE: plasticity or particle characteristic, colour, secondary and minor components								⊕ ⊙ (kPa) 50 100 150 200		2 4 6 8 10			
HA N				Not Encountered		VS UTP		0.5		[diagonal lines]				ORGANIC SILT: non plastic, dark brown black mottled orange, trace fine to medium grained sand.				M		H		VS UTP				TOPSOIL	
				VS UTP		VS UTP		1.0						SILT: non plastic, brown mottled pale brown/pale grey/pale orange, with minor fine grained sand.								VS UTP				FILL	
				VS UTP		VS 128/ 31 kPa		1.5						Clayey SILT: low plasticity, brown.						VSt		⊕ ⊙					
				VS UTP		VS UTP		2.0						SILT: non plastic, brown, with trace fine grained subrounded gravel, with trace fine grained sand.						H		VS UTP					
								2.0						Hand Auger HAL519-520 terminated at 2.0 m Target depth								VS UTP					
								2.5																			
								3.0																			
								3.5																			
								4.0																			
								4.5																			
method AD auger drilling* AS auger screwing* HA hand auger W washbore HA hand auger				support M mud N nil C casing penetration  no resistance ranging to refusal water  10-Oct-12 water level on date shown water inflow water outflow				samples & field tests B bulk disturbed sample D disturbed sample E environmental sample SS split spoon sample U## undisturbed sample ##mm diameter HP hand penetrometer (kPa) N standard penetration test (SPT) N* SPT - sample recovered Nc SPT with solid cone VS vane shear; peak/remoulded (kPa) R refusal HB hammer bouncing				classification symbol & soil description based on Unified Classification System moisture D dry M moist W wet S saturated Wp plastic limit Wi liquid limit				consistency / relative density VS very soft S soft F firm St stiff VSt very stiff H hard Fb friable VL very loose L loose MD medium dense D dense VD very dense											

Engineering Log - Hand Auger

client: **THE LAKES (2012) LIMITED**

principal:

project: **THE LAKES, STAGE 3I GCR**

location: **CENTRE OF LOT 520**

Borehole ID. **HAL520**

sheet: 1 of 1

project no. **773-GENZTAUC13086AP**

date started: **02 Nov 2017**

date completed: **02 Nov 2017**

logged by: **SBG**

checked by: **DBC**

position: Not Specified surface elevation: Not Specified angle from horizontal: 90° DCP id.:
drill model: Hand Auger drilling fluid: hole diameter : 50 mm vane id.: 764

drilling information							material substance										
method & support	penetration		water	samples & field tests	RL (m)	depth (m)	graphic log	classification symbol	material description	moisture condition	consistency / relative density	vane shear ⊕ remoulded ⊙ peak (kPa)		DCP (blows/ 100 mm)	structure and additional observations		
HA N	1	2	Not Encountered	VS >213 kPa		0.0			ORGANIC SILT: non plastic, dark brown black mottled orange, trace fine to medium grained sand.	M	H	⊕	⊙	2 4 6 8 10	TOPSOIL		
	3			0.5		SILT: non plastic, pale brown mottled pale orange.			VSt						⊕	⊙	FILL
				1.0		Sandy SILT: non plastic, pale brown mottled pale orange-brown, sand is fine grained.			⊕						⊙		
				1.5		Clayey SILT: low plasticity, brown, with minor fine grained sand.			⊕						⊙		
				2.0		SAND: fine to medium grained, grey, with trace silt.											
						2.0			Hand Auger HAL520 terminated at 2.0 m Target depth								
						2.5											
						3.0											
						3.5											
						4.0											
						4.5											

method AD auger drilling* AS auger screwing* HA hand auger W washbore HA hand auger	support M mud C casing N nil	samples & field tests B bulk disturbed sample D disturbed sample E environmental sample SS split spoon sample U## undisturbed sample ##mm diameter HP hand penetrometer (kPa) N standard penetration test (SPT) N* SPT - sample recovered Nc SPT with solid cone VS vane shear; peak/remoulded (kPa) R refusal HB hammer bouncing	classification symbol & soil description based on Unified Classification System	consistency / relative density VS very soft S soft F firm St stiff VSt very stiff H hard Fb friable VL very loose L loose MD medium dense D dense VD very dense
* bit shown by suffix e.g. AD/T B blank bit T TC bit V V bit	penetration 		moisture D dry M moist W wet S saturated Wp plastic limit Wl liquid limit	

Engineering Log - Hand Auger

client: **THE LAKES (2012) LIMITED**

principal:

project: **THE LAKES, STAGE 3I GCR**

location: **BOUNDARY OF LOT 520-521**

Borehole ID: **HAL520-521**

sheet: 1 of 1

project no: **773-GENZTAUC13086AP**

date started: **02 Nov 2017**

date completed: **02 Nov 2017**

logged by: **SBG**

checked by: **DBC**

position: Not Specified surface elevation: Not Specified angle from horizontal: 90° DCP id.:
drill model: Hand Auger drilling fluid: hole diameter : 50 mm vane id.: SL819

drilling information				material substance									
method & support	penetration	water	samples & field tests	RL (m)	depth (m)	graphic log	classification symbol	material description	moisture condition	consistency / relative density	vane shear (kPa)	DCP (blows/100 mm)	structure and additional observations
HA	1							ORGANIC SILT: non plastic, dark brown black mottled orange, trace fine to medium grained sand.	D to M				TOPSOIL
	2		VS >247 kPa		0.5			SILT: non plastic, orange-brown mottled black, with minor fine grained sand. 0.4 m: with minor clay	M	VSt			FILL
	3		VS >247 kPa		1.0			Clayey SILT: low plasticity, orange-brown, with minor fine to medium grained sand.		St			
		Not Encountered	VS 204 kPa		1.5			Sandy SILT: non plastic, brown-grey mottled black/white, sand is fine to medium grained.	M to W	H			
			VS >247 kPa		2.0			Hand Auger HAL520-521 terminated at 2.0 m Target depth					
			VS >247 kPa		2.5								
					3.0								
					3.5								
					4.0								
					4.5								

method AD auger drilling* AS auger screwing* HA hand auger W washbore HA hand auger	support M mud C casing N nil	samples & field tests B bulk disturbed sample D disturbed sample E environmental sample SS split spoon sample U## undisturbed sample ##mm diameter HP hand penetrometer (kPa) N standard penetration test (SPT) N* SPT - sample recovered Nc SPT with solid cone VS vane shear; peak/remoulded (kPa) R refusal HB hammer bouncing	classification symbol & soil description based on Unified Classification System	consistency / relative density VS very soft S soft F firm St stiff VSt very stiff H hard Fb friable VL very loose L loose MD medium dense D dense VD very dense
* bit shown by suffix e.g. AD/T B blank bit T TC bit V V bit	penetration 		moisture D dry M moist W wet S saturated Wp plastic limit Wl liquid limit	

Engineering Log - Hand Auger

client: **THE LAKES (2012) LIMITED**

principal:

project: **THE LAKES, STAGE 3I GCR**

location: **CENTRE OF LOT 521**

Borehole ID. **HAL521**

sheet: 1 of 1

project no. **773-GENZTAUC13086AP**

date started: **02 Nov 2017**

date completed: **02 Nov 2017**

logged by: **PRM**

checked by: **DBC**

position: Not Specified surface elevation: Not Specified angle from horizontal: 90° DCP id.:
drill model: Hand Auger drilling fluid: hole diameter : 50 mm vane id.: 1447

drilling information							material substance								
method & support	penetration		water	samples & field tests	RL (m)	depth (m)	graphic log	classification symbol	material description	moisture condition	consistency / relative density	vane shear		DCP (blows/ 100 mm)	structure and additional observations
	1	2										⊕ remoulded	⊙ peak		
HA	1	2	Not Encountered	VS 147/ 50 kPa		0.5			ORGANIC SILT: non plastic, dark brown black mottled orange, trace fine to medium grained sand. Clayey SILT: low plasticity, brown mottled pale pink/ dark brown, with minor fine grained sand, and trace fine grained subrounded gravel.	M	VSt	⊕	⊙		TOPSOIL
				VS 166/ 50 kPa								⊕	⊙		
				VS UTP		1.0			SILTY SAND: fine grained, pale brown.				VS UTP		
				VS 179/ 61 kPa		1.5			1.4 m: becoming pale brown mottled pale grey/pale orange			⊕	⊙		
				VS 176/ 48 kPa		2.0			Hand Auger HAL521 terminated at 2.0 m Refusal			⊕	⊙		
						2.5									
						3.0									
						3.5									
						4.0									
						4.5									

method AD auger drilling* AS auger screwing* HA hand auger W washbore HA hand auger	support M mud C casing N nil	samples & field tests B bulk disturbed sample D disturbed sample E environmental sample SS split spoon sample U## undisturbed sample ##mm diameter HP hand penetrometer (kPa) N standard penetration test (SPT) N* SPT - sample recovered Nc SPT with solid cone VS vane shear; peak/remoulded (kPa) R refusal HB hammer bouncing	classification symbol & soil description based on Unified Classification System	consistency / relative density VS very soft S soft F firm St stiff VSt very stiff H hard Fb friable VL very loose L loose MD medium dense D dense VD very dense
* bit shown by suffix e.g. AD/T B blank bit T TC bit V V bit	penetration  no resistance ranging to refusal 10-Oct-12 water level on date shown water inflow water outflow		moisture D dry M moist W wet S saturated Wp plastic limit Wl liquid limit	

Engineering Log - Hand Auger

client: **THE LAKES (2012) LIMITED**

principal:

project: **THE LAKES, STAGE 3I GCR**

location: **CORNER LOT 521**

Borehole ID: **HAL521c**

sheet: 1 of 1

project no: **773-GENZTAUC13086AP**

date started: **02 Nov 2017**

date completed: **02 Nov 2017**

logged by: **SBG**

checked by: **DBC**

position: Not Specified surface elevation: Not Specified angle from horizontal: 90° DCP id.:
drill model: Hand Auger drilling fluid: hole diameter : 50 mm vane id.: 1447

drilling information							material substance										
method & support	penetration			water	samples & field tests	RL (m)	depth (m)	graphic log	classification symbol	material description	moisture condition	consistency / relative density	vane shear ⊕ remoulded ⊙ peak (kPa)	DCP (blows/ 100 mm)	structure and additional observations		
HA N	1	2	3	Not Encountered	VS 166/ 42 kPa		0.5			ORGANIC SILT: non plastic, dark brown black mottled orange, trace fine to medium grained sand.	D to M					TOPSOIL	
						VS 162/ 39 kPa					SILT: non plastic, orange-brown mottled dark brown.	M	VSt	⊕	⊙		FILL
						VS 162/ 58 kPa			1.0		Clayey SILT: non plastic to low plasticity, orange-brown mottled dark black, with minor fine to medium grained sand.			⊕	⊙		
						VS 162/ 58 kPa			1.5		Silty CLAY: low plasticity, brown grey mottled dark brown, with minor fine to medium grained sand.			⊕	⊙		
						VS 196/ 45 kPa			2.0		Sandy SILT: non plastic, pale brown-grey, sand is fine to medium grained.			⊕	⊙		
				VS 179/ 45 kPa		2.0				Hand Auger HAL521c terminated at 2.0 m Target depth			⊕	⊙			
							2.5										
							3.0										
							3.5										
							4.0										
							4.5										

method AD auger drilling* AS auger screwing* HA hand auger W washbore HA hand auger	support M mud C casing N nil	samples & field tests B bulk disturbed sample D disturbed sample E environmental sample SS split spoon sample U## undisturbed sample ##mm diameter HP hand penetrometer (kPa) N standard penetration test (SPT) N* SPT - sample recovered Nc SPT with solid cone VS vane shear; peak/remoulded (kPa) R refusal HB hammer bouncing	classification symbol & soil description based on Unified Classification System	consistency / relative density VS very soft S soft F firm St stiff VSt very stiff H hard Fb friable VL very loose L loose MD medium dense D dense VD very dense
* bit shown by suffix e.g. AD/T B blank bit T TC bit V V bit	penetration no resistance ranging to refusal	moisture D dry M moist W wet S saturated Wp plastic limit WL liquid limit		

Engineering Log - Hand Auger

client: **THE LAKES (2012) LIMITED**

principal:

project: **THE LAKES, STAGE 3I GCR**

location: **CENTRE OF LOT 522**

Borehole ID. **HAL522**

sheet: 1 of 1

project no. **773-GENZTAUC13086AP**

date started: **05 Oct 2017**

date completed: **05 Oct 2017**

logged by: **SBG**

checked by: **DBC**

position: Not Specified surface elevation: Not Specified angle from horizontal: 90° DCP id.:
drill model: Hand Auger drilling fluid: hole diameter : 50 mm vane id.: 817

drilling information								material substance							
method & support	penetration			water	samples & field tests	RL (m)	depth (m)	graphic log	classification symbol	material description	moisture condition	consistency / relative density	vane shear ⊕ remoulded ⊙ peak (kPa)	DCP (blows/ 100 mm)	structure and additional observations
HA N	1	2	3		VS 104/ 25 kPa					SILT: non plastic to low plasticity, brown orange mottled grey.	D to M				FILL
				VS >247 kPa	0.5		Clayey SILT: low to medium plasticity, brown orange mottled white black grey.		M	VSt	⊕	⊙			
				VS >247 kPa						H			⊙		
				VS >247 kPa	1.0		SILT: non plastic, brown orange mottled black white, trace fine to medium grained sand.						⊙		
				VS >247 kPa	1.5		Clayey SILT: low plasticity, brown orange mottled white grey black, trace fine to medium grained sand.						⊙		
				VS >247 kPa			SILT: non plastic, brown orange, trace fine to medium grained sand.						⊙		
						2.0				Hand Auger HAL522 terminated at 2.0 m Target depth					
							2.5								
							3.0								
							3.5								
							4.0								
							4.5								

method AD auger drilling* AS auger screwing* HA hand auger W washbore HA hand auger		support M mud C casing N nil		penetration no resistance ranging to refusal 10-Oct-12 water level on date shown water inflow water outflow		samples & field tests B bulk disturbed sample D disturbed sample E environmental sample SS split spoon sample U## undisturbed sample ##mm diameter HP hand penetrometer (kPa) N standard penetration test (SPT) N* SPT - sample recovered Nc SPT with solid cone VS vane shear; peak/remoulded (kPa) R refusal HB hammer bouncing		classification symbol & soil description based on Unified Classification System moisture D dry M moist W wet S saturated Wp plastic limit WL liquid limit		consistency / relative density VS very soft S soft F firm St stiff VSt very stiff H hard Fb friable VL very loose L loose MD medium dense D dense VD very dense	
---	--	--	--	--	--	--	--	---	--	--	--

* bit shown by suffix
e.g.
AD/T
B blank bit
T TC bit
V V bit

Engineering Log - Hand Auger

client: **THE LAKES (2012) LIMITED**

principal:

project: **THE LAKES, STAGE 3I GCR**

location: **BOUNDARY OF LOT 522 AND 523**

Borehole ID: **HAL522-523**

sheet: 1 of 1

project no: **773-GENZTAUC13086AP**

date started: **05 Oct 2017**

date completed: **05 Oct 2017**

logged by: **PRM**

checked by: **DBC**

position: Not Specified surface elevation: Not Specified angle from horizontal: 90° DCP id.:
drill model: Hand Auger drilling fluid: hole diameter : 50 mm vane id.: 4523

drilling information					material substance								
method & support	penetration	water	samples & field tests	RL (m)	depth (m)	graphic log	classification symbol	material description	moisture condition	consistency / relative density	vane shear ⊕ remoulded ⊙ peak (kPa)	DCP (blows/ 100 mm)	structure and additional observations
HA N	1	Not Encountered	VS UTP		0.5			ORGANIC SILT: non plastic, dark brown-black.	M	H	VS UTP		TOPSOIL
	2							Clayey SILT: low plasticity, brown mottled dark brown/pink, with trace fine to medium grained sand.					
	3		VS UTP		1.0								
			VS 140/ 35 kPa		1.3 m: brown orange		VSt	⊕ ⊙					
			VS 140/ 32 kPa		1.5			⊕ ⊙					
			VS 140/ 37 kPa		2.0			⊕ ⊙					
					2.0			Hand Auger HAL522-523 terminated at 2.0 m Target depth					
					2.5								
					3.0								
					3.5								
					4.0								
					4.5								

method AD auger drilling* AS auger screwing* HA hand auger W washbore HA hand auger * bit shown by suffix e.g. AD/T B blank bit T TC bit V V bit	support M mud C casing penetration no resistance ranging to refusal 10-Oct-12 water level on date shown water inflow water outflow	samples & field tests B bulk disturbed sample D disturbed sample E environmental sample SS split spoon sample U## undisturbed sample ##mm diameter HP hand penetrometer (kPa) N standard penetration test (SPT) N* SPT - sample recovered Nc SPT with solid cone VS vane shear; peak/remoulded (kPa) R refusal HB hammer bouncing	classification symbol & soil description based on Unified Classification System moisture D dry M moist W wet S saturated Wp plastic limit Wl liquid limit	consistency / relative density VS very soft S soft F firm St stiff VSt very stiff H hard Fb friable VL very loose L loose MD medium dense D dense VD very dense
---	---	--	---	--

Engineering Log - Hand Auger

client: **THE LAKES (2012) LIMITED**

principal:

project: **THE LAKES, STAGE 3I GCR**

location: **SOUTHERN CORNER OF LOT 522**

Borehole ID. **HAL522C**

sheet: 1 of 1

project no. **773-GENZTAUC13086AP**

date started: **05 Oct 2017**

date completed: **05 Oct 2017**

logged by: **ODS**

checked by: **DBC**

position: Not Specified surface elevation: Not Specified angle from horizontal: 90° DCP id.:
drill model: Hand Auger drilling fluid: hole diameter : 50 mm vane id.: SL588

drilling information					material substance									
method & support	penetration	water	samples & field tests	RL (m)	depth (m)	graphic log	classification symbol	material description	moisture condition	consistency / relative density	vane shear (kPa)	DCP (blows/100 mm)	structure and additional observations	
HA	1							SILT: low plasticity, orange brown mottled brown and grey, with minor clay and trace to minor fine to medium grained sand.	M	H to VSt			FILL	
	2		VS >213 kPa		0.5									
	3		VS >213 kPa		1.0									
		Not Encountered	VS 182/ 52 kPa		1.5			1.2 m: becomes orange brown mottled brown with some clay and trace fine grained sand						
			VS 184/ 50 kPa		2.0									
			VS 150/ 40 kPa		2.5									
					3.0			Hand Auger HAL522C terminated at 2.0 m Target depth						
					3.5									
					4.0									
					4.5									

method AD auger drilling* AS auger screwing* HA hand auger W washbore HA hand auger	support M mud C casing N nil	samples & field tests B bulk disturbed sample D disturbed sample E environmental sample SS split spoon sample U## undisturbed sample ##mm diameter HP hand penetrometer (kPa) N standard penetration test (SPT) N* SPT - sample recovered Nc SPT with solid cone VS vane shear; peak/remoulded (kPa) R refusal HB hammer bouncing	classification symbol & soil description based on Unified Classification System	consistency / relative density VS very soft S soft F firm St stiff VSt very stiff H hard Fb friable VL very loose L loose MD medium dense D dense VD very dense
* bit shown by suffix e.g. AD/T B blank bit T TC bit V V bit	penetration  no resistance ranging to refusal 10-Oct-12 water level on date shown water inflow water outflow		moisture D dry M moist W wet S saturated Wp plastic limit Wl liquid limit	

Engineering Log - Hand Auger

client: **THE LAKES (2012) LIMITED**

principal:

project: **THE LAKES, STAGE 3I GCR**

location: **CENTRE OF LOT 523**

Borehole ID. **HAL523**

sheet: 1 of 1

project no. **773-GENZTAUC13086AP**

date started: **05 Oct 2017**

date completed: **05 Oct 2017**

logged by: **SBG**

checked by: **DBC**

position: Not Specified surface elevation: Not Specified angle from horizontal: 90° DCP id.:
drill model: Hand Auger drilling fluid: hole diameter : 50 mm vane id.: SL817

drilling information					material substance									
method & support	penetration	water	samples & field tests	RL (m)	depth (m)	graphic log	classification symbol	material description	moisture condition	consistency / relative density	vane shear (kPa)	DCP (blows/100 mm)	structure and additional observations	
HA N	1		VS >247 kPa		0.5			ORGANIC SILT: non plastic, dark brown black mottled orange, trace fine to medium grained sand.	D to M				TOPSOIL	
	2		VS >247 kPa		1.0			Clayey SILT: low plasticity, brown orange mottled grey black white.	M	H			FILL	
	3		VS >247 kPa		1.5			SILT: non plastic, brown orange, trace fine to medium grained sand.						
			VS >247 kPa		2.0									
			VS UTP		2.5									
			VS UTP		3.0									
					3.5			Hand Auger HAL523 terminated at 2.0 m						
					4.0									
					4.5									

method AD auger drilling* AS auger screwing* HA hand auger W washbore HA hand auger	support M mud C casing N nil	penetration 	samples & field tests B bulk disturbed sample D disturbed sample E environmental sample SS split spoon sample U## undisturbed sample ##mm diameter HP hand penetrometer (kPa) N standard penetration test (SPT) N* SPT - sample recovered Nc SPT with solid cone VS vane shear; peak/remoulded (kPa) R refusal HB hammer bouncing	classification symbol & soil description based on Unified Classification System	consistency / relative density VS very soft S soft F firm St stiff VSt very stiff H hard Fb friable VL very loose L loose MD medium dense D dense VD very dense
moisture D dry M moist W wet S saturated Wp plastic limit WL liquid limit					

* bit shown by suffix
e.g.
AD/T
B blank bit
T TC bit
V V bit

Engineering Log - Hand Auger

client: **THE LAKES (2012) LIMITED**

principal:

project: **THE LAKES, STAGE 3I GCR**

location: **EASTERN BOUNDARY OF LOT 523 AND 524**

Borehole ID. **HAL523-524**

sheet: 1 of 1

project no. **773-GENZTAUC13086AP**

date started: **05 Oct 2017**

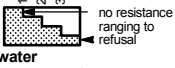
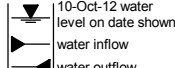
date completed: **05 Oct 2017**

logged by: **ODS**

checked by: **DBC**

position: Not Specified surface elevation: Not Specified angle from horizontal: 90° DCP id.:
drill model: Hand Auger drilling fluid: hole diameter : 50 mm vane id.: SL588

drilling information					material substance									
method & support	1 penetration	2 water	samples & field tests	RL (m)	depth (m)	graphic log	classification symbol	material description	moisture condition	consistency / relative density	vane shear remoulded peak (kPa)	DCP (blows/100 mm)	structure and additional observations	
HA N	1 2 3							SILT: low plasticity, orange brown mottled brown and grey, with minor clay and trace fine grained sand. 0.5 m: with some clay	D to M	H			FILL	
			VS >213 kPa		0.5									
			VS >213 kPa		1.0									
			VS >213 kPa		1.5									
			VS >213 kPa		2.0			Hand Auger HAL523-524 terminated at 2.0 m Target depth						
					2.5									
					3.0									
					3.5									
					4.0									
					4.5									

method AD auger drilling* AS auger screwing* HA hand auger W washbore HA hand auger	support M mud N nil C casing penetration  water 	samples & field tests B bulk disturbed sample D disturbed sample E environmental sample SS split spoon sample U## undisturbed sample ##mm diameter HP hand penetrometer (kPa) N standard penetration test (SPT) N* SPT - sample recovered Nc SPT with solid cone VS vane shear; peak/remoulded (kPa) R refusal HB hammer bouncing	classification symbol & soil description based on Unified Classification System moisture D dry M moist W wet S saturated Wp plastic limit Wl liquid limit	consistency / relative density VS very soft S soft F firm St stiff VSt very stiff H hard Fb friable VL very loose L loose MD medium dense D dense VD very dense
---	---	--	---	--

* bit shown by suffix
e.g.
AD/T
B blank bit
T TC bit
V V bit

Engineering Log - Hand Auger

client: **THE LAKES (2012) LIMITED**

principal:

project: **THE LAKES, STAGE 3I GCR**

location: **CENTRE OF LOT 524**

Borehole ID. **HAL524**

sheet: 1 of 1

project no. **773-GENZTAUC13086AP**

date started: **05 Oct 2017**

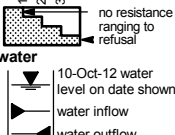
date completed: **05 Oct 2017**

logged by: **SBG**

checked by: **DBC**

position: Not Specified surface elevation: Not Specified angle from horizontal: 90° DCP id.:
drill model: Hand Auger drilling fluid: hole diameter : 50 mm vane id.: SL817

drilling information				material substance									
method & support	penetration	water	samples & field tests	RL (m)	depth (m)	graphic log	classification symbol	material description	moisture condition	consistency / relative density	vane shear (kPa)	DCP (blows/100 mm)	structure and additional observations
HA	1	Not Encountered	VS 217 kPa					ORGANIC SILT: non plastic, dark brown black.	D to M				TOPSOIL
	2		VS 140 kPa		0.5			Clayey SILT: low to medium plasticity, brown orange mottled black white grey.	M	H			FILL
	3		VS 247 kPa		1.0			SILT: low plasticity, brown orange mottled black white, minor fine to medium grained sand.		VSt			
			VS 247 kPa		1.5			Sandy SILT: non plastic, brown orange mottled grey white. 1.5 m: becoming slightly plastic		H			
			VS UTP		2.0			Hand Auger HAL524 terminated at 2.0 m Target depth					
					2.5								
					3.0								
					3.5								
					4.0								
					4.5								

method AD auger drilling* AS auger screwing* HA hand auger W washbore HA hand auger	support M mud C casing N nil	samples & field tests B bulk disturbed sample D disturbed sample E environmental sample SS split spoon sample U## undisturbed sample ##mm diameter HP hand penetrometer (kPa) N standard penetration test (SPT) N* SPT - sample recovered Nc SPT with solid cone VS vane shear; peak/remoulded (kPa) R refusal HB hammer bouncing	classification symbol & soil description based on Unified Classification System	consistency / relative density VS very soft S soft F firm St stiff VSt very stiff H hard Fb friable VL very loose L loose MD medium dense D dense VD very dense
* bit shown by suffix e.g. AD/T B blank bit T TC bit V V bit	penetration 		moisture D dry M moist W wet S saturated Wp plastic limit WL liquid limit	

Engineering Log - Hand Auger

client: **THE LAKES (2012) LIMITED**

principal:

project: **THE LAKES, STAGE 3I GCR**

location: **BOUNDARY OF LOT 524 AND 525**

Borehole ID. **HAL524-525**

sheet: 1 of 1

project no. **773-GENZTAUC13086AP**

date started: **05 Oct 2017**

date completed: **05 Oct 2017**

logged by: **PRM**

checked by: **DBC**

position: Not Specified surface elevation: Not Specified angle from horizontal: 90° DCP id.:
drill model: Hand Auger drilling fluid: hole diameter : 50 mm vane id.: 4523

drilling information							material substance								
method & support	1 penetration	2	3	water	samples & field tests	RL (m)	depth (m)	graphic log	classification symbol	material description	moisture condition	consistency / relative density	vane shear ⊕ remoulded ⊙ peak (kPa)	DCP (blows/ 100 mm)	structure and additional observations
HA N				Not Encountered	VS 215/ 37 kPa		0.5			ORGANIC SILT: non plastic, dark brown-black.	D to M				TOPSOIL
					VS UTP					Clayey SILT: low plasticity, brown mottled dark brown/pink, with trace fine to medium grained sand.	M	VSt	⊕	⊙	FILL
					VS 140/ 40 kPa		1.0			1.2 to 1.3 m: becoming moderately plastic			⊕	⊙	
					VS UTP		1.5						⊕	⊙	
					VS 194/ 35 kPa		2.0			Sandy SILT: non plastic, pale grey, sand is fine grained.			⊕	⊙	
										Hand Auger HAL524-525 terminated at 2.0 m Target depth					
							2.5								
							3.0								
							3.5								
							4.0								
							4.5								

method AD auger drilling* AS auger screwing* HA hand auger W washbore HA hand auger	support M mud C casing N nil	samples & field tests B bulk disturbed sample D disturbed sample E environmental sample SS split spoon sample U## undisturbed sample ##mm diameter HP hand penetrometer (kPa) N standard penetration test (SPT) N* SPT - sample recovered Nc SPT with solid cone VS vane shear; peak/remoulded (kPa) R refusal HB hammer bouncing	classification symbol & soil description based on Unified Classification System	consistency / relative density VS very soft S soft F firm St stiff VSt very stiff H hard Fb friable VL very loose L loose MD medium dense D dense VD very dense
* bit shown by suffix e.g. AD/T B blank bit T TC bit V V bit	penetration no resistance ranging to refusal 10-Oct-12 water level on date shown water inflow water outflow		moisture D dry M moist W wet S saturated Wp plastic limit WL liquid limit	

Engineering Log - Hand Auger

client: **THE LAKES (2012) LIMITED**

principal:

project: **THE LAKES, STAGE 3I GCR**

location: **CENTRE OF LOT 525**

Borehole ID. **HAL525**

sheet: 1 of 1

project no. **773-GENZTAUC13086AP**

date started: **05 Oct 2017**

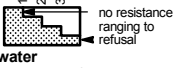
date completed: **05 Oct 2017**

logged by: **ODS**

checked by: **DBC**

position: Not Specified surface elevation: Not Specified angle from horizontal: 90° DCP id.:
drill model: Hand Auger drilling fluid: hole diameter : 50 mm vane id.: SL588

drilling information							material substance								
method & support	1 penetration	2	3	water	samples & field tests	RL (m)	depth (m)	graphic log	classification symbol	material description	moisture condition	consistency / relative density	vane shear ⊕ remoulded ⊙ peak (kPa)	DCP (blows/ 100 mm)	structure and additional observations
HA Z				Not Encountered	VS >213 kPa		0.5			ORGANIC SILT: non plastic, black.	D to M				TOPSOIL
						SILT: non plastic to low plasticity, orange brown mottled grey and dark brown, with trace to minor clay and trace fine to medium grained sand.				FILL					
						ORGANIC SILT: non plastic, black mottled orange brown.				BURIED TOPSOIL					
						SILT: low plasticity, orange brown mottled brown and grey, with minor clay and trace fine to coarse grained sand.				FILL					
					VS 173/ 31 kPa		1.0			1.3 m: with some clay and trace fine grained sand			⊕	⊙	
					VS >213 kPa		1.5						⊕	⊙	
					VS 208/ 61 kPa		2.0						⊕	⊙	
							2.0			Hand Auger HAL525 terminated at 2.0 m Target depth					
							2.5								
							3.0								
							3.5								
							4.0								
							4.5								

method AD auger drilling* AS auger screwing* HA hand auger W washbore HA hand auger	support M mud C casing N nil	samples & field tests B bulk disturbed sample D disturbed sample E environmental sample SS split spoon sample U## undisturbed sample ##mm diameter HP hand penetrometer (kPa) N standard penetration test (SPT) N* SPT - sample recovered Nc SPT with solid cone VS vane shear, peak/remoulded (kPa) R refusal HB hammer bouncing	classification symbol & soil description based on Unified Classification System	consistency / relative density VS very soft S soft F firm St stiff VSt very stiff H hard Fb friable VL very loose L loose MD medium dense D dense VD very dense
* bit shown by suffix e.g. AD/T B blank bit T TC bit V V bit	penetration  no resistance ranging to refusal 10-Oct-12 water level on date shown water inflow water outflow		moisture D dry M moist W wet S saturated Wp plastic limit WL liquid limit	

Engineering Log - Hand Auger

client: **THE LAKES (2012) LIMITED**

principal:

project: **THE LAKES, STAGE 3I GCR**

location: **EASTERN BOUNDARY OF LOT 525 AND 526**

Borehole ID. **HAL525-526**

sheet: 1 of 1

project no. **773-GENZTAUC13086AP**

date started: **05 Oct 2017**

date completed: **05 Oct 2017**

logged by: **ODS**

checked by: **DBC**

position: Not Specified surface elevation: Not Specified angle from horizontal: 90° DCP id.:
drill model: Hand Auger drilling fluid: hole diameter : 50 mm vane id.: SL588

drilling information							material substance								
method & support	penetration		water	samples & field tests	RL (m)	depth (m)	graphic log	classification symbol	material description	moisture condition	consistency / relative density	vane shear ⊕ remoulded ⊙ peak (kPa)	DCP (blows/ 100 mm)	structure and additional observations	
HA	1	2		VS >213 kPa		0.5			ORGANIC SILT: non plastic, black.	M	VSt to H	⊕ ⊙ ⊙ ⊙ ⊕ ⊙	2 4 6 8 10	TOPSOIL	
									SILT: low plasticity, orange brown mottled brown and grey, with minor clay and trace fine to coarse grained sand. 0.5 m: perched water table encountered	S				FILL	
				VS >213 kPa		1.0									
				VS >213 kPa		1.5									
				VS 157/ 40 kPa		2.0			Hand Auger HAL525-526 terminated at 2.0 m Target depth						
				VS >213 kPa		2.5									
						3.0									
						3.5									
						4.0									
						4.5									

method AD auger drilling* AS auger screwing* HA hand auger W washbore HA hand auger	support M mud C casing N nil	samples & field tests B bulk disturbed sample D disturbed sample E environmental sample SS split spoon sample U## undisturbed sample ##mm diameter HP hand penetrometer (kPa) N standard penetration test (SPT) N* SPT - sample recovered Nc SPT with solid cone VS vane shear; peak/remoulded (kPa) R refusal HB hammer bouncing	classification symbol & soil description based on Unified Classification System	consistency / relative density VS very soft S soft F firm St stiff VSt very stiff H hard Fb friable VL very loose L loose MD medium dense D dense VD very dense
penetration  no resistance ranging to refusal 10-Oct-12 water level on date shown water inflow water outflow	moisture D dry M moist W wet S saturated Wp plastic limit Wl liquid limit			

* bit shown by suffix
e.g.
AD/T
B blank bit
T TC bit
V V bit

Engineering Log - Hand Auger

client: **THE LAKES (2012) LIMITED**

principal:

project: **THE LAKES, STAGE 3I GCR**

location: **CENTRE OF LOT 526**

Borehole ID. **HAL526**

sheet: 1 of 1

project no. **773-GENZTAUC13086AP**

date started: **05 Oct 2017**

date completed: **05 Oct 2017**

logged by: **SBG**

checked by: **DBC**

position: Not Specified surface elevation: Not Specified angle from horizontal: 90° DCP id.:
drill model: Hand Auger drilling fluid: hole diameter : 50 mm vane id.: SL817

drilling information					material substance										structure and additional observations
method & support	1 penetration	2	3	water	samples & field tests	RL (m)	depth (m)	graphic log	classification symbol	material description	moisture condition	consistency / relative density	vane shear remoulded peak (kPa)	DCP (blows/100 mm)	
HA N	1 2 3			Not Encountered	VS >247 kPa VS >247 kPa VS >247 kPa VS >247 kPa VS >247 kPa VS >247 kPa		0.5 1.0 1.5 2.0			ORGANIC SILT: non plastic, dark brown black, trace fine grained sand.	D to M				TOPSOIL
										Clayey SILT: low to medium plasticity, brown orange mottled white black red.	M	H			FILL
										Sandy SILT: low plasticity, pale grey mottled brown orange black, minor clay.					
										Clayey SILT: low plasticity, brown orange mottled black white.					
										SILT: non plastic, brown mottled black white grey.					
										Hand Auger HAL526 terminated at 2.0 m Target depth					
							2.5 3.0 3.5 4.0 4.5								

method AD auger drilling* AS auger screwing* HA hand auger W washbore HA hand auger	support M mud C casing N nil	samples & field tests B bulk disturbed sample D disturbed sample E environmental sample SS split spoon sample U## undisturbed sample ##mm diameter HP hand penetrometer (kPa) N standard penetration test (SPT) N* SPT - sample recovered Nc SPT with solid cone VS vane shear; peak/remoulded (kPa) R refusal HB hammer bouncing	classification symbol & soil description based on Unified Classification System	consistency / relative density VS very soft S soft F firm St stiff VSt very stiff H hard Fb friable VL very loose L loose MD medium dense D dense VD very dense
* bit shown by suffix e.g. AD/T B blank bit T TC bit V V bit	penetration water 10-Oct-12 water level on date shown water inflow water outflow		moisture D dry M moist W wet S saturated Wp plastic limit WI liquid limit	

Engineering Log - Hand Auger

client: **THE LAKES (2012) LIMITED**

principal:

project: **THE LAKES, STAGE 3I GCR**

location: **BOUNDARY OF LOT 526 AND 527**

Borehole ID. **HAL526-527**

sheet: 1 of 1

project no. **773-GENZTAUC13086AP**

date started: **05 Oct 2017**

date completed: **05 Oct 2017**

logged by: **PRM**

checked by: **DBC**

position: Not Specified surface elevation: Not Specified angle from horizontal: 90° DCP id.:
drill model: Hand Auger drilling fluid: hole diameter : 50 mm vane id.: 4523

drilling information					material substance									
method & support	penetration	water	samples & field tests	RL (m)	depth (m)	graphic log	classification symbol	material description	moisture condition	consistency / relative density	vane shear remoulded peak (kPa)	DCP (blows/100 mm)	structure and additional observations	
HA	1							ORGANIC SILT: non plastic, dark brown-black.	D to M				TOPSOIL	
	2		VS 215/40 kPa		0.5			Clayey SILT: low plasticity, dark brown mottled pale orange/pale pink, with trace fine grained sand.	M	H	⊕	⊙	FILL	
	3		VS >224 kPa		1.0									
		Not Encountered	VS UTP		1.5			1.1 to 1.3 m: becoming moderately plastic						
			VS UTP		2.0									
					2.0			Hand Auger HAL526-527 terminated at 2.0 m Target depth						

method AD auger drilling* AS auger screwing* HA hand auger W washbore HA hand auger	support M mud C casing N nil	penetration water 10-Oct-12 water level on date shown water inflow water outflow	samples & field tests B bulk disturbed sample D disturbed sample E environmental sample SS split spoon sample U## undisturbed sample ##mm diameter HP hand penetrometer (kPa) N standard penetration test (SPT) N* SPT - sample recovered Nc SPT with solid cone VS vane shear; peak/remoulded (kPa) R refusal HB hammer bouncing	classification symbol & soil description based on Unified Classification System moisture D dry M moist W wet S saturated Wp plastic limit WL liquid limit	consistency / relative density VS very soft S soft F firm St stiff VSt very stiff H hard Fb friable VL very loose L loose MD medium dense D dense VD very dense
---	--	--	--	---	--

* bit shown by suffix
e.g.
AD/T
B blank bit
T TC bit
V V bit

Engineering Log - Hand Auger

client: **THE LAKES (2012) LIMITED**

principal:

project: **THE LAKES, STAGE 3I GCR**

location: **CENTRE OF LOT 527**

Borehole ID. **HAL527**

sheet: 1 of 1

project no. **773-GENZTAUC13086AP**

date started: **05 Oct 2017**

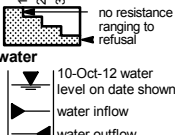
date completed: **05 Oct 2017**

logged by: **SBG**

checked by: **DBC**

position: Not Specified surface elevation: Not Specified angle from horizontal: 90° DCP id.:
drill model: Hand Auger drilling fluid: hole diameter : 50 mm vane id.: SL817

drilling information					material substance										structure and additional observations	
method & support	1 penetration	2 water	samples & field tests	RL (m)	depth (m)	graphic log	classification symbol	material description	moisture condition	consistency / relative density	vane shear remoulded peak (kPa)	DCP (blows/ 100 mm)				
HA	1	Not Encountered	VS >247 kPa		0.5			ORGANIC SILT: non plastic, dark brown black mottled red white grey, trace fine to medium grained sand.	D to M	H						TOPSOIL
	2		VS >247 kPa		1.0			SILT: low plasticity, brown orange mottled white black, trace fine to medium grained sand, minor clay.	M							FILL
	3		VS >247 kPa		1.5			Clayey SILT: low to medium plasticity, brown orange mottled black white grey.								
			VS >247 kPa		2.0			SILT: low plasticity, brown orange, trace fine to medium grained sand.								
			VS UTP		2.0			Hand Auger HAL527 terminated at 2.0 m Target depth								
					2.5											
					3.0											
					3.5											
					4.0											
					4.5											

method AD auger drilling* AS auger screwing* HA hand auger W washbore HA hand auger	support M mud C casing N nil	penetration  no resistance ranging to refusal 10-Oct-12 water level on date shown water inflow water outflow	samples & field tests B bulk disturbed sample D disturbed sample E environmental sample SS split spoon sample U## undisturbed sample ##mm diameter HP hand penetrometer (kPa) N standard penetration test (SPT) N* SPT - sample recovered Nc SPT with solid cone VS vane shear; peak/remoulded (kPa) R refusal HB hammer bouncing	classification symbol & soil description based on Unified Classification System	consistency / relative density VS very soft S soft F firm St stiff VSt very stiff H hard Fb friable VL very loose L loose MD medium dense D dense VD very dense
moisture D dry M moist W wet S saturated Wp plastic limit Wl liquid limit					

* bit shown by suffix
e.g.
AD/T
B blank bit
T TC bit
V V bit

Engineering Log - Hand Auger

client: **THE LAKES (2012) LIMITED**

principal:

project: **THE LAKES, STAGE 3I GCR**

location: **BOUNDARY OF LOT 527 AND 528**

Borehole ID. **HAL527-528**

sheet: 1 of 1

project no. **773-GENZTAUC13086AP**

date started: **04 Oct 2017**

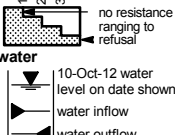
date completed: **04 Oct 2017**

logged by: **PRM**

checked by: **DBC**

position: Not Specified surface elevation: Not Specified angle from horizontal: 90° DCP id.:
drill model: Hand Auger drilling fluid: hole diameter : 50 mm vane id.: 4523

drilling information							material substance								
method & support	1 penetration	2 penetration	3 penetration	water	samples & field tests	RL (m)	depth (m)	graphic log	classification symbol	material description	moisture condition	consistency / relative density	vane shear ⊕ remoulded ⊙ peak (kPa)	DCP (blows/ 100 mm)	structure and additional observations
HA	N			Not Encountered	VS >224 kPa		0.5			ORGANIC SILT: non plastic, dark brown-black.	D to M	H			TOPSOIL
							Sandy SILT: non plastic, brown mottled orange-brown and dark brown, sand is fine to medium grained.		M		⊕		FILL		
							Clayey SILT: low plasticity, brown mottled dark brown/white/pale brown, with trace fine to medium grained sand.								
					1.0		SILTY SAND: fine to medium grained, pale grey-white.								
					1.5		Clayey SILT: low plasticity, brown mottled brown/dark brown/ orange-brown, with minor fine grained sand.		H						
					VS UTP		2.0			Hand Auger HAL527-528 terminated at 2.0 m Target depth			VS UTP		
							2.5								
							3.0								
							3.5								
							4.0								
							4.5								

method AD auger drilling* AS auger screwing* HA hand auger W washbore HA hand auger	support M mud C casing N nil	samples & field tests B bulk disturbed sample D disturbed sample E environmental sample SS split spoon sample U## undisturbed sample ##mm diameter HP hand penetrometer (kPa) N standard penetration test (SPT) N* SPT - sample recovered Nc SPT with solid cone VS vane shear; peak/remoulded (kPa) R refusal HB hammer bouncing	classification symbol & soil description based on Unified Classification System	consistency / relative density VS very soft S soft F firm St stiff VSt very stiff H hard Fb friable VL very loose L loose MD medium dense D dense VD very dense
* bit shown by suffix e.g. AD/T B blank bit T TC bit V V bit	penetration 		moisture D dry M moist W wet S saturated Wp plastic limit Wl liquid limit	

Engineering Log - Hand Auger

client: **THE LAKES (2012) LIMITED**

principal:

project: **THE LAKES, STAGE 3I GCR**

location: **CENTRE OF LOT 528**

Borehole ID. **HAL528**

sheet: 1 of 1

project no. **773-GENZTAUC13086AP**

date started: **05 Oct 2017**

date completed: **05 Oct 2017**

logged by: **ODS**

checked by: **DBC**

position: Not Specified surface elevation: Not Specified angle from horizontal: 90° DCP id.:
drill model: Hand Auger drilling fluid: hole diameter : 50 mm vane id.: SL588

drilling information							material substance											
method & support	penetration			water	samples & field tests	RL (m)	depth (m)	graphic log	classification symbol	material description	moisture condition	consistency / relative density	vane shear			DCP (blows/ 100 mm)	structure and additional observations	
	1	2	3										⊕ remoulded	⊙ peak	(kPa)			
HA N				Not Encountered						ORGANIC SILT: non plastic, black.	D						TOPSOIL	
												M	VSt to H	⊕	⊙			FILL
														⊕	⊙			
															⊙			
																⊙		
										1.2 m: becomes grey mottled brown. With minor to some clay and trace fine grained sand								
										1.5 m: becomes brown mottled grey. With minor to some fine to medium grained sand and with trace to minor clay								
										Sandy SILT: non plastic to low plasticity, brown mottled grey and orange brown, with trace clay. Sand is fine grained.	W	VSt	⊕	⊙				
										Hand Auger HAL528 terminated at 2.0 m Target depth								
							</											

method AD auger drilling* AS auger screwing* HA hand auger W washbore HA hand auger	support M mud C casing N nil	samples & field tests B bulk disturbed sample D disturbed sample E environmental sample SS split spoon sample U## undisturbed sample ##mm diameter HP hand penetrometer (kPa) N standard penetration test (SPT) N* SPT - sample recovered Nc SPT with solid cone VS vane shear; peak/remoulded (kPa) R refusal HB hammer bouncing	classification symbol & soil description based on Unified Classification System	consistency / relative density VS very soft S soft F firm St stiff VSt very stiff H hard Fb friable VL very loose L loose MD medium dense D dense VD very dense
penetration 	water 10-Oct-12 water level on date shown water inflow water outflow		moisture D dry M moist W wet S saturated Wp plastic limit WL liquid limit	

* bit shown by suffix
e.g.
AD/T
B blank bit
T TC bit
V V bit

Engineering Log - Hand Auger

client: **THE LAKES (2012) LIMITED**

principal:

project: **THE LAKES, STAGE 3I GCR**

location: **BOUNDARY OF LOT 528 AND 529**

Borehole ID. **HAL528-529**

sheet: 1 of 1

project no. **773-GENZTAUC13086AP**

date started: **04 Oct 2017**

date completed: **04 Oct 2017**

logged by: **PRM**

checked by: **DBC**

position: Not Specified surface elevation: Not Specified angle from horizontal: 90° DCP id.:
drill model: Hand Auger drilling fluid: hole diameter : 50 mm vane id.: 4523

drilling information					material substance										
method & support	penetration		water	samples & field tests	RL (m)	depth (m)	graphic log	classification symbol	material description	moisture condition	consistency / relative density		vane shear ⊕ remoulded ⊙ peak (kPa)	DCP (blows/ 100 mm)	structure and additional observations
HA Z	1	2	Not Encountered	VS 143/ 32 kPa		0.5			ORGANIC SILT: non plastic, dark brown-black.	D to M	VSt to H	⊕	⊙	2 4 6 8 10	TOPSOIL
	3	VS >224 kPa				SILT: non plastic, brown mottled pale orange and dark brown, with trace fine grained sand.			M	⊕		⊙	FILL		
	VS >224 kPa	1.0		Clayey SILT: low plasticity, brown mottled orange-brown, with trace fine to medium grained sand.					⊕	⊙					
	VS 98/ 25 kPa	1.5		1.5 m: becoming moderately plastic, white mottled orange-brown and brown		St to VSt			⊕	⊙					
			VS 105/ 28 kPa		2.0				Hand Auger HAL528-529 terminated at 2.0 m Target depth			⊕	⊙		
						2.5									
						3.0									
						3.5									
						4.0									
						4.5									

method AD auger drilling* AS auger screwing* HA hand auger W washbore HA hand auger	support M mud C casing N nil	penetration 	samples & field tests B bulk disturbed sample D disturbed sample E environmental sample SS split spoon sample U## undisturbed sample ##mm diameter HP hand penetrometer (kPa) N standard penetration test (SPT) N* SPT - sample recovered Nc SPT with solid cone VS vane shear; peak/remoulded (kPa) R refusal HB hammer bouncing	classification symbol & soil description based on Unified Classification System	consistency / relative density VS very soft S soft F firm St stiff VSt very stiff H hard Fb friable VL very loose L loose MD medium dense D dense VD very dense
moisture D dry M moist W wet S saturated Wp plastic limit Wl liquid limit					

* bit shown by suffix
e.g. AD/T
B blank bit
T TC bit
V V bit

Engineering Log - Hand Auger

client: **THE LAKES (2012) LIMITED**

principal:

project: **THE LAKES, STAGE 3I GCR**

location: **BOUNDARY OF LOT 529 AND 530**

Borehole ID. **HAL529-530**

sheet: 1 of 1

project no. **773-GENZTAUC13086AP**

date started: **04 Oct 2017**

date completed: **04 Oct 2017**

logged by: **SBG**

checked by: **DBC**

position: Not Specified surface elevation: Not Specified angle from horizontal: 90° DCP id.:
drill model: Hand Auger drilling fluid: hole diameter : 50 mm vane id.: SL817

drilling information							material substance								
method & support	penetration			water	samples & field tests	RL (m)	depth (m)	graphic log	classification symbol	material description	moisture condition	consistency / relative density	vane shear ⊕ remoulded ⊙ peak (kPa)	DCP (blows/ 100 mm)	structure and additional observations
HA N	1	2	3		VS 247/ 42 kPa					ORGANIC SILT: low plasticity, dark brown black mottled grey white.	D to M				TOPSOIL
				VS 247 kPa	0.5		Sandy SILT: low plasticity, brown orange mottled dark brown black white. 0.4 m: becoming slightly plastic		M	H	⊕	⊙		FILL	
				VS 247 kPa	1.0		SILTY SAND: fine to medium grained, brown orange mottled white black. 0.9 m: becoming pale grey mottled brown orange black								
				VS 247 kPa	1.5		Sandy SILT: low plasticity, brown orange mottled grey white black.		H		⊕	⊙			
				VS 247 kPa			2.0			Hand Auger HAL529-530 terminated at 2.0 m Target depth					
							2.5								
							3.0								
							3.5								
							4.0								
							4.5								

method AD auger drilling* AS auger screwing* HA hand auger W washbore HA hand auger	support M mud C casing N nil	samples & field tests B bulk disturbed sample D disturbed sample E environmental sample SS split spoon sample U## undisturbed sample ##mm diameter HP hand penetrometer (kPa) N standard penetration test (SPT) N* SPT - sample recovered Nc SPT with solid cone VS vane shear; peak/remoulded (kPa) R refusal HB hammer bouncing	classification symbol & soil description based on Unified Classification System	consistency / relative density VS very soft S soft F firm St stiff VSt very stiff H hard Fb friable VL very loose L loose MD medium dense D dense VD very dense
penetration 	water 10-Oct-12 water level on date shown water inflow water outflow	moisture D dry M moist W wet S saturated Wp plastic limit WL liquid limit		

* bit shown by suffix
e.g.
AD/T
B blank bit
T TC bit
V V bit

Engineering Log - Hand Auger

client: **THE LAKES (2012) LIMITED**

principal:

project: **THE LAKES, STAGE 3I GCR**

location: **CENTRE OF LOT 530**

Borehole ID. **HAL530**

sheet: 1 of 1

project no. **773-GENZTAUC13086AP**

date started: **04 Oct 2017**

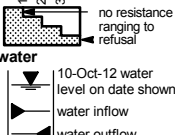
date completed: **04 Oct 2017**

logged by: **ODS**

checked by: **DBC**

position: Not Specified surface elevation: Not Specified angle from horizontal: 90° DCP id.:
drill model: Hand Auger drilling fluid: hole diameter : 50 mm vane id.: SL588

drilling information				material substance									
method & support	penetration	water	samples & field tests	RL (m)	depth (m)	graphic log	classification symbol	material description	moisture condition	consistency / relative density	vane shear (kPa)	DCP (blows/100 mm)	structure and additional observations
1 2 3	1 2 3							ORGANIC SILT: low plasticity, dark brown black mottled grey white.	M				TOPSOIL
			VS 199/ 48 kPa		0.5			SILT: low plasticity, orange-brown mottled brown, with minor clay and trace fine to coarse grained sand.	VSt				FILL
			VS 134/ 22 kPa		1.0			0.9 m: with minor fine to medium grained sand	W				
			VS 115/ 38 kPa		1.5								
			VS 103/ 38 kPa		2.0								
			VS 89/ 31 kPa		2.0			Hand Auger HAL530 terminated at 2.0 m Target depth	St				
					2.5								
					3.0								
					3.5								
					4.0								
					4.5								

method AD auger drilling* AS auger screwing* HA hand auger W washbore HA hand auger	support M mud C casing N nil	penetration 	samples & field tests B bulk disturbed sample D disturbed sample E environmental sample SS split spoon sample U## undisturbed sample ##mm diameter HP hand penetrometer (kPa) N standard penetration test (SPT) N* SPT - sample recovered Nc SPT with solid cone VS vane shear; peak/remoulded (kPa) R refusal HB hammer bouncing	classification symbol & soil description based on Unified Classification System	consistency / relative density VS very soft S soft F firm St stiff VSt very stiff H hard Fb friable VL very loose L loose MD medium dense D dense VD very dense
moisture D dry M moist W wet S saturated Wp plastic limit Wl liquid limit					

* bit shown by suffix
e.g.
AD/T
B blank bit
T TC bit
V V bit

Engineering Log - Hand Auger

client: **THE LAKES (2012) LIMITED**

principal:

project: **THE LAKES, STAGE 3I GCR**

location: **CENTRE OF LOT 531**

Borehole ID. **HAL531**

sheet: 1 of 1

project no. **773-GENZTAUC13086AP**

date started: **04 Oct 2017**

date completed: **04 Oct 2017**

logged by: **ODS**

checked by: **DBC**

position: Not Specified surface elevation: Not Specified angle from horizontal: 90° DCP id.:
drill model: Hand Auger drilling fluid: hole diameter : 50 mm vane id.: SL588

drilling information					material substance									
method & support	1 penetration	2 water	samples & field tests	RL (m)	depth (m)	graphic log	classification symbol	material description	moisture condition	consistency / relative density	vane shear remoulded peak (kPa)	DCP (blows/100 mm)	structure and additional observations	
HA N	1		VS >213 kPa		0.5			ORGANIC SILT: non plastic, dark brown-black.	D to M				TOPSOIL	
	2		VS >213 kPa		1.0			SILT: low plasticity, orange-brown mottled brown/grey, with minor clay, and trace fine to coarse grained sand.	M	H			FILL	
	3		VS >213 kPa		1.1			1.1 m: with minor fine to medium grained sand	W					
			VS >213 kPa		1.5			1.6 m: with trace fine to medium grained sand						
			VS >213 kPa		2.0			Hand Auger HAL531 terminated at 2.0 m Target depth						
					2.5									
					3.0									
					3.5									
					4.0									
					4.5									

method AD auger drilling* AS auger screwing* HA hand auger W washbore HA hand auger * bit shown by suffix e.g. AD/T B blank bit T TC bit V V bit	support M mud C casing penetration water 10-Oct-12 water level on date shown water inflow water outflow	samples & field tests B bulk disturbed sample D disturbed sample E environmental sample SS split spoon sample U## undisturbed sample ##mm diameter HP hand penetrometer (kPa) N standard penetration test (SPT) N* SPT - sample recovered Nc SPT with solid cone VS vane shear; peak/remoulded (kPa) R refusal HB hammer bouncing	classification symbol & soil description based on Unified Classification System moisture D dry M moist W wet S saturated Wp plastic limit Wl liquid limit	consistency / relative density VS very soft S soft F firm St stiff VSt very stiff H hard Fb friable VL very loose L loose MD medium dense D dense VD very dense
--	---	--	---	--

client: **THE LAKES (2012) LIMITED**

principal:

project: **THE LAKES, STAGE 3/ GCR**

location: **BOUNDARY OF LOT 531 AND 532**

Borehole ID. **HAL531-532**

sheet: 1 of 1

project no. **773-GENZTAUC13086AP**

date started: **04 Oct 2017**

date completed: **04 Oct 2017**

logged by: **SBG**

checked by: **DBC**[illegible]

Engineering Log - Hand Auger

client: **THE LAKES (2012) LIMITED**

principal:

project: **THE LAKES, STAGE 3I GCR**

location: **CENTRE OF LOT 532**

Borehole ID. **HAL532**

sheet: 1 of 1

project no. **773-GENZTAUC13086AP**

date started: **05 Oct 2017**

date completed: **05 Oct 2017**

logged by: **ODS**

checked by: **DBC**

position: Not Specified surface elevation: Not Specified angle from horizontal: 90° DCP id.:
drill model: Hand Auger drilling fluid: hole diameter : 50 mm vane id.: SL588

drilling information							material substance								
method & support	penetration			water	samples & field tests	RL (m)	depth (m)	graphic log	classification symbol	material description	moisture condition	consistency / relative density	vane shear ⊕ remoulded ⊙ peak (kPa)	DCP (blows/ 100 mm)	structure and additional observations
HA N	1	2	3	Not Encountered	VS >213 kPa VS >213 kPa VS 157/ 46 kPa VS >213 kPa VS 132/ 28 kPa		0.5			ORGANIC SILT: non plastic, black.	D to M	VSt to H	⊕ ⊙ ⊕ ⊙ ⊕ ⊙	2 4 6 8 10	TOPSOIL
	0.3 m: becoming mottled brown	M	FILL												
	SILT: low plasticity, orange brown mottled brown and grey, with minor to some clay and with trace fine grained sand. 0.6 to 0.65 m: mixed topsoil														
	1.5 to 1.6 m: trace organic odour														
						2.0				Hand Auger HAL532 terminated at 2.0 m Target depth					
							2.5								
							3.0								
							3.5								
							4.0								
							4.5								

method AD auger drilling* AS auger screwing* HA hand auger W washbore HA hand auger	support M mud C casing N nil	samples & field tests B bulk disturbed sample D disturbed sample E environmental sample SS split spoon sample U## undisturbed sample ##mm diameter HP hand penetrometer (kPa) N standard penetration test (SPT) N* SPT - sample recovered Nc SPT with solid cone VS vane shear; peak/remoulded (kPa) R refusal HB hammer bouncing	classification symbol & soil description based on Unified Classification System	consistency / relative density VS very soft S soft F firm St stiff VSt very stiff H hard Fb friable VL very loose L loose MD medium dense D dense VD very dense
penetration no resistance ranging to refusal	water 10-Oct-12 water level on date shown water inflow water outflow	moisture D dry M moist W wet S saturated Wp plastic limit Wl liquid limit		

* bit shown by suffix
e.g.
AD/T
B blank bit
T TC bit
V V bit

Engineering Log - Hand Auger

client: **THE LAKES (2012) LIMITED**

principal:

project: **THE LAKES, STAGE 3I GCR**

location: **WESTERN BOUNDARY OF LOT 532 AND 533**

Borehole ID. **HAL532-533**

sheet: 1 of 1

project no. **773-GENZTAUC13086A**

date started: **05 Oct 2017**

date completed: **05 Oct 2017**

logged by: **ODS**

checked by: **DBC**

position: Not Specified surface elevation: Not Specified angle from horizontal: 90° DCP id.:
drill model: Hand Auger drilling fluid: hole diameter : 50 mm vane id.: SL588

drilling information					material substance									
method & support	penetration	water	samples & field tests	RL (m)	depth (m)	graphic log	classification symbol	material description	moisture condition	consistency / relative density	vane shear (kPa)	DCP (blows/100 mm)	structure and additional observations	
HA N	1	Not Encountered	VS 179/52 kPa VS >213 kPa		0.5			ORGANIC SILT: non plastic, black.	D to M	VSt to H			TOPSOIL	
	2				1.0			SILT: low plasticity, orange brown mottled brown, with trace fine grained sand and minor clay.	M				FILL	
	3				1.5			SAND: fine to medium grained, orange brown mottled brown, with minor silt. 1.3 m: with some silt	M to W					
					2.0			Hand Auger HAL532-533 terminated at 2.0 m Target depth						
					2.5									
					3.0									
					3.5									
					4.0									
					4.5									

method AD auger drilling* AS auger screwing* HA hand auger W washbore HA hand auger	support M mud C casing N nil	penetration no resistance ranging to refusal water 10-Oct-12 water level on date shown water inflow water outflow	samples & field tests B bulk disturbed sample D disturbed sample E environmental sample SS split spoon sample U## undisturbed sample ##mm diameter HP hand penetrometer (kPa) N standard penetration test (SPT) N* SPT - sample recovered Nc SPT with solid cone VS vane shear; peak/remoulded (kPa) R refusal HB hammer bouncing	classification symbol & soil description based on Unified Classification System moisture D dry M moist W wet S saturated Wp plastic limit Wl liquid limit	consistency / relative density VS very soft S soft F firm St stiff VSt very stiff H hard Fb friable VL very loose L loose MD medium dense D dense VD very dense
---	--	--	--	---	--

* bit shown by suffix
e.g. AD/T
B blank bit
T TC bit
V V bit

Engineering Log - Hand Auger

client: **THE LAKES (2012) LIMITED**

principal:

project: **THE LAKES, STAGE 3I GCR**

location: **CENTRE OF LOT 533**

Borehole ID. **HAL533**

sheet: 1 of 1

project no. **773-GENZTAUC13086AP**

date started: **04 Oct 2017**

date completed: **04 Oct 2017**

logged by: **PRM**

checked by: **DBC**

position: Not Specified surface elevation: Not Specified angle from horizontal: 90° DCP id.:
drill model: Hand Auger drilling fluid: hole diameter : 50 mm vane id.: 4523

drilling information					material substance									
method & support	penetration	water	samples & field tests	RL (m)	depth (m)	graphic log	classification symbol	material description	moisture condition	consistency / relative density	vane shear remoulded peak (kPa)	DCP (blows/100 mm)	structure and additional observations	
HA N	1	Not Encountered	VS 143/ 35 kPa		0.5			ORGANIC SILT: non plastic, dark brown-black.	D to M				TOPSOIL	FILL
	2		VS 196/ 35 kPa					Clayey SILT: low plasticity, dark brown mottled pale brown/orange, with minor fine grained sand.	M	VSt				
	3		VS 140/ 37 kPa		1.0			Sandy SILT: non plastic, pale white-grey mottled pale orange, sand is fine grained.						
			VS 140/ 37 kPa		1.5									
			VS 105/ 35 kPa		2.0			Hand Auger HAL533 terminated at 2.0 m Target depth						
					2.5									
					3.0									
					3.5									
					4.0									
					4.5									

method AD auger drilling* AS auger screwing* HA hand auger W washbore HA hand auger		support M mud N nil C casing		samples & field tests B bulk disturbed sample D disturbed sample E environmental sample SS split spoon sample U## undisturbed sample ##mm diameter HP hand penetrometer (kPa) N standard penetration test (SPT) N* SPT - sample recovered Nc SPT with solid cone VS vane shear; peak/remoulded (kPa) R refusal HB hammer bouncing				classification symbol & soil description based on Unified Classification System		consistency / relative density VS very soft S soft F firm St stiff VSt very stiff H hard Fb friable VL very loose L loose MD medium dense D dense VD very dense	
penetration 		water 10-Oct-12 water level on date shown water inflow water outflow		moisture D dry M moist W wet S saturated Wp plastic limit Wl liquid limit							

* bit shown by suffix
e.g.
AD/T
B blank bit
T TC bit
V V bit

Engineering Log - Hand Auger

client: **THE LAKES (2012) LIMITED**

principal:

project: **THE LAKES, STAGE 3I GCR**

location: **BOUNDARY OF LOT 533 AND 534**

Borehole ID. **HAL533-534**

sheet: 1 of 1

project no. **773-GENZTAUC13086A**

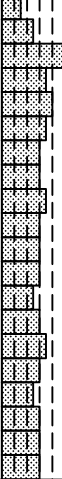
date started: **04 Oct 2017**

date completed: **04 Oct 2017**

logged by: **PRM**

checked by: **DBC**

position: Not Specified surface elevation: Not Specified angle from horizontal: 90° DCP id.:
drill model: Hand Auger drilling fluid: hole diameter : 50 mm vane id.: 4523

drilling information					material substance									
method & support	penetration	water	samples & field tests	RL (m)	depth (m)	graphic log	classification symbol	material description	moisture condition	consistency / relative density	vane shear ⊕ remoulded ⊙ peak (kPa)	DCP (blows/ 100 mm)	structure and additional observations	
HA N	1	Not Encountered	VS UTP		0.5			ORGANIC SILT: non plastic, dark brown-black.	D to M	VSt			TOPSOIL	
							SILT: non plastic, pale orange-brown, with some fine grained sand.	M	FILL					
							SILTY SAND: fine to medium grained, white-grey.	MD	0.7 m: becoming pale grey-white					SILTY SAND: fine to medium grained, white-grey.
							1.0							
					1.5									
					2.0			Hand Auger HAL533-534 terminated at 2.0 m Target depth						
					2.5									
					3.0									
					3.5									
					4.0									
					4.5									

method AD auger drilling* AS auger screwing* HA hand auger W washbore HA hand auger	support M mud C casing N nil	penetration 	samples & field tests B bulk disturbed sample D disturbed sample E environmental sample SS split spoon sample U## undisturbed sample ##mm diameter HP hand penetrometer (kPa) N standard penetration test (SPT) N* SPT - sample recovered Nc SPT with solid cone VS vane shear; peak/remoulded (kPa) R refusal HB hammer bouncing	classification symbol & soil description based on Unified Classification System	consistency / relative density VS very soft S soft F firm St stiff VSt very stiff H hard Fb friable VL very loose L loose MD medium dense D dense VD very dense
* bit shown by suffix e.g. AD/T B blank bit T TC bit V V bit	water 			moisture D dry M moist W wet S saturated Wp plastic limit WL liquid limit	

Engineering Log - Hand Auger

client: **THE LAKES (2012) LIMITED**

principal:

project: **THE LAKES, STAGE 3I GCR**

location: **CENTRE OF LOT 534**

Borehole ID. **HAL534**

sheet: 1 of 1

project no. **773-GENZTAUC13086A**

date started: **04 Oct 2017**

date completed: **04 Oct 2017**

logged by: **ODS**

checked by: **DBC**

position: Not Specified surface elevation: Not Specified angle from horizontal: 90° DCP id.:
drill model: Hand Auger drilling fluid: hole diameter : 50 mm vane id.:

drilling information				material substance									
method & support	penetration	water	samples & field tests	RL (m)	depth (m)	graphic log	classification symbol	material description	moisture condition	consistency / relative density	vane shear (kPa)	DCP (blows/100 mm)	structure and additional observations
HA	1							ORGANIC SILT.	D				TOPSOIL
	2				0.5			SAND: fine to coarse grained, orange pale brown, some silt. 0.4 m: becoming pale brown with trace to minor silt	D to M	MD			FILL
	3				1.0			SAND: fine to coarse grained, grey, some silt.	M				
					1.5								
					2.0			Hand Auger HAL534 terminated at 2.0 m Target depth					
					2.5								
					3.0								
					3.5								
					4.0								
					4.5								

method AD auger drilling* AS auger screwing* HA hand auger W washbore HA hand auger	support M mud C casing N nil	samples & field tests B bulk disturbed sample D disturbed sample E environmental sample SS split spoon sample U## undisturbed sample ##mm diameter HP hand penetrometer (kPa) N standard penetration test (SPT) N* SPT - sample recovered Nc SPT with solid cone VS vane shear; peak/remoulded (kPa) R refusal HB hammer bouncing	classification symbol & soil description based on Unified Classification System	consistency / relative density VS very soft S soft F firm St stiff VSt very stiff H hard Fb friable VL very loose L loose MD medium dense D dense VD very dense
* bit shown by suffix e.g. AD/T B blank bit T TC bit V V bit	penetration  no resistance ranging to refusal 10-Oct-12 water level on date shown water inflow water outflow		moisture D dry M moist W wet S saturated Wp plastic limit WL liquid limit	

Engineering Log - Hand Auger

client: **THE LAKES (2012) LIMITED**

principal:

project: **THE LAKES, STAGE 3I GCR**

location: **BOUNDARY OF LOT 534 and 535**

Borehole ID. **HAL534-535**

sheet: 1 of 1

project no. **773-GENZTAUC13086A**

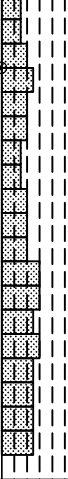
date started: **04 Oct 2017**

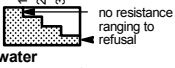
date completed: **04 Oct 2017**

logged by: **SBG**

checked by: **DBC**

position: Not Specified surface elevation: Not Specified angle from horizontal: 90° DCP id.:
drill model: Hand Auger drilling fluid: hole diameter : 50 mm vane id.: SL817

drilling information					material substance								
method & support	penetration	water	samples & field tests	RL (m)	depth (m)	graphic log	classification symbol	material description	moisture condition	consistency / relative density	vane shear ⊕ remoulded ⊙ peak (kPa) 100 150 200	DCP (blows/ 100 mm) 2 4 6 8 10	structure and additional observations
HA N	1	Not Encountered	VS 247 kPa		0.5			ORGANIC SILT: non plastic, dark brown mottled orange brown, trace fine grained sand.	D to M	MD	⊕ ⊙ ⊕ ⊙ ⊕ ⊙ ⊕ ⊙ ⊕ ⊙		TOPSOIL
	2		VS 213/ 48 kPa				SAND: fine to medium grained, pale brown mottled white black, minor silt.	M	FILL				
3	VS 162/ 29 kPa			0.7 m: becoming brown orange mottled dark brown black white									
	VS 193/ 45 kPa			1.2 m: becoming pale brown mottled black white dark brown									
	VS 193/ 42 kPa												
	VS 196/ 104 kPa												
				2.0				Hand Auger HAL534-535 terminated at 2.0 m Target depth					
					2.5								
					3.0								
					3.5								
					4.0								
					4.5								

method AD auger drilling* AS auger screwing* HA hand auger W washbore HA hand auger	support M mud C casing N nil	samples & field tests B bulk disturbed sample D disturbed sample E environmental sample SS split spoon sample U## undisturbed sample ##mm diameter HP hand penetrometer (kPa) N standard penetration test (SPT) N* SPT - sample recovered Nc SPT with solid cone VS vane shear; peak/remoulded (kPa) R refusal HB hammer bouncing	classification symbol & soil description based on Unified Classification System	consistency / relative density VS very soft S soft F firm St stiff VSt very stiff H hard Fb friable VL very loose L loose MD medium dense D dense VD very dense
* bit shown by suffix e.g. AD/T B blank bit T TC bit V V bit	penetration  no resistance ranging to refusal 10-Oct-12 water level on date shown water inflow water outflow		moisture D dry M moist W wet S saturated Wp plastic limit WL liquid limit	

Engineering Log - Hand Auger

client: **THE LAKES (2012) LIMITED**

principal:

project: **THE LAKES, STAGE 3I GCR**

location: **CENTRE OF LOT 535**

Borehole ID. **HAL535**

sheet: 1 of 1

project no. **773-GENZTAUC13086A**

date started: **04 Oct 2017**

date completed: **04 Oct 2017**

logged by: **SBG**

checked by: **DBC**

position: Not Specified surface elevation: Not Specified angle from horizontal: 90° DCP id.:
drill model: Hand Auger drilling fluid: hole diameter : 50 mm vane id.:

drilling information				material substance									
method & support	penetration	water	samples & field tests	RL (m)	depth (m)	graphic log	classification symbol	material description	moisture condition	consistency / relative density	vane shear (kPa)	DCP (blows/100 mm)	structure and additional observations
HA	1 2 3							ORGANIC SILT: non plastic, dark brown black, trace fine grained sand.	D to M				FILL
					0.5			SAND: fine to medium grained, pale brown orange mottled white black.	M	L to D			
					0.8 m: with trace silt								
					1.6 m: with minor silt								
					2.0			Hand Auger HAL535 terminated at 2.0 m Target depth					
					2.5								
					3.0								
					3.5								
					4.0								
					4.5								

method AD auger drilling* AS auger screwing* HA hand auger W washbore HA hand auger	support M mud C casing N nil	penetration 	samples & field tests B bulk disturbed sample D disturbed sample E environmental sample SS split spoon sample U## undisturbed sample ##mm diameter HP hand penetrometer (kPa) N standard penetration test (SPT) N* SPT - sample recovered Nc SPT with solid cone VS vane shear; peak/remoulded (kPa) R refusal HB hammer bouncing	classification symbol & soil description based on Unified Classification System	consistency / relative density VS very soft S soft F firm St stiff VSt very stiff H hard Fb friable VL very loose L loose MD medium dense D dense VD very dense
moisture D dry M moist W wet S saturated Wp plastic limit WL liquid limit					

* bit shown by suffix
e.g.
AD/T
B blank bit
T TC bit
V V bit

Engineering Log - Hand Auger

client: **THE LAKES (2012) LIMITED**

principal:

project: **THE LAKES, STAGE 3I GCR**

location: **BOUNDARY OF LOT 535 AND 536**

Borehole ID. **HAL535-536**

sheet: 1 of 1

project no. **773-GENZTAUC13086A**

date started: **04 Oct 2017**

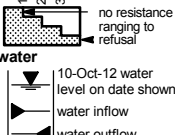
date completed: **04 Oct 2017**

logged by: **PRM**

checked by: **DBC**

position: Not Specified surface elevation: Not Specified angle from horizontal: 90° DCP id.:
drill model: Hand Auger drilling fluid: hole diameter : 50 mm vane id.: 4523

drilling information				material substance									
method & support	penetration	water	samples & field tests	RL (m)	depth (m)	graphic log	classification symbol	material description	moisture condition	consistency / relative density	vane shear (kPa)	DCP (blows/100 mm)	structure and additional observations
1 2 3	1 2 3							ORGANIC SILT: non plastic, dark brown-black.	D to M				TOPSOIL
			VS UTP		0.5			SILTY SAND: fine to medium grained, white-grey mottled pale orange, with trace clay.	M	MD			MATUA SUBGROUP
					1.0								
					1.5			CLAYEY SAND: fine to medium grained, white mottled pale orange/dark brown, clay is slightly plastic.		L			
					2.0			Hand Auger HAL535-536 terminated at 2.0 m Target depth					
					2.5								
					3.0								
					3.5								
					4.0								
					4.5								

method AD auger drilling* AS auger screwing* HA hand auger W washbore HA hand auger	support M mud C casing N nil	samples & field tests B bulk disturbed sample D disturbed sample E environmental sample SS split spoon sample U## undisturbed sample ##mm diameter HP hand penetrometer (kPa) N standard penetration test (SPT) N* SPT - sample recovered Nc SPT with solid cone VS vane shear; peak/remoulded (kPa) R refusal HB hammer bouncing	classification symbol & soil description based on Unified Classification System	consistency / relative density VS very soft S soft F firm St stiff VSt very stiff H hard Fb friable VL very loose L loose MD medium dense D dense VD very dense
* bit shown by suffix e.g. AD/T B blank bit T TC bit V V bit	penetration 		moisture D dry M moist W wet S saturated Wp plastic limit WL liquid limit	

Engineering Log - Hand Auger

client: **THE LAKES (2012) LIMITED**

principal:

project: **THE LAKES, STAGE 3I GCR**

location: **CENTRE OF LOT 536**

Borehole ID. **HAL536**

sheet: 1 of 1

project no. **773-GENZTAUC13086A**

date started: **04 Oct 2017**

date completed: **04 Oct 2017**

logged by: **ODS**

checked by: **DBC**

position: Not Specified surface elevation: Not Specified angle from horizontal: 90° DCP id.:
drill model: Hand Auger drilling fluid: hole diameter : 50 mm vane id.: SL588

drilling information				material substance									
method & support	penetration	water	samples & field tests	RL (m)	depth (m)	graphic log	classification symbol	material description	moisture condition	consistency / relative density	vane shear (kPa)	DCP (blows/100 mm)	structure and additional observations
HA	1		VS 193/40 kPa		0.5			ORGANIC SILT: non plastic, dark brown-black.	D to M				TOPSOIL
	2				1.0			Clayey SILT: low plasticity, orange-brown mottled brown/dark brown, with trace fine to medium grained sand.	M	VSt			FILL
	3				1.5			SAND: fine to coarse grained, grey, with minor silt, and trace subrounded fine grained gravel. 0.8 m: becoming fine grained with some silt, gravel absent		MD			
					2.0			Hand Auger HAL536 terminated at 2.0 m Target depth					
					2.5								
					3.0								
					3.5								
					4.0								
					4.5								

method AD auger drilling* AS auger screwing* HA hand auger W washbore HA hand auger	support M mud C casing N nil	penetration 	samples & field tests B bulk disturbed sample D disturbed sample E environmental sample SS split spoon sample U## undisturbed sample ##mm diameter HP hand penetrometer (kPa) N standard penetration test (SPT) N* SPT - sample recovered Nc SPT with solid cone VS vane shear; peak/remoulded (kPa) R refusal HB hammer bouncing	classification symbol & soil description based on Unified Classification System	consistency / relative density VS very soft S soft F firm St stiff VSt very stiff H hard Fb friable VL very loose L loose MD medium dense D dense VD very dense
moisture D dry M moist W wet S saturated Wp plastic limit WL liquid limit					

* bit shown by suffix
e.g.
AD/T
B blank bit
T TC bit
V V bit

Engineering Log - Hand Auger

client: **THE LAKES (2012) LIMITED**

principal:

project: **THE LAKES, STAGE 3I GCR**

location: **BOUNDARY OF LOT 536 AND 537**

Borehole ID. **HAL536-537**

sheet: 1 of 1

project no. **773-GENZTAUC13086A**

date started: **04 Oct 2017**

date completed: **04 Oct 2017**

logged by: **ODS**

checked by: **DBC**

position: Not Specified surface elevation: Not Specified angle from horizontal: 90° DCP id.:
drill model: Hand Auger drilling fluid: hole diameter : 50 mm vane id.: SL588

drilling information				material substance									
method & support	penetration	water	samples & field tests	RL (m)	depth (m)	graphic log	classification symbol	material description	moisture condition	consistency / relative density	vane shear (kPa)	DCP (blows/100 mm)	structure and additional observations
HA	1		VS UTP					ORGANIC SILT: non plastic, dark brown-black.	D to M				TOPSOIL
	2				0.5			SILT: low plasticity, orange-brown mottled brown, with minor clay and trace fine to coarse grained sand.	M	H			FILL
	3							SAND: fine to medium grained, brown mottled grey, with minor silt.	M to W	MD to D			
					1.0			SAND: fine to medium grained, pale grey, with minor silt.					
					1.5								
					2.0			Hand Auger HAL536-537 terminated at 2.0 m Target depth					
					2.5								
					3.0								
					3.5								
					4.0								
					4.5								

method AD auger drilling* AS auger screwing* HA hand auger W washbore HA hand auger	support M mud C casing N nil	samples & field tests B bulk disturbed sample D disturbed sample E environmental sample SS split spoon sample U## undisturbed sample ##mm diameter HP hand penetrometer (kPa) N standard penetration test (SPT) N* SPT - sample recovered Nc SPT with solid cone VS vane shear; peak/remoulded (kPa) R refusal HB hammer bouncing	classification symbol & soil description based on Unified Classification System	consistency / relative density VS very soft S soft F firm St stiff VSt very stiff H hard Fb friable VL very loose L loose MD medium dense D dense VD very dense
* bit shown by suffix e.g. AD/T B blank bit T TC bit V V bit	penetration 		moisture D dry M moist W wet S saturated Wp plastic limit Wl liquid limit	

Engineering Log - Hand Auger

client: **THE LAKES (2012) LIMITED**

principal:

project: **THE LAKES, STAGE 3I GCR**

location: **CENTRE OF LOT 537**

Borehole ID. **HAL537**

sheet: 1 of 1

project no. **773-GENZTAUC13086A**

date started: **06 Oct 2017**

date completed: **06 Oct 2017**

logged by: **SBG**

checked by: **DBC**

position: Not Specified surface elevation: Not Specified angle from horizontal: 90° DCP id.:
drill model: Hand Auger drilling fluid: hole diameter : 50 mm vane id.:

drilling information				material substance									
method & support	penetration	water	samples & field tests	RL (m)	depth (m)	graphic log	classification symbol	material description	moisture condition	consistency / relative density	vane shear (kPa)	DCP (blows/100 mm)	structure and additional observations
HA	1							ORGANIC SILT: non plastic to low plasticity, dark brown black mottled orange white.	D to M				TOPSOIL
	2				0.5			SAND: fine to medium grained, pale brown orange mottled white black, trace silt.	M	L to MD			FILL
	3				1.0			0.6 m: becoming pale brown mottled white black					
					1.5			SAND: fine to medium grained, pale brown mottled white black, some silt.					TE RANGA IGNIMBRITE
					2.0			Hand Auger HAL537 terminated at 2.0 m Target depth					
					2.5								
					3.0								
					3.5								
					4.0								
					4.5								

method AD auger drilling* AS auger screwing* HA hand auger W washbore HA hand auger	support M mud C casing N nil	samples & field tests B bulk disturbed sample D disturbed sample E environmental sample SS split spoon sample U## undisturbed sample ##mm diameter HP hand penetrometer (kPa) N standard penetration test (SPT) N* SPT - sample recovered Nc SPT with solid cone VS vane shear; peak/remoulded (kPa) R refusal HB hammer bouncing	classification symbol & soil description based on Unified Classification System	consistency / relative density VS very soft S soft F firm St stiff VSt very stiff H hard Fb friable VL very loose L loose MD medium dense D dense VD very dense
* bit shown by suffix e.g. AD/T B blank bit T TC bit V V bit	penetration 		moisture D dry M moist W wet S saturated Wp plastic limit WI liquid limit	

Engineering Log - Hand Auger

client: **THE LAKES (2012) LIMITED**

principal:

project: **THE LAKES, STAGE 3I GCR**

location: **BOUNDARY OF LOT 537 AND 538**

Borehole ID. **HAL537-538**

sheet: 1 of 1

project no. **773-GENZTAUC13086A**

date started: **04 Oct 2017**

date completed: **04 Oct 2017**

logged by: **ODS**

checked by: **DBC**

position: Not Specified surface elevation: Not Specified angle from horizontal: 90° DCP id.:
drill model: Hand Auger drilling fluid: hole diameter : 50 mm vane id.: SL588

drilling information				material substance									
method & support	penetration	water	samples & field tests	RL (m)	depth (m)	graphic log	classification symbol	material description	moisture condition	consistency / relative density	vane shear (kPa)	DCP (blows/100 mm)	structure and additional observations
HA	1							ORGANIC SILT: non plastic, black.	D to M				TOPSOIL
	2		VS 150/36 kPa		0.5			SILT: low plasticity, orange brown, minor clay, trace fine grained sand.	M	VSt			FILL
	3		VS 92/31 kPa		1.0			0.9 m: becoming mottled brown with trace fine to medium grained sand 1.0 m: with some fine to medium grained sand		St			
			VS 136/31 kPa		1.5			SAND: fine to medium grained, brown, minor silt. 1.4 m: becoming grey brown		L to MD			
					2.0			SAND: fine to medium grained, grey, minor to some silt.	M to W				
					2.5			Hand Auger HAL537-538 terminated at 2.0 m Target depth					
					3.0								
					3.5								
					4.0								
					4.5								

method AD auger drilling* AS auger screwing* HA hand auger W washbore HA hand auger	support M mud C casing N nil	samples & field tests B bulk disturbed sample D disturbed sample E environmental sample SS split spoon sample U## undisturbed sample ##mm diameter HP hand penetrometer (kPa) N standard penetration test (SPT) N* SPT - sample recovered Nc SPT with solid cone VS vane shear; peak/remoulded (kPa) R refusal HB hammer bouncing	classification symbol & soil description based on Unified Classification System	consistency / relative density VS very soft S soft F firm St stiff VSt very stiff H hard Fb friable VL very loose L loose MD medium dense D dense VD very dense
* bit shown by suffix e.g. AD/T B blank bit T TC bit V V bit	penetration  no resistance ranging to refusal 10-Oct-12 water level on date shown water inflow water outflow		moisture D dry M moist W wet S saturated Wp plastic limit Wl liquid limit	

Engineering Log - Hand Auger

client: **THE LAKES (2012) LIMITED**

principal:

project: **THE LAKES, STAGE 3I GCR**

location: **CENTRE OF LOT 538**

Borehole ID. **HAL538**

sheet: 1 of 1

project no. **773-GENZTAUC13086A**

date started: **04 Oct 2017**

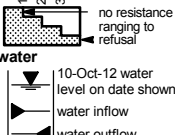
date completed: **04 Oct 2017**

logged by: **SBG**

checked by: **DBC**

position: Not Specified surface elevation: Not Specified angle from horizontal: 90° DCP id.:
drill model: Hand Auger drilling fluid: hole diameter : 50 mm vane id.:

drilling information				material substance									
method & support	penetration	water	samples & field tests	RL (m)	depth (m)	graphic log	classification symbol	material description	moisture condition	consistency / relative density	vane shear (kPa)	DCP (blows/100 mm)	structure and additional observations
1 2 3	1 2 3							ORGANIC SILT: non plastic, dark brown mottled black orange.	D to M				TOPSOIL
					0.5			SAND: fine to medium grained, pale brown grey mottled white black, minor silt.	M	MD			FILL
					1.0								
					1.5								
					2.0			Hand Auger HAL538 terminated at 2.0 m Target depth					
					2.5								
					3.0								
					3.5								
					4.0								
					4.5								

method AD auger drilling* AS auger screwing* HA hand auger W washbore HA hand auger	support M mud C casing N nil	samples & field tests B bulk disturbed sample D disturbed sample E environmental sample SS split spoon sample U## undisturbed sample ##mm diameter HP hand penetrometer (kPa) N standard penetration test (SPT) N* SPT - sample recovered Nc SPT with solid cone VS vane shear; peak/remoulded (kPa) R refusal HB hammer bouncing	classification symbol & soil description based on Unified Classification System	consistency / relative density VS very soft S soft F firm St stiff VSt very stiff H hard Fb friable VL very loose L loose MD medium dense D dense VD very dense
* bit shown by suffix e.g. AD/T B blank bit T TC bit V V bit	penetration 		moisture D dry M moist W wet S saturated Wp plastic limit Wl liquid limit	

Engineering Log - Hand Auger

client: **THE LAKES (2012) LIMITED**

principal:

project: **THE LAKES, STAGE 3I GCR**

location: **BOUNDARY OF LOT 538 AND 539**

Borehole ID. **HAL538-539**

sheet: 1 of 1

project no. **773-GENZTAUC13086A**

date started: **05 Oct 2017**

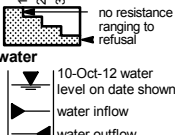
date completed: **05 Oct 2017**

logged by: **SBG**

checked by: **DBC**

position: Not Specified surface elevation: Not Specified angle from horizontal: 90° DCP id.:
drill model: Hand Auger drilling fluid: hole diameter : 50 mm vane id.:

drilling information				material substance									
method & support	penetration	water	samples & field tests	RL (m)	depth (m)	graphic log	classification symbol	material description	moisture condition	consistency / relative density	vane shear (kPa)	DCP (blows/100 mm)	structure and additional observations
1 2 3	1 2 3							ORGANIC SILT: non plastic, dark brown black mottled orange.	D to M				TOPSOIL
					0.5			SAND: fine to medium grained, pale brown orange, minor silt.	M	L to MD			FILL
					1.0			0.6 m: becoming pale brown mottled black white orange					
					1.5								
					2.0			Hand Auger HAL538-539 terminated at 2.0 m Target depth					
					2.5								
					3.0								
					3.5								
					4.0								
					4.5								

method AD auger drilling* AS auger screwing* HA hand auger W washbore HA hand auger	support M mud C casing N nil	samples & field tests B bulk disturbed sample D disturbed sample E environmental sample SS split spoon sample U## undisturbed sample ##mm diameter HP hand penetrometer (kPa) N standard penetration test (SPT) N* SPT - sample recovered Nc SPT with solid cone VS vane shear; peak/remoulded (kPa) R refusal HB hammer bouncing	classification symbol & soil description based on Unified Classification System	consistency / relative density VS very soft S soft F firm St stiff VSt very stiff H hard Fb friable VL very loose L loose MD medium dense D dense VD very dense
* bit shown by suffix e.g. AD/T B blank bit T TC bit V V bit	penetration 		moisture D dry M moist W wet S saturated Wp plastic limit Wl liquid limit	

Engineering Log - Hand Auger

client: **THE LAKES (2012) LIMITED**

principal:

project: **THE LAKES, STAGE 3I GCR**

location: **CENTRE OF LOT 540**

Borehole ID. **HAL540**

sheet: 1 of 1

project no. **773-GENZTAUC13086A**

date started: **06 Oct 2017**

date completed: **06 Oct 2017**

logged by: **SBG**

checked by: **DBC**

position: Not Specified surface elevation: Not Specified angle from horizontal: 90° DCP id.:
drill model: Hand Auger drilling fluid: hole diameter : 50 mm vane id.:

drilling information					material substance								
method & support	penetration	water	samples & field tests	RL (m)	depth (m)	graphic log	classification symbol	material description	moisture condition	consistency / relative density	vane shear ⊕ remoulded ⊙ peak (kPa)	DCP (blows/ 100 mm)	structure and additional observations
HA N	1	Not Encountered			0.5			ORGANIC SILT: low plasticity, dark brown black.	D to M		60	2	TOPSOIL
							SAND: fine to medium grained, pale grey brown, trace silt.	M	MD	100	4	FILL	
							0.9 m: with trace clay			150	6		
							SILTY SAND: fine to medium grained, brown grey mottled dark brown, trace clay.			200	8		
					2.0			SAND: fine to medium grained, pale grey brown.			2	10	
				2.5							4		
				3.0							6		
				3.5							8		
					4.0								
				4.5									
					4.5								
method AD auger drilling* AS auger screwing* HA hand auger W washbore HA hand auger	support M mud C casing N nil	penetration 	samples & field tests B bulk disturbed sample D disturbed sample E environmental sample SS split spoon sample U## undisturbed sample ##mm diameter HP hand penetrometer (kPa) N standard penetration test (SPT) N* SPT - sample recovered Nc SPT with solid cone VS vane shear; peak/remoulded (kPa) R refusal HB hammer bouncing	classification symbol & soil description based on Unified Classification System	consistency / relative density VS very soft S soft F firm St stiff VSt very stiff H hard Fb friable VL very loose L loose MD medium dense D dense VD very dense
moisture D dry M moist W wet S saturated Wp plastic limit WL liquid limit					

* bit shown by suffix
e.g.
AD/T
B blank bit
T TC bit
V V bit

Engineering Log - Hand Auger

client: **THE LAKES (2012) LIMITED**

principal:

project: **THE LAKES, STAGE 3I GCR**

location: **BOUNDARY OF LOT 540 AND 541**

Borehole ID. **HAL540-541**

sheet: 1 of 1

project no. **773-GENZTAUC13086A**

date started: **05 Oct 2017**

date completed: **05 Oct 2017**

logged by: **PRM**

checked by: **DBC**

position: Not Specified surface elevation: Not Specified angle from horizontal: 90° DCP id.:
drill model: Hand Auger drilling fluid: hole diameter : 50 mm vane id.:

drilling information				material substance									
method & support	penetration	water	samples & field tests	RL (m)	depth (m)	graphic log	classification symbol	material description	moisture condition	consistency / relative density	vane shear (kPa)	DCP (blows/100 mm)	structure and additional observations
HA	1							ORGANIC SILT: non plastic, dark brown-black.	D to M				TOPSOIL
	2				0.5			SILTY SAND: fine grained, pale grey-white.	M	D			FILL
	3				1.0					MD to D			
					1.5					D			
					2.0			Hand Auger HAL540-541 terminated at 2.0 m Target depth					
					2.5								
					3.0								
					3.5								
					4.0								
					4.5								

method AD auger drilling* AS auger screwing* HA hand auger W washbore HA hand auger	support M mud C casing N nil	samples & field tests B bulk disturbed sample D disturbed sample E environmental sample SS split spoon sample U## undisturbed sample ##mm diameter HP hand penetrometer (kPa) N standard penetration test (SPT) N* SPT - sample recovered Nc SPT with solid cone VS vane shear; peak/remoulded (kPa) R refusal HB hammer bouncing	classification symbol & soil description based on Unified Classification System	consistency / relative density VS very soft S soft F firm St stiff VSt very stiff H hard Fb friable VL very loose L loose MD medium dense D dense VD very dense
* bit shown by suffix e.g. AD/T B blank bit T TC bit V V bit	penetration 		moisture D dry M moist W wet S saturated Wp plastic limit WL liquid limit	

Engineering Log - Hand Auger

client: **THE LAKES (2012) LIMITED**

principal:

project: **THE LAKES, STAGE 3I GCR**

location: **WESTERN CORNER OF LOT 540**

Borehole ID. **HAL540C**

sheet: 1 of 1

project no. **773-GENZTAUC13086A**

date started: **05 Oct 2017**

date completed: **05 Oct 2017**

logged by: **ODS**

checked by: **DBC**

position: Not Specified surface elevation: Not Specified angle from horizontal: 90° DCP id.:
drill model: Hand Auger drilling fluid: hole diameter : 50 mm vane id.: SL588

drilling information					material substance								
method & support	penetration	water	samples & field tests	RL (m)	depth (m)	graphic log	classification symbol	material description	moisture condition	consistency / relative density	vane shear ⊕ remoulded ⊙ peak (kPa)	DCP (blows/ 100 mm)	structure and additional observations
HA	1 2 3							SILTY SAND: fine to coarse grained, orange brown mottled grey.	M	L to MD			FILL
		Not Encountered	VS 114/ 34 kPa		0.5			0.5 m: becomes brown					
			VS 117/ 31 kPa		1.0								
			VS 113/ 31 kPa		1.5			Sandy SILT: non plastic, grey, with trace clay. Sand is fine to medium grained.	W	VSt			
					2.0			Hand Auger HAL540C terminated at 2.0 m Target depth					
					2.5								
					3.0								
					3.5								
					4.0								
					4.5								

method AD auger drilling* AS auger screwing* HA hand auger W washbore HA hand auger * bit shown by suffix e.g. AD/T B blank bit T TC bit V V bit	support M mud C casing penetration water 	samples & field tests B bulk disturbed sample D disturbed sample E environmental sample SS split spoon sample U## undisturbed sample ##mm diameter HP hand penetrometer (kPa) N standard penetration test (SPT) N* SPT - sample recovered Nc SPT with solid cone VS vane shear; peak/remoulded (kPa) R refusal HB hammer bouncing	classification symbol & soil description based on Unified Classification System moisture D dry M moist W wet S saturated Wp plastic limit WL liquid limit	consistency / relative density VS very soft S soft F firm St stiff VSt very stiff H hard Fb friable VL very loose L loose MD medium dense D dense VD very dense
---	---	--	---	--

Engineering Log - Hand Auger

client: **THE LAKES (2012) LIMITED**

principal:

project: **THE LAKES, STAGE 3I GCR**

location: **BOUNDARY OF LOT 541 AND 542**

Borehole ID. **HAL541-542**

sheet: 1 of 1

project no. **773-GENZTAUC13086A**

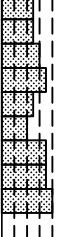
date started: **05 Oct 2017**

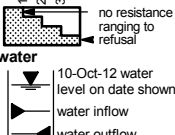
date completed: **05 Oct 2017**

logged by: **SBG**

checked by: **DBC**

position: Not Specified surface elevation: Not Specified angle from horizontal: 90° DCP id.:
drill model: Hand Auger drilling fluid: hole diameter : 50 mm vane id.:

drilling information							material substance									
method & support	penetration			water	samples & field tests	RL (m)	depth (m)	graphic log	classification symbol	material description	moisture condition	consistency / relative density	vane shear ⊕ remoulded ⊙ peak (kPa)	DCP (blows/ 100 mm)	structure and additional observations	
HA N	1	2	3	Not Encountered			0.5			ORGANIC SILT: non plastic, dark brown black, trace fine to medium grained sand.	D to M				TOPSOIL	
									M	MD	SILTY SAND: fine to medium grained, pale grey brown.					FILL
											SAND: fine to medium grained, pale grey.					TE RANGA IGNIMBRITE
							2.0			Hand Auger HAL541-542 terminated at 2.0 m Target depth						
							2.5									
							3.0									
							3.5									
							4.0									
							4.5									

method AD auger drilling* AS auger screwing* HA hand auger W washbore HA hand auger	support M mud C casing N nil	samples & field tests B bulk disturbed sample D disturbed sample E environmental sample SS split spoon sample U## undisturbed sample ##mm diameter HP hand penetrometer (kPa) N standard penetration test (SPT) N* SPT - sample recovered Nc SPT with solid cone VS vane shear; peak/remoulded (kPa) R refusal HB hammer bouncing	classification symbol & soil description based on Unified Classification System	consistency / relative density VS very soft S soft F firm St stiff VSt very stiff H hard Fb friable VL very loose L loose MD medium dense D dense VD very dense
* bit shown by suffix e.g. AD/T B blank bit T TC bit V V bit	penetration  no resistance ranging to refusal 10-Oct-12 water level on date shown water inflow water outflow		moisture D dry M moist W wet S saturated Wp plastic limit Wl liquid limit	

Engineering Log - Hand Auger

client: **THE LAKES (2012) LIMITED**

principal:

project: **THE LAKES, STAGE 3I GCR**

location: **CENTRE OF LOT 542**

Borehole ID. **HAL542**

sheet: 1 of 1

project no. **773-GENZTAUC13086A**

date started: **05 Oct 2017**

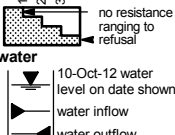
date completed: **05 Oct 2017**

logged by: **ODS**

checked by: **DBC**

position: Not Specified surface elevation: Not Specified angle from horizontal: 90° DCP id.:
drill model: Hand Auger drilling fluid: hole diameter : 50 mm vane id.: SL588

drilling information					material substance								structure and additional observations	
method & support	penetration	water	samples & field tests	RL (m)	depth (m)	graphic log	classification symbol	material description	moisture condition	consistency / relative density	vane shear ⊕ remoulded ⊙ peak (kPa)	DCP (blows/ 100 mm)		
HA N	1	Not Encountered	VS >213 kPa		0.5			ORGANIC SILT: non plastic, black.	D to M		50	2	TOPSOIL	
	0.7 m: with minor fine to medium grained sand				M	H	100	⊙	FILL					
							150	⊕						
			VS >213 kPa		1.0			SAND: fine to medium grained, brown grey, with trace to minor silt.	MD to D		200	10	TE RANGA IGNIMBRITE	
					1.5			1.3 m: becomes pale grey with trace fine subrounded pumiceous gravel						
					2.0									
					2.5									
					3.0			Hand Auger HAL542 terminated at 3.0 m Target depth						
					3.5									
					4.0									
					4.5									

method AD auger drilling* AS auger screwing* HA hand auger W washbore HA hand auger	support M mud C casing N nil	samples & field tests B bulk disturbed sample D disturbed sample E environmental sample SS split spoon sample U## undisturbed sample ##mm diameter HP hand penetrometer (kPa) N standard penetration test (SPT) N* SPT - sample recovered Nc SPT with solid cone VS vane shear; peak/remoulded (kPa) R refusal HB hammer bouncing	classification symbol & soil description based on Unified Classification System	consistency / relative density VS very soft S soft F firm St stiff VSt very stiff H hard Fb friable VL very loose L loose MD medium dense D dense VD very dense
* bit shown by suffix e.g. AD/T B blank bit T TC bit V V bit	penetration 		moisture D dry M moist W wet S saturated Wp plastic limit Wl liquid limit	

Engineering Log - Hand Auger

client: **THE LAKES (2012) LIMITED**

principal:

project: **THE LAKES, STAGE 3I GCR**

location: **WESTERN BOUNDARY OF LOT 542 AND 543**

Borehole ID. **HAL542-543**

sheet: 1 of 1

project no. **773-GENZTAUC13086A**

date started: **05 Oct 2017**

date completed: **05 Oct 2017**

logged by: **SBG**

checked by: **DBC**

position: Not Specified surface elevation: Not Specified angle from horizontal: 90° DCP id.:
drill model: Hand Auger drilling fluid: hole diameter : 50 mm vane id.: SL817

drilling information					material substance									
method & support	penetration		water	samples & field tests	RL (m)	depth (m)	graphic log	classification symbol	material description	moisture condition	consistency / relative density	vane shear ⊕ remoulded ⊙ peak (kPa)	DCP (blows/ 100 mm)	structure and additional observations
HA N	1	2		VS 158/ 42 kPa		0.5			ORGANIC SILT: low plasticity, dark brown black mottled orange.	D to M		⊕	⊙	TOPSOIL
				VS >247 kPa					Clayey SILT: low to medium plasticity, orange brown, trace fine to medium grained sand.	M				FILL
						1.0			SAND: fine to medium grained, pale grey brown.		L to MD			
			Not Encountered			2.0								
						2.5								
						3.0			Hand Auger HAL542-543 terminated at 3.0 m Target depth					
						3.5								
						4.0								
						4.5								

method AD auger drilling* AS auger screwing* HA hand auger W washbore HA hand auger * bit shown by suffix e.g. B blank bit T TC bit V V bit	support M mud C casing penetration 10-Oct-12 water level on date shown water inflow water outflow	samples & field tests B bulk disturbed sample D disturbed sample E environmental sample SS split spoon sample U## undisturbed sample ##mm diameter HP hand penetrometer (kPa) N standard penetration test (SPT) N* SPT - sample recovered Nc SPT with solid cone VS vane shear; peak/remoulded (kPa) R refusal HB hammer bouncing	classification symbol & soil description based on Unified Classification System moisture D dry M moist W wet S saturated Wp plastic limit Wl liquid limit	consistency / relative density VS very soft S soft F firm St stiff VSt very stiff H hard Fb friable VL very loose L loose MD medium dense D dense VD very dense
--	---	--	---	--

Engineering Log - Hand Auger

client: **THE LAKES (2012) LIMITED**

principal:

project: **THE LAKES, STAGE 3I GCR**

location: **CENTRE OF LOT 543**

Borehole ID. **HAL543**

sheet: 1 of 1

project no. **773-GENZTAUC13086A**

date started: **05 Oct 2017**

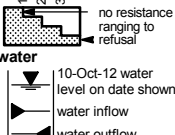
date completed: **05 Oct 2017**

logged by: **PRM**

checked by: **DBC**

position: Not Specified surface elevation: Not Specified angle from horizontal: 90° DCP id.:
drill model: Hand Auger drilling fluid: hole diameter : vane id.: 4523

drilling information					material substance																
method & support	penetration		water	samples & field tests	RL (m)	depth (m)	graphic log	classification symbol	material description	moisture condition	consistency / relative density	vane shear ⊕ remoulded ⊙ peak (kPa)	DCP (blows/100 mm)	structure and additional observations							
	1	2 3																			
			Not Encountered	VS >224 kPa		0.5			ORGANIC SILT: non plastic, dark brown-black.	D to M	H	 	                        	TOPSOIL							
				VS >224 kPa		1.0			Clayey SILT: low plasticity, brown mottled orange-brown/pale brown, with minor fine grained sand. Clayey SILT: low to medium plasticity, white, with trace fine grained sand. Clayey SILT: low plasticity, brown mottled orange-brown/pale brown, with minor fine grained sand. SAND: fine grained, pale grey-brown, with minor silt and trace clay.	M					L to D	 	FILL				
				VS >224 kPa		1.5			Clayey SILT: low plasticity, brown mottled orange-brown/pale brown, with minor fine grained sand. SAND: fine grained, pale grey-brown, with minor silt and trace clay.	MD	 										
				VS 73/ 22 kPa		2.0			Clayey SILT: non plastic, pale grey-brown, with minor fine grained sand.			St to H	 								
				VS >224 kPa		2.5															
												3.0			Hand Auger HAL543 terminated at 3.0 m Target depth						
													3.5								
						4.0															
						4.5															

method AD auger drilling* AS auger screwing* HA hand auger W washbore HA hand auger	support M mud C casing N nil	penetration  10-Oct-12 water level on date shown water inflow water outflow	samples & field tests B bulk disturbed sample D disturbed sample E environmental sample SS split spoon sample U## undisturbed sample ##mm diameter HP hand penetrometer (kPa) N standard penetration test (SPT) N* SPT - sample recovered Nc SPT with solid cone VS vane shear; peak/remoulded (kPa) R refusal HB hammer bouncing	classification symbol & soil description based on Unified Classification System moisture D dry M moist W wet S saturated Wp plastic limit WL liquid limit	consistency / relative density VS very soft S soft F firm St stiff VSt very stiff H hard Fb friable VL very loose L loose MD medium dense D dense VD very dense
---	--	---	--	---	--

* bit shown by suffix
e.g.
AD/T
B blank bit
T TC bit
V V bit

Engineering Log - Hand Auger

client: **THE LAKES (2012) LIMITED**

principal:

project: **THE LAKES, STAGE 3I GCR**

location: **WESTERN BOUNDARY OF LOT 543 AND 544**

Borehole ID. **HAL543-544**

sheet: 1 of 1

project no. **773-GENZTAUC13086A**

date started: **05 Oct 2017**

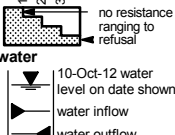
date completed: **05 Oct 2017**

logged by: **ODS**

checked by: **DBC**

position: Not Specified surface elevation: Not Specified angle from horizontal: 90° DCP id.:
drill model: Hand Auger drilling fluid: hole diameter : 50 mm vane id.: SL588

drilling information				material substance									
method & support	penetration	water	samples & field tests	RL (m)	depth (m)	graphic log	classification symbol	material description	moisture condition	consistency / relative density	vane shear (kPa)	DCP (blows/100 mm)	structure and additional observations
HA	1		VS >213 kPa		0.5			ORGANIC SILT: non plastic, black.	D to M				TOPSOIL
	2							SILT: non plastic to low plasticity, grey mottled orange brown and brown, with minor fine to medium grained sand and with trace clay.	H				FILL
	3				1.0			SAND: fine to medium grained, brown grey, with minor silt.	D				
			VS >213 kPa		1.5			SILT: non plastic to low plasticity, orange brown mottled grey, with trace to minor fine to medium grained sand.	H				POST ROTOEHU ASH
								SILT: non plastic, orange brown, with trace fine to medium grained sand and with trace clay.	MD				ROTOEHU ASH
					2.0			SAND: fine to medium grained, brown, with trace silt.					
					2.0			Hand Auger HAL543-544 terminated at 2.0 m Target depth					
					2.5								
					3.0								
					3.5								
					4.0								
					4.5								

method AD auger drilling* AS auger screwing* HA hand auger W washbore HA hand auger	support M mud C casing N nil	penetration 	samples & field tests B bulk disturbed sample D disturbed sample E environmental sample SS split spoon sample U## undisturbed sample ##mm diameter HP hand penetrometer (kPa) N standard penetration test (SPT) N* SPT - sample recovered Nc SPT with solid cone VS vane shear; peak/remoulded (kPa) R refusal HB hammer bouncing	classification symbol & soil description based on Unified Classification System	consistency / relative density VS very soft S soft F firm St stiff VSt very stiff H hard Fb friable VL very loose L loose MD medium dense D dense VD very dense
moisture D dry M moist W wet S saturated Wp plastic limit WL liquid limit					

* bit shown by suffix
e.g.
AD/T
B blank bit
T TC bit
V V bit

Engineering Log - Hand Auger

client: **THE LAKES (2012) LIMITED**

principal:

project: **THE LAKES, STAGE 3I GCR**

location: **CENTRE OF LOT 544**

Borehole ID. **HAL544**

sheet: 1 of 1

project no. **773-GENZTAUC13086A**

date started: **05 Oct 2017**

date completed: **05 Oct 2017**

logged by: **SBG**

checked by: **DBC**

position: Not Specified surface elevation: Not Specified angle from horizontal: 90° DCP id.:
drill model: Hand Auger drilling fluid: hole diameter : 50 mm vane id.: SL817

drilling information				material substance								structure and additional observations	
method & support	penetration	water	samples & field tests	RL (m)	depth (m)	graphic log	classification symbol	material description	moisture condition	consistency / relative density	vane shear (kPa)	DCP (blows/100 mm)	
1 2 3	1 2 3							ORGANIC SILT: non plastic to low plasticity, dark brown black, trace fine to medium grained sand.	D to M				TOPSOIL
			VS 247 kPa		0.5			Sandy SILT: low plasticity, brown orange mottled white black. 0.5 m: becoming slightly to moderately plastic	M	VSt to H			FILL
			VS 196/66 kPa		1.0			SILTY SAND: fine to medium grained, brown grey mottled orange dark brown.		MD to D			
					1.5			1.6 m: becoming grey mottled orange					
					2.0			2.0 m: becoming orange grey mottled brown	W				
					2.5				S				
					3.0			Hand Auger HAL544 terminated at 3.0 m Target depth					
					3.5								
					4.0								
					4.5								

method AD auger drilling* AS auger screwing* HA hand auger W washbore HA hand auger	support M mud C casing N nil	samples & field tests B bulk disturbed sample D disturbed sample E environmental sample SS split spoon sample U## undisturbed sample ##mm diameter HP hand penetrometer (kPa) N standard penetration test (SPT) N* SPT - sample recovered Nc SPT with solid cone VS vane shear; peak/remoulded (kPa) R refusal HB hammer bouncing	classification symbol & soil description based on Unified Classification System	consistency / relative density VS very soft S soft F firm St stiff VSt very stiff H hard Fb friable VL very loose L loose MD medium dense D dense VD very dense
* bit shown by suffix e.g. AD/T B blank bit T TC bit V V bit	penetration  no resistance ranging to refusal 10-Oct-12 water level on date shown water inflow water outflow		moisture D dry M moist W wet S saturated Wp plastic limit Wl liquid limit	

Engineering Log - Hand Auger

client: **THE LAKES (2012) LIMITED**

principal:

project: **THE LAKES, STAGE 3I GCR**

location: **BOUNDARY OF LOT 544 AND 545**

Borehole ID. **HAL544-545**

sheet: 1 of 1

project no. **773-GENZTAUC13086A**

date started: **05 Oct 2017**

date completed: **05 Oct 2017**

logged by: **SBG**

checked by: **DBC**

position: Not Specified surface elevation: Not Specified angle from horizontal: 90° DCP id.:
drill model: Hand Auger drilling fluid: hole diameter : 50 mm vane id.:

drilling information				material substance									
method & support	penetration	water	samples & field tests	RL (m)	depth (m)	graphic log	classification symbol	material description	moisture condition	consistency / relative density	vane shear (kPa)	DCP (blows/100 mm)	structure and additional observations
1 2 3								SOIL TYPE: plasticity or particle characteristic, colour, secondary and minor components					
HA					0.5			ORGANIC SILT: low plasticity, dark brown black, trace fine grained sand.	D to M				TOPSOIL
								Sandy SILT: low plasticity, brown orange mottled grey, sand fine to medium grained.	M				FILL
					1.0			SILTY SAND: fine to medium grained, brown grey mottled dark brown.	MD				
					1.5								
					2.0			SAND: fine to medium grained, brown grey, minor silt.	S				DCP REFUSAL
					2.5								
					3.0			SAND: fine to medium grained, pale grey brown.	D				TE RANGA IGNIMBRITE
					3.5			Hand Auger HAL544-545 terminated at 3.0 m Target depth					
					4.0								
					4.5								

method AD auger drilling* AS auger screwing* HA hand auger W washbore HA hand auger	support M mud C casing N nil	samples & field tests B bulk disturbed sample D disturbed sample E environmental sample SS split spoon sample U## undisturbed sample ##mm diameter HP hand penetrometer (kPa) N standard penetration test (SPT) N* SPT - sample recovered Nc SPT with solid cone VS vane shear; peak/remoulded (kPa) R refusal HB hammer bouncing	classification symbol & soil description based on Unified Classification System	consistency / relative density VS very soft S soft F firm St stiff VSt very stiff H hard Fb friable VL very loose L loose MD medium dense D dense VD very dense
* bit shown by suffix e.g. AD/T B blank bit T TC bit V V bit	penetration 		moisture D dry M moist W wet S saturated Wp plastic limit Wl liquid limit	

Engineering Log - Hand Auger

client: **THE LAKES (2012) LIMITED**

principal:

project: **THE LAKES, STAGE 3I GCR**

location: **CENTRE OF LOT 545**

Borehole ID. **HAL545**

sheet: 1 of 1

project no. **773-GENZTAUC13086A**

date started: **05 Oct 2017**

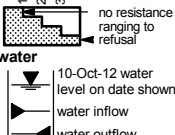
date completed: **05 Oct 2017**

logged by: **PRM**

checked by: **DBC**

position: Not Specified surface elevation: Not Specified angle from horizontal: 90° DCP id.:
drill model: Hand Auger drilling fluid: hole diameter : 50 mm vane id.: 4523

drilling information				material substance									
method & support	penetration	water	samples & field tests	RL (m)	depth (m)	graphic log	classification symbol	material description	moisture condition	consistency / relative density	vane shear (kPa)	DCP (blows/100 mm)	structure and additional observations
1 2 3	1 2 3							ORGANIC SILT: non plastic, dark brown-black.	D to M				TOPSOIL
			VS 197/ 46 kPa		0.5			Clayey SILT: low plasticity, brown mottled orange-brown/pale brown, with minor fine grained sand.	M	MD	⊕ ⊙		FILL
			VS 179/ 31 kPa		1.0			SILTY SAND: fine grained, pale orange brown.		MD	⊕ ⊙		
			VS UTP		1.5			Clayey SILT: low plasticity, brown mottled orange-brown/pale brown, with minor fine grained sand.		VSt to H	⊕ ⊙		
			VS 197/ 46 kPa		2.0			SILTY SAND: fine grained, pale orange brown.					
					2.5			Sandy SILT: non plastic, pale orange brown mottled white, sand is fine grained.	D				DCP REFUSAL
					3.0			SILTY SAND: fine grained, pale grey mottled pale orange.					
					3.5								
					4.0								
					4.5								
								Hand Auger HAL545 terminated at 3.0 m Target depth					

method AD auger drilling* AS auger screwing* HA hand auger W washbore HA hand auger	support M mud C casing N nil	penetration  10-Oct-12 water level on date shown water inflow water outflow	samples & field tests B bulk disturbed sample D disturbed sample E environmental sample SS split spoon sample U## undisturbed sample ##mm diameter HP hand penetrometer (kPa) N standard penetration test (SPT) N* SPT - sample recovered Nc SPT with solid cone VS vane shear; peak/remoulded (kPa) R refusal HB hammer bouncing	classification symbol & soil description based on Unified Classification System moisture D dry M moist W wet S saturated Wp plastic limit WL liquid limit	consistency / relative density VS very soft S soft F firm St stiff VSt very stiff H hard Fb friable VL very loose L loose MD medium dense D dense VD very dense
---	--	---	--	---	--

* bit shown by suffix
e.g.
AD/T
B blank bit
T TC bit
V V bit

Engineering Log - Hand Auger

client: **THE LAKES (2012) LIMITED**

principal:

project: **THE LAKES, STAGE 3I GCR**

location: **WESTERN BOUNDARY OF LOT 545 AND 546**

Borehole ID. **HAL545-546**

sheet: 1 of 1

project no. **773-GENZTAUC13086A**

date started: **05 Oct 2017**

date completed: **05 Oct 2017**

logged by: **ODS**

checked by: **DBC**

position: Not Specified surface elevation: Not Specified angle from horizontal: 90° DCP id.:
drill model: Hand Auger drilling fluid: hole diameter : 50 mm vane id.: SL588

drilling information					material substance								
method & support	penetration	water	samples & field tests	RL (m)	depth (m)	graphic log	classification symbol	material description	moisture condition	consistency / relative density	vane shear ⊕ remoulded ⊙ peak (kPa)	DCP (blows/ 100 mm)	structure and additional observations
HA N	1	Not Encountered	VS >213 kPa VS >213 kPa		0.5			ORGANIC SILT: non plastic, black.	D to M	H	50 100 150 200	2 4 6 8 10	TOPSOIL
	SILT: low plasticity, orange brown mottled grey and brown, with some clay and with trace fine grained sand. 0.4 m: becomes pale brown mottled grey, non plastic to slightly plastic with trace to minor clay and minor fine to medium grained sand												
	SILTY SAND: fine to medium grained, pale brown grey, with trace fine subrounded pumiceous gravel.												
					1.0				M to W	MD to VD			REFUSAL
					1.5								
					2.0			Hand Auger HAL545-546 terminated at 2.0 m Target depth					
					2.5								
					3.0								
					3.5								
					4.0								
					4.5								

method AD auger drilling* AS auger screwing* HA hand auger W washbore HA hand auger	support M mud C casing N nil	samples & field tests B bulk disturbed sample D disturbed sample E environmental sample SS split spoon sample U## undisturbed sample ##mm diameter HP hand penetrometer (kPa) N standard penetration test (SPT) N* SPT - sample recovered Nc SPT with solid cone VS vane shear; peak/remoulded (kPa) R refusal HB hammer bouncing	classification symbol & soil description based on Unified Classification System	consistency / relative density VS very soft S soft F firm St stiff VSt very stiff H hard Fb friable VL very loose L loose MD medium dense D dense VD very dense
* bit shown by suffix e.g. AD/T B blank bit T TC bit V V bit	penetration  no resistance ranging to refusal 10-Oct-12 water level on date shown water inflow water outflow		moisture D dry M moist W wet S saturated Wp plastic limit Wl liquid limit	

Engineering Log - Hand Auger

client: **THE LAKES (2012) LIMITED**

principal:

project: **THE LAKES, STAGE 3I GCR**

location: **CENTRE OF LOT 546**

Borehole ID: **HAL546**

sheet: 1 of 1

project no: **773-GENZTAUC13086AP**

date started: **05 Oct 2017**

date completed: **05 Oct 2017**

logged by: **ODS**

checked by: **DBC**

position: Not Specified surface elevation: Not Specified angle from horizontal: 90° DCP id.:
drill model: Hand Auger drilling fluid: hole diameter : 50 mm vane id.: SL588

drilling information							material substance								
method & support	penetration			water	samples & field tests	RL (m)	depth (m)	graphic log	classification symbol	material description	moisture condition	consistency / relative density	vane shear ⊕ remoulded ⊙ peak (kPa)	DCP (blows/ 100 mm)	structure and additional observations
HA N	1	2	3	Not Encountered	VS 161/ 31 kPa					ORGANIC SILT: non plastic, black.	D to M	VSt	⊕ ⊙		

method AD auger drilling* AS auger screwing* HA hand auger W washbore HA hand auger	support M mud C casing N nil	samples & field tests B bulk disturbed sample D disturbed sample E environmental sample SS split spoon sample U## undisturbed sample ##mm diameter HP hand penetrometer (kPa) N standard penetration test (SPT) N* SPT - sample recovered Nc SPT with solid cone VS vane shear; peak/remoulded (kPa) R refusal HB hammer bouncing	classification symbol & soil description based on Unified Classification System	consistency / relative density VS very soft S soft F firm St stiff VSt very stiff H hard Fb friable VL very loose L loose MD medium dense D dense VD very dense
* bit shown by suffix e.g. AD/T B blank bit T TC bit V V bit	penetration 		moisture D dry M moist W wet S saturated Wp plastic limit WL liquid limit	

Engineering Log - Hand Auger

client: **THE LAKES (2012) LIMITED**

principal:

project: **THE LAKES, STAGE 3I GCR**

location: **BOUNDARY OF LOT 546 AND 547**

Borehole ID. **HAL546-547**

sheet: 1 of 1

project no. **773-GENZTAUC13086A**

date started: **05 Oct 2017**

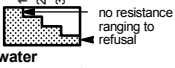
date completed: **05 Oct 2017**

logged by: **SBG**

checked by: **DBC**

position: Not Specified surface elevation: Not Specified angle from horizontal: 90° DCP id.:
drill model: Hand Auger drilling fluid: hole diameter : 50 mm vane id.:

drilling information				material substance									
method & support	penetration	water	samples & field tests	RL (m)	depth (m)	graphic log	classification symbol	material description	moisture condition	consistency / relative density	vane shear (kPa)	DCP (blows/100 mm)	structure and additional observations
HA	1				0.5			ORGANIC SILT: low plasticity, dark brown black, trace fine to medium grained sand. SILTY SAND: fine to medium grained, brown grey mottled dark brown.	D to M	L			TOPSOIL
	2				1.0			0.8 m: becoming mottled black					FILL
	3				1.5			SILTY SAND: fine to medium grained, brown mottled grey, minor clay.		L to D			TE RANGA IGNIMBRITE
					2.0			Hand Auger HAL546-547 terminated at 2.0 m Target depth					
					2.5								
					3.0								
					3.5								
					4.0								
					4.5								

method AD auger drilling* AS auger screwing* HA hand auger W washbore HA hand auger	support M mud C casing N nil	penetration  water 10-Oct-12 water level on date shown water inflow water outflow	samples & field tests B bulk disturbed sample D disturbed sample E environmental sample SS split spoon sample U## undisturbed sample ##mm diameter HP hand penetrometer (kPa) N standard penetration test (SPT) N* SPT - sample recovered Nc SPT with solid cone VS vane shear; peak/remoulded (kPa) R refusal HB hammer bouncing	classification symbol & soil description based on Unified Classification System moisture D dry M moist W wet S saturated Wp plastic limit WL liquid limit	consistency / relative density VS very soft S soft F firm St stiff VSt very stiff H hard Fb friable VL very loose L loose MD medium dense D dense VD very dense
---	--	---	--	---	--

* bit shown by suffix
e.g.
AD/T
blank bit
T TC bit
V V bit

Engineering Log - Hand Auger

client: **THE LAKES (2012) LIMITED**

principal:

project: **THE LAKES, STAGE 3I GCR**

location: **CENTRE OF LOT 547**

Borehole ID. **HAL547**

sheet: 1 of 1

project no. **773-GENZTAUC13086AP**

date started: **05 Oct 2017**

date completed: **05 Oct 2017**

logged by: **ODS**

checked by: **DBC**

position: Not Specified surface elevation: Not Specified angle from horizontal: 90° DCP id.:
drill model: Hand Auger drilling fluid: hole diameter : 50 mm vane id.: SL588

drilling information								material substance									
method & support	penetration			water	samples & field tests	RL (m)	depth (m)	graphic log	classification symbol	material description	moisture condition	consistency / relative density	vane shear ⊕ remoulded ⊙ peak (kPa)	DCP (blows/ 100 mm)	structure and additional observations		
HA	1	2	3	Not Encountered	VS UTP		0.5			ORGANIC SILT: non plastic, black.	D to M	H	VS UTP			TOPSOIL	
					Sandy SILT: non plastic, orange brown mottled grey, sand is fine to medium grained.					M							
					SILT: low plasticity, orange brown mottled grey, with minor to some clay and trace fine to medium grained sand.												
					0.9 m: becomes grey mottled grey brown with some clay and with trace fine grained sand 1.1 m: with trace to minor clay and with minor fine to medium grained sand 1.3 m: becomes orange brown mottled brown grey with minor clay and with trace fine grained sand												
				VS >213 kPa		1.0											
				VS >213 kPa		1.5											
				VS >213 kPa		2.0											
				VS >213 kPa		2.0				Hand Auger HAL547 terminated at 2.0 m Target depth							
							2.5										
							3.0										
							3.5										
							4.0										
							4.5										

method AD auger drilling* AS auger screwing* HA hand auger W washbore HA hand auger	support M mud C casing N nil	samples & field tests B bulk disturbed sample D disturbed sample E environmental sample SS split spoon sample U## undisturbed sample ##mm diameter HP hand penetrometer (kPa) N standard penetration test (SPT) N* SPT - sample recovered Nc SPT with solid cone VS vane shear; peak/remoulded (kPa) R refusal HB hammer bouncing	classification symbol & soil description based on Unified Classification System	consistency / relative density VS very soft S soft F firm St stiff VSt very stiff H hard Fb friable VL very loose L loose MD medium dense D dense VD very dense
penetration 	water 	moisture D dry M moist W wet S saturated Wp plastic limit WL liquid limit		

* bit shown by suffix
e.g.
AD/T
B blank bit
T TC bit
V V bit

Engineering Log - Hand Auger

client: **THE LAKES (2012) LIMITED**

principal:

project: **THE LAKES, STAGE 3I GCR**

location: **BOUNDARY OF LOT 547 AND 548**

Borehole ID. **HAL547-548**

sheet: 1 of 1

project no. **773-GENZTAUC13086A**

date started: **05 Oct 2017**

date completed: **05 Oct 2017**

logged by: **PRM**

checked by: **DBC**

position: Not Specified surface elevation: Not Specified angle from horizontal: 90° DCP id.:
drill model: Hand Auger drilling fluid: hole diameter : 50 mm vane id.: 4523

drilling information					material substance								
method & support	penetration	water	samples & field tests	RL (m)	depth (m)	graphic log	classification symbol	material description	moisture condition	consistency / relative density	vane shear ⊕ remoulded ⊙ peak (kPa)	DCP (blows/ 100 mm)	structure and additional observations
HA N	1	Not Encountered	VS UTP		0.5			ORGANIC SILT: non plastic, dark brown-black.	M		VS UTP		TOPSOIL
	SILTY SAND: fine to medium grained, pale orange-brown-grey, with trace clay.							D					
	VS UTP		1.0				M to W	H	VS UTP		DCP REFUSAL		
	VS >213 kPa		1.5									Clayey SILT: non plastic, brown mottled pale brown, with trace fine grained sand.	
		VS >213 kPa		2.0				Hand Auger HAL547-548 terminated at 2.0 m Target depth			⊙		
					2.5								
					3.0								
					3.5								
					4.0								
					4.5								

method AD auger drilling* AS auger screwing* HA hand auger W washbore HA hand auger	support M mud C casing N nil	samples & field tests B bulk disturbed sample D disturbed sample E environmental sample SS split spoon sample U## undisturbed sample ##mm diameter HP hand penetrometer (kPa) N standard penetration test (SPT) N* SPT - sample recovered Nc SPT with solid cone VS vane shear, peak/remoulded (kPa) R refusal HB hammer bouncing	classification symbol & soil description based on Unified Classification System	consistency / relative density VS very soft S soft F firm St stiff VSt very stiff H hard Fb friable VL very loose L loose MD medium dense D dense VD very dense
* bit shown by suffix e.g. AD/T B blank bit T TC bit V V bit	penetration  no resistance ranging to refusal 10-Oct-12 water level on date shown water inflow water outflow		moisture D dry M moist W wet S saturated Wp plastic limit WL liquid limit	

client: **THE LAKES (2012) LIMITED**

principal:

project: **THE LAKES, STAGE 3/ GCR**

location: ***CENTRE OF LOT 548***

Borehole ID. **HAL548**

sheet: 1 of 1

project no. **773-GENZTAUC13086AP**

date started: **06 Oct 2017**

date completed: **06 Oct 2017**

logged by: **PRM**

checked by: **DBC**[illegible]

Engineering Log - Hand Auger

client: **THE LAKES (2012) LIMITED**

principal:

project: **THE LAKES, STAGE 3I GCR**

location: **BOUNDARY OF LOT 548 AND 549**

Borehole ID. **HAL548-549**

sheet: 1 of 1

project no. **773-GENZTAUC13086AP**

date started: **06 Oct 2017**

date completed: **06 Oct 2017**

logged by: **SBG**

checked by: **DBC**

position: Not Specified surface elevation: Not Specified angle from horizontal: 90° DCP id.:
drill model: Hand Auger drilling fluid: hole diameter : 50 mm vane id.: SL817

drilling information							material substance										
method & support	penetration			water	samples & field tests	RL (m)	depth (m)	graphic log	classification symbol	material description	moisture condition	consistency / relative density	vane shear			DCP (blows/ 100 mm)	structure and additional observations
	1	2	3										⊕ remoulded	⊙ peak	(kPa)		
HA	N			Not Encountered			0.5			ORGANIC SILT: non plastic, dark brown black, trace clay.	D to M	H				TOPSOIL	
										Sandy SILT: low to medium plasticity, brown orange mottled pink white black, trace clay.	M						FILL
										Clayey SILT: low plasticity, brown orange mottled dark brown, trace fine to medium grained sand.							
					VS >247 kPa		1.0										
					VS >247 kPa		1.5										
					VS 213/ 42 kPa		2.0										
					VS >247 kPa		2.5										
							3.0										
							3.5										
							67.5							</			

Engineering Log - Hand Auger

client: **THE LAKES (2012) LIMITED**

principal:

project: **THE LAKES, STAGE 3I GCR**

location: **CENTRE OF LOT 549**

Borehole ID. **HAL549**

sheet: 1 of 1

project no. **773-GENZTAUC13086AP**

date started: **06 Oct 2017**

date completed: **06 Oct 2017**

logged by: **SBG**

checked by: **DBC**

position: Not Specified surface elevation: Not Specified angle from horizontal: 90° DCP id.:
drill model: Hand Auger drilling fluid: hole diameter : 50 mm vane id.: SL817

drilling information							material substance									
method & support	1 penetration	2 penetration	3 penetration	water	samples & field tests	RL (m)	depth (m)	graphic log	classification symbol	material description	moisture condition	consistency / relative density	vane shear (kPa)	DCP (blows/ 100 mm)	structure and additional observations	
HA N				Not Encountered	VS >247 kPa		0.5			ORGANIC SILT: non plastic, dark brown black.	D to M				TOPSOIL	
					VS >247 kPa					Clayey SILT: non plastic to low plasticity, brown orange mottled dark brown, trace fine to medium grained sand.	M	H				FILL
					VS >247 kPa				1.0	Sandy SILT: low to medium plasticity, brown orange, minor clay.						
					VS >247 kPa				1.5	Clayey SILT: low to medium plasticity, brown orange mottled dark brown.						
					VS >247 kPa				2.0	Hand Auger HAL549 terminated at 2.0 m Target depth						
							2.5									
							3.0									
							3.5									
							4.0									
							4.5									

method AD auger drilling* AS auger screwing* HA hand auger W washbore HA hand auger	support M mud C casing N nil	samples & field tests B bulk disturbed sample D disturbed sample E environmental sample SS split spoon sample U## undisturbed sample ##mm diameter HP hand penetrometer (kPa) N standard penetration test (SPT) N* SPT - sample recovered Nc SPT with solid cone VS vane shear; peak/remoulded (kPa) R refusal HB hammer bouncing	classification symbol & soil description based on Unified Classification System	consistency / relative density VS very soft S soft F firm St stiff VSt very stiff H hard Fb friable VL very loose L loose MD medium dense D dense VD very dense
penetration 	water 10-Oct-12 water level on date shown water inflow water outflow	moisture D dry M moist W wet S saturated Wp plastic limit WI liquid limit		

* bit shown by suffix
e.g.
AD/T
B blank bit
T TC bit
V V bit

Engineering Log - Hand Auger

client: **THE LAKES (2012) LIMITED**

principal:

project: **THE LAKES, STAGE 3I GCR**

location: **BOUNDARY OF LOT 549 AND 550**

Borehole ID. **HAL549-550**

sheet: 1 of 1

project no. **773-GENZTAUC13086AP**

date started: **06 Oct 2017**

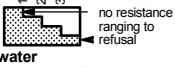
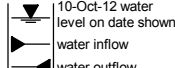
date completed: **06 Oct 2017**

logged by: **PRM**

checked by: **DBC**

position: Not Specified surface elevation: Not Specified angle from horizontal: 90° DCP id.:
drill model: Hand Auger drilling fluid: hole diameter : 50 mm vane id.: 764

drilling information					material substance									
method & support	penetration	water	samples & field tests	RL (m)	depth (m)	graphic log	classification symbol	material description	moisture condition	consistency / relative density	vane shear remoulded peak (kPa)	DCP (blows/ 100 mm)	structure and additional observations	
HA	1							ORGANIC SILT: non plastic, dark brown-black.	D to M				TOPSOIL	
	2		VS UTP		0.5			SILT: non plastic, pale orange-brown, with minor fine grained sand. 0.5 to 0.8 m: with minor clay	M	VSt to H	VS UTP		FILL	
	3		VS UTP		1.0						VS UTP			
			VS UTP		1.5			Clayey SILT: low plasticity, brown, with minor fine grained sand.			VS UTP			
			VS 197/ 46 kPa		2.0			Hand Auger HAL549-550 terminated at 2.0 m Target depth						
			VS >213 kPa		2.5									
					3.0									
					3.5									
					4.0									
					4.5									

method AD auger drilling* AS auger screwing* HA hand auger W washbore HA hand auger	support M mud C casing N nil	penetration  water 	samples & field tests B bulk disturbed sample D disturbed sample E environmental sample SS split spoon sample U## undisturbed sample ##mm diameter HP hand penetrometer (kPa) N standard penetration test (SPT) N* SPT - sample recovered Nc SPT with solid cone VS vane shear; peak/remoulded (kPa) R refusal HB hammer bouncing	classification symbol & soil description based on Unified Classification System moisture D dry M moist W wet S saturated Wp plastic limit Wl liquid limit	consistency / relative density VS very soft S soft F firm St stiff VSt very stiff H hard Fb friable VL very loose L loose MD medium dense D dense VD very dense
---	--	--	--	---	--

* bit shown by suffix
e.g.
AD/T
B blank bit
T TC bit
V V bit

Engineering Log - Hand Auger

client: **THE LAKES (2012) LIMITED**

principal:

project: **THE LAKES, STAGE 3I GCR**

location: **CENTRE OF LOT 550**

Borehole ID. **HAL550**

sheet: 1 of 1

project no. **773-GENZTAUC13086AP**

date started: **06 Oct 2017**

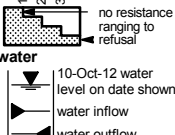
date completed: **06 Oct 2017**

logged by: **SBG**

checked by: **DBC**

position: Not Specified surface elevation: Not Specified angle from horizontal: 90° DCP id.:
drill model: Hand Auger drilling fluid: hole diameter : 50 mm vane id.: SL817

drilling information					material substance								
method & support	penetration	water	samples & field tests	RL (m)	depth (m)	graphic log	classification symbol	material description	moisture condition	consistency / relative density	vane shear ⊕ remoulded ⊙ peak (kPa)	DCP (blows/ 100 mm)	structure and additional observations
HA N	1							ORGANIC SILT: non plastic, dark brown-black.	M				TOPSOIL
	2		VS >247 kPa		0.5			Clayey SILT: low plasticity, orange-brown mottled pink/black.		H			
	3												
		Not Encountered	VS >247 kPa		1.0								
			VS >247 kPa		1.5								
			VS >247 kPa		2.0								
			VS >247 kPa		2.0			Hand Auger HAL550 terminated at 2.0 m Target depth					
					2.5								
					3.0								
					3.5								
					4.0								
					4.5								

method AD auger drilling* AS auger screwing* HA hand auger W washbore HA hand auger	support M mud C casing N nil	penetration  10-Oct-12 water level on date shown water inflow water outflow	samples & field tests B bulk disturbed sample D disturbed sample E environmental sample SS split spoon sample U## undisturbed sample ##mm diameter HP hand penetrometer (kPa) N standard penetration test (SPT) N* SPT - sample recovered Nc SPT with solid cone VS vane shear; peak/remoulded (kPa) R refusal HB hammer bouncing	classification symbol & soil description based on Unified Classification System	consistency / relative density VS very soft S soft F firm St stiff VSt very stiff H hard Fb friable VL very loose L loose MD medium dense D dense VD very dense
moisture D dry M moist W wet S saturated Wp plastic limit WL liquid limit					

* bit shown by suffix
e.g.
AD/T
B blank bit
T TC bit
V V bit

Engineering Log - Hand Auger

client: **THE LAKES (2012) LIMITED**

principal:

project: **THE LAKES, STAGE 3I GCR**

location: **BOUNDARY OF LOT 550 AND 551**

Borehole ID: **HAL550-551**

sheet: 1 of 1

project no: **773-GENZTAUC13086AP**

date started: **06 Oct 2017**

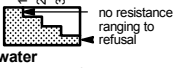
date completed: **06 Oct 2017**

logged by: **PRM**

checked by: **DBC**

position: Not Specified surface elevation: Not Specified angle from horizontal: 90° DCP id.:
drill model: Hand Auger drilling fluid: hole diameter : 50 mm vane id.: 764

drilling information							material substance										
method & support	penetration		water	samples & field tests	RL (m)	depth (m)	graphic log	classification symbol	material description	moisture condition	consistency / relative density	vane shear ⊕ remoulded ⊙ peak (kPa)			DCP (blows/ 100 mm)	structure and additional observations	
HA N	1	2	Not Encountered						ORGANIC SILT: non plastic, dark brown-black.	D to M						TOPSOIL	
				VS 161/ 31 kPa				0.5		Clayey SILT: non plastic, pale brown mottled orange-brown, with trace pumice gravel, minor fine grained sand.	M	VSt to H	⊕	⊙			FILL
				VS 164/ 31 kPa				1.0					⊕	⊙			
				VS UTP				1.5		Clayey SILT: non plastic, pale brown mottled orange-brown, with trace pumice gravel, minor fine grained sand. 1.2 to 2.0 m: interbedded clayey SILT and Sandy SILT at approximately 0.2m intervals					⊙		
				VS >213 kPa		2.0			Hand Auger HAL550-551 terminated at 2.0 m Target depth				⊙				
				VS >213 kPa		2.0											
						2.5											
						3.0											
						3.5											
						4.0											
						4.5											

method AD auger drilling* AS auger screwing* HA hand auger W washbore HA hand auger		support M mud N nil C casing		samples & field tests B bulk disturbed sample D disturbed sample E environmental sample SS split spoon sample U## undisturbed sample ##mm diameter HP hand penetrometer (kPa) N standard penetration test (SPT) N* SPT - sample recovered Nc SPT with solid cone VS vane shear; peak/remoulded (kPa) R refusal HB hammer bouncing				classification symbol & soil description based on Unified Classification System		consistency / relative density VS very soft S soft F firm St stiff VSt very stiff H hard Fb friable VL very loose L loose MD medium dense D dense VD very dense	
penetration 		water 10-Oct-12 water level on date shown water inflow water outflow		moisture D dry M moist W wet S saturated Wp plastic limit Wl liquid limit							

* bit shown by suffix
e.g.
AD/T
B blank bit
T TC bit
V V bit

Engineering Log - Hand Auger

client: **THE LAKES (2012) LIMITED**

principal:

project: **THE LAKES, STAGE 3I GCR**

location: **CENTRE OF LOT 551**

Borehole ID. **HAL551**

sheet: 1 of 1

project no. **773-GENZTAUC13086AP**

date started: **06 Oct 2017**

date completed: **06 Oct 2017**

logged by: **SBG**

checked by: **DBC**

position: Not Specified surface elevation: Not Specified angle from horizontal: 90° DCP id.:
drill model: Hand Auger drilling fluid: hole diameter : 50 mm vane id.: SL817

drilling information				material substance									
method & support	penetration	water	samples & field tests	RL (m)	depth (m)	graphic log	classification symbol	material description	moisture condition	consistency / relative density	vane shear (kPa)	DCP (blows/100 mm)	structure and additional observations
HA	1							ORGANIC SILT: non plastic, dark brown-black. Clayey SILT: low plasticity, orange-brown mottled pink/black.	M	H			TOPSOIL
	2		VS >247 kPa		0.5								FILL
	3		VS >247 kPa		1.0								
		Not Encountered	VS 231/45 kPa		1.5								
			VS >247 kPa		2.0			Hand Auger HAL551 terminated at 2.0 m Target depth					
			VS >247 kPa		2.5								
					3.0								
					3.5								
					4.0								
					4.5								

method AD auger drilling* AS auger screwing* HA hand auger W washbore HA hand auger	support M mud C casing N nil	penetration 	samples & field tests B bulk disturbed sample D disturbed sample E environmental sample SS split spoon sample U## undisturbed sample ##mm diameter HP hand penetrometer (kPa) N standard penetration test (SPT) N* SPT - sample recovered Nc SPT with solid cone VS vane shear; peak/remoulded (kPa) R refusal HB hammer bouncing	classification symbol & soil description based on Unified Classification System	consistency / relative density VS very soft S soft F firm St stiff VSt very stiff H hard Fb friable VL very loose L loose MD medium dense D dense VD very dense
moisture D dry M moist W wet S saturated Wp plastic limit WL liquid limit					

* bit shown by suffix
e.g.
AD/T
B blank bit
T TC bit
V V bit

Engineering Log - Hand Auger

client: **THE LAKES (2012) LIMITED**

principal:

project: **THE LAKES, STAGE 3I GCR**

location: **BOUNDARY OF LOT 551 AND 552**

Borehole ID. **HAL551-552**

sheet: 1 of 1

project no. **773-GENZTAUC13086AP**

date started: **06 Oct 2017**

date completed: **06 Oct 2017**

logged by: **PRM**

checked by: **DBC**

position: Not Specified surface elevation: Not Specified angle from horizontal: 90° DCP id.:
drill model: Hand Auger drilling fluid: hole diameter : 50 mm vane id.: 764

drilling information							material substance								
method & support	penetration			water	samples & field tests	RL (m)	depth (m)	graphic log	classification symbol	material description	moisture condition	consistency / relative density	vane shear ⊕ remoulded ⊙ peak (kPa)	DCP (blows/ 100 mm)	structure and additional observations
HA N	1	2	3							ORGANIC SILT: non plastic, dark brown-black.	D to M		50 100 150 200	2 4 6 8 10	TOPSOIL
				Not Encountered	VS >213 kPa VS >213 kPa VS >213 kPa VS UTP VS >213 kPa		0.5 1.0 1.5 2.0			Clayey SILT: non plastic, pale orange-brown, with minor fine grained sand.	M	H	⊙ ⊙ ⊙ VS UTP ⊙		FILL
										Hand Auger HAL551-552 terminated at 2.0 m Target depth					
							2.5								
							3.0								
							3.5								
							4.0								
							4.5								

method AD auger drilling* AS auger screwing* HA hand auger W washbore HA hand auger	support M mud C casing N nil	samples & field tests B bulk disturbed sample D disturbed sample E environmental sample SS split spoon sample U## undisturbed sample ##mm diameter HP hand penetrometer (kPa) N standard penetration test (SPT) N* SPT - sample recovered Nc SPT with solid cone VS vane shear; peak/remoulded (kPa) R refusal HB hammer bouncing	classification symbol & soil description based on Unified Classification System	consistency / relative density VS very soft S soft F firm St stiff VSt very stiff H hard Fb friable VL very loose L loose MD medium dense D dense VD very dense
* bit shown by suffix e.g. AD/T B blank bit T TC bit V V bit	penetration 	moisture D dry M moist W wet S saturated Wp plastic limit Wl liquid limit		

Engineering Log - Hand Auger

client: **THE LAKES (2012) LIMITED**

principal:

project: **THE LAKES, STAGE 3I GCR**

location: **CENTRE OF LOT 552**

Borehole ID. **HAL552**

sheet: 1 of 1

project no. **773-GENZTAUC13086AP**

date started: **06 Oct 2017**

date completed: **06 Oct 2017**

logged by: **SBG**

checked by: **DBC**

position: Not Specified surface elevation: Not Specified angle from horizontal: 90° DCP id.:
drill model: Hand Auger drilling fluid: hole diameter : 50 mm vane id.: SL817

drilling information					material substance										structure and additional observations	
method & support	1 penetration	2 water	samples & field tests	RL (m)	depth (m)	graphic log	classification symbol	material description	moisture condition	consistency / relative density	vane shear remoulded peak (kPa)	DCP (blows/ 100 mm)				
HA N	1 2 3	Not Encountered	VS >247 kPa					ORGANIC SILT: low plasticity, dark brown black.	D to M							TOPSOIL
			VS >247 kPa		0.5			Clayey SILT: low plasticity, brown orange mottled pink white, trace fine to medium grained sand.	M	H						FILL
			VS >247 kPa		1.0											
			VS >247 kPa		1.5			SAND: fine to medium grained, pale grey brown mottled black white, trace sub angular gravel clasts, trace silt.		MD						
			VS >247 kPa		2.0			Sandy SILT: low plasticity, pale brown orange mottled pink white, trace clay.		H						
					2.0			Hand Auger HAL552 terminated at 2.0 m Target depth								
					2.5											
					3.0											
					3.5											
					4.0											
					4.5											

method AD auger drilling* AS auger screwing* HA hand auger W washbore HA hand auger	support M mud C casing N nil	penetration no resistance ranging to refusal water 10-Oct-12 water level on date shown water inflow water outflow	samples & field tests B bulk disturbed sample D disturbed sample E environmental sample SS split spoon sample U## undisturbed sample ##mm diameter HP hand penetrometer (kPa) N standard penetration test (SPT) N* SPT - sample recovered Nc SPT with solid cone VS vane shear; peak/remoulded (kPa) R refusal HB hammer bouncing	classification symbol & soil description based on Unified Classification System moisture D dry M moist W wet S saturated Wp plastic limit WL liquid limit	consistency / relative density VS very soft S soft F firm St stiff VSt very stiff H hard Fb friable VL very loose L loose MD medium dense D dense VD very dense
---	--	--	--	---	--

* bit shown by suffix
e.g.
AD/T
B blank bit
T TC bit
V V bit

Engineering Log - Hand Auger

client: **THE LAKES (2012) LIMITED**

principal:

project: **THE LAKES, STAGE 3I GCR**

location: **BOUNDARY OF LOT 552 AND 553**

Borehole ID. **HAL552-553**

sheet: 1 of 1

project no. **773-GENZTAUC13086AP**

date started: **06 Oct 2017**

date completed: **06 Oct 2017**

logged by: **PRM**

checked by: **DBC**

position: Not Specified surface elevation: Not Specified angle from horizontal: 90° DCP id.:
drill model: Hand Auger drilling fluid: hole diameter : 50 mm vane id.: SL817

drilling information							material substance											
method & support	penetration			water	samples & field tests	RL (m)	depth (m)	graphic log	classification symbol	material description	moisture condition	consistency / relative density	vane shear			DCP (blows/ 100 mm)	structure and additional observations	
	1	2	3										remoulded	peak	(kPa)			
HA N				Not Encountered	VS >247 kPa					ORGANIC SILT: non plastic, dark brown-black.	D to M						TOPSOIL	
					VS 196/ 42 kPa						Clayey SILT: non plastic, pale orange-brown mottled pale pink, with minor fine to medium grained sand.	M	VSt to H					FILL
					VS >247 kPa						1.0 m: becoming moderstely plastic							
					VS UTP													
					VS 127/ 40 kPa							Sandy SILT: non plastic, pale brown-grey, sand is fine grained.						
							2.0			Clayey SILT: non plastic, pale orange-brown mottled pale pink, with minor fine to medium grained sand.								
										Hand Auger HAL552-553 terminated at 2.0 m Target depth								
							2.5											
							3.0											
							3.5											
							4.0											
							4.5											

method AD auger drilling* AS auger screwing* HA hand auger W washbore HA hand auger	support M mud C casing N nil	samples & field tests B bulk disturbed sample D disturbed sample E environmental sample SS split spoon sample U## undisturbed sample ##mm diameter HP hand penetrometer (kPa) N standard penetration test (SPT) N* SPT - sample recovered Nc SPT with solid cone VS vane shear; peak/remoulded (kPa) R refusal HB hammer bouncing	classification symbol & soil description based on Unified Classification System	consistency / relative density VS very soft S soft F firm St stiff VSt very stiff H hard Fb friable VL very loose L loose MD medium dense D dense VD very dense
penetration 	water 10-Oct-12 water level on date shown water inflow water outflow	moisture D dry M moist W wet S saturated Wp plastic limit WL liquid limit		

* bit shown by suffix
e.g. AD/T
B blank bit
T TC bit
V V bit

Engineering Log - Hand Auger

client: **THE LAKES (2012) LIMITED**

principal:

project: **THE LAKES, STAGE 3I GCR**

location: **CENTRE OF LOT 553**

Borehole ID. **HAL553**

sheet: 1 of 1

project no. **773-GENZTAUC13086AP**

date started: **06 Oct 2017**

date completed: **06 Oct 2017**

logged by: **SBG**

checked by: **DBC**

position: Not Specified surface elevation: Not Specified angle from horizontal: 90° DCP id.:
drill model: Hand Auger drilling fluid: hole diameter : 50 mm vane id.: SL817

drilling information				material substance									
method & support	penetration	water	samples & field tests	RL (m)	depth (m)	graphic log	classification symbol	material description	moisture condition	consistency / relative density	vane shear (kPa)	DCP (blows/100 mm)	structure and additional observations
HA	1		VS >247 kPa					ORGANIC SILT: low plasticity, dark brown black.	D to M				TOPSOIL
	2		VS >247 kPa		0.5			Sandy SILT: non plastic, brown orange mottled dark brown white black, minor clay, trace sub angular gravel.	M	H			FILL
	3		VS >247 kPa		1.0			Clayey SILT: low to medium plasticity, brown orange mottled dark brown, trace fine to medium grained sand.					
			VS >247 kPa		1.5			SAND: fine to medium grained, grey brown, trace silt.					
			VS >247 kPa		2.0			Sandy SILT: non plastic, grey brown, minor clay.		H			
					2.0			Hand Auger HAL553 terminated at 2.0 m Target depth					
					2.5								
					3.0								
					3.5								
					4.0								
					4.5								

method AD auger drilling* AS auger screwing* HA hand auger W washbore HA hand auger	support M mud C casing N nil	samples & field tests B bulk disturbed sample D disturbed sample E environmental sample SS split spoon sample U## undisturbed sample ##mm diameter HP hand penetrometer (kPa) N standard penetration test (SPT) N* SPT - sample recovered Nc SPT with solid cone VS vane shear; peak/remoulded (kPa) R refusal HB hammer bouncing	classification symbol & soil description based on Unified Classification System	consistency / relative density VS very soft S soft F firm St stiff VSt very stiff H hard Fb friable VL very loose L loose MD medium dense D dense VD very dense
* bit shown by suffix e.g. AD/T B blank bit T TC bit V V bit	penetration  no resistance ranging to refusal 10-Oct-12 water level on date shown water inflow water outflow		moisture D dry M moist W wet S saturated Wp plastic limit Wl liquid limit	

Engineering Log - Hand Auger

client: **THE LAKES (2012) LIMITED**

principal:

project: **THE LAKES, STAGE 3I GCR**

location: **BOUNDARY OF LOT 553 AND 554**

Borehole ID. **HAL553-554**

sheet: 1 of 1

project no. **773-GENZTAUC13086AP**

date started: **06 Oct 2017**

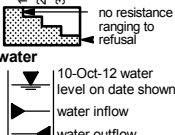
date completed: **06 Oct 2017**

logged by: **PRM**

checked by: **DBC**

position: Not Specified surface elevation: Not Specified angle from horizontal: 90° DCP id.:
drill model: Hand Auger drilling fluid: hole diameter : 50 mm vane id.: 764

drilling information							material substance								
method & support	penetration		water	samples & field tests	RL (m)	depth (m)	graphic log	classification symbol	material description	moisture condition	consistency / relative density	vane shear ⊕ remoulded ⊙ peak (kPa)	DCP (blows/ 100 mm)	structure and additional observations	
HA N	1	2							ORGANIC SILT: non plastic, dark brown-black.	D to M				TOPSOIL	
				VS >213 kPa		0.5			Clayey SILT: low plasticity, brown mottled pale brown/white.	M	H	⊙		FILL	
				VS >213 kPa		1.0						⊙			
				VS >213 kPa		1.5						⊙			
				VS UTP		2.0						VS UTP			
				VS UTP		2.0			Hand Auger HAL553-554 terminated at 2.0 m Target depth			VS UTP			
						2.5									
						3.0									
						3.5									
						4.0									
						4.5									

method AD auger drilling* AS auger screwing* HA hand auger W washbore HA hand auger	support M mud C casing N nil	samples & field tests B bulk disturbed sample D disturbed sample E environmental sample SS split spoon sample U## undisturbed sample ##mm diameter HP hand penetrometer (kPa) N standard penetration test (SPT) N* SPT - sample recovered Nc SPT with solid cone VS vane shear; peak/remoulded (kPa) R refusal HB hammer bouncing	classification symbol & soil description based on Unified Classification System	consistency / relative density VS very soft S soft F firm St stiff VSt very stiff H hard Fb friable VL very loose L loose MD medium dense D dense VD very dense
* bit shown by suffix e.g. AD/T B blank bit T TC bit V V bit	penetration 		moisture D dry M moist W wet S saturated Wp plastic limit Wl liquid limit	

Engineering Log - Hand Auger

client: **THE LAKES (2012) LIMITED**

principal:

project: **THE LAKES, STAGE 3I GCR**

location: **CENTRE OF LOT 554**

Borehole ID: **HAL554**

sheet: 1 of 1

project no: **773-GENZTAUC13086AP**

date started: **05 Oct 2017**

date completed: **05 Oct 2017**

logged by: **SBG**

checked by: **DBC**

position: Not Specified surface elevation: Not Specified angle from horizontal: 90° DCP id.:
drill model: Hand Auger drilling fluid: hole diameter : 50 mm vane id.: 764

drilling information							material substance									
method & support	penetration			water	samples & field tests	RL (m)	depth (m)	graphic log	classification symbol	material description	moisture condition	consistency / relative density	vane shear ⊕ remoulded ⊙ peak (kPa)	DCP (blows/ 100 mm)	structure and additional observations	
HA	1	2	3	Not Encountered	VS UTP		0.5			ORGANIC SILT: non plastic, dark brown black.	D to M	H	VS UTP		TOPSOIL	
							Clayey SILT: non plastic, brown orange mottled white black, minor fine to medium grained sand.			M	FILL					
							1.0				VS UTP					
							1.5			1.4 m: becoming slightly to moderatley plastic					VS UTP	
							1.8			1.8 m: becoming slightly plastic						
							2.0			Hand Auger HAL554 terminated at 2.0 m Target depth						
							2.5									
							3.0									
							3.5									
							4.0									
							4.5									

method AD auger drilling* AS auger screwing* HA hand auger W washbore HA hand auger	support M mud C casing N nil	samples & field tests B bulk disturbed sample D disturbed sample E environmental sample SS split spoon sample U## undisturbed sample ##mm diameter HP hand penetrometer (kPa) N standard penetration test (SPT) N* SPT - sample recovered Nc SPT with solid cone VS vane shear; peak/remoulded (kPa) R refusal HB hammer bouncing	classification symbol & soil description based on Unified Classification System	consistency / relative density VS very soft S soft F firm St stiff VSt very stiff H hard Fb friable VL very loose L loose MD medium dense D dense VD very dense
* bit shown by suffix e.g. AD/T B blank bit T TC bit V V bit	penetration 		moisture D dry M moist W wet S saturated Wp plastic limit WL liquid limit	

Engineering Log - Hand Auger

client: **THE LAKES (2012) LIMITED**

principal:

project: **THE LAKES, STAGE 3I GCR**

location: **BOUNDARY OF LOT 554 AND 555**

Borehole ID. **HAL554-555**

sheet: 1 of 1

project no. **773-GENZTAUC13086AP**

date started: **06 Oct 2017**

date completed: **06 Oct 2017**

logged by: **SBG**

checked by: **DBC**

position: Not Specified surface elevation: Not Specified angle from horizontal: 90° DCP id.:
drill model: Hand Auger drilling fluid: hole diameter : 50 mm vane id.: 817

drilling information							material substance										
method & support	penetration			water	samples & field tests	RL (m)	depth (m)	graphic log	classification symbol	material description	moisture condition	consistency / relative density	vane shear ⊕ remoulded ⊙ peak (kPa)	DCP (blows/ 100 mm)	structure and additional observations		
HA N	1	2	3	Not Encountered	VS 240/ 45 kPa		0.5			ORGANIC SILT: low plasticity, dark brown black mottled pink white.	D to M	H			TOPSOIL		
					VS >247 kPa						Clayey SILT: low plasticity, brown orange mottled white black pink, minor fine to medium grained sand.		M	⊕		⊙	FILL
					VS >247 kPa						0.9 to 1.1 m: with pumiceous inclusions						
					VS >247 kPa		1.0										
					VS UTP		1.5										
					VS >247 kPa		2.0			Sandy SILT: non plastic, brown grey mottled white black, sand fine to medium grained, trace clay.			VS UTP	⊙			
							2.0			Hand Auger HAL554-555 terminated at 2.0 m Target depth							
							2.5										
							3.0										
							3.5										
							4.0										
							4.5										

method AD auger drilling* AS auger screwing* HA hand auger W washbore HA hand auger	support M mud C casing N nil	samples & field tests B bulk disturbed sample D disturbed sample E environmental sample SS split spoon sample U## undisturbed sample ##mm diameter HP hand penetrometer (kPa) N standard penetration test (SPT) N* SPT - sample recovered Nc SPT with solid cone VS vane shear; peak/remoulded (kPa) R refusal HB hammer bouncing	classification symbol & soil description based on Unified Classification System	consistency / relative density VS very soft S soft F firm St stiff VSt very stiff H hard Fb friable VL very loose L loose MD medium dense D dense VD very dense
* bit shown by suffix e.g. AD/T B blank bit T TC bit V V bit	penetration no resistance ranging to refusal 10-Oct-12 water level on date shown water inflow water outflow		moisture D dry M moist W wet S saturated Wp plastic limit WL liquid limit	

Engineering Log - Hand Auger

client: **THE LAKES (2012) LIMITED**

principal:

project: **THE LAKES, STAGE 3I GCR**

location: **CENTRE OF LOT 555**

Borehole ID. **HAL555**

sheet: 1 of 1

project no. **773-GENZTAUC13086AP**

date started: **06 Oct 2017**

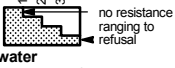
date completed: **06 Oct 2017**

logged by: **PRM**

checked by: **DBC**

position: Not Specified surface elevation: Not Specified angle from horizontal: 90° DCP id.:
drill model: Hand Auger drilling fluid: hole diameter : 50 mm vane id.: 764

drilling information					material substance								structure and additional observations	
method & support	penetration	water	samples & field tests	RL (m)	depth (m)	graphic log	classification symbol	material description	moisture condition	consistency / relative density	vane shear (kPa)	DCP (blows/100 mm)		
HA	1							ORGANIC SILT: non plastic, dark brown-black.	D to M					TOPSOIL
	2		VS UTP		0.5			Sandy SILT: non plastic, pale orange-brown mottled brown, sand is fine to medium grained.	M	H	VS UTP			FILL
	3		VS UTP		1.0			Clayey SILT: low plasticity, pale orange brown mottled pale grey, with minor fine grained sand.			VS UTP			
			VS >213 kPa		1.5									
			VS UTP		2.0			Hand Auger HAL555 terminated at 2.0 m Target depth						
			VS >213 kPa		2.5									
					3.0									
					3.5									
					4.0									
					4.5									

method AD auger drilling* AS auger screwing* HA hand auger W washbore HA hand auger	support M mud C casing N nil	penetration  water 10-Oct-12 water level on date shown water inflow water outflow	samples & field tests B bulk disturbed sample D disturbed sample E environmental sample SS split spoon sample U## undisturbed sample ##mm diameter HP hand penetrometer (kPa) N standard penetration test (SPT) N* SPT - sample recovered Nc SPT with solid cone VS vane shear; peak/remoulded (kPa) R refusal HB hammer bouncing	classification symbol & soil description based on Unified Classification System moisture D dry M moist W wet S saturated Wp plastic limit Wl liquid limit	consistency / relative density VS very soft S soft F firm St stiff VSt very stiff H hard Fb friable VL very loose L loose MD medium dense D dense VD very dense
---	--	---	--	---	--

* bit shown by suffix
e.g.
AD/T
B blank bit
T TC bit
V V bit

Engineering Log - Hand Auger

client: **THE LAKES (2012) LIMITED**

principal:

project: **THE LAKES, STAGE 3I GCR**

location: **BOUNDARY OF LOT 555 AND 556**

Borehole ID. **HAL555-556**

sheet: 1 of 1

project no. **773-GENZTAUC13086AP**

date started: **06 Oct 2017**

date completed: **06 Oct 2017**

logged by: **SBG**

checked by: **DBC**

position: Not Specified surface elevation: Not Specified angle from horizontal: 90° DCP id.:
drill model: Hand Auger drilling fluid: hole diameter : 50 mm vane id.: SL817

drilling information					material substance									
method & support	1 penetration	2 water	samples & field tests	RL (m)	depth (m)	graphic log	classification symbol	material description	moisture condition	consistency / relative density	vane shear ⊕ remoulded ⊙ peak (kPa)	DCP (blows/ 100 mm)	structure and additional observations	
HA N	1 2 3	Not Encountered	VS 247 kPa		0.5			ORGANIC SILT: non plastic, dark brown black.	D to M	VSt to H	⊕ ⊙ ⊕ ⊙ ⊕	2 4 6 8 10	TOPSOIL	
			VS 247 kPa					Sandy SILT: non plastic, orange brown mottled white dark brown, sand is fine to medium grained.	M				FILL	
			VS 188/ 45 kPa					Clayey SILT: low plasticity, orange brown mottled white pale brown, trace fine to medium grained sand.						
			VS 247 kPa											
			VS 247 kPa					Sandy CLAY: low to medium plasticity, orange brown, trace fine to medium grained sand.						
			VS 247 kPa		2.0			Hand Auger HAL555-556 terminated at 2.0 m Target depth						
					2.5									
					3.0									
					3.5									
					4.0									
					4.5									

method AD auger drilling* AS auger screwing* HA hand auger W washbore HA hand auger	support M mud C casing N nil	penetration water 10-Oct-12 water level on date shown water inflow water outflow	samples & field tests B bulk disturbed sample D disturbed sample E environmental sample SS split spoon sample U## undisturbed sample ##mm diameter HP hand penetrometer (kPa) N standard penetration test (SPT) N* SPT - sample recovered Nc SPT with solid cone VS vane shear; peak/remoulded (kPa) R refusal HB hammer bouncing	classification symbol & soil description based on Unified Classification System moisture D dry M moist W wet S saturated Wp plastic limit Wl liquid limit	consistency / relative density VS very soft S soft F firm St stiff VSt very stiff H hard Fb friable VL very loose L loose MD medium dense D dense VD very dense
---	--	--	--	---	--

* bit shown by suffix
e.g.
AD/T
B blank bit
T TC bit
V V bit

Engineering Log - Hand Auger

client: **THE LAKES (2012) LIMITED**

principal:

project: **THE LAKES, STAGE 3I GCR**

location: **CENTRE OF LOT 556**

Borehole ID. **HAL556**

sheet: 1 of 1

project no. **773-GENZTAUC13086A**

date started: **06 Oct 2017**

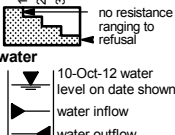
date completed: **06 Oct 2017**

logged by: **SBG**

checked by: **DBC**

position: Not Specified surface elevation: Not Specified angle from horizontal: 90° DCP id.:
drill model: Hand Auger drilling fluid: hole diameter : 50 mm vane id.: SL817

drilling information					material substance								
method & support	penetration	water	samples & field tests	RL (m)	depth (m)	graphic log	classification symbol	material description	moisture condition	consistency / relative density	vane shear ⊕ remoulded ⊙ peak (kPa)	DCP (blows/ 100 mm)	structure and additional observations
HA Z	1							ORGANIC SILT: non plastic, dark brown black.	D to M	H	50	2	TOPSOIL
	2		VS >247 kPa					SILTY SAND: fine to medium grained, orange brown mottled grey white.	M		100	4	FILL
	3		VS >247 kPa	0.5				Clayey SILT: low plasticity, orange brown mottled white grey black, trace fine to medium grained sand.			150	6	
			VS >247 kPa	1.0							200	8	
			VS >247 kPa	1.5								10	
			VS >247 kPa										
			VS UTP										
				2.0				1.5 m: with minor fine to medium grained sand 1.51 m: becomes slightly to moderately plastic	W		VS UTP	DCP REFUSAL	
					2.0			Hand Auger HAL556 terminated at 2.0 m Target depth					
					2.5								
					3.0								
					3.5								
					4.0								
					4.5								

method AD auger drilling* AS auger screwing* HA hand auger W washbore HA hand auger	support M mud C casing N nil	samples & field tests B bulk disturbed sample D disturbed sample E environmental sample SS split spoon sample U## undisturbed sample ##mm diameter HP hand penetrometer (kPa) N standard penetration test (SPT) N* SPT - sample recovered Nc SPT with solid cone VS vane shear; peak/remoulded (kPa) R refusal HB hammer bouncing	classification symbol & soil description based on Unified Classification System	consistency / relative density VS very soft S soft F firm St stiff VSt very stiff H hard Fb friable VL very loose L loose MD medium dense D dense VD very dense
* bit shown by suffix e.g. AD/T B blank bit T TC bit V V bit	penetration 	moisture D dry M moist W wet S saturated Wp plastic limit Wl liquid limit		

Engineering Log - Hand Auger

client: **THE LAKES (2012) LIMITED**

principal:

project: **THE LAKES, STAGE 3I GCR**

location: **BOUNDARY OF LOT 556 AND 557**

Borehole ID. **HAL556-557**

sheet: 1 of 1

project no. **773-GENZTAUC13086AP**

date started: **06 Oct 2017**

date completed: **06 Oct 2017**

logged by: **PRM**

checked by: **DBC**

position: Not Specified surface elevation: Not Specified angle from horizontal: 90° DCP id.:
drill model: Hand Auger drilling fluid: hole diameter : 50 mm vane id.: 764

drilling information							material substance										
method & support	penetration			water	samples & field tests	RL (m)	depth (m)	graphic log	classification symbol	material description	moisture condition	consistency / relative density	vane shear		DCP (blows/ 100 mm)	structure and additional observations	
	1	2	3										remoulded	peak			
HA N	1			Not Encountered	VS 179/ 31 kPa		0.5			ORGANIC SILT: non plastic, dark brown-black.	D to M						TOPSOIL
	2				VS UTP				Clayey SILT: low plasticity, orange-brown, with trace fine grained sand.	M	VSt to H	⊕	⊙		FILL		
	3				VS UTP		1.0						VS UTP				
					VS UTP		1.5						VS UTP				
					VS UTP		2.0						VS UTP				
					VS 161/ 31 kPa		2.0			Hand Auger HAL556-557 terminated at 2.0 m Target depth			⊕	⊙			
							2.5										
							3.0										
							3.5										
							4.0										
							4.5										

method AD auger drilling* AS auger screwing* HA hand auger W washbore HA hand auger	support M mud C casing N nil	samples & field tests B bulk disturbed sample D disturbed sample E environmental sample SS split spoon sample U## undisturbed sample ##mm diameter HP hand penetrometer (kPa) N standard penetration test (SPT) N* SPT - sample recovered Nc SPT with solid cone VS vane shear, peak/remoulded (kPa) R refusal HB hammer bouncing	classification symbol & soil description based on Unified Classification System	consistency / relative density VS very soft S soft F firm St stiff VSt very stiff H hard Fb friable VL very loose L loose MD medium dense D dense VD very dense
penetration 	water 10-Oct-12 water level on date shown water inflow water outflow	moisture D dry M moist W wet S saturated Wp plastic limit WI liquid limit		

* bit shown by suffix
e.g.
AD/T
B blank bit
T TC bit
V V bit

Engineering Log - Hand Auger

client: **THE LAKES (2012) LIMITED**

principal:

project: **THE LAKES, STAGE 3I GCR**

location: **CENTRE OF LOT 557**

Borehole ID. **HAL557**

sheet: 1 of 1

project no. **773-GENZTAUC13086AP**

date started: **06 Oct 2017**

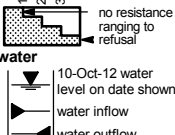
date completed: **06 Oct 2017**

logged by: **SBG**

checked by: **DBC**

position: Not Specified surface elevation: Not Specified angle from horizontal: 90° DCP id.:
drill model: Hand Auger drilling fluid: hole diameter : 50 mm vane id.: SL817

drilling information					material substance									
method & support	penetration	water	samples & field tests	RL (m)	depth (m)	graphic log	classification symbol	material description	moisture condition	consistency / relative density	vane shear (kPa)	DCP (blows/100 mm)	structure and additional observations	
HA	1							ORGANIC SILT: non plastic, dark brown-black.	M				TOPSOIL	
	2		VS >247 kPa		0.5			Clayey SILT: non plastic, orange-brown mottled white/black, with minor fine to medium grained sand.		H			FILL	
	3		VS >247 kPa		1.0									
		Not Encountered	VS >247 kPa		1.5			1.4 m: becoming slightly to moderately plastic						
			VS >247 kPa		2.0			1.8 m: becoming slightly plastic						
			VS 209/45 kPa		2.0			Hand Auger HAL557 terminated at 2.0 m Target depth						
					2.5									
					3.0									
					3.5									
					4.0									
					4.5									

method AD auger drilling* AS auger screwing* HA hand auger W washbore HA hand auger	support M mud C casing N nil	penetration 	samples & field tests B bulk disturbed sample D disturbed sample E environmental sample SS split spoon sample U## undisturbed sample ##mm diameter HP hand penetrometer (kPa) N standard penetration test (SPT) N* SPT - sample recovered Nc SPT with solid cone VS vane shear; peak/remoulded (kPa) R refusal HB hammer bouncing	classification symbol & soil description based on Unified Classification System	consistency / relative density VS very soft S soft F firm St stiff VSt very stiff H hard Fb friable VL very loose L loose MD medium dense D dense VD very dense
moisture D dry M moist W wet S saturated Wp plastic limit WL liquid limit					

* bit shown by suffix
e.g.
AD/T
B blank bit
T TC bit
V V bit

Engineering Log - Hand Auger

client: **THE LAKES (2012) LIMITED**

principal:

project: **THE LAKES, STAGE 3I GCR**

location: **BOUNDARY OF LOT 557 AND 558**

Borehole ID. **HAL557-558**

sheet: 1 of 1

project no. **773-GENZTAUC13086AP**

date started: **06 Oct 2017**

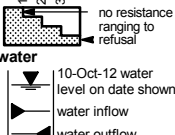
date completed: **06 Oct 2017**

logged by: **PRM**

checked by: **DBC**

position: Not Specified surface elevation: Not Specified angle from horizontal: 90° DCP id.:
drill model: Hand Auger drilling fluid: hole diameter : 50 mm vane id.: 764

drilling information				material substance									
method & support	penetration	water	samples & field tests	RL (m)	depth (m)	graphic log	classification symbol	material description	moisture condition	consistency / relative density	vane shear (kPa)	DCP (blows/100 mm)	structure and additional observations
HA	1 2 3	Not Encountered	VS UTP		0.5			ORGANIC SILT: non plastic, dark brown-black.	D to M				TOPSOIL
			VS UTP		1.0			Clayey SILT: non plastic, orange-brown, with trace fine grained sand.	M	VSt	VS UTP		FILL
			VS UTP		1.5			1.2 m: Refused at 3 different locations due to gravel hardfill Hand Auger HAL557-558 terminated at 1.2 m Refusal			VS UTP		
					2.0								
					2.5								
					3.0								
					3.5								
					4.0								
					4.5								

method AD auger drilling* AS auger screwing* HA hand auger W washbore HA hand auger	support M mud C casing N nil	samples & field tests B bulk disturbed sample D disturbed sample E environmental sample SS split spoon sample U## undisturbed sample ##mm diameter HP hand penetrometer (kPa) N standard penetration test (SPT) N* SPT - sample recovered Nc SPT with solid cone VS vane shear; peak/remoulded (kPa) R refusal HB hammer bouncing	classification symbol & soil description based on Unified Classification System	consistency / relative density VS very soft S soft F firm St stiff VSt very stiff H hard Fb friable VL very loose L loose MD medium dense D dense VD very dense
* bit shown by suffix e.g. AD/T B blank bit T TC bit V V bit	penetration 		moisture D dry M moist W wet S saturated Wp plastic limit WL liquid limit	

Engineering Log - Hand Auger

client: **THE LAKES (2012) LIMITED**

principal:

project: **THE LAKES, STAGE 3I GCR**

location: **CENTRE OF LOT 558**

Borehole ID. **HAL558**

sheet: 1 of 1

project no. **773-GENZTAUC13086AP**

date started: **06 Oct 2017**

date completed: **06 Oct 2017**

logged by: **SBG**

checked by: **DBC**

position: Not Specified surface elevation: Not Specified angle from horizontal: 90° DCP id.:
drill model: Hand Auger drilling fluid: hole diameter : 50 mm vane id.: SL817

drilling information					material substance									
method & support	penetration	water	samples & field tests	RL (m)	depth (m)	graphic log	classification symbol	material description	moisture condition	consistency / relative density	vane shear (kPa)	DCP (blows/100 mm)	structure and additional observations	
HA	1	Not Encountered	VS 247 kPa		0.5			ORGANIC SILT: non plastic, dark brown black, trace fine to medium grained sand.	D to M				TOPSOIL	
	2		VS 213/42 kPa					Sandy SILT: non plastic, brown orange mottled dark brown, sand fine to medium grained.	M	H			FILL	
	3		VS 247 kPa		1.0			Clayey SILT: low plasticity, brown orange, minor fine to medium grained sand.						
			VS UTP		1.2			1.2 m: Refused at 3 different locations due to gravel hardfill Hand Auger HAL558 terminated at 1.2 m Refusal						
					1.5									
					2.0									
					2.5									
					3.0									
					3.5									
					4.0									
					4.5									

method AD auger drilling* AS auger screwing* HA hand auger W washbore HA hand auger	support M mud C casing N nil	samples & field tests B bulk disturbed sample D disturbed sample E environmental sample SS split spoon sample U## undisturbed sample ##mm diameter HP hand penetrometer (kPa) N standard penetration test (SPT) N* SPT - sample recovered Nc SPT with solid cone VS vane shear; peak/remoulded (kPa) R refusal HB hammer bouncing	classification symbol & soil description based on Unified Classification System	consistency / relative density VS very soft S soft F firm St stiff VSt very stiff H hard Fb friable VL very loose L loose MD medium dense D dense VD very dense
* bit shown by suffix e.g. AD/T B blank bit T TC bit V V bit	penetration 		moisture D dry M moist W wet S saturated Wp plastic limit WL liquid limit	

Engineering Log - Hand Auger

client: **THE LAKES (2012) LIMITED**

principal:

project: **THE LAKES, STAGE 3I GCR**

location: **BOUNDARY OF LOT 558 AND 559**

Borehole ID. **HAL558-559**

sheet: 1 of 1

project no. **773-GENZTAUC13086AP**

date started: **06 Oct 2017**

date completed: **06 Oct 2017**

logged by: **PRM**

checked by: **DBC**

position: Not Specified surface elevation: Not Specified angle from horizontal: 90° DCP id.:
drill model: Hand Auger drilling fluid: hole diameter : 50 mm vane id.: 764

drilling information					material substance									
method & support	1 penetration	2 water	samples & field tests	RL (m)	depth (m)	graphic log	classification symbol	material description	moisture condition	consistency / relative density	vane shear remoulded peak (kPa)	DCP (blows/100 mm)	structure and additional observations	
HA N	1							ORGANIC SILT: non plastic, dark brown-black.	D to M				TOPSOIL	FILL
	2		VS UTP		0.5			Clayey SILT: non plastic, orange-brown, with trace fine grained sand.	M	H	VS UTP			
	3		VS UTP		1.0						VS UTP			
			VS UTP		1.5						VS UTP			
			VS UTP		2.0						VS UTP			
			VS UTP		2.0						VS UTP			
					2.5			Hand Auger HAL558-559 terminated at 2.0 m Target depth						
					3.0									
					3.5									
					4.0									
					4.5									

method AD auger drilling* AS auger screwing* HA hand auger W washbore HA hand auger	support M mud C casing N nil	samples & field tests B bulk disturbed sample D disturbed sample E environmental sample SS split spoon sample U## undisturbed sample ##mm diameter HP hand penetrometer (kPa) N standard penetration test (SPT) N* SPT - sample recovered Nc SPT with solid cone VS vane shear; peak/remoulded (kPa) R refusal HB hammer bouncing	classification symbol & soil description based on Unified Classification System	consistency / relative density VS very soft S soft F firm St stiff VSt very stiff H hard Fb friable VL very loose L loose MD medium dense D dense VD very dense
* bit shown by suffix e.g. AD/T B blank bit T TC bit V V bit	penetration no resistance ranging to refusal 10-Oct-12 water level on date shown water inflow water outflow		moisture D dry M moist W wet S saturated Wp plastic limit WL liquid limit	

Engineering Log - Hand Auger

client: **THE LAKES (2012) LIMITED**

principal:

project: **THE LAKES, STAGE 3I GCR**

location: **CENTRE OF LOT 559**

Borehole ID. **HAL559**

sheet: 1 of 1

project no. **773-GENZTAUC13086AP**

date started: **10 Oct 2017**

date completed: **10 Oct 2017**

logged by: **PM**

checked by: **DBC**

position: Not Specified surface elevation: Not Specified angle from horizontal: 90° DCP id.:
drill model: Hand Auger drilling fluid: hole diameter : 50 mm vane id.: VH1447

drilling information							material substance								
method & support	penetration			water	samples & field tests	RL (m)	depth (m)	graphic log	classification symbol	material description	moisture condition	consistency / relative density	vane shear ⊕ remoulded ⊙ peak (kPa)	DCP (blows/ 100 mm)	structure and additional observations
HA N	1	2	3	Not Encountered	VS 162/ 30 kPa		0.5			ORGANIC SILT: non plastic, dark brown black.	M	VSt	⊕ ⊙		TOPSOIL
					VS >247 kPa		1.0			Sandy SILT: non plastic, pale brown mottled orange brown, sand fine to medium grained, minor slightly plastic clay.		H		⊙ ⊙ ⊙ ⊙ ⊙ ⊙	
					VS >247 kPa		1.5								
					VS >247 kPa		2.0								
					VS >247 kPa		2.5								
					VS >247 kPa		3.0			Hand Auger HAL559 terminated at 3.0 m Target depth					
							3.5								
							4.0								
							4.5								

method AD auger drilling* AS auger screwing* HA hand auger W washbore HA hand auger	support M mud C casing N nil	samples & field tests B bulk disturbed sample D disturbed sample E environmental sample SS split spoon sample U## undisturbed sample ##mm diameter HP hand penetrometer (kPa) N standard penetration test (SPT) N* SPT - sample recovered Nc SPT with solid cone VS vane shear; peak/remoulded (kPa) R refusal HB hammer bouncing	classification symbol & soil description based on Unified Classification System	consistency / relative density VS very soft S soft F firm St stiff VSt very stiff H hard Fb friable VL very loose L loose MD medium dense D dense VD very dense
penetration  no resistance ranging to refusal	water 10-Oct-12 water level on date shown water inflow water outflow		moisture D dry M moist W wet S saturated Wp plastic limit Wl liquid limit	

* bit shown by suffix
e.g.
AD/T
B blank bit
T TC bit
V V bit

client: **THE LAKES (2012) LIMITED**

principal:

project: **THE LAKES, STAGE 3/ GCR**

location: **BOUNDARY OF LOT 559 AND 560**

Borehole ID. **HAL559-560**

sheet: 1 of 1

project no. **773-GENZTAUC13086AP**

date started: **10 Oct 2017**

date completed: **10 Oct 2017**

logged by: **SBG**

checked by: **DBC**

position: Not Specified				surface elevation: Not Specified				angle from horizontal: 90°				DCP id.:				
drill model: Hand Auger				drilling fluid:				hole diameter : 50 mm				vane id.: VH4523				
drilling information						material substance										
method & support		samples & field tests		RL (m)	depth (m)	graphic log	classification symbol	material description		moisture condition	consistency / relative density	vane shear		DCP (blows/ 100 mm)	structure and additional observations	
1 2 3		penetration						SOIL TYPE: plasticity or particle characteristic, colour, secondary and minor components				● remoulded ● peak (kPa) 50 100 150 200				
HA N		Not Encountered						SILTY SAND: fine to medium grained, pale brown orange.		M		○			FILL	
		VS >215 kPa			0.5			Sandy SILT: non plastic, pale brown orange mottled black white red, sand fine to medium grained.			H	○				
		VS >215 kPa										○				
		VS >215 kPa			1.0			Silty CLAY: low to medium plasticity, brown orange, trace fine to medium grained sand.				○				
		VS >215 kPa										○				
		VS >215 kPa			1.5			Sandy SILT: non plastic, sand fine to medium grained.				○				
		VS >215 kPa										○				
					2.0			Hand Auger HAL559-560 terminated at 2.0 m Target depth								
					2.5											
					3.0											
					3.5											
					4.0											
					4.5											

Engineering Log - Hand Auger

client: **THE LAKES (2012) LIMITED**

principal:

project: **THE LAKES, STAGE 3I GCR**

location: **CENTRE OF LOT 560**

Borehole ID: **HAL560**

sheet: 1 of 1

project no: **773-GENZTAUC13086AP**

date started: **10 Oct 2017**

date completed: **10 Oct 2017**

logged by: **PRM**

checked by: **DBC**

position: Not Specified surface elevation: Not Specified angle from horizontal: 90° DCP id.:
drill model: Hand Auger drilling fluid: hole diameter : 50 mm vane id.: VH1447

drilling information					material substance									
method & support	penetration	water	samples & field tests	RL (m)	depth (m)	graphic log	classification symbol	material description	moisture condition	consistency / relative density	vane shear	DCP	structure and additional observations	
	1 2 3							SOIL TYPE: plasticity or particle characteristic, colour, secondary and minor components			remoulded peak (kPa)	(blows/100 mm)		
HA								ORGANIC SILT: non plastic, dark brown black.	M				TOPSOIL	
			VS UTP		0.5			Sandy SILT: non plastic, pale orange brown, minor fine grained sand.					FILL	
			VS 166/39 kPa		1.0			Clayey SILT: low plasticity, pale pink mottled pale brown.		VSt to H				
			VS UTP		1.5									
			VS UTP		2.0									
					2.0			2.0 m: Refusal due to hardfill Hand Auger HAL560 terminated at 2.0 m Refusal						
					2.5									
					3.0									
					3.5									
					4.0									
					4.5									

method AD auger drilling* AS auger screwing* HA hand auger W washbore HA hand auger	support M mud C casing N nil	samples & field tests B bulk disturbed sample D disturbed sample E environmental sample SS split spoon sample U## undisturbed sample ##mm diameter HP hand penetrometer (kPa) N standard penetration test (SPT) N* SPT - sample recovered Nc SPT with solid cone VS vane shear; peak/remoulded (kPa) R refusal HB hammer bouncing	classification symbol & soil description based on Unified Classification System	consistency / relative density VS very soft S soft F firm St stiff VSt very stiff H hard Fb friable VL very loose L loose MD medium dense D dense VD very dense
* bit shown by suffix e.g. AD/T B blank bit T TC bit V V bit	penetration 		moisture D dry M moist W wet S saturated Wp plastic limit WL liquid limit	

Engineering Log - Hand Auger

client: **THE LAKES (2012) LIMITED**

principal:

project: **THE LAKES, STAGE 3I GCR**

location: **BOUNDARY OF LOT 560 AND 561**

Borehole ID. **HAL560-561**

sheet: 1 of 1

project no. **773-GENZTAUC13086AP**

date started: **10 Oct 2017**

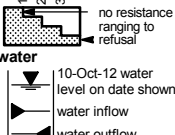
date completed: **10 Oct 2017**

logged by: **SBG**

checked by: **DBC**

position: Not Specified surface elevation: Not Specified angle from horizontal: 90° DCP id.:
drill model: Hand Auger drilling fluid: hole diameter : 50 mm vane id.: SL817

drilling information				material substance									
method & support	penetration	water	samples & field tests	RL (m)	depth (m)	graphic log	classification symbol	material description	moisture condition	consistency / relative density	vane shear (kPa)	DCP (blows/100 mm)	structure and additional observations
1 2 3	1 2 3							ORGANIC SILT: dark brown black.	M				TOPSOIL
			VS 227/ 58 kPa		0.5			Clayey SILT: non plastic, brown, trace fine grained sand.	H	⊕	⊙		FILL
			VS 173/ 48 kPa		1.0			Clayey SILT: low plasticity, pale pink brown mottled brown, trace fine to medium grained sand.	St	⊕	⊙		
			VS >247 kPa		1.5				VSt to H				
			VS 158/ 39 kPa		2.0					⊕	⊙		
			VS 144/ 32 kPa		2.5					⊕	⊙		
			VS 140/ 29 kPa		3.0					⊕	⊙		
			VS UTP		3.5								
			VS 147/ 32 kPa		4.0								
					4.5								
								Hand Auger HAL560-561 terminated at 3.0 m Target depth					

method AD auger drilling* AS auger screwing* HA hand auger W washbore HA hand auger	support M mud C casing N nil	penetration  10-Oct-12 water level on date shown water inflow water outflow	samples & field tests B bulk disturbed sample D disturbed sample E environmental sample SS split spoon sample U## undisturbed sample ##mm diameter HP hand penetrometer (kPa) N standard penetration test (SPT) N* SPT - sample recovered Nc SPT with solid cone VS vane shear; peak/remoulded (kPa) R refusal HB hammer bouncing	classification symbol & soil description based on Unified Classification System	consistency / relative density VS very soft S soft F firm St stiff VSt very stiff H hard Fb friable VL very loose L loose MD medium dense D dense VD very dense
moisture D dry M moist W wet S saturated Wp plastic limit WL liquid limit					

* bit shown by suffix
e.g.
AD/T
B blank bit
T TC bit
V V bit

Engineering Log - Hand Auger

client: **THE LAKES (2012) LIMITED**

principal:

project: **THE LAKES, STAGE 3I GCR**

location: **CENTRE OF LOT 561**

Borehole ID. **HAL561**

sheet: 1 of 1

project no. **773-GENZTAUC13086AP**

date started: **10 Oct 2017**

date completed: **10 Oct 2017**

logged by: **PRM**

checked by: **DBC**

position: Not Specified surface elevation: Not Specified angle from horizontal: 90° DCP id.:
drill model: Hand Auger drilling fluid: hole diameter : 50 mm vane id.: VH4523

drilling information					material substance									
method & support	penetration		water	samples & field tests	RL (m)	depth (m)	graphic log	classification symbol	material description	moisture condition	consistency / relative density	vane shear ⊕ remoulded ⊙ peak (kPa) 0 50 100 150 200	DCP (blows/ 100 mm) 2 4 6 8 10	structure and additional observations
HA N	1	2	Not Encountered	VS 129 kPa		0.5			ORGANIC SILT: non plastic, dark brown black.	D to M	VSt	⊙	<	

method AD auger drilling* AS auger screwing* HA hand auger W washbore HA hand auger * bit shown by suffix e.g. AD/T B blank bit T TC bit V V bit	support M mud N nil C casing penetration no resistance ranging to refusal water 10-Oct-12 water level on date shown water inflow water outflow	samples & field tests B bulk disturbed sample D disturbed sample E environmental sample SS split spoon sample U## undisturbed sample ##mm diameter HP hand penetrometer (kPa) N standard penetration test (SPT) N* SPT - sample recovered Nc SPT with solid cone VS vane shear; peak/remoulded (kPa) R refusal HB hammer bouncing	classification symbol & soil description based on Unified Classification System moisture D dry M moist W wet S saturated Wp plastic limit Wl liquid limit	consistency / relative density VS very soft S soft F firm St stiff VSt very stiff H hard Fb friable VL very loose L loose MD medium dense D dense VD very dense
---	---	--	---	--

Engineering Log - Hand Auger

client: **THE LAKES (2012) LIMITED**

principal:

project: **THE LAKES, STAGE 3I GCR**

location: **BOUNDARY OF LOT 561 AND 562**

Borehole ID. **HAL561-562**

sheet: 1 of 1

project no. **773-GENZTAUC13086AP**

date started: **10 Oct 2017**

date completed: **10 Oct 2017**

logged by: **PRM**

checked by: **DBC**

position: Not Specified surface elevation: Not Specified angle from horizontal: 90° DCP id.:
drill model: Hand Auger drilling fluid: hole diameter : 50 mm vane id.: VH1447

drilling information							material substance									
method & support	penetration		water	samples & field tests	RL (m)	depth (m)	graphic log	classification symbol	material description	moisture condition	consistency / relative density	vane shear ⊕ remoulded ⊙ peak (kPa)			DCP (blows/ 100 mm)	structure and additional observations
HA N	1	2	Not Encountered	VS 231/ 58 kPa		0.5			ORGANIC SILT: non plastic, dark brown black.	M	H	⊕	⊙		TOPSOIL	
						Sandy SILT: non plastic, pale orange brown, sand fine to medium grained.										
						Clayey SILT: low plasticity, pale orange mottled pale pink brown, trace to minor fine to medium grained sand.		⊕	⊙			FILL				
						1.6 m: becoming moderately plastic with trace fine grained sand		⊕	⊙							
			VS 231/ 42 kPa		1.0						St to VSt	⊕	⊙			
			VS 144/ 42 kPa		1.5							⊕	⊙			
			VS 107/ 48 kPa		2.0							⊕	⊙			
			VS 72/ 42 kPa		2.6				Hand Auger HAL561-562 terminated at 2.0 m Target depth			⊕	⊙			
						2.5										
						3.0										
						3.5										
						4.0										
						4.5										

method AD auger drilling* AS auger screwing* HA hand auger W washbore HA hand auger	support M mud C casing N nil	samples & field tests B bulk disturbed sample D disturbed sample E environmental sample SS split spoon sample U## undisturbed sample ##mm diameter HP hand penetrometer (kPa) N standard penetration test (SPT) N* SPT - sample recovered Nc SPT with solid cone VS vane shear; peak/remoulded (kPa) R refusal HB hammer bouncing	classification symbol & soil description based on Unified Classification System	consistency / relative density VS very soft S soft F firm St stiff VSt very stiff H hard Fb friable VL very loose L loose MD medium dense D dense VD very dense
* bit shown by suffix e.g. AD/T B blank bit T TC bit V V bit	penetration 	moisture D dry M moist W wet S saturated Wp plastic limit WL liquid limit		

Engineering Log - Hand Auger

client: **THE LAKES (2012) LIMITED**

principal:

project: **THE LAKES, STAGE 3I GCR**

location: **CENTRE OF LOT 562**

Borehole ID. **HAL562**

sheet: 1 of 1

project no. **773-GENZTAUC13086AP**

date started: **10 Oct 2017**

date completed: **10 Oct 2017**

logged by: **SBG**

checked by: **DBC**

position: Not Specified surface elevation: Not Specified angle from horizontal: 90° DCP id.:
drill model: Hand Auger drilling fluid: hole diameter : 50 mm vane id.: SL817

drilling information					material substance																		
method & support	penetration			water	samples & field tests	RL (m)	depth (m)	graphic log	classification symbol	material description	moisture condition	consistency / relative density	vane shear			DCP (blows/ 100 mm)	structure and additional observations						
	1	2	3										⊕ remoulded	⊙ peak	(kPa)								
HA	N		Not Encountered	VS 129/ 43 kPa		0.5			ORGANIC SILT: non plastic, dark brown black.	D to M							TOPSOIL						
				VS 165/ 48 kPa					Silty CLAY: low to medium plasticity, brown orange.									M	VSt	⊕	⊙	FILL	
				VS 215 kPa					Clayey SILT: low plasticity, pale brown orange mottled pink white black, trace fine to medium grained sand.											H	⊕		⊙
				VS 215 kPa																	⊙		
				VS 215 kPa																	⊙		
				VS >247 kPa					⊙									⊙					
				VS 176/ 95 kPaUTP					VS >247 kPa									⊙					
				VS 247 kPa					⊙														
				VS 247 kPa					⊙														
																							3.0
3.5																							
4.0																							
4.5																							

method AD auger drilling* AS auger screwing* HA hand auger W washbore HA hand auger	support M mud C casing N nil	samples & field tests B bulk disturbed sample D disturbed sample E environmental sample SS split spoon sample U## undisturbed sample ##mm diameter HP hand penetrometer (kPa) N standard penetration test (SPT) N* SPT - sample recovered Nc SPT with solid cone VS vane shear; peak/remoulded (kPa) R refusal HB hammer bouncing	classification symbol & soil description based on Unified Classification System	consistency / relative density VS very soft S soft F firm St stiff VSt very stiff H hard Fb friable VL very loose L loose MD medium dense D dense VD very dense
penetration no resistance ranging to refusal	water 10-Oct-12 water level on date shown water inflow water outflow	moisture D dry M moist W wet S saturated Wp plastic limit WL liquid limit		

* bit shown by suffix
e.g.
AD/T
B blank bit
T TC bit
V V bit

Engineering Log - Hand Auger

client: **THE LAKES (2012) LIMITED**

principal:

project: **THE LAKES, STAGE 3I GCR**

location: **BOUNDARY OF LOT 562 AND 563**

Borehole ID. **HAL562-563**

sheet: 1 of 1

project no. **773-GENZTAUC13086AP**

date started: **10 Oct 2017**

date completed: **10 Oct 2017**

logged by: **SBG**

checked by: **DBC**

position: Not Specified surface elevation: Not Specified angle from horizontal: 90° DCP id.:
drill model: Hand Auger drilling fluid: hole diameter : 50 mm vane id.: SV817

drilling information						material substance										
method & support	penetration			water	samples & field tests	RL (m)	depth (m)	graphic log	classification symbol	material description SOIL TYPE: plasticity or particle characteristic, colour, secondary and minor components	moisture condition	consistency / relative density	vane shear		DCP (blows/ 100 mm)	structure and additional observations
	1	2	3										remoulded	peak		
HA	N		Not Encountered	VS >247 kPa		0.5			ORGANIC SILT: non plastic, dark brown black.	D to M						TOPSOIL
				VS 198/ 69 kPa		1.0			Clayey SILT: low to medium plasticity, brown orange.	M	St				FILL	
				VS 247 kPa		1.5			1.0 m: becoming pale brown mottled black white		VSt					
				VS 247 kPa		2.0										
				VS 209/ 76 kPa		2.5			Silty CLAY: medium plasticity, pale brown grey mottled dark brown, trace fine to medium grained sand.	M to W	St to VSt					
				VS 179/ 61 kPa		3.0										
				VS 213/ 66 kPa		3.5										
						4.0										
						4.5										
										Hand Auger HAL562-563 terminated at 3.0 m Target depth						

method AD auger drilling* AS auger screwing* HA hand auger W washbore HA hand auger	support M mud C casing N nil	penetration 	samples & field tests B bulk disturbed sample D disturbed sample E environmental sample SS split spoon sample U## undisturbed sample ##mm diameter HP hand penetrometer (kPa) N standard penetration test (SPT) N* SPT - sample recovered Nc SPT with solid cone VS vane shear, peak/remoulded (kPa) R refusal HB hammer bouncing	classification symbol & soil description based on Unified Classification System	consistency / relative density VS very soft S soft F firm St stiff VSt very stiff H hard Fb friable VL very loose L loose MD medium dense D dense VD very dense
moisture D dry M moist W wet S saturated Wp plastic limit WL liquid limit					

* bit shown by suffix
e.g.
AD/T
B blank bit
T TC bit
V V bit

Engineering Log - Hand Auger

client: **THE LAKES (2012) LIMITED**

principal:

project: **THE LAKES, STAGE 3I GCR**

location: **CENTRE OF LOT 563**

Borehole ID. **HAL563**

sheet: 1 of 1

project no. **773-GENZTAUC13086AP**

date started: **10 Oct 2017**

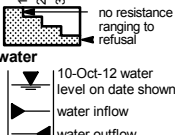
date completed: **10 Oct 2017**

logged by: **ODS**

checked by: **DBC**

position: Not Specified surface elevation: Not Specified angle from horizontal: 90° DCP id.:
drill model: Hand Auger drilling fluid: hole diameter : 50 mm vane id.: SL588

drilling information					material substance								
method & support	penetration	water	samples & field tests	RL (m)	depth (m)	graphic log	classification symbol	material description	moisture condition	consistency / relative density	vane shear ⊕ remoulded ⊙ peak (kPa)	DCP (blows/ 100 mm)	structure and additional observations
HA N	1 2 3							ORGANIC SILT: non plastic, dark brown black.	D to M				TOPSOIL
			VS 164/ 49 kPa		0.5			SILT: low plasticity, orange brown mottled brown grey, trace to minor fine to medium grained sand, minor clay.		VSt to H	⊕ ⊙		FILL
		Not Encountered	VS 213 kPa		1.0							⊙	
			VS 213 kPa		1.5						⊙		
			VS 180 kPa		2.0			SILT: low plasticity, orange brown, trace fine grained sand, trace fine grained pumice, trace sub rounded gravel.			⊙		
			VS 213 kPa		2.5			2.5 m: becoming slightly mottled grey			⊕ ⊙		
			VS 109/ 72 kPa		3.0						⊕ ⊙		
			VS 213 kPa		3.5						⊙		
					4.0								
					4.5								
								Hand Auger HAL563 terminated at 3.0 m Target depth					

method AD auger drilling* AS auger screwing* HA hand auger W washbore HA hand auger	support M mud C casing N nil	samples & field tests B bulk disturbed sample D disturbed sample E environmental sample SS split spoon sample U## undisturbed sample ##mm diameter HP hand penetrometer (kPa) N standard penetration test (SPT) N* SPT - sample recovered Nc SPT with solid cone VS vane shear; peak/remoulded (kPa) R refusal HB hammer bouncing	classification symbol & soil description based on Unified Classification System	consistency / relative density VS very soft S soft F firm St stiff VSt very stiff H hard Fb friable VL very loose L loose MD medium dense D dense VD very dense
* bit shown by suffix e.g. AD/T B blank bit T TC bit V V bit	penetration 		moisture D dry M moist W wet S saturated Wp plastic limit Wl liquid limit	

Engineering Log - Hand Auger

client: **THE LAKES (2012) LIMITED**

principal:

project: **THE LAKES, STAGE 3I GCR**

location: **BOUNDARY OF LOT 563 AND 564**

Borehole ID. **HAL563-564**

sheet: 1 of 1

project no. **773-GENZTAUC13086AP**

date started: **10 Oct 2017**

date completed: **10 Oct 2017**

logged by: **PRM**

checked by: **DBC**

position: Not Specified surface elevation: Not Specified angle from horizontal: 90° DCP id.:
drill model: Hand Auger drilling fluid: hole diameter : 50 mm vane id.: VH1447

drilling information							material substance								
method & support	penetration		water	samples & field tests	RL (m)	depth (m)	graphic log	classification symbol	material description	moisture condition	consistency / relative density	vane shear ⊕ remoulded ⊙ peak (kPa) 100 150 200	DCP (blows/ 100 mm)	structure and additional observations	
HA N	1	2	Not Encountered	VS UTP		0.5			ORGANIC SILT: non plastic, dark brown black.	M	VSt to H	VS UTP	</		

method AD auger drilling* AS auger screwing* HA hand auger W washbore HA hand auger	support M mud C casing N nil	samples & field tests B bulk disturbed sample D disturbed sample E environmental sample SS split spoon sample U## undisturbed sample ##mm diameter HP hand penetrometer (kPa) N standard penetration test (SPT) N* SPT - sample recovered Nc SPT with solid cone VS vane shear; peak/remoulded (kPa) R refusal HB hammer bouncing	classification symbol & soil description based on Unified Classification System	consistency / relative density VS very soft S soft F firm St stiff VSt very stiff H hard Fb friable VL very loose L loose MD medium dense D dense VD very dense
* bit shown by suffix e.g. AD/T B blank bit T TC bit V V bit	penetration 		moisture D dry M moist W wet S saturated Wp plastic limit Wl liquid limit	

Engineering Log - Hand Auger

client: **THE LAKES (2012) LIMITED**

principal:

project: **THE LAKES, STAGE 3I GCR**

location: **CENTRE OF LOT 564**

Borehole ID. **HAL564**

sheet: 1 of 1

project no. **773-GENZTAUC13086AP**

date started: **10 Oct 2017**

date completed: **10 Oct 2017**

logged by: **ODS**

checked by: **DBC**

position: Not Specified surface elevation: Not Specified angle from horizontal: 90° DCP id.:
drill model: Hand Auger drilling fluid: hole diameter : 50 mm vane id.: SL588

drilling information					material substance									
method & support	penetration	water	samples & field tests	RL (m)	depth (m)	graphic log	classification symbol	material description	moisture condition	consistency / relative density	vane shear ⊕ remoulded ⊙ peak (kPa)	DCP (blows/ 100 mm)	structure and additional observations	
HA N	1 2 3							ORGANIC SILT: non plastic, dark brown black.	D to M	H			TOPSOIL	
			VS >213 kPa		0.5			SILT: non plastic, brown mottled orange brown grey, trace to minor fine to medium grained sand, trace to minor clay.		VSt		⊙		FILL
			VS >247 kPa		1.0							⊙		
			VS UTP		1.5						H	VS UTP		
			VS 179/ 61 kPa		2.0			SILT: low plasticity, orange brown, minor clay, trace fine to medium grained sand, trace fine grained pumice, trace sub rounded gravel.	VSt to H		⊕	⊙		
			VS >213 kPa		2.5								⊙	
			VS 134/ 58 kPa		3.0								⊕	⊙
			VS >213 kPa		3.5									
					4.0									
					4.5									
								Hand Auger HAL564 terminated at 3.0 m Target depth						

method AD auger drilling* AS auger screwing* HA hand auger W washbore HA hand auger	support M mud C casing N nil	samples & field tests B bulk disturbed sample D disturbed sample E environmental sample SS split spoon sample U## undisturbed sample ##mm diameter HP hand penetrometer (kPa) N standard penetration test (SPT) N* SPT - sample recovered Nc SPT with solid cone VS vane shear; peak/remoulded (kPa) R refusal HB hammer bouncing	classification symbol & soil description based on Unified Classification System	consistency / relative density VS very soft S soft F firm St stiff VSt very stiff H hard Fb friable VL very loose L loose MD medium dense D dense VD very dense
* bit shown by suffix e.g. AD/T B blank bit T TC bit V V bit	penetration 		moisture D dry M moist W wet S saturated Wp plastic limit Wl liquid limit	

Engineering Log - Hand Auger

client: **THE LAKES (2012) LIMITED**

principal:

project: **THE LAKES, STAGE 3I GCR**

location: **BOUNDARY OF LOT 564 AND 565**

Borehole ID. **HAL564-565**

sheet: 1 of 1

project no. **773-GENZTAUC13086AP**

date started: **10 Oct 2017**

date completed: **10 Oct 2017**

logged by: **SBG**

checked by: **DBC**

position: Not Specified surface elevation: Not Specified angle from horizontal: 90° DCP id.:
drill model: Hand Auger drilling fluid: hole diameter : 50 mm vane id.: SV817

drilling information				material substance									
method & support	penetration	water	samples & field tests	RL (m)	depth (m)	graphic log	classification symbol	material description	moisture condition	consistency / relative density	vane shear remoulded peak (kPa)	DCP (blows/ 100 mm)	structure and additional observations
HA	1	Not Encountered	VS >247 kPa		0.5			ORGANIC SILT: non plastic, Dark brown black.	D to M				TOPSOIL
	2		VS UTP					Clayey SILT: low plasticity, brown orange mottled black dark brown and white.	M	H			FILL
	3		VS UTP		1.0			Silty CLAY: medium plasticity, brown orange mottled black dark brown, trace fine to medium grained sand.	W	St to VSt	VS UTP		
			VS UTP		1.5						VS UTP		
			VS 227/ 72 kPa		2.0			Clayey SILT: medium plasticity, brown orange, trace fine to medium grained sand.	M				
			VS 107/ 61 kPa		2.5			Silty CLAY: medium plasticity, dark brown mottled orange black blue, trace fine to medium grained sand.					
			VS 116/ 61 kPa		3.0								
			VS 114/ 58 kPa		3.0			Hand Auger HAL564-565 terminated at 3.0 m Target depth					
					3.5								
					4.0								
					4.5								

method AD auger drilling* AS auger screwing* HA hand auger W washbore HA hand auger	support M mud C casing N nil	penetration no resistance ranging to refusal 10-Oct-12 water level on date shown water inflow water outflow	samples & field tests B bulk disturbed sample D disturbed sample E environmental sample SS split spoon sample U## undisturbed sample ##mm diameter HP hand penetrometer (kPa) N standard penetration test (SPT) N* SPT - sample recovered Nc SPT with solid cone VS vane shear; peak/remoulded (kPa) R refusal HB hammer bouncing	classification symbol & soil description based on Unified Classification System	consistency / relative density VS very soft S soft F firm St stiff VSt very stiff H hard Fb friable VL very loose L loose MD medium dense D dense VD very dense
moisture D dry M moist W wet S saturated Wp plastic limit WL liquid limit					

* bit shown by suffix
e.g.
AD/T
B blank bit
T TC bit
V V bit

Engineering Log - Hand Auger

client: **THE LAKES (2012) LIMITED**

principal:

project: **THE LAKES, STAGE 3I GCR**

location: **CENTRE OF LOT 565**

Borehole ID. **HAL565**

sheet: 1 of 1

project no. **773-GENZTAUC13086AP**

date started: **10 Oct 2017**

date completed: **10 Oct 2017**

logged by: **PRM**

checked by: **DBC**

position: Not Specified surface elevation: Not Specified angle from horizontal: 90° DCP id.:
drill model: Hand Auger drilling fluid: hole diameter : 50 mm vane id.: VH1447

drilling information				material substance									
method & support	penetration	water	samples & field tests	RL (m)	depth (m)	graphic log	classification symbol	material description	moisture condition	consistency / relative density	vane shear remoulded peak (kPa)	DCP (blows/ 100 mm)	structure and additional observations
HA	1	Not Encountered	VS 144/ 29 kPa		0.5			ORGANIC SILT: non plastic, dark brown black.	M	VSt to H			TOPSOIL
	2		VS 140/ 25 kPa		1.0			Clayey SILT: non plastic, pale brown, minor fine grained sand.					FILL
	3		VS UTP		1.5			Clayey SILT: low plasticity, brown mottled pale brown.					
			VS 166/ 39 kPa		2.0			SILT: non plastic, brown, minor fine to medium grained sand.					
			VS UTP		2.5			Clayey SILT: low plasticity, brown mottled pale brown.					
			VS UTP		3.0			Hand Auger HAL565 terminated at 3.0 m Target depth					

method AD auger drilling* AS auger screwing* HA hand auger W washbore HA hand auger	support M mud C casing N nil	penetration 	samples & field tests B bulk disturbed sample D disturbed sample E environmental sample SS split spoon sample U## undisturbed sample ##mm diameter HP hand penetrometer (kPa) N standard penetration test (SPT) N* SPT - sample recovered Nc SPT with solid cone VS vane shear; peak/remoulded (kPa) R refusal HB hammer bouncing	classification symbol & soil description based on Unified Classification System	consistency / relative density VS very soft S soft F firm St stiff VSt very stiff H hard Fb friable VL very loose L loose MD medium dense D dense VD very dense
moisture D dry M moist W wet S saturated Wp plastic limit WL liquid limit					

* bit shown by suffix
e.g.
AD/T
B blank bit
T TC bit
V V bit

Engineering Log - Hand Auger

client: **THE LAKES (2012) LIMITED**

principal:

project: **THE LAKES, STAGE 3I GCR**

location: **BOUNDARY OF LOT 565 AND 566**

Borehole ID. **HAL565-566**

sheet: 1 of 1

project no. **773-GENZTAUC13086AP**

date started: **10 Oct 2017**

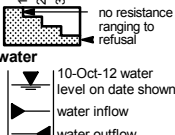
date completed: **10 Oct 2017**

logged by: **SBG**

checked by: **DBC**

position: Not Specified surface elevation: Not Specified angle from horizontal: 90° DCP id.:
drill model: Hand Auger drilling fluid: hole diameter : 50 mm vane id.: VH4523

drilling information					material substance									
method & support	penetration	water	samples & field tests	RL (m)	depth (m)	graphic log	classification symbol	material description	moisture condition	consistency / relative density	vane shear (kPa)	DCP (blows/100 mm)	structure and additional observations	
HA	1	Not Encountered	VS 149/42 kPa		0.5			ORGANIC SILT: non plastic, dark brown black.	D to M				TOPSOIL	
	2		VS 140/35 kPa		1.0			Clayey SILT: low to medium plasticity, brown orange mottled white black grey.	M	VSt			FILL	
	3		VS 143/42 kPa		1.5			Silty CLAY: low to medium plasticity, brown orange mottled black white.						
			VS 172/60 kPa		2.0			SILT: non plastic, brown orange.		H				
			VS 224 kPa		2.5			Hand Auger HAL565-566 terminated at 2.0 m Target depth						
			VS 224 kPa		3.0									
					3.5									
					4.0									
					4.5									

method AD auger drilling* AS auger screwing* HA hand auger W washbore HA hand auger	support M mud C casing N nil	samples & field tests B bulk disturbed sample D disturbed sample E environmental sample SS split spoon sample U## undisturbed sample ##mm diameter HP hand penetrometer (kPa) N standard penetration test (SPT) N* SPT - sample recovered Nc SPT with solid cone VS vane shear; peak/remoulded (kPa) R refusal HB hammer bouncing	classification symbol & soil description based on Unified Classification System	consistency / relative density VS very soft S soft F firm St stiff VSt very stiff H hard Fb friable VL very loose L loose MD medium dense D dense VD very dense
* bit shown by suffix e.g. AD/T B blank bit T TC bit V V bit	penetration 		moisture D dry M moist W wet S saturated Wp plastic limit Wl liquid limit	

Engineering Log - Hand Auger

client: **THE LAKES (2012) LIMITED**

principal:

project: **THE LAKES, STAGE 3I GCR**

location: **CENTRE OF LOT 566**

Borehole ID. **HAL566**

sheet: 1 of 1

project no. **773-GENZTAUC13086A**

date started: **12 Oct 2017**

date completed: **12 Oct 2017**

logged by: **PRM**

checked by: **DBC**

position: Not Specified surface elevation: Not Specified angle from horizontal: 90° DCP id.:
drill model: Hand Auger drilling fluid: hole diameter : 50 mm vane id.: 1447

drilling information					material substance									
method & support	penetration	water	samples & field tests	RL (m)	depth (m)	graphic log	classification symbol	material description	moisture condition	consistency / relative density	vane shear (kPa)	DCP (blows/100 mm)	structure and additional observations	
HA	1 2 3	Not Encountered	VS UTP		0.5			ORGANIC SILT: non plastic, dark brown-black.	D to M				TOPSOIL	
			VS UTP		1.0			Clayey SILT: low plasticity, pale brown.	M	H			FILL	
					1.0			SILTY SAND: fine to medium grained, grey-brown.		MD to D				
					1.0			refusal on gravel						
					1.0			Hand Auger HAL566 terminated at 1.0 m Refusal					DCP REFUSAL	

method AD auger drilling* AS auger screwing* HA hand auger W washbore HA hand auger	support M mud C casing N nil	penetration 	samples & field tests B bulk disturbed sample D disturbed sample E environmental sample SS split spoon sample U## undisturbed sample ##mm diameter HP hand penetrometer (kPa) N standard penetration test (SPT) N* SPT - sample recovered Nc SPT with solid cone VS vane shear; peak/remoulded (kPa) R refusal HB hammer bouncing	classification symbol & soil description based on Unified Classification System	consistency / relative density VS very soft S soft F firm St stiff VSt very stiff H hard Fb friable VL very loose L loose MD medium dense D dense VD very dense
moisture D dry M moist W wet S saturated Wp plastic limit WL liquid limit					

* bit shown by suffix
e.g.
AD/T
B blank bit
T TC bit
V V bit

Engineering Log - Hand Auger

client: **THE LAKES (2012) LIMITED**

principal:

project: **THE LAKES, STAGE 3I GCR**

location: **CENTRE OF LOT 567**

Borehole ID. **HAL567**

sheet: 1 of 1

project no. **773-GENZTAUC13086AP**

date started: **12 Oct 2017**

date completed: **12 Oct 2017**

logged by: **SBG**

checked by: **DBC**

position: Not Specified surface elevation: Not Specified angle from horizontal: 90° DCP id.:
drill model: Hand Auger drilling fluid: hole diameter : 50 mm vane id.: VH4523

drilling information					material substance									
method & support	penetration	water	samples & field tests	RL (m)	depth (m)	graphic log	classification symbol	material description	moisture condition	consistency / relative density	vane shear (kPa)	DCP (blows/100 mm)	structure and additional observations	
HA	1 2 3	Not Encountered	VS 140/37 kPa VS 224 kPa VS UTP		0.5			ORGANIC SILT: non plastic, dark brown black.	D to M				TOPSOIL	
					1.0			Clayey SILT: non plastic to low plasticity, brown orange mottled black white.	M	VSt			FILL	
					1.0			1.0 m: Refused at 3 different locations due to gravel hardfill Hand Auger HAL567 terminated at 1.0 m Refusal		H				
					1.5									
					2.0									
					2.5									
					3.0									
					3.5									
					4.0									
					4.5									

method AD auger drilling* AS auger screwing* HA hand auger W washbore HA hand auger	support M mud C casing N nil	samples & field tests B bulk disturbed sample D disturbed sample E environmental sample SS split spoon sample U## undisturbed sample ##mm diameter HP hand penetrometer (kPa) N standard penetration test (SPT) N* SPT - sample recovered Nc SPT with solid cone VS vane shear; peak/remoulded (kPa) R refusal HB hammer bouncing	classification symbol & soil description based on Unified Classification System	consistency / relative density VS very soft S soft F firm St stiff VSt very stiff H hard Fb friable VL very loose L loose MD medium dense D dense VD very dense
* bit shown by suffix e.g. AD/T B blank bit T TC bit V V bit	penetration  no resistance ranging to refusal water 10-Oct-12 water level on date shown water inflow water outflow		moisture D dry M moist W wet S saturated Wp plastic limit Wl liquid limit	

Engineering Log - Hand Auger

client: **THE LAKES (2012) LIMITED**

principal:

project: **THE LAKES, STAGE 3I GCR**

location: **BOUNDARY OF LOT 567 AND 568**

Borehole ID. **HAL567-568**

sheet: 1 of 1

project no. **773-GENZTAUC13086AP**

date started: **12 Oct 2017**

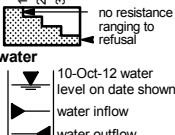
date completed: **12 Oct 2017**

logged by: **PRM**

checked by: **DBC**

position: Not Specified surface elevation: Not Specified angle from horizontal: 90° DCP id.:
drill model: Hand Auger drilling fluid: hole diameter : 50 mm vane id.: 1447

drilling information					material substance									
method & support	1 penetration	2 water	samples & field tests	RL (m)	depth (m)	graphic log	classification symbol	material description	moisture condition	consistency / relative density	vane shear remoulded peak (kPa)	DCP (blows/100 mm)	structure and additional observations	
HA	1		VS UTP		0.5			ORGANIC SILT: non plastic, dark brown-black.	M	H			TOPSOIL	
	2		VS UTP		1.0			Clayey SILT: low plasticity, brown.					FILL	
	3		VS UTP		1.5									
			VS UTP		2.0			Hand Auger HAL567-568 terminated at 2.0 m Target depth						
					2.5									
					3.0									
					3.5									
					4.0									
					4.5									

method AD auger drilling* AS auger screwing* HA hand auger W washbore HA hand auger	support M mud C casing N nil	samples & field tests B bulk disturbed sample D disturbed sample E environmental sample SS split spoon sample U## undisturbed sample ##mm diameter HP hand penetrometer (kPa) N standard penetration test (SPT) N* SPT - sample recovered Nc SPT with solid cone VS vane shear; peak/remoulded (kPa) R refusal HB hammer bouncing	classification symbol & soil description based on Unified Classification System	consistency / relative density VS very soft S soft F firm St stiff VSt very stiff H hard Fb friable VL very loose L loose MD medium dense D dense VD very dense
* bit shown by suffix e.g. AD/T B blank bit T TC bit V V bit	penetration 		moisture D dry M moist W wet S saturated Wp plastic limit Wl liquid limit	

Engineering Log - Hand Auger

client: **THE LAKES (2012) LIMITED**

principal:

project: **THE LAKES, STAGE 3I GCR**

location: **BOUNDARY OF LOT 568 AND 569**

Borehole ID. **HAL568-569**

sheet: 1 of 1

project no. **773-GENZTAUC13086AP**

date started: **12 Oct 2017**

date completed: **12 Oct 2017**

logged by: **PRM**

checked by: **DBC**

position: Not Specified surface elevation: Not Specified angle from horizontal: 90° DCP id.:
drill model: Hand Auger drilling fluid: hole diameter : 50 mm vane id.: 1447

drilling information					material substance									
method & support	penetration	water	samples & field tests	RL (m)	depth (m)	graphic log	classification symbol	material description	moisture condition	consistency / relative density	vane shear remoulded peak (kPa)	DCP (blows/ 100 mm)	structure and additional observations	
HA	1 2 3	Not Encountered	VS UTP VS UTP		0.5			ORGANIC SILT: non plastic, black.	D to M	H			TOPSOIL	
								SILT: non plastic, pale grey brown, with minor fine grained sand and with trace clay.	M		VS UTP		FILL	
					1.0			1.0 m: Refusal due to gravel obstruction in hole Hand Auger HAL568-569 terminated at 1.0 m Refusal			VS UTP			
					1.5									
					2.0									
					2.5									
					3.0									
					3.5									
					4.0									
					4.5									

method AD auger drilling* AS auger screwing* HA hand auger W washbore HA hand auger * bit shown by suffix e.g. AD/T B blank bit T TC bit V V bit	support M mud N nil C casing penetration no resistance ranging to refusal water 10-Oct-12 water level on date shown water inflow water outflow	samples & field tests B bulk disturbed sample D disturbed sample E environmental sample SS split spoon sample U## undisturbed sample ##mm diameter HP hand penetrometer (kPa) N standard penetration test (SPT) N* SPT - sample recovered Nc SPT with solid cone VS vane shear; peak/remoulded (kPa) R refusal HB hammer bouncing	classification symbol & soil description based on Unified Classification System moisture D dry M moist W wet S saturated Wp plastic limit Wl liquid limit	consistency / relative density VS very soft S soft F firm St stiff VSt very stiff H hard Fb friable VL very loose L loose MD medium dense D dense VD very dense
--	---	--	---	--

Engineering Log - Hand Auger

client: **THE LAKES (2012) LIMITED**

principal:

project: **THE LAKES, STAGE 3I GCR**

location: **CENTRE OF LOT 569**

Borehole ID. **HAL569**

sheet: 1 of 1

project no. **773-GENZTAUC13086AP**

date started: **11 Oct 2017**

date completed: **11 Oct 2017**

logged by: **ODS**

checked by: **DBC**

position: Not Specified surface elevation: Not Specified angle from horizontal: 90° DCP id.:
drill model: Hand Auger drilling fluid: hole diameter : 50 mm vane id.: SL588

drilling information							material substance	
method & support	penetration			water	samples & field tests	RL (m)	depth (m)	graphic log	classification symbol	material description	moisture condition	consistency / relative density	vane shear			DCP (blows/ 100 mm)	structure and additional observations	
	1	2	3										remoulded	peak	(kPa)	
HA	N			Not Encountered	VS >213 kPa		0.5			ORGANIC SILT: non plastic, dark brown-black.	D to M	H				TOPSOIL	
										SILT: non plastic, orange mottled brown, with trace clay and trace fine to medium grained sand.							M	VSt	

method AD auger drilling* AS auger screwing* HA hand auger W washbore HA hand auger	support M mud C casing N nil	samples & field tests B bulk disturbed sample D disturbed sample E environmental sample SS split spoon sample U## undisturbed sample ##mm diameter HP hand penetrometer (kPa) N standard penetration test (SPT) N* SPT - sample recovered Nc SPT with solid cone VS vane shear; peak/remoulded (kPa) R refusal HB hammer bouncing	classification symbol & soil description based on Unified Classification System	consistency / relative density VS very soft S soft F firm St stiff VSt very stiff H hard Fb friable VL very loose L loose MD medium dense D dense VD very dense
* bit shown by suffix e.g. AD/T B blank bit T TC bit V V bit	penetration 		moisture D dry M moist W wet S saturated Wp plastic limit WL liquid limit	

Engineering Log - Hand Auger

client: **THE LAKES (2012) LIMITED**

principal:

project: **THE LAKES, STAGE 3I GCR**

location: **BOUNDARY OF LOT 569 AND 570**

Borehole ID. **HAL569-570**

sheet: 1 of 1

project no. **773-GENZTAUC13086A**

date started: **12 Oct 2017**

date completed: **12 Oct 2017**

logged by: **SBG**

checked by: **DBC**

position: Not Specified surface elevation: Not Specified angle from horizontal: 90° DCP id.:
drill model: Hand Auger drilling fluid: hole diameter : 50 mm vane id.:

drilling information				material substance									
method & support	penetration	water	samples & field tests	RL (m)	depth (m)	graphic log	classification symbol	material description	moisture condition	consistency / relative density	vane shear (kPa)	DCP (blows/100 mm)	structure and additional observations
HA	1							ORGANIC SILT: non plastic, dark brown black.	D to M				TOPSOIL
	2				0.5			SILTY SAND: fine to medium grained, brown orange.	M	L to MD			FILL
	3				1.0								
					1.5								
					2.0			Hand Auger HAL569-570 terminated at 2.0 m Target depth					
					2.5								
					3.0								
					3.5								
					4.0								
					4.5								

method AD auger drilling* AS auger screwing* HA hand auger W washbore HA hand auger	support M mud C casing N nil	samples & field tests B bulk disturbed sample D disturbed sample E environmental sample SS split spoon sample U## undisturbed sample ##mm diameter HP hand penetrometer (kPa) N standard penetration test (SPT) N* SPT - sample recovered Nc SPT with solid cone VS vane shear; peak/remoulded (kPa) R refusal HB hammer bouncing	classification symbol & soil description based on Unified Classification System	consistency / relative density VS very soft S soft F firm St stiff VSt very stiff H hard Fb friable VL very loose L loose MD medium dense D dense VD very dense
* bit shown by suffix e.g. AD/T B blank bit T TC bit V V bit	penetration 		moisture D dry M moist W wet S saturated Wp plastic limit WL liquid limit	

Engineering Log - Hand Auger

client: **THE LAKES (2012) LIMITED**

principal:

project: **THE LAKES, STAGE 3I GCR**

location: **CENTRE OF LOT 570**

Borehole ID. **HAL570**

sheet: 1 of 1

project no. **773-GENZTAUC13086A**

date started: **12 Oct 2017**

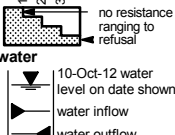
date completed: **12 Oct 2017**

logged by: **PRM**

checked by: **DBC**

position: Not Specified surface elevation: Not Specified angle from horizontal: 90° DCP id.:
drill model: Hand Auger drilling fluid: hole diameter : 50 mm vane id.:

drilling information				material substance									
method & support	penetration	water	samples & field tests	RL (m)	depth (m)	graphic log	classification symbol	material description	moisture condition	consistency / relative density	vane shear (kPa)	DCP (blows/100 mm)	structure and additional observations
HA	1 2 3	Not Encountered			0.5			ORGANIC SILT: non plastic, dark brown black.	D to M				TOPSOIL
					1.0			Clayey SILT: non plastic, pale orange brown, minor fine grained sand.	M				FILL
					1.5			1.2 m: Refused at 3 different locations due to gravel hardfill Hand Auger HAL570 terminated at 1.2 m Refusal					BOUNCING/DCP REFUSAL
					2.0								
					2.5								
					3.0								
					3.5								
					4.0								
					4.5								

method AD auger drilling* AS auger screwing* HA hand auger W washbore HA hand auger	support M mud C casing N nil	samples & field tests B bulk disturbed sample D disturbed sample E environmental sample SS split spoon sample U## undisturbed sample ##mm diameter HP hand penetrometer (kPa) N standard penetration test (SPT) N* SPT - sample recovered Nc SPT with solid cone VS vane shear; peak/remoulded (kPa) R refusal HB hammer bouncing	classification symbol & soil description based on Unified Classification System	consistency / relative density VS very soft S soft F firm St stiff VSt very stiff H hard Fb friable VL very loose L loose MD medium dense D dense VD very dense
* bit shown by suffix e.g. AD/T B blank bit T TC bit V V bit	penetration 		moisture D dry M moist W wet S saturated Wp plastic limit Wl liquid limit	

Engineering Log - Hand Auger

client: **THE LAKES (2012) LIMITED**

principal:

project: **THE LAKES, STAGE 3I GCR**

location: **BOUNDARY OF LOT 570 AND 571**

Borehole ID. **HAL570-571**

sheet: 1 of 1

project no. **773-GENZTAUC13086A**

date started: **12 Oct 2017**

date completed: **12 Oct 2017**

logged by: **SBG**

checked by: **DBC**

position: Not Specified surface elevation: Not Specified angle from horizontal: 90° DCP id.:
drill model: Hand Auger drilling fluid: hole diameter : 50 mm vane id.: VH4523

drilling information				material substance									
method & support	penetration	water	samples & field tests	RL (m)	depth (m)	graphic log	classification symbol	material description	moisture condition	consistency / relative density	vane shear (kPa)	DCP (blows/100 mm)	structure and additional observations
HA	1 2 3	Not Encountered	VS 224 kPa VS 175/36 kPa VS UTP		0.5			ORGANIC SAND: non plastic, dark brown black. Clayey SILT: low plasticity, brown orange mottled dark brown white black, trace fine to medium grained sand.	D to M M	VSt to H	50 100 150 200	2 4 6 8 10	TOPSOIL FILL
					1.0			1.0 m: Refused at 3 different locations due to gravel hardfill Hand Auger HAL570-571 terminated at 1.0 m Refusal					BOUNCING/DCP REFUSAL
					1.5								
					2.0								
					2.5								
					3.0								
					3.5								
					4.0								
					4.5								

method AD auger drilling* AS auger screwing* HA hand auger W washbore HA hand auger	support M mud C casing N nil	samples & field tests B bulk disturbed sample D disturbed sample E environmental sample SS split spoon sample U## undisturbed sample ##mm diameter HP hand penetrometer (kPa) N standard penetration test (SPT) N* SPT - sample recovered Nc SPT with solid cone VS vane shear; peak/remoulded (kPa) R refusal HB hammer bouncing	classification symbol & soil description based on Unified Classification System	consistency / relative density VS very soft S soft F firm St stiff VSt very stiff H hard Fb friable VL very loose L loose MD medium dense D dense VD very dense
* bit shown by suffix e.g. AD/T B blank bit T TC bit V V bit	penetration water 10-Oct-12 water level on date shown water inflow water outflow		moisture D dry M moist W wet S saturated Wp plastic limit Wl liquid limit	

Engineering Log - Hand Auger

client: **THE LAKES (2012) LIMITED**

principal:

project: **THE LAKES, STAGE 3I GCR**

location: **CENTRE OF LOT 571**

Borehole ID. **HAL571**

sheet: 1 of 1

project no. **773-GENZTAUC13086AP**

date started: **11 Oct 2017**

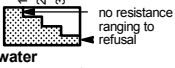
date completed: **11 Oct 2017**

logged by: **ODS**

checked by: **DBC**

position: Not Specified surface elevation: Not Specified angle from horizontal: 90° DCP id.:
drill model: Hand Auger drilling fluid: hole diameter : 50 mm vane id.: SL588

drilling information					material substance											
method & support	penetration		water	samples & field tests	RL (m)	depth (m)	graphic log	classification symbol	material description	moisture condition	consistency / relative density	vane shear		DCP (blows/ 100 mm)	structure and additional observations	
	1	2										remoulded	peak			
HA N	1	2							ORGANIC SAND: non plastic, dark brown black.	D to M		50	100		TOPSOIL	
	3			VS >213 kPa	0.5			SILT: low plasticity, orange mottled brown, with minor clay, and trace fine grained sand.	H							
				VS >213 kPa	1.0											
				VS 161/ 46 kPa	1.5				VSt							
				VS 147/ 37 kPa	2.0											
				VS >213 kPa	2.5				H							
				VS >213 kPa	3.0											
								Hand Auger HAL571 terminated at 3.0 m Target depth								
		</														

method AD auger drilling* AS auger screwing* HA hand auger W washbore HA hand auger	support M mud C casing N nil	samples & field tests B bulk disturbed sample D disturbed sample E environmental sample SS split spoon sample U## undisturbed sample ##mm diameter HP hand penetrometer (kPa) N standard penetration test (SPT) N* SPT - sample recovered Nc SPT with solid cone VS vane shear; peak/remoulded (kPa) R refusal HB hammer bouncing	classification symbol & soil description based on Unified Classification System	consistency / relative density VS very soft S soft F firm St stiff VSt very stiff H hard Fb friable VL very loose L loose MD medium dense D dense VD very dense
* bit shown by suffix e.g. AD/T B blank bit T TC bit V V bit	penetration  10-Oct-12 water level on date shown water inflow water outflow		moisture D dry M moist W wet S saturated Wp plastic limit WI liquid limit	

Engineering Log - Hand Auger

client: **THE LAKES (2012) LIMITED**

principal:

project: **THE LAKES, STAGE 3I GCR**

location: **BOUNDARY OF LOT 571 AND 572**

Borehole ID. **HAL571-572**

sheet: 1 of 1

project no. **773-GENZTAUC13086A**

date started: **12 Oct 2017**

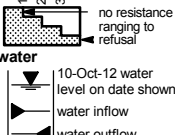
date completed: **12 Oct 2017**

logged by: **PRM**

checked by: **DBC**

position: Not Specified surface elevation: Not Specified angle from horizontal: 90° DCP id.:
drill model: Hand Auger drilling fluid: hole diameter : vane id.:

drilling information						material substance									
method & support	penetration			water	samples & field tests	RL (m)	depth (m)	graphic log	classification symbol	material description	moisture condition	consistency / relative density	vane shear ⊕ remoulded ⊙ peak (kPa)	DCP (blows/ 100 mm)	structure and additional observations
	1	2	3							0.0 m: Refusal on gravel after 3 tries Hand Auger HAL571-572 terminated at 0.0 m Refusal			50 100 150 200	2 4 6 8 10	
				Not Encountered			0.5								
							1.0								
							1.5								
							2.0								
							2.5								
							3.0								
							3.5								
							4.0								
							4.5								

method AD auger drilling* AS auger screwing* HA hand auger W washbore HA hand auger * bit shown by suffix e.g. AD/T B blank bit T TC bit V V bit	support M mud C casing penetration  no resistance ranging to refusal 10-Oct-12 water level on date shown water inflow water outflow	samples & field tests B bulk disturbed sample D disturbed sample E environmental sample SS split spoon sample U## undisturbed sample ##mm diameter HP hand penetrometer (kPa) N standard penetration test (SPT) N* SPT - sample recovered Nc SPT with solid cone VS vane shear; peak/remoulded (kPa) R refusal HB hammer bouncing	classification symbol & soil description based on Unified Classification System moisture D dry M moist W wet S saturated Wp plastic limit Wl liquid limit	consistency / relative density VS very soft S soft F firm St stiff VSt very stiff H hard Fb friable VL very loose L loose MD medium dense D dense VD very dense
--	--	--	---	--

Engineering Log - Hand Auger

client: **THE LAKES (2012) LIMITED**

principal:

project: **THE LAKES, STAGE 3I GCR**

location: **CENTRE OF LOT 572**

Borehole ID. **HAL572**

sheet: 1 of 1

project no. **773-GENZTAUC13086AP**

date started: **12 Oct 2017**

date completed: **12 Oct 2017**

logged by: **PRM**

checked by: **DBC**

position: Not Specified surface elevation: Not Specified angle from horizontal: 90° DCP id.:
drill model: Hand Auger drilling fluid: hole diameter : 50 mm vane id.: SV1447

drilling information				material substance									
method & support	penetration	water	samples & field tests	RL (m)	depth (m)	graphic log	classification symbol	material description	moisture condition	consistency / relative density	vane shear (kPa)	DCP (blows/100 mm)	structure and additional observations
HA N	1	Not Encountered	VS UTP		0.5			ORGANIC SILT: non plastic, dark brown black.	M	H	VS UTP		TOPSOIL
	2							Clayey SILT: low plasticity, brown mottled orange brown, trace fine grained sand.					
	3				1.0								
					1.5								
					2.0			Silty CLAY: low plasticity, pale orange mottled orange, minor fine grained sand.					
					2.5			Clayey SILT: low plasticity, brown mottled orange brown, trace fine grained sand.					
					3.0								
			VS 231/ 51 kPa					Hand Auger HAL572 terminated at 3.0 m Target depth					

method AD auger drilling* AS auger screwing* HA hand auger W washbore HA hand auger	support M mud C casing N nil	samples & field tests B bulk disturbed sample D disturbed sample E environmental sample SS split spoon sample U## undisturbed sample ##mm diameter HP hand penetrometer (kPa) N standard penetration test (SPT) N* SPT - sample recovered Nc SPT with solid cone VS vane shear; peak/remoulded (kPa) R refusal HB hammer bouncing	classification symbol & soil description based on Unified Classification System	consistency / relative density VS very soft S soft F firm St stiff VSt very stiff H hard Fb friable VL very loose L loose MD medium dense D dense VD very dense
* bit shown by suffix e.g. AD/T B blank bit T TC bit V V bit	penetration no resistance ranging to refusal water 10-Oct-12 water level on date shown water inflow water outflow		moisture D dry M moist W wet S saturated Wp plastic limit WI liquid limit	

Engineering Log - Hand Auger

client: **THE LAKES (2012) LIMITED**

principal:

project: **THE LAKES, STAGE 3I GCR**

location: **BOUNDARY OF LOT 572 AND 573**

Borehole ID. **HAL572-573**

sheet: 1 of 1

project no. **773-GENZTAUC13086AP**

date started: **12 Oct 2017**

date completed: **12 Oct 2017**

logged by: **SBG**

checked by: **DBC**

position: Not Specified surface elevation: Not Specified angle from horizontal: 90° DCP id.:
drill model: Hand Auger drilling fluid: hole diameter : 50 mm vane id.: VH4523

drilling information					material substance										
method & support	penetration			water	samples & field tests	RL (m)	depth (m)	graphic log	classification symbol	material description	moisture condition	consistency / relative density	vane shear ⊕ remoulded ⊙ peak (kPa) 0 20 40 60 80 100 120 140 160 180 200	DCP (blows/ 100 mm) 2 4 6 8 10	structure and additional observations
HA	1	2	3	Not Encountered	VS 194/ 41 kPa		0.5			ORGANIC SILT: non plastic, dark brown black.	D to M	VSt to H	⊕	⊙	TOPSOIL
					VS 198/ 35 kPa					SILT: non plastic to low plasticity, brown orange mottled white dark brown black, trace clay, trace fine to medium grained sand.	M		⊕	⊙	
				VS 190/ 37 kPa		1.0						⊕	⊙		
				VS 136/ 32 kPa		1.5						⊕	⊙		
				VS 211/ 55 kPa		2.0				Clayey SILT: low plasticity, pale orange brown, trace fine grained sand.			⊕	⊙	
				VS 211/ 47 kPa		2.5				2.0 m: becoming mottled pink			⊕	⊙	
				VS >224 kPa		3.0							⊕	⊙	
				VS >224 kPa		3.5							⊕	⊙	
				VS >224 kPa		4.0							⊕	⊙	
						4.5				Hand Auger HAL572-573 terminated at 3.0 m Target depth					
							</								

Engineering Log - Hand Auger

client: **THE LAKES (2012) LIMITED**

principal:

project: **THE LAKES, STAGE 3I GCR**

location: **CENTRE OF LOT 573**

Borehole ID. **HAL573**

sheet: 1 of 1

project no. **773-GENZTAUC13086AP**

date started: **12 Oct 2017**

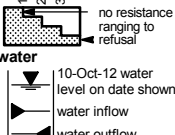
date completed: **12 Oct 2017**

logged by: **ODS**

checked by: **DBC**

position: Not Specified surface elevation: Not Specified angle from horizontal: 90° DCP id.:
drill model: Hand Auger drilling fluid: hole diameter : 50 mm vane id.: SL588

drilling information				material substance									
method & support	1 penetration	2 water	samples & field tests	RL (m)	depth (m)	graphic log	classification symbol	material description	moisture condition	consistency / relative density	vane shear remoulded peak (kPa)	DCP (blows/ 100 mm)	structure and additional observations
HA	1							ORGANIC SILT: non plastic, dark brown black.	D to M	H			TOPSOIL
	2		VS >213 kPa		0.5			SILT: low plasticity, orange-brown mottled brown, with trace to minor clay, and trace fine grained sand.					FILL
	3		VS >213 kPa		1.0			Sandy SILT: non plastic, grey, sand is fine to medium grained.	M				
			VS >213 kPa		1.5								
			VS >213 kPa		2.0			1.7 m: becoming mottled clayey SILT: low plasticity, pink					
			VS 147/ 43 kPa		2.0			Hand Auger HAL573 terminated at 2.0 m Target depth					
					2.5								
					3.0								
					3.5								
					4.0								
					4.5								

method AD auger drilling* AS auger screwing* HA hand auger W washbore HA hand auger	support M mud C casing N nil	penetration 	samples & field tests B bulk disturbed sample D disturbed sample E environmental sample SS split spoon sample U## undisturbed sample ##mm diameter HP hand penetrometer (kPa) N standard penetration test (SPT) N* SPT - sample recovered Nc SPT with solid cone VS vane shear; peak/remoulded (kPa) R refusal HB hammer bouncing	classification symbol & soil description based on Unified Classification System	consistency / relative density VS very soft S soft F firm St stiff VSt very stiff H hard Fb friable VL very loose L loose MD medium dense D dense VD very dense
moisture D dry M moist W wet S saturated Wp plastic limit WL liquid limit					

* bit shown by suffix
e.g.
AD/T
B blank bit
T TC bit
V V bit

Engineering Log - Hand Auger

client: **THE LAKES (2012) LIMITED**

principal:

project: **THE LAKES, STAGE 3I GCR**

location: **BOUNDARY OF LOT 573 AND 574**

Borehole ID. **HAL573-574**

sheet: 1 of 1

project no. **773-GENZTAUC13086AP**

date started: **13 Oct 2017**

date completed: **13 Oct 2017**

logged by: **PRM**

checked by: **DBC**

position: Not Specified surface elevation: Not Specified angle from horizontal: 90° DCP id.:
drill model: Hand Auger drilling fluid: hole diameter : 50 mm vane id.: SL817

drilling information				material substance									
method & support	1 penetration	2 water	samples & field tests	RL (m)	depth (m)	graphic log	classification symbol	material description	moisture condition	consistency / relative density	vane shear remoulded peak (kPa)	DCP (blows/100 mm)	structure and additional observations
HA	1	Not Encountered	VS UTP		0.5			Clayey SILT: non plastic, brown.	M	H			FILL
	2		VS UTP		0.7			0.7 m: becoming slightly plastic					
	3		VS UTP		1.0								
			VS 176/ 30 kPa		1.5			Sandy SILT: non plastic, pale grey-brown, sand is fine to medium grained.	M to W	VSt			MATUA SUBGROUP
			VS 176/ 24 kPa		2.0			Silty CLAY: non plastic, white-grey, with minor fine grained sand.	W				
					2.0			Hand Auger HAL573-574 terminated at 2.0 m Target depth					
					2.5								
					3.0								
					3.5								
					4.0								
					4.5								

method AD auger drilling* AS auger screwing* HA hand auger W washbore HA hand auger	support M mud C casing N nil	samples & field tests B bulk disturbed sample D disturbed sample E environmental sample SS split spoon sample U## undisturbed sample ##mm diameter HP hand penetrometer (kPa) N standard penetration test (SPT) N* SPT - sample recovered Nc SPT with solid cone VS vane shear; peak/remoulded (kPa) R refusal HB hammer bouncing	classification symbol & soil description based on Unified Classification System	consistency / relative density VS very soft S soft F firm St stiff VSt very stiff H hard Fb friable VL very loose L loose MD medium dense D dense VD very dense
* bit shown by suffix e.g. AD/T B blank bit T TC bit V V bit	penetration 		moisture D dry M moist W wet S saturated Wp plastic limit Wl liquid limit	

Engineering Log - Hand Auger

client: **THE LAKES (2012) LIMITED**

principal:

project: **THE LAKES, STAGE 3I GCR**

location: **CENTRE OF LOT 574**

Borehole ID. **HAL574**

sheet: 1 of 1

project no. **773-GENZTAUC13086AP**

date started: **13 Oct 2017**

date completed: **13 Oct 2017**

logged by: **SBG**

checked by: **DBC**

position: Not Specified surface elevation: Not Specified angle from horizontal: 90° DCP id.:
drill model: Hand Auger drilling fluid: hole diameter : 50 mm vane id.: SL817

drilling information				material substance									
method & support	penetration	water	samples & field tests	RL (m)	depth (m)	graphic log	classification symbol	material description	moisture condition	consistency / relative density	vane shear remoulded peak (kPa)	DCP (blows/100 mm)	structure and additional observations
HA	1	Not Encountered	VS >247 kPa		0.5			ORGANIC SILT: non plastic, dark brown black.	D to M	VSt to H			TOPSOIL
	2		VS 196/ 61 kPa		1.0			Clayey SILT: low plasticity, brown orange mottled black white grey. 0.4 m: becoming slightly to moderately plastic 0.6 m: with trace fine to medium grained sand	M				FILL
	3		VS >247 kPa		1.5			SILT: non plastic to low plasticity, brown orange, minor fine to medium grained sand.					
			VS >247 kPa		2.0			CLAY: medium plasticity, brown orange, trace silt. Clayey SILT: low plasticity, brown orange, trace fine to medium grained sand.					
			VS >247 kPa		2.5			Sandy SILT: non plastic, pale brown grey mottled white black, trace clay.	W				
			VS 179/ 42 kPa		3.0			Hand Auger HAL574 terminated at 3.0 m Target depth					MATUA SUBGROUP
					3.5								
					4.0								
					4.5								

method AD auger drilling* AS auger screwing* HA hand auger W washbore HA hand auger	support M mud C casing N nil	samples & field tests B bulk disturbed sample D disturbed sample E environmental sample SS split spoon sample U## undisturbed sample ##mm diameter HP hand penetrometer (kPa) N standard penetration test (SPT) N* SPT - sample recovered Nc SPT with solid cone VS vane shear; peak/remoulded (kPa) R refusal HB hammer bouncing	classification symbol & soil description based on Unified Classification System	consistency / relative density VS very soft S soft F firm St stiff VSt very stiff H hard Fb friable VL very loose L loose MD medium dense D dense VD very dense
penetration no resistance ranging to refusal	water 10-Oct-12 water level on date shown water inflow water outflow	moisture D dry M moist W wet S saturated Wp plastic limit WL liquid limit		

* bit shown by suffix
e.g.
AD/T
B blank bit
T TC bit
V V bit

client: **THE LAKES (2012) LIMITED**

principal:

project: **THE LAKES, STAGE 3/ GCR**

location: **BOUNDARY OF LOT 574 AND 575**

Borehole ID. **HAL574-575**

sheet: 1 of 1

project no. **773-GENZTAUC13086AP**

date started: **13 Oct 2017**

date completed: **13 Oct 2017**

logged by: **PRM**

checked by: **DBC**[illegible]

Engineering Log - Hand Auger

client: **THE LAKES (2012) LIMITED**

principal:

project: **THE LAKES, STAGE 3I GCR**

location: **CENTRE OF LOT 575**

Borehole ID. **HAL575**

sheet: 1 of 1

project no. **773-GENZTAUC13086AP**

date started: **13 Oct 2017**

date completed: **13 Oct 2017**

logged by: **SBG**

checked by: **DBC**

position: Not Specified surface elevation: Not Specified angle from horizontal: 90° DCP id.:
drill model: Hand Auger drilling fluid: hole diameter : 50 mm vane id.: SL817

drilling information				material substance									
method & support	penetration	water	samples & field tests	RL (m)	depth (m)	graphic log	classification symbol	material description	moisture condition	consistency / relative density	vane shear (kPa)	DCP (blows/100 mm)	structure and additional observations
HA	1		VS 213/42 kPa		0.5			ORGANIC SILT: non plastic, dark brown black.	D to M				TOPSOIL
	2		VS 196/45 kPa					Clayey SILT: non plastic, pale brown yellow mottled dark brown, trace fine to medium grained sand.	M	VSt to H			FILL
	3		VS 129/42 kPa		1.0			SILT: low plasticity, brown orange, trace fine to medium grained sand.					
		Not Encountered	VS >247 kPa		1.5			SILT: non plastic to low plasticity, brown orange mottled black white, trace fine to medium grained sand, trace clay.					
			VS >247 kPa		2.0			Sandy SILT: non plastic, brown orange mottled pale brown black, sand is fine to medium grained, trace clay.					
			VS 213/42 kPa		2.5			Sandy SILT: non plastic, brown orange mottled white black, minor clay.					
			VS 231/42 kPa		3.0			Hand Auger HAL575 terminated at 3.0 m Target depth					
			VS >247 kPa		3.5								
			VS >247 kPa		4.0								
			VS >247 kPa		4.5								

method AD auger drilling* AS auger screwing* HA hand auger W washbore HA hand auger	support M mud C casing N nil	samples & field tests B bulk disturbed sample D disturbed sample E environmental sample SS split spoon sample U## undisturbed sample ##mm diameter HP hand penetrometer (kPa) N standard penetration test (SPT) N* SPT - sample recovered Nc SPT with solid cone VS vane shear; peak/remoulded (kPa) R refusal HB hammer bouncing	classification symbol & soil description based on Unified Classification System	consistency / relative density VS very soft S soft F firm St stiff VSt very stiff H hard Fb friable VL very loose L loose MD medium dense D dense VD very dense
* bit shown by suffix e.g. AD/T B blank bit T TC bit V V bit	penetration 		moisture D dry M moist W wet S saturated Wp plastic limit WL liquid limit	

Engineering Log - Hand Auger

client: **THE LAKES (2012) LIMITED**

principal:

project: **THE LAKES, STAGE 3I GCR**

location: **BOUNDARY OF LOT 575 AND 576**

Borehole ID: **HAL575-576**

sheet: 1 of 1

project no: **773-GENZTAUC13086AP**

date started: **13 Oct 2017**

date completed: **13 Oct 2017**

logged by: **SBG**

checked by: **DBC**

position: Not Specified surface elevation: Not Specified angle from horizontal: 90° DCP id.:
drill model: Hand Auger drilling fluid: hole diameter : 50 mm vane id.: SL817

drilling information					material substance									
method & support	penetration	water	samples & field tests	RL (m)	depth (m)	graphic log	classification symbol	material description	moisture condition	consistency / relative density	vane shear (kPa)	DCP (blows/100 mm)	structure and additional observations	
HA	1	Not Encountered	VS >247 kPa					ORGANIC SILT: non plastic, dark brown black.	M				TOPSOIL	FILL
	2		VS >247 kPa		0.5			SILT: non plastic, brown orange mottled black grey white, trace fine to medium grained sand.	VSt to H					
	3		VS 142/45 kPa		1.0									
			VS >247 kPa		1.5			Sandy SILT: non plastic, pale grey brown mottled dark brown black, sand fine to medium grained, trace clay.						
			VS >247 kPa		2.0									
			VS >247 kPa		2.5			SILT: non plastic, brown orange mottled black white grey, minor fine to medium grained sand, minor clay.						
			VS 217/42 kPa		3.0			Hand Auger HAL575-576 terminated at 3.0 m Target depth						
			VS 234/42 kPa		3.5									
			VS >247 kPa		4.0									
					4.5									

method AD auger drilling* AS auger screwing* HA hand auger W washbore HA hand auger	support M mud C casing N nil	penetration no resistance ranging to refusal 10-Oct-12 water level on date shown water inflow water outflow	samples & field tests B bulk disturbed sample D disturbed sample E environmental sample SS split spoon sample U## undisturbed sample ##mm diameter HP hand penetrometer (kPa) N standard penetration test (SPT) N* SPT - sample recovered Nc SPT with solid cone VS vane shear; peak/remoulded (kPa) R refusal HB hammer bouncing	classification symbol & soil description based on Unified Classification System moisture D dry M moist W wet S saturated Wp plastic limit WL liquid limit	consistency / relative density VS very soft S soft F firm St stiff VSt very stiff H hard Fb friable VL very loose L loose MD medium dense D dense VD very dense
---	--	--	--	---	--

* bit shown by suffix
e.g.
AD/T
B blank bit
T TC bit
V V bit

Engineering Log - Hand Auger

client: **THE LAKES (2012) LIMITED**

principal:

project: **THE LAKES, STAGE 3I GCR**

location: **CENTRE OF LOT 576**

Borehole ID. **HAL576**

sheet: 1 of 1

project no. **773-GENZTAUC13086AP**

date started: **13 Oct 2017**

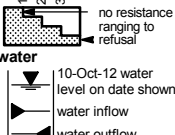
date completed: **13 Oct 2017**

logged by: **SBG**

checked by: **DBC**

position: Not Specified surface elevation: Not Specified angle from horizontal: 90° DCP id.:
drill model: Hand Auger drilling fluid: hole diameter : 50 mm vane id.: SL817

drilling information				material substance									
method & support	penetration	water	samples & field tests	RL (m)	depth (m)	graphic log	classification symbol	material description	moisture condition	consistency / relative density	vane shear remoulded peak (kPa)	DCP (blows/100 mm)	structure and additional observations
HA	1		VS >247 kPa					ORGANIC SILT: non plastic, dark brown black.	D to M				TOPSOIL
	2		VS 209/42 kPa		0.5			SILT: non plastic to low plasticity, brown orange mottled black grey white, trace fine to medium grained sand.	M	VSt to H			FILL
	3		VS 134/29 kPa		1.0								
		Not Encountered	VS >247 kPa		1.5			Sandy SILT: non plastic, pale grey brown mottled black white, sand fine to medium grained.					
			VS >247 kPa		2.0			1.6 m: becoming slightly plastic 1.61 m: becoming pale brown orange mottled black white	W				
			VS >247 kPa		2.5			SILT: non plastic, brown orange mottled black white grey, trace fine to medium grained sand, trace clay.	M				
			VS 213/39 kPa		3.0			Hand Auger HAL576 terminated at 3.0 m Target depth					
			VS 188/45 kPa		3.5								
					4.0								
					4.5								

method AD auger drilling* AS auger screwing* HA hand auger W washbore HA hand auger	support M mud C casing N nil	samples & field tests B bulk disturbed sample D disturbed sample E environmental sample SS split spoon sample U## undisturbed sample ##mm diameter HP hand penetrometer (kPa) N standard penetration test (SPT) N* SPT - sample recovered Nc SPT with solid cone VS vane shear; peak/remoulded (kPa) R refusal HB hammer bouncing	classification symbol & soil description based on Unified Classification System	consistency / relative density VS very soft S soft F firm St stiff VSt very stiff H hard Fb friable VL very loose L loose MD medium dense D dense VD very dense
* bit shown by suffix e.g. AD/T B blank bit T TC bit V V bit	penetration 		moisture D dry M moist W wet S saturated Wp plastic limit Wl liquid limit	

Engineering Log - Hand Auger

client: **THE LAKES (2012) LIMITED**

principal:

project: **THE LAKES, STAGE 3I GCR**

location: **EASTERN BOUNDARY OF LOT 576**

Borehole ID. **HAL576b**

sheet: 1 of 1

project no. **773-GENZTAUC13086AP**

date started: **13 Oct 2017**

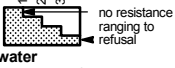
date completed: **13 Oct 2017**

logged by: **PRM**

checked by: **DBC**

position: Not Specified surface elevation: Not Specified angle from horizontal: 90° DCP id.:
drill model: Hand Auger drilling fluid: hole diameter : 50 mm vane id.: SL817

drilling information					material substance									
method & support	penetration	water	samples & field tests	RL (m)	depth (m)	graphic log	classification symbol	material description	moisture condition	consistency / relative density	vane shear (kPa)	DCP (blows/100 mm)	structure and additional observations	
HA	1		VS 213 kPa		0.5			SILT : non plastic, brown, with minor fine grained sand.	D to M				FILL	
	2		VS UTP					SILTY SAND : fine to medium grained, grey.						
	3		VS >247 kPa		1.0			SILT : non plastic, brown, with trace fine to medium grained sand.	M	VSt to H				
		Not Encountered	VS 231/ 25 kPa		1.5			1.1 m: becoming brown mottled orange	W to S				MATUA SUBGROUP	
			VS 213/ 29 kPa		2.0			Clayey SILT : low plasticity, brown mottled orange-pink, with trace fine grained sand.						
			VS 173/ 32 kPa		2.5			Silty CLAY : low plasticity, orange mottled pale orange, sensitive, greasy, with trace fine grained sand.						
			VS >247 kPa		3.0			SILT : non plastic, brown.						
					3.0			Hand Auger HAL576b terminated at 3.0 m Target depth						
					3.5									
					4.0									
					4.5									

method AD auger drilling* AS auger screwing* HA hand auger W washbore HA hand auger	support M mud C casing N nil	samples & field tests B bulk disturbed sample D disturbed sample E environmental sample SS split spoon sample U## undisturbed sample ##mm diameter HP hand penetrometer (kPa) N standard penetration test (SPT) N* SPT - sample recovered Nc SPT with solid cone VS vane shear; peak/remoulded (kPa) R refusal HB hammer bouncing	classification symbol & soil description based on Unified Classification System	consistency / relative density VS very soft S soft F firm St stiff VSt very stiff H hard Fb friable VL very loose L loose MD medium dense D dense VD very dense
* bit shown by suffix e.g. AD/T B blank bit T TC bit V V bit	penetration  no resistance ranging to refusal 10-Oct-12 water level on date shown water inflow water outflow		moisture D dry M moist W wet S saturated Wp plastic limit WL liquid limit	

Engineering Log - Hand Auger

client: **THE LAKES (2012) LIMITED**

principal:

project: **THE LAKES, STAGE 3I GCR**

location: **CENTRE OF LOT 577**

Borehole ID. **HAL577**

sheet: 1 of 1

project no. **773-GENZTAUC13086AP**

date started: **13 Oct 2017**

date completed: **13 Oct 2017**

logged by: **SBG**

checked by: **DBC**

position: Not Specified surface elevation: Not Specified angle from horizontal: 90° DCP id.:
drill model: Hand Auger drilling fluid: hole diameter : 50 mm vane id.: SL817

drilling information							material substance																							
method & support	1 penetration	2	3	water	samples & field tests	RL (m)	depth (m)	graphic log	classification symbol	material description SOIL TYPE: plasticity or particle characteristic, colour, secondary and minor components	moisture condition	consistency / relative density	vane shear ⊕ remoulded ⊙ peak (kPa)	DCP (blows/ 100 mm)	structure and additional observations															
HA N	1 2 3			Not Encountered	VS 234/ 42 kPa		0.5			ORGANIC SILT: non plastic, dark brown black.	D to M					TOPSOIL														
					VS 247 kPa					SILT: low plasticity, brown orange mottled pale orange, trace fine to medium grained sand. 0.5 m: becoming brown orange	M					St to H	⊕	⊙		FILL										
					VS 196/ 39 kPa					Sandy SILT: non plastic, pale brown grey mottled white.																				
					VS >247 kPa																SILT: low plasticity, pale brown orange, trace clay.									
					VS >247 kPa																						⊕	⊙		
					VS 213/ 61 kPa																									
					VS 114/ 39 kPa					Clayey SILT: medium plasticity, brown orange.																				
					VS 138/ 37 kPa																⊕	⊙								
					VS 134/ 39 kPa																				⊕	⊙				
					VS 138/ 42 kPa					⊕	⊙																			
							3.0			Hand Auger HAL577 terminated at 3.0 m Target depth																				
							3.5																							
							4.0																							
							4.5																							

Engineering Log - Hand Auger

client: **THE LAKES (2012) LIMITED**

principal:

project: **THE LAKES, STAGE 3I GCR**

location: **BOUNDARY OF LOT 577 AND 578**

Borehole ID. **HAL577-578**

sheet: 1 of 1

project no. **773-GENZTAUC13086AP**

date started: **13 Oct 2017**

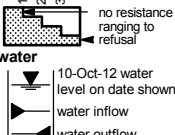
date completed: **13 Oct 2017**

logged by: **SBG**

checked by: **DBC**

position: Not Specified surface elevation: Not Specified angle from horizontal: 90° DCP id.:
drill model: Hand Auger drilling fluid: hole diameter : 50 mm vane id.: SL817

drilling information					material substance								
method & support	penetration	water	samples & field tests	RL (m)	depth (m)	graphic log	classification symbol	material description	moisture condition	consistency / relative density	vane shear (kPa)	DCP (blows/ 100 mm)	structure and additional observations
HA	1 2 3							SOIL TYPE: plasticity or particle characteristic, colour, secondary and minor components			remoulded peak		
		Not Encountered	VS 138/ 39 kPa VS 144/ 42 kPa VS 158/ 39 kPa VS 247 kPa VS 247 kPa VS 247 kPa		0.5 1.0 1.5 2.0			Clayey SILT: low plasticity, brown orange mottled white black pink. 0.9 m: becoming brown orange	M	VSt H	50 100 150 200	2 4 6 8 10	FILL
					2.5 3.0 3.5 4.0 4.5			2.1 m: Refused at 3 different locations due to gravel hardfill Hand Auger HAL577-578 terminated at 2.1 m Refusal					

method AD auger drilling* AS auger screwing* HA hand auger W washbore HA hand auger * bit shown by suffix e.g. AD/T B blank bit T TC bit V V bit	support M mud C casing N nil penetration  water 10-Oct-12 water level on date shown water inflow water outflow	samples & field tests B bulk disturbed sample D disturbed sample E environmental sample SS split spoon sample U## undisturbed sample ##mm diameter HP hand penetrometer (kPa) N standard penetration test (SPT) N* SPT - sample recovered Nc SPT with solid cone VS vane shear; peak/remoulded (kPa) R refusal HB hammer bouncing	classification symbol & soil description based on Unified Classification System moisture D dry M moist W wet S saturated Wp plastic limit Wl liquid limit	consistency / relative density VS very soft S soft F firm St stiff VSt very stiff H hard Fb friable VL very loose L loose MD medium dense D dense VD very dense
--	---	--	---	--

Engineering Log - Hand Auger

client: **THE LAKES (2012) LIMITED**

principal:

project: **THE LAKES, STAGE 3I GCR**

location: **CORNER OF LOT 577**

Borehole ID. **HAL577C**

sheet: 1 of 1

project no. **773-GENZTAUC13086AP**

date started: **13 Oct 2017**

date completed: **13 Oct 2017**

logged by: **PRM**

checked by: **DBC**

position: Not Specified surface elevation: Not Specified angle from horizontal: 90° DCP id.:
drill model: Hand Auger drilling fluid: hole diameter : 50 mm vane id.: SL817

drilling information					material substance										
method & support	penetration		water	samples & field tests	RL (m)	depth (m)	graphic log	classification symbol	material description	moisture condition	consistency / relative density	vane shear		DCP (blows/ 100 mm)	structure and additional observations
	1	2										remoulded	peak		
HA N	1	3	water table encountered	VS UTP		0.5			Clayey SILT: non plastic, brown mottled white / dark brown/ pink.	M	St to H	60	100	2	FILL
	2			VS 81/ 10 kPa		1.0				150	4				
				VS 196/ 25 kPa		1.5			S			120	6		
				VS 183/ 61 kPa		2.0						180	8		
				VS 179/ 61 kPa		2.5						240	10		
				VS 196/ 42 kPa		2.5			Hand Auger HAL577C terminated at 2.5 m Squeezing			300	10		
						3.0									
						3.5									
						4.0									
						4.5									

method AD auger drilling* AS auger screwing* HA hand auger W washbore HA hand auger * bit shown by suffix e.g. AD/T B blank bit T TC bit V V bit	support M mud C casing penetration water 10-Oct-12 water level on date shown water inflow water outflow	samples & field tests B bulk disturbed sample D disturbed sample E environmental sample SS split spoon sample U## undisturbed sample ##mm diameter HP hand penetrometer (kPa) N standard penetration test (SPT) N* SPT - sample recovered Nc SPT with solid cone VS vane shear; peak/remoulded (kPa) R refusal HB hammer bouncing	classification symbol & soil description based on Unified Classification System moisture D dry M moist W wet S saturated Wp plastic limit Wl liquid limit	consistency / relative density VS very soft S soft F firm St stiff VSt very stiff H hard Fb friable VL very loose L loose MD medium dense D dense VD very dense
--	---	--	---	--

Engineering Log - Hand Auger

client: **THE LAKES (2012) LIMITED**

principal:

project: **THE LAKES, STAGE 3I GCR**

location: **CENTRE OF LOT 578**

Borehole ID. **HAL578**

sheet: 1 of 1

project no. **773-GENZTAUC13086AP**

date started: **13 Oct 2017**

date completed: **13 Oct 2017**

logged by: **PRM**

checked by: **DBC**

position: Not Specified surface elevation: Not Specified angle from horizontal: 90° DCP id.:
drill model: Hand Auger drilling fluid: hole diameter : 50 mm vane id.: SL588

drilling information					material substance								
method & support	penetration	water	samples & field tests	RL (m)	depth (m)	graphic log	classification symbol	material description	moisture condition	consistency / relative density	vane shear ⊕ remoulded ⊙ peak (kPa)	DCP (blows/ 100 mm)	structure and additional observations
HA N	1	Not Encountered	VS 213 kPa		0.5			ORGANIC SILT: non plastic, dark brown-black.	M	VSt to H	⊕ ⊙ VS UTP		TOPSOIL
	SILT: low plasticity, orange brown mottled brown pale brown, trace fine grained sand, some clay.												
			VS 213 kPaUTP		1.0			1.5 m: poor recovery			⊕ ⊙		FILL
			VS 213 kPa		1.5						⊕ ⊙		
			VS 187/ 75 kPa		2.0						⊕ ⊙		
			VS 213 kPa		2.0			Hand Auger HAL578 terminated at 2.0 m Squeezing			⊕ ⊙		
					2.5								
					3.0								
					3.5								
					4.0								
					4.5								

method AD auger drilling* AS auger screwing* HA hand auger W washbore HA hand auger	support M mud C casing N nil	samples & field tests B bulk disturbed sample D disturbed sample E environmental sample SS split spoon sample U## undisturbed sample ##mm diameter HP hand penetrometer (kPa) N standard penetration test (SPT) N* SPT - sample recovered Nc SPT with solid cone VS vane shear; peak/remoulded (kPa) R refusal HB hammer bouncing	classification symbol & soil description based on Unified Classification System	consistency / relative density VS very soft S soft F firm St stiff VSt very stiff H hard Fb friable VL very loose L loose MD medium dense D dense VD very dense
* bit shown by suffix e.g. AD/T B blank bit T TC bit V V bit	penetration  no resistance ranging to refusal 10-Oct-12 water level on date shown water inflow water outflow		moisture D dry M moist W wet S saturated Wp plastic limit WI liquid limit	

Engineering Log - Hand Auger

client: **THE LAKES (2012) LIMITED**

principal:

project: **THE LAKES, STAGE 3I GCR**

location: **CENTRE OF LOT 579**

Borehole ID. **HAL579**

sheet: 1 of 1

project no. **773-GENZTAUC13086AP**

date started: **15 Oct 2017**

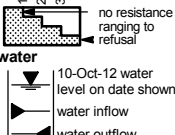
date completed: **15 Oct 2017**

logged by: **ODS**

checked by: **DBC**

position: Not Specified surface elevation: Not Specified angle from horizontal: 90° DCP id.:
drill model: Hand Auger drilling fluid: hole diameter : 50 mm vane id.: SL588

drilling information					material substance											
method & support	penetration		water	samples & field tests	RL (m)	depth (m)	graphic log	classification symbol	material description	moisture condition	consistency / relative density	vane shear ⊕ remoulded ⊙ peak (kPa)	DCP (blows/ 100 mm)	structure and additional observations		
HA N	1	2	Not Encountered	VS >213 kPa		0.5			ORGANIC SILT: non plastic, black.	D to M	VSt to H	⊕ ⊙	2 4 6 8 10	FILL		
	3			VS 197/ 65 kPa		1.0									SILT: non plastic, orange brown mottled brown, with trace fine grained sand.	
				VS >213 kPa		1.5										
				VS >213 kPa		2.0										
				VS 190/ 64 kPa												
						2.0			Hand Auger HAL579 terminated at 2.0 m Target depth			⊕ ⊙	2 4 6 8 10			

method AD auger drilling* AS auger screwing* HA hand auger W washbore HA hand auger	support M mud C casing N nil	penetration 	samples & field tests B bulk disturbed sample D disturbed sample E environmental sample SS split spoon sample U## undisturbed sample ##mm diameter HP hand penetrometer (kPa) N standard penetration test (SPT) N* SPT - sample recovered Nc SPT with solid cone VS vane shear; peak/remoulded (kPa) R refusal HB hammer bouncing	classification symbol & soil description based on Unified Classification System	consistency / relative density VS very soft S soft F firm St stiff VSt very stiff H hard Fb friable VL very loose L loose MD medium dense D dense VD very dense
moisture D dry M moist W wet S saturated Wp plastic limit Wl liquid limit					

* bit shown by suffix
e.g.
AD/T
B blank bit
T TC bit
V V bit

Engineering Log - Hand Auger

client: **THE LAKES (2012) LIMITED**

principal:

project: **THE LAKES, STAGE 3I GCR**

location: **BOUNDARY OF LOT 579 AND 580**

Borehole ID. **HAL579-580**

sheet: 1 of 1

project no. **773-GENZTAUC13086AP**

date started: **16 Oct 2017**

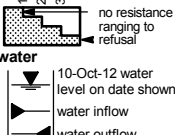
date completed: **16 Oct 2017**

logged by: **SBG**

checked by: **DBC**

position: Not Specified surface elevation: Not Specified angle from horizontal: 90° DCP id.:
drill model: Hand Auger drilling fluid: hole diameter : 50 mm vane id.: SL817

drilling information				material substance									
method & support	penetration	water	samples & field tests	RL (m)	depth (m)	graphic log	classification symbol	material description	moisture condition	consistency / relative density	vane shear (kPa)	DCP (blows/100 mm)	structure and additional observations
	1 2 3							SOIL TYPE: plasticity or particle characteristic, colour, secondary and minor components			remoulded peak		
								ORGANIC SILT: non plastic, dark brown black.	M				TOPSOIL
			VS 125/39 kPa		0.5			SILT: non plastic, brown orange mottled dark brown, trace fine to medium grained sand.		VSt			FILL
			VS 179/42 kPa					0.5 m: becoming slightly plastic 0.51 m: with trace clay					
			VS 247 kPa		1.0			Sandy SILT: non plastic, pale brown mottled orange black, sand is fine to medium grained, trace clay.					
			VS 247 kPa		1.5			SILT: non plastic to low plasticity, brown orange.	H				
			VS 247 kPa		2.0								
			VS 247 kPa		2.5								
			VS 247 kPa		3.0			Hand Auger HAL579-580 terminated at 3.0 m Target depth					
					3.5								
					4.0								
					4.5								

method AD auger drilling* AS auger screwing* HA hand auger W washbore HA hand auger	support M mud C casing N nil	penetration 	samples & field tests B bulk disturbed sample D disturbed sample E environmental sample SS split spoon sample U## undisturbed sample ##mm diameter HP hand penetrometer (kPa) N standard penetration test (SPT) N* SPT - sample recovered Nc SPT with solid cone VS vane shear; peak/remoulded (kPa) R refusal HB hammer bouncing	classification symbol & soil description based on Unified Classification System	consistency / relative density VS very soft S soft F firm St stiff VSt very stiff H hard Fb friable VL very loose L loose MD medium dense D dense VD very dense
moisture D dry M moist W wet S saturated Wp plastic limit WL liquid limit					

* bit shown by suffix
e.g.
AD/T
B blank bit
T TC bit
V V bit

Engineering Log - Hand Auger

client: **THE LAKES (2012) LIMITED**

principal:

project: **THE LAKES, STAGE 3I GCR**

location: **CENTRE OF LOT 580**

Borehole ID. **HAL580**

sheet: 1 of 1

project no. **773-GENZTAUC13086AP**

date started: **13 Oct 2017**

date completed: **13 Oct 2017**

logged by: **PRM**

checked by: **DBC**

position: Not Specified surface elevation: Not Specified angle from horizontal: 90° DCP id.:
drill model: Hand Auger drilling fluid: hole diameter : 50 mm vane id.: SL817

drilling information					material substance									
method & support	penetration	water	samples & field tests	RL (m)	depth (m)	graphic log	classification symbol	material description	moisture condition	consistency / relative density	vane shear ⊕ remoulded ⊙ peak (kPa)	DCP (blows/100 mm)	structure and additional observations	
								SOIL TYPE: plasticity or particle characteristic, colour, secondary and minor components						
HA N	1							ORGANIC SILT: non plastic, dark brown-black.	M	St to H	⊕	⊙		TOPSOIL
	2		VS 213/ 35 kPa				Clayey SILT: low plasticity, brown mottled pale brown, with trace fine to medium grained sand.				⊕	⊙		FILL
	3		VS 109/ 69 kPa	0.5	becoming orange mottled brown from 0.7m to 0.9m			⊕			⊙			
			VS 193/ 75 kPa	1.0				⊕			⊙			
			VS 162/ 42 kPa	1.5				⊕			⊙			
			VS 213/ 25 kPa	2.0	1.8 m: becoming moderately plastic			⊕			⊙			
			VS 213/ 25 kPa	2.5				⊕			⊙			
			VS UTP											
			VS UTP											
					3.0						Hand Auger HAL580 terminated at 3.0 m Target depth			
					3.5									
					4.0									
					4.5									

method AD auger drilling* AS auger screwing* HA hand auger W washbore HA hand auger	support M mud C casing N nil	samples & field tests B bulk disturbed sample D disturbed sample E environmental sample SS split spoon sample U## undisturbed sample ##mm diameter HP hand penetrometer (kPa) N standard penetration test (SPT) N* SPT - sample recovered Nc SPT with solid cone VS vane shear; peak/remoulded (kPa) R refusal HB hammer bouncing	classification symbol & soil description based on Unified Classification System	consistency / relative density VS very soft S soft F firm St stiff VSt very stiff H hard Fb friable VL very loose L loose MD medium dense D dense VD very dense
* bit shown by suffix e.g. AD/T B blank bit T TC bit V V bit	penetration 		moisture D dry M moist W wet S saturated Wp plastic limit Wl liquid limit	

Engineering Log - Hand Auger

client: **THE LAKES (2012) LIMITED**

principal:

project: **THE LAKES, STAGE 3I GCR**

location: **BOUNDARY OF LOT 580 AND 581**

Borehole ID. **HAL580-581**

sheet: 1 of 1

project no. **773-GENZTAUC13086AP**

date started: **15 Oct 2017**

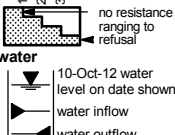
date completed: **15 Oct 2017**

logged by: **ODS**

checked by: **DBC**

position: Not Specified surface elevation: Not Specified angle from horizontal: 90° DCP id.:
drill model: Hand Auger drilling fluid: hole diameter : 50 mm vane id.: SL588

drilling information					material substance											
method & support	penetration		water	samples & field tests	RL (m)	depth (m)	graphic log	classification symbol	material description	moisture condition	consistency / relative density	vane shear ⊕ remoulded ⊙ peak (kPa)	DCP (blows/ 100 mm)	structure and additional observations		
HA N	1	2							SILT: non plastic, brown mottled grey.	D to M	H	50	2	FILL		
												100	4			
												150	6			
												200	8			
													10			
			VS >213 kPa			0.5						⊙				
			VS >213 kPa			1.0						⊙				
			VS >213 kPa			1.5						⊙				
			VS >213 kPa			2.0						⊙				
			VS >213 kPa			2.5			Hand Auger HAL580-581 terminated at 2.0 m Target depth			⊙				
						3.0										
						3.5										
						4.0										
						4.5										

method AD auger drilling* AS auger screwing* HA hand auger W washbore HA hand auger	support M mud C casing N nil	samples & field tests B bulk disturbed sample D disturbed sample E environmental sample SS split spoon sample U## undisturbed sample ##mm diameter HP hand penetrometer (kPa) N standard penetration test (SPT) N* SPT - sample recovered Nc SPT with solid cone VS vane shear; peak/remoulded (kPa) R refusal HB hammer bouncing	classification symbol & soil description based on Unified Classification System	consistency / relative density VS very soft S soft F firm St stiff VSt very stiff H hard Fb friable VL very loose L loose MD medium dense D dense VD very dense
* bit shown by suffix e.g. AD/T B blank bit T TC bit V V bit	penetration  10-Oct-12 water level on date shown water inflow water outflow		moisture D dry M moist W wet S saturated Wp plastic limit Wl liquid limit	

Engineering Log - Hand Auger

client: **THE LAKES (2012) LIMITED**

principal:

project: **THE LAKES, STAGE 3I GCR**

location: **CENTRE OF LOT 581**

Borehole ID: **HAL581**

sheet: 1 of 1

project no: **773-GENZTAUC13086AP**

date started: **16 Oct 2017**

date completed: **16 Oct 2017**

logged by: **SBG**

checked by: **DBC**

position: Not Specified surface elevation: Not Specified angle from horizontal: 90° DCP id.:
drill model: Hand Auger drilling fluid: hole diameter : 50 mm vane id.: SL588

drilling information					material substance									
method & support	penetration	water	samples & field tests	RL (m)	depth (m)	graphic log	classification symbol	material description	moisture condition	consistency / relative density	vane shear		DCP (blows/ 100 mm)	structure and additional observations
											remoulded	peak		
	1 2 3										⊕ ⊗ ⊙	⊕ ⊗ ⊙		
HA N		Not Encountered	VS 231/ 58 kPa		0.5			ORGANIC SILT: non plastic, dark brown black. SILT: low plasticity, brown orange mottled black, trace clay.	D to M M		⊕ ⊗ ⊙	⊕ ⊗ ⊙		TOPSOIL FILL
			VS 82/ 38 kPa						H					
			VS 88/ 35 kPa		1.0		Clayey SILT: low to medium plasticity, brown orange mottled white black.	VSt						
			VS 143/ 61 kPa		1.5		Silty CLAY: low to medium plasticity, brown orange, trace fine to medium grained sand.	M to W	H	⊕ ⊗ ⊙	⊕ ⊗ ⊙			
			VS 179/ 61 kPa		2.0			W		⊕ ⊗ ⊙	⊕ ⊗ ⊙			
					2.5									
					3.0			Hand Auger HAL581 terminated at 3.0 m Target depth						
					3.5									
					4.0									
					4.5									

method AD auger drilling* AS auger screwing* HA hand auger W washbore HA hand auger	support M mud C casing N nil	samples & field tests B bulk disturbed sample D disturbed sample E environmental sample SS split spoon sample U## undisturbed sample ##mm diameter HP hand penetrometer (kPa) N standard penetration test (SPT) N* SPT - sample recovered Nc SPT with solid cone VS vane shear; peak/remoulded (kPa) R refusal HB hammer bouncing	classification symbol & soil description based on Unified Classification System	consistency / relative density VS very soft S soft F firm St stiff VSt very stiff H hard Fb friable VL very loose L loose MD medium dense D dense VD very dense
* bit shown by suffix e.g. AD/T B blank bit T TC bit V V bit	penetration 		moisture D dry M moist W wet S saturated Wp plastic limit Wl liquid limit	

Engineering Log - Hand Auger

client: **THE LAKES (2012) LIMITED**

principal:

project: **THE LAKES, STAGE 3I GCR**

location: **BOUNDARY OF LOT 581 AND 582**

Borehole ID. **HAL581-582**

sheet: 1 of 1

project no. **773-GENZTAUC13086AP**

date started: **15 Oct 2017**

date completed: **15 Oct 2017**

logged by: **ODS**

checked by: **DBC**

position: Not Specified surface elevation: Not Specified angle from horizontal: 90° DCP id.:
drill model: Hand Auger drilling fluid: hole diameter : 50 mm vane id.: SL588

drilling information					material substance									
method & support	penetration		water	samples & field tests	RL (m)	depth (m)	graphic log	classification symbol	material description	moisture condition	consistency / relative density	vane shear ⊕ remoulded ⊙ peak (kPa)	DCP (blows/ 100 mm)	structure and additional observations
HA N	1	2	15/10/17	VS 161/ 35 kPa		0.5			SILT: non plastic, brown mottled grey.		VSt	⊕	⊙	FILL
	3	VS 161/ 32 kPa		1.0	⊕	⊙								
		VS >213 kPa		1.5		⊙								
		VS >213 kPa		2.0		⊙								
		VS >213 kPa		2.5		⊙								
		VS >213 kPa		3.0		⊙								
		VS >213 kPa												
		VS >213 kPa												
		VS >213 kPa												

method AD auger drilling* AS auger screwing* HA hand auger W washbore HA hand auger	support M mud C casing N nil	samples & field tests B bulk disturbed sample D disturbed sample E environmental sample SS split spoon sample U## undisturbed sample ##mm diameter HP hand penetrometer (kPa) N standard penetration test (SPT) N* SPT - sample recovered Nc SPT with solid cone VS vane shear; peak/remoulded (kPa) R refusal HB hammer bouncing	classification symbol & soil description based on Unified Classification System	consistency / relative density VS very soft S soft F firm St stiff VSt very stiff H hard Fb friable VL very loose L loose MD medium dense D dense VD very dense
* bit shown by suffix e.g. AD/T B blank bit T TC bit V V bit	penetration 	moisture D dry M moist W wet S saturated Wp plastic limit Wl liquid limit		

Engineering Log - Hand Auger

client: **THE LAKES (2012) LIMITED**

principal:

project: **THE LAKES, STAGE 3I GCR**

location: **BOUNDARY OF LOT 582 AND 583**

Borehole ID. **HAL582-583**

sheet: 1 of 1

project no. **773-GENZTAUC13086AP**

date started: **16 Oct 2017**

date completed: **16 Oct 2017**

logged by: **SBG**

checked by: **DBC**

position: Not Specified surface elevation: Not Specified angle from horizontal: 90° DCP id.:
drill model: Hand Auger drilling fluid: hole diameter : 50 mm vane id.: SL817

drilling information					material substance												
method & support	penetration	water	samples & field tests	RL (m)	depth (m)	graphic log	classification symbol	material description	moisture condition	consistency / relative density	vane shear ⊕ remoulded ⊙ peak (kPa)	DCP (blows/ 100 mm)	structure and additional observations				
HA N	1	Not Encountered	VS 247 kPa		0.5			ORGANIC SILT: non plastic, dark brown black.	D to M				TOPSOIL				
	2								SILT: low plasticity, brown orange mottled black pink, trace clay.	M	H				FILL		
	3							1.0	Sandy SILT: non plastic, pale brown mottled orange black white, sand is fine to medium grained.	VSt							
								1.5									
								2.0	Clayey SILT: low to medium plasticity, brown orange mottled dark brown.	H							
					2.0	Hand Auger HAL582-583 terminated at 2.0 m Target depth											
					2.5												
					3.0												
					3.5												
					4.0												
					4.5												

method AD auger drilling* AS auger screwing* HA hand auger W washbore HA hand auger	support M mud C casing N nil	samples & field tests B bulk disturbed sample D disturbed sample E environmental sample SS split spoon sample U## undisturbed sample ##mm diameter HP hand penetrometer (kPa) N standard penetration test (SPT) N* SPT - sample recovered Nc SPT with solid cone VS vane shear; peak/remoulded (kPa) R refusal HB hammer bouncing	classification symbol & soil description based on Unified Classification System	consistency / relative density VS very soft S soft F firm St stiff VSt very stiff H hard Fb friable VL very loose L loose MD medium dense D dense VD very dense
* bit shown by suffix e.g. AD/T B blank bit T TC bit V V bit	penetration no resistance ranging to refusal water 10-Oct-12 water level on date shown water inflow water outflow		moisture D dry M moist W wet S saturated Wp plastic limit WL liquid limit	

Engineering Log - Hand Auger

client: **THE LAKES (2012) LIMITED**

principal:

project: **THE LAKES, STAGE 3I GCR**

location: **CENTRE OF LOT 583**

Borehole ID. **HAL583**

sheet: 1 of 1

project no. **773-GENZTAUC13086AP**

date started: **13 Oct 2017**

date completed: **13 Oct 2017**

logged by: **PRM**

checked by: **DBC**

position: Not Specified surface elevation: Not Specified angle from horizontal: 90° DCP id.:
drill model: Hand Auger drilling fluid: hole diameter : 50 mm vane id.: SL588, SL817

drilling information				material substance									
method & support	penetration	water	samples & field tests	RL (m)	depth (m)	graphic log	classification symbol	material description	moisture condition	consistency / relative density	vane shear (kPa)	DCP (blows/100 mm)	structure and additional observations
	1 2 3							ORGANIC SILT: non plastic, dark brown-black.	M				TOPSOIL
			VS >213 kPa		0.5			SILT: low plasticity, brown mottled pale orange-brown, with trace fine grained sand, some clay.		VSt to H			FILL
			VS >213/ 42 kPa										
			VS 191/ 64 kPa		1.0			Clayey SILT: low plasticity, orange-brown mottled pale orange, with trace fine to medium sand.		St			
			VS 173/ 31 kPa		1.5								
			VS 213/ 45 kPa		2.0			1.6 m: becoming dark brown mottled brown	M to W S	VSt to H			
			VS 213/ 48 kPa		2.5								
			VS 222/ 86 kPa		3.0								
					3.0			Hand Auger HAL583 terminated at 3.0 m Target depth					
					3.5								
					4.0								
					4.5								

method AD auger drilling* AS auger screwing* HA hand auger W washbore HA hand auger	support M mud C casing N nil	samples & field tests B bulk disturbed sample D disturbed sample E environmental sample SS split spoon sample U## undisturbed sample ##mm diameter HP hand penetrometer (kPa) N standard penetration test (SPT) N* SPT - sample recovered Nc SPT with solid cone VS vane shear; peak/remoulded (kPa) R refusal HB hammer bouncing	classification symbol & soil description based on Unified Classification System	consistency / relative density VS very soft S soft F firm St stiff VSt very stiff H hard Fb friable VL very loose L loose MD medium dense D dense VD very dense
penetration 	moisture D dry M moist W wet S saturated Wp plastic limit WI liquid limit			

* bit shown by suffix
e.g.
AD/T
B blank bit
T TC bit
V V bit

Engineering Log - Hand Auger

client: **THE LAKES (2012) LIMITED**

principal:

project: **THE LAKES, STAGE 3I GCR**

location: **BOUNDARY OF LOT 583 AND 584**

Borehole ID. **HAL583-584**

sheet: 1 of 1

project no. **773-GENZTAUC13086AP**

date started: **16 Oct 2017**

date completed: **16 Oct 2017**

logged by: **PRM**

checked by: **DBC**

position: Not Specified surface elevation: Not Specified angle from horizontal: 90° DCP id.:
drill model: Hand Auger drilling fluid: hole diameter : 50 mm vane id.: 1447

drilling information					material substance											
method & support	penetration		water	samples & field tests	RL (m)	depth (m)	graphic log	classification symbol	material description SOIL TYPE: plasticity or particle characteristic, colour, secondary and minor components	moisture condition	consistency / relative density	vane shear		DCP (blows/ 100 mm)	structure and additional observations	
	1	2										⊕ remoulded	⊙ peak			(kPa)
HA	1	2							ORGANIC SILT: non plastic, dark brown black.	M		50	100	2	TOPSOIL	
	3			VS 196/ 25 kPa		0.5		Clayey SILT: low plasticity, brown mottled pale brown, with trace fine grained sand.		VSt to H	⊕	⊙		FILL		
				VS >247 kPa		1.0							⊙			
				VS UTP		1.5		1.4 m: becoming brown mottled pale brown/ orange-brown/ dark brown								
			▽ water table encountered	VS 186/ 29 kPa		2.0			S		⊕	⊙	⊙			
				VS >247 kPa		2.5										
				VS UTP		3.0										
				VS UTP		3.5										
				VS UTP		4.0										
				VS UTP		4.5										
						3.0			Hand Auger HAL583-584 terminated at 3.0 m Target depth			VS UTP				

method AD auger drilling* AS auger screwing* HA hand auger W washbore HA hand auger	support M mud C casing N nil	samples & field tests B bulk disturbed sample D disturbed sample E environmental sample SS split spoon sample U## undisturbed sample ##mm diameter HP hand penetrometer (kPa) N standard penetration test (SPT) N* SPT - sample recovered Nc SPT with solid cone VS vane shear; peak/remoulded (kPa) R refusal HB hammer bouncing	classification symbol & soil description based on Unified Classification System	consistency / relative density VS very soft S soft F firm St stiff VSt very stiff H hard Fb friable VL very loose L loose MD medium dense D dense VD very dense
* bit shown by suffix e.g. AD/T B blank bit T TC bit V V bit	penetration 		moisture D dry M moist W wet S saturated Wp plastic limit Wl liquid limit	

Engineering Log - Hand Auger

client: **THE LAKES (2012) LIMITED**

principal:

project: **THE LAKES, STAGE 3I GCR**

location: **CENTRE OF LOT 584**

Borehole ID. **HAL584**

sheet: 1 of 1

project no. **773-GENZTAUC13086AP**

date started: **16 Oct 2017**

date completed: **16 Oct 2017**

logged by: **SBG**

checked by: **DBC**

position: Not Specified surface elevation: Not Specified angle from horizontal: 90° DCP id.:
drill model: Hand Auger drilling fluid: hole diameter : 50 mm vane id.: SL817

drilling information					material substance									
method & support	penetration		water	samples & field tests	RL (m)	depth (m)	graphic log	classification symbol	material description	moisture condition	consistency / relative density	vane shear ⊕ remoulded ⊙ peak (kPa)	DCP (blows/ 100 mm)	structure and additional observations
HA N	1	2	Not Encountered	VS 144/ 63 kPa		0.5			ORGANIC SILT: non plastic, dark brown black.	D to M	VSt	⊕	⊙	TOPSOIL
		VS 213/ 63 kPa				0.6 m: with minor fine to medium grained sand		M				FILL		
		VS 247 kPa			1.0				H	⊕			⊙	
		VS 247 kPa			1.5									
			VS 222/ 90 kPa		2.0				Sandy SILT: non plastic to low plasticity, pale brown grey mottled black white orange, sand is fine to medium grained, minor clay.	W		⊕	⊙	
			VS 247 kPa		2.5					M		⊕	⊙	
			VS 247 kPa		3.0				Hand Auger HAL584 terminated at 3.0 m Target depth			⊕	⊙	
						3.5								
						4.0								
						4.5								

method AD auger drilling* AS auger screwing* HA hand auger W washbore HA hand auger	support M mud C casing N nil	penetration water 10-Oct-12 water level on date shown water inflow water outflow	samples & field tests B bulk disturbed sample D disturbed sample E environmental sample SS split spoon sample U## undisturbed sample ##mm diameter HP hand penetrometer (kPa) N standard penetration test (SPT) N* SPT - sample recovered Nc SPT with solid cone VS vane shear; peak/remoulded (kPa) R refusal HB hammer bouncing	classification symbol & soil description based on Unified Classification System moisture D dry M moist W wet S saturated Wp plastic limit WL liquid limit	consistency / relative density VS very soft S soft F firm St stiff VSt very stiff H hard Fb friable VL very loose L loose MD medium dense D dense VD very dense
---	--	--	--	---	--

* bit shown by suffix
e.g.
AD/T
B blank bit
T TC bit
V V bit

Engineering Log - Hand Auger

client: **THE LAKES (2012) LIMITED**

principal:

project: **THE LAKES, STAGE 3I GCR**

location: **BOUNDARY OF LOT 584 AND 585**

Borehole ID. **HAL584-585**

sheet: 1 of 1

project no. **773-GENZTAUC13086AP**

date started: **26 Oct 2017**

date completed: **26 Oct 2017**

logged by: **ODS**

checked by: **DBC**

position: Not Specified surface elevation: Not Specified angle from horizontal: 90° DCP id.:
drill model: Hand Auger drilling fluid: hole diameter : 50 mm vane id.: SL588

drilling information					material substance								
method & support	penetration	water	samples & field tests	RL (m)	depth (m)	graphic log	classification symbol	material description	moisture condition	consistency / relative density	vane shear ⊕ remoulded ⊙ peak (kPa)	DCP (blows/ 100 mm)	structure and additional observations
HA N	1 2 3												
			VS 122/ 26 kPa		0.5			SILT: non plastic, orange mottled brown.	D to M	VSt to H	⊕ ⊙		FILL
		Not Encountered	VS 213 kPa		1.0								
			VS 156/ 43 kPa		1.5						⊕ ⊙		
			VS 147/ 48 kPa		2.0						⊕ ⊙		
			VS 213 kPa		2.0			Hand Auger HAL584-585 terminated at 2.0 m Target depth			⊙		
					2.5								
					3.0								
					3.5								
					4.0								
					4.5								

method AD auger drilling* AS auger screwing* HA hand auger W washbore HA hand auger * bit shown by suffix e.g. AD/T B blank bit T TC bit V V bit	support M mud C casing penetration no resistance ranging to refusal water 10-Oct-12 water level on date shown water inflow water outflow	samples & field tests B bulk disturbed sample D disturbed sample E environmental sample SS split spoon sample U## undisturbed sample ##mm diameter HP hand penetrometer (kPa) N standard penetration test (SPT) N* SPT - sample recovered Nc SPT with solid cone VS vane shear; peak/remoulded (kPa) R refusal HB hammer bouncing	classification symbol & soil description based on Unified Classification System moisture D dry M moist W wet S saturated Wp plastic limit Wl liquid limit	consistency / relative density VS very soft S soft F firm St stiff VSt very stiff H hard Fb friable VL very loose L loose MD medium dense D dense VD very dense
--	---	--	---	--

Engineering Log - Hand Auger

client: **THE LAKES (2012) LIMITED**

principal:

project: **THE LAKES, STAGE 3I GCR**

location: **CENTRE OF LOT 585**

Borehole ID. **HAL585**

sheet: 1 of 1

project no. **773-GENZTAUC13086AP**

date started: **16 Oct 2017**

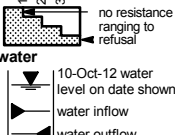
date completed: **16 Oct 2017**

logged by: **SBG**

checked by: **DBC**

position: Not Specified surface elevation: Not Specified angle from horizontal: 90° DCP id.:
drill model: Hand Auger drilling fluid: hole diameter : 50 mm vane id.: SL817

drilling information				material substance									
method & support	penetration	water	samples & field tests	RL (m)	depth (m)	graphic log	classification symbol	material description	moisture condition	consistency / relative density	vane shear remoulded peak (kPa)	DCP (blows/ 100 mm)	structure and additional observations
HA	1							ORGANIC SILT: non plastic, dark brown black.	D to M				TOPSOIL
	2		VS 247 kPa		0.5			SILT: non plastic to low plasticity, brown orange mottled black white.	M				FILL
	3		VS 196/ 47 kPa					0.6 m: becoming slightly plastic with trace clay		VSt to H			
			VS 134/ 55 kPa		1.0			Clayey SILT: low to medium plasticity, brown orange mottled black white.					
			VS 247 kPa		1.5								
			VS 222/ 50 kPa		2.0			2.1 m: with trace fine to medium grained sand	W				
			VS 167/ 51 kPa		2.5			Sandy SILT: non plastic to low plasticity, pale brown grey mottled black white orange, minor clay.	M				
			VS 218/ 69 kPa		3.0			Hand Auger HAL585 terminated at 3.0 m Target depth					
					3.5								
					4.0								
					4.5								

method AD auger drilling* AS auger screwing* HA hand auger W washbore HA hand auger	support M mud C casing N nil	samples & field tests B bulk disturbed sample D disturbed sample E environmental sample SS split spoon sample U## undisturbed sample ##mm diameter HP hand penetrometer (kPa) N standard penetration test (SPT) N* SPT - sample recovered Nc SPT with solid cone VS vane shear; peak/remoulded (kPa) R refusal HB hammer bouncing	classification symbol & soil description based on Unified Classification System	consistency / relative density VS very soft S soft F firm St stiff VSt very stiff H hard Fb friable VL very loose L loose MD medium dense D dense VD very dense
* bit shown by suffix e.g. AD/T B blank bit T TC bit V V bit	penetration 		moisture D dry M moist W wet S saturated Wp plastic limit Wl liquid limit	

Engineering Log - Hand Auger

client: **THE LAKES (2012) LIMITED**

principal:

project: **THE LAKES, STAGE 3I GCR**

location: **BOUNDARY OF LOT 585 and 586**

Borehole ID. **HAL585-586**

sheet: 1 of 1

project no. **773-GENZTAUC13086AP**

date started: **16 Oct 2017**

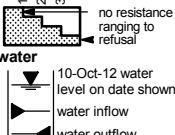
date completed: **16 Oct 2017**

logged by: **ODS**

checked by: **DBC**

position: Not Specified surface elevation: Not Specified angle from horizontal: 90° DCP id.:
drill model: Hand Auger drilling fluid: hole diameter : 50 mm vane id.: SL817

drilling information					material substance								
method & support	penetration	water	samples & field tests	RL (m)	depth (m)	graphic log	classification symbol	material description	moisture condition	consistency / relative density	vane shear ⊕ remoulded ⊙ peak (kPa)	DCP (blows/ 100 mm)	structure and additional observations
HA	1	16/10/17, perched water table						ORGANIC SILT: non plastic, dark brown black.	M				TOPSOIL
	2		VS 83/ 16 kPa	0.5			SILT: low plasticity, orange mottled brown, with minor clay, and trace fine grained sand.	St	⊕ ⊙				
N	3		VS 84/ 20 kPa		1.0				S		⊕ ⊙		
			VS 213 kPa		1.5			1.5 m: with pale pink clayey silt inclusions		H		⊙	
			VS >213 kPa		2.0						⊙		
			VS >213 kPa		2.5						⊙		
			VS >213 kPa		3.0			Hand Auger HAL585-586 terminated at 3.0 m Target depth				⊙	
					3.5								
					4.0								
					4.5								

method AD auger drilling* AS auger screwing* HA hand auger W washbore HA hand auger	support M mud C casing N nil	samples & field tests B bulk disturbed sample D disturbed sample E environmental sample SS split spoon sample U## undisturbed sample ##mm diameter HP hand penetrometer (kPa) N standard penetration test (SPT) N* SPT - sample recovered Nc SPT with solid cone VS vane shear; peak/remoulded (kPa) R refusal HB hammer bouncing	classification symbol & soil description based on Unified Classification System	consistency / relative density VS very soft S soft F firm St stiff VSt very stiff H hard Fb friable VL very loose L loose MD medium dense D dense VD very dense
* bit shown by suffix e.g. AD/T B blank bit T TC bit V V bit	penetration  no resistance ranging to refusal 10-Oct-12 water level on date shown water inflow water outflow		moisture D dry M moist W wet S saturated Wp plastic limit WL liquid limit	

Engineering Log - Hand Auger

client: **THE LAKES (2012) LIMITED**

principal:

project: **THE LAKES, STAGE 3I GCR**

location: **CENTRE OF LOT 586**

Borehole ID. **HAL586**

sheet: 1 of 1

project no. **773-GENZTAUC13086AP**

date started: **16 Oct 2017**

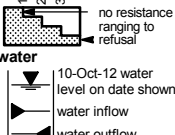
date completed: **16 Oct 2017**

logged by: **SBG**

checked by: **DBC**

position: Not Specified surface elevation: Not Specified angle from horizontal: 90° DCP id.:
drill model: Hand Auger drilling fluid: hole diameter : 50 mm vane id.: 1447

drilling information				material substance									
method & support	penetration	water	samples & field tests	RL (m)	depth (m)	graphic log	classification symbol	material description	moisture condition	consistency / relative density	vane shear remoulded peak (kPa)	DCP (blows/100 mm)	structure and additional observations
HA	1							ORGANIC SILT: non plastic, dark brown black.	M				TOPSOIL
	2		VS UTP		0.5			Clayey SILT: low plasticity, brown mottled pale brown/pink/orange-brown, with trace fine to medium grained sand.		H	VS UTP		FILL
	3		VS >209/39 kPa		1.0								
			VS >247/39 kPa		1.5								
			VS 227/39 kPa		2.0			1.5 m: with trace black charcoal inclusions (no organic odour) 1.6 m: no black charcoal inclusions					
			VS 213/35 kPa		2.5								
			VS >247 kPa		3.0			Hand Auger HAL586 terminated at 3.0 m Target depth					
			VS >247 kPa		3.5								
			VS >247 kPa		4.0								
			VS >247 kPa		4.5								

method AD auger drilling* AS auger screwing* HA hand auger W washbore HA hand auger	support M mud C casing N nil	samples & field tests B bulk disturbed sample D disturbed sample E environmental sample SS split spoon sample U## undisturbed sample ##mm diameter HP hand penetrometer (kPa) N standard penetration test (SPT) N* SPT - sample recovered Nc SPT with solid cone VS vane shear; peak/remoulded (kPa) R refusal HB hammer bouncing	classification symbol & soil description based on Unified Classification System	consistency / relative density VS very soft S soft F firm St stiff VSt very stiff H hard Fb friable VL very loose L loose MD medium dense D dense VD very dense
* bit shown by suffix e.g. AD/T B blank bit T TC bit V V bit	penetration 		moisture D dry M moist W wet S saturated Wp plastic limit Wl liquid limit	

Engineering Log - Hand Auger

client: **THE LAKES (2012) LIMITED**

principal:

project: **THE LAKES, STAGE 3I GCR**

location: **BOUNDARY OF LOT 586 AND 587**

Borehole ID. **HAL586-587**

sheet: 1 of 1

project no. **773-GENZTAUC13086AP**

date started: **16 Oct 2017**

date completed: **16 Oct 2017**

logged by: **SBG**

checked by: **DBC**

position: Not Specified surface elevation: Not Specified angle from horizontal: 90° DCP id.:
drill model: Hand Auger drilling fluid: hole diameter : 50 mm vane id.: SL817

drilling information							material substance								
method & support	penetration			water	samples & field tests	RL (m)	depth (m)	graphic log	classification symbol	material description	moisture condition	consistency / relative density	vane shear ⊕ remoulded ⊙ peak (kPa)	DCP (blows/ 100 mm)	structure and additional observations
HA N	1	2	3	Not Encountered	VS 222/ 50 kPa		0.5			ORGANIC SILT: non plastic, dark brown black.	D to M				TOPSOIL
							SILT: non plastic to low plasticity, brown orange mottled white black dark brown, trace fine to medium grained sand, trace clay.		M	VSt to H	⊕	⊙	FILL		
							0.7 m: becoming pale brown orange mottled black white				⊕	⊙			
							Sandy SILT: non plastic, pale brown grey mottled black brown white, sand fine to medium grained.					⊕			
							SILT: low plasticity, brown orange, trace fine to medium grained sand.					⊕			
							2.0			SILTY SAND: fine to medium grained, pale grey mottled black brown.					MATUA SUBGROUP
							2.0			Hand Auger HAL586-587 terminated at 2.0 m Target depth					
							2.5								
							3.0								
							3.5								
							4.0								
							4.5								

method AD auger drilling* AS auger screwing* HA hand auger W washbore HA hand auger	support M mud C casing N nil	samples & field tests B bulk disturbed sample D disturbed sample E environmental sample SS split spoon sample U## undisturbed sample ##mm diameter HP hand penetrometer (kPa) N standard penetration test (SPT) N* SPT - sample recovered Nc SPT with solid cone VS vane shear; peak/remoulded (kPa) R refusal HB hammer bouncing	classification symbol & soil description based on Unified Classification System	consistency / relative density VS very soft S soft F firm St stiff VSt very stiff H hard Fb friable VL very loose L loose MD medium dense D dense VD very dense
* bit shown by suffix e.g. AD/T B blank bit T TC bit V V bit	penetration no resistance ranging to refusal 10-Oct-12 water level on date shown water inflow water outflow		moisture D dry M moist W wet S saturated Wp plastic limit Wl liquid limit	

Engineering Log - Hand Auger

client: **THE LAKES (2012) LIMITED**

principal:

project: **THE LAKES, STAGE 3I GCR**

location: **CENTRE OF LOT 587**

Borehole ID. **HAL587**

sheet: 1 of 1

project no. **773-GENZTAUC13086AP**

date started: **16 Oct 2017**

date completed: **16 Oct 2017**

logged by: **ODS**

checked by: **DBC**

position: Not Specified surface elevation: Not Specified angle from horizontal: 90° DCP id.:
drill model: Hand Auger drilling fluid: hole diameter : 50 mm vane id.: SL588

drilling information					material substance								
method & support	penetration	water	samples & field tests	RL (m)	depth (m)	graphic log	classification symbol	material description	moisture condition	consistency / relative density	vane shear ⊕ remoulded ⊙ peak (kPa)	DCP (blows/ 100 mm)	structure and additional observations
HA N	1 2 3							ORGANIC SILT: non plastic, dark brown black. SILT: non plastic to low plasticity, brown orange mottled white black dark brown, trace fine to medium grained sand, trace clay.	D to M	H 			

Engineering Log - Hand Auger

client: **THE LAKES (2012) LIMITED**

principal:

project: **THE LAKES, STAGE 3I GCR**

location: **BOUNDARY OF LOT 587 AND 588**

Borehole ID. **HAL587-588**

sheet: 1 of 1

project no. **773-GENZTAUC13086AP**

date started: **26 Oct 2017**

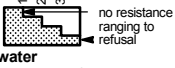
date completed: **26 Oct 2017**

logged by: **SBG**

checked by: **DBC**

position: Not Specified surface elevation: Not Specified angle from horizontal: 90° DCP id.:
drill model: Hand Auger drilling fluid: hole diameter : 50 mm vane id.: DR2244

drilling information					material substance									
method & support	penetration	water	samples & field tests	RL (m)	depth (m)	graphic log	classification symbol	material description	moisture condition	consistency / relative density	vane shear (kPa)	DCP (blows/100 mm)	structure and additional observations	
	1 2 3							SOIL TYPE: plasticity or particle characteristic, colour, secondary and minor components						
								ORGANIC SILT: non plastic, dark brown black.	M				TOPSOIL	
			VS >182 kPa		0.5			SILT: non plastic, brown orange, trace fine to medium grained sand.		VSt to H			FILL	
			VS 141/ 43 kPa		1.0									
			VS 92/ 37 kPa		1.5			Clayey SILT: low plasticity, brown orange, trace fine to medium grained sand.		St				
			VS >182 kPa		2.0			SILT: non plastic, brown orange mottled pink, trace clay, trace fine to medium grained sand.		VSt to H				
			VS >182 kPa		2.5									
			VS >182 kPa		3.0			Silty CLAY: low to medium plasticity, brown orange mottled black.						
			VS >182 kPa		3.5			Hand Auger HAL587-588 terminated at 3.0 m Target depth						
					4.0									
					4.5									

method AD auger drilling* AS auger screwing* HA hand auger W washbore HA hand auger	support M mud C casing N nil	penetration  10-Oct-12 water level on date shown water inflow water outflow	samples & field tests B bulk disturbed sample D disturbed sample E environmental sample SS split spoon sample U## undisturbed sample ##mm diameter HP hand penetrometer (kPa) N standard penetration test (SPT) N* SPT - sample recovered Nc SPT with solid cone VS vane shear; peak/remoulded (kPa) R refusal HB hammer bouncing	classification symbol & soil description based on Unified Classification System moisture D dry M moist W wet S saturated Wp plastic limit Wl liquid limit	consistency / relative density VS very soft S soft F firm St stiff VSt very stiff H hard Fb friable VL very loose L loose MD medium dense D dense VD very dense
---	--	---	--	---	--

* bit shown by suffix
e.g.
AD/T
B blank bit
T TC bit
V V bit

Engineering Log - Hand Auger

client: **THE LAKES (2012) LIMITED**

principal:

project: **THE LAKES, STAGE 3I GCR**

location: **CENTRE OF LOT 588**

Borehole ID. **HAL588**

sheet: 1 of 1

project no. **773-GENZTAUC13086AP**

date started: **26 Oct 2017**

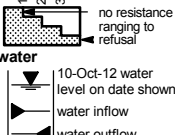
date completed: **26 Oct 2017**

logged by: **SBG**

checked by: **DBC**

position: Not Specified surface elevation: Not Specified angle from horizontal: 90° DCP id.:
drill model: Hand Auger drilling fluid: hole diameter : 50 mm vane id.: DR2244

drilling information					material substance								
method & support	penetration	water	samples & field tests	RL (m)	depth (m)	graphic log	classification symbol	material description	moisture condition	consistency / relative density	vane shear ⊕ remoulded ⊙ peak (kPa)	DCP (blows/ 100 mm)	structure and additional observations
HA N	1 2 3							Clayey SILT: low plasticity, orange brown mottled brown, with trace fine grained sand.	M	VSt	50 100 150 200	2 4 6 8 10	FILL
		Not Encountered	VS >182 kPa		0.5						⊙		
			VS >182 kPa		1.0						⊙		
			VS >182 kPa		1.5						⊙		
			VS >182 kPa		2.0						⊙		
			VS >182 kPa		2.0			Hand Auger HAL588 terminated at 2.0 m Target depth			⊙		
					2.5								
					3.0								
					3.5								
					4.0								
					4.5								

method AD auger drilling* AS auger screwing* HA hand auger W washbore HA hand auger	support M mud C casing N nil	samples & field tests B bulk disturbed sample D disturbed sample E environmental sample SS split spoon sample U## undisturbed sample ##mm diameter HP hand penetrometer (kPa) N standard penetration test (SPT) N* SPT - sample recovered Nc SPT with solid cone VS vane shear; peak/remoulded (kPa) R refusal HB hammer bouncing	classification symbol & soil description based on Unified Classification System	consistency / relative density VS very soft S soft F firm St stiff VSt very stiff H hard Fb friable VL very loose L loose MD medium dense D dense VD very dense
* bit shown by suffix e.g. AD/T B blank bit T TC bit V V bit	penetration 		moisture D dry M moist W wet S saturated Wp plastic limit Wl liquid limit	

Engineering Log - Hand Auger

client: **THE LAKES (2012) LIMITED**

principal:

project: **THE LAKES, STAGE 3I GCR**

location: **CORNER OF LOT 588**

Borehole ID. **HAL588c**

sheet: 1 of 1

project no. **773-GENZTAUC13086AP**

date started: **26 Oct 2017**

date completed: **26 Oct 2017**

logged by: **PRM**

checked by: **DBC**

position: Not Specified surface elevation: Not Specified angle from horizontal: 90° DCP id.:
drill model: Hand Auger drilling fluid: hole diameter : 50 mm vane id.: DR2244

drilling information					material substance								
method & support	penetration	water	samples & field tests	RL (m)	depth (m)	graphic log	classification symbol	material description	moisture condition	consistency / relative density	vane shear ⊕ remoulded ⊙ peak (kPa)	DCP (blows/ 100 mm)	structure and additional observations
↑ HA ↓ ↑ N ↓	1 2 3							SILT: non plastic, brown orange mottled black white, minor fine to medium grained sand.	M	VSt to H	⊕	⊙	FILL
		VS 107/ 25 kPa	0.5				⊕	⊙					
		VS >247 kPa	1.0					⊙					
		VS >247 kPa	1.5					⊙					
		VS >247 kPa	2.0				⊕	⊙					
			VS 151/ 81 kPa		2.0			2.4 m: shear vane possibly slipping on gravel					
					2.5			Hand Auger HAL588c terminated at 2.5 m Target depth					
					3.0								
					3.5								
					4.0								
					4.5								

method AD auger drilling* AS auger screwing* HA hand auger W washbore HA hand auger	support M mud C casing N nil	samples & field tests B bulk disturbed sample D disturbed sample E environmental sample SS split spoon sample U## undisturbed sample ##mm diameter HP hand penetrometer (kPa) N standard penetration test (SPT) N* SPT - sample recovered Nc SPT with solid cone VS vane shear; peak/remoulded (kPa) R refusal HB hammer bouncing	classification symbol & soil description based on Unified Classification System	consistency / relative density VS very soft S soft F firm St stiff VSt very stiff H hard Fb friable VL very loose L loose MD medium dense D dense VD very dense
* bit shown by suffix e.g. AD/T B blank bit T TC bit V V bit	penetration 		moisture D dry M moist W wet S saturated Wp plastic limit Wl liquid limit	

Appendix E – Fill Test Summary Tables

FILL TEST RESULTS						
Summary of earthfill test data						
Test Number	Date	Test RL (m)	Result			Pass/Fail
			Air Voids (%)	Shear Vane (kPa)	Scala (blows per 100mm)	
A-295	27/12/2007	40.3	2.0	232+	-	Pass
A-296		38.0	0.0	243+	-	Pass
A-297	28/12/2007	38.1	0.0	243+	-	Pass
A-298		36.5	0.0	222+	-	Pass
A-299		36.6	4.1	243+	-	Pass
A-300		35.8	0.0	218+	-	Pass
A-301		37.3	0.0	243+	-	Pass
A-302		40.1	0.0	235+	-	Pass
A-303		36.8	0.7	243+	-	Pass
A-304		35.7	0.0	223+	-	Pass
A-305		36.3	0.0	243+	-	Pass
B-23	5/11/2014	45.03	-	209	-	Pass
B-24		46.32	-	211	-	Pass
B-25		43.47	-	190	-	Pass
B-34	27/11/2014	30.46	1	199	-	Pass
B-35		30.04	3.6	199	-	Pass
B-36		30.09	-1.3	216	-	Pass
B-37		29.44	2	125	-	Fail - Area Reworked
B-38		28.65	7.8	174	-	Pass
B-39		29.44	9.8	177	-	Pass
B-40		29.56	8.5	179	-	Pass
B-41		30.20	-1.3	162	-	Pass
B-42		30.02	1.4	200	-	Pass
B-43		30.38	2.7	186	-	Pass
B-44		30.04	4.9	185	-	Pass
B-45		29.62	-2.7	124	-	Fail
B-46		29.74	2.8	210	-	Pass
B-47			4.1	196	-	Pass
B-60A	11/02/2015	46.70	14.8	232	-	Fail - Area Reworked
B-61A		48.39	10.9	232	-	Fail - Area Reworked
B-62A		46.20	4	232	-	Pass
B-63A		45.12	8.3	232	-	Pass
B-64A		44.61	14.9	120	-	Fail - Area Reworked
B-65A		45.78	2.5	232	-	Pass
B-66		43.35	5.7	232	-	Pass
B-67		42.65	5.3	220	-	Pass
B-68		42.71	6	215	-	Pass
B-69		43.57	6.2	231	-	Pass
B-70			1.9	107	-	Fail - Area Reworked
B-71		31.90	11.5	114	-	Fail - Area Reworked
B-72		32.03	2.1	232	-	Pass
B-73		31.69	2.3	232	-	Pass
B-74		32.09	3.4	198	-	Pass
B-75	12/02/2015	32.01	1.3	206	-	Pass
B-76		33.01	3.7	196	-	Pass
B-77		32.18	1.6	159	-	Pass
B-78		32.42	-0.4	194	-	Pass
B-79		33.61	-1.3	230	-	Pass
B-80		32.90	-1.5	177	-	Pass
B-81		31.97	4.7	162	-	Pass
B-82		32.80	8.2	200	-	Pass
B-83		31.82	4	232	-	Pass
B-84		32.69	6.8	158	-	Pass
B-85		31.67	0.4	201	-	Pass
B-86		32.34	2.2	159	-	Pass
B-87		31.70	-2.2	225	-	Pass
B-88		32.00	0	195	-	Pass
B-89		30.96	-0.5	232	-	Pass
B-90		31.87	3.4	232	-	Pass
B-91		30.49	10.4	196	-	Pass
B-92		31.19	5.5	232	-	Pass
B-93		32.30	2.7	183	-	Pass
B-94		32.55	3.6	210	-	Pass
B-95		31.72	5.4	232	-	Pass
B-96		32.84	4.1	220	-	Pass
B-97		31.62	-3.8	220	-	Pass
B-98		31.71	8.4	232	-	Pass
B-99		32.63	0.3	196	-	Pass
B-100		32.31	3.2	222	-	Pass
B-101		31.61	3.5	213	-	Pass
B-102		32.76	0.9	219	-	Pass
B-103		31.23	2.4	UTP	-	Pass

Test Number	Date	Test RL (m)	Result			Pass/Fail
			Air Voids (%)	Shear Vane (kPa)	Scala (blows per 100mm)	
B-104		32.74	9.7	232	-	Pass
B-105		31.77	2.1	232	-	Pass
B-106		32.80	0.4	232	-	Pass
B-107		31.94	0.3	219	-	Pass
B-108		32.66	3.7	232	-	Pass
B-109		31.72	6.5	230	-	Pass
B-130		32.12	0.3	149	-	Pass
B-131	13/02/2015	31.54	3	232	-	Pass
B-132		32.30	-0.5	188	-	Pass
B-133		31.49	2.1	227	-	Pass
B-134		32.10	-2	172	-	Pass
B-135		31.17	6.1	203	-	Pass
B-136		31.66	2	213	-	Pass
B-137		30.82	12.4	110	-	Fail
B-138		32.17	-0.4	190	-	Pass
B-139		31.61	1.4	225	-	Pass
B-141		32.50	2.6	228	-	Pass
B-142	16/02/2015	31.62	2.6	232	-	Pass
B-143		32.56	1.2	225	-	Pass
B-144		31.48	0.5	157	-	Pass
B-145		32.28	0	189	-	Pass
B-146		31.02	0.2	229	-	Pass
B-147		31.74	7.1	232	-	Pass
B-148		30.22	4.7	232	-	Pass
B-149		31.32	6.2	232	-	Pass
B-150		30.03	7.6	218	-	Pass
B-151		30.51	-0.9	194	-	Pass
B-152		29.09	7.1	178	-	Pass
B-153		29.66	3.7	232	-	Pass
B-154		29.20	6.7	198	-	Pass
B-155		30.00	2.8	224	-	Pass
B-156		29.46	4.6	212	-	Pass
B-157		30.63	7	232	-	Pass
B-158		30.09	-2.1	194	-	Pass
B-159		31.91	0.4	207	-	Pass
B-160		31.01	-0.2	232	-	Pass
B-161		29.96	2.6	213	-	Pass
B-162		30.49	3.5	232	-	Pass
B-163		31.05	3.7	230	-	Pass
B-164		30.67	6.1	232	-	Pass
B-165		31.67	6.6	232	-	Pass
B-166		30.80	4.8	232	-	Pass
B-167		30.64	1.7	231	-	Pass
B-218	9/10/2015	43.92	4.3	206	-	Pass
B-219		43.51	3.4	183	-	Pass
B-249	18/12/2015	29.59	8.0	206	-	Pass
B-250		29.94	3.5	206	-	Pass
B-251	2/02/2016	30.29	-0.2	206	-	Pass
B-255		32.18	Relative Compaction=97%	-	2 - 7	Fail
B-256		32.43	Relative Compaction= 96.2%	-	> 5	Pass
B-257		32.39	Relative Compaction=105.3%	-	> 5	Pass
B-258		31.57	Relative Compaction=91.7%	-	> 5	Pass
B-259		32.70	Relative Compaction=94%	-	> 3	Fail
B-260		31.58	Relative Compaction=89.5%	-	> 4	Fail
B-261		32.01	Relative Compaction=93.2%	-	> 5	Pass
B-263		28.50	Relative Compaction=94.7%	-	1 - 4	Fail
B-264		29.40	11.6	UTP		Pass
B-265		29.33	-1.8	202		Pass
B-266		31.36	5.4	202		Pass
B-267		31.67	5.4	UTP		Pass
B-268		31.50	10.0	202		Pass
B-269		31.92	11.1	202		Pass
B-270		31.12	-7.9	202		Pass
B-271		31.46	-0.7	201		Pass
B-272		31.28	2.3	UTP		Pass
B-273		31.66	8.6	202		Pass
B-274		31.50	0.7	202		Pass
B-275		31.11	-0.4	202		Pass
B-276		30.91	0.0	152		Pass
B-277		30.53	6.3	143		Pass
B-278		31.52	7.7	-	> 5	Pass
B-279		31.20	-0.3	192		Pass
B-280		31.54	6.9	202		Pass
B-281		31.22	0.4	202		Pass
B-282		31.48	5.4	UTP		Pass
B-283		31.19	5.0	202		Pass
B-284		31.40	1.2	202		Pass
B-285		31.08	-2.4	202		Pass

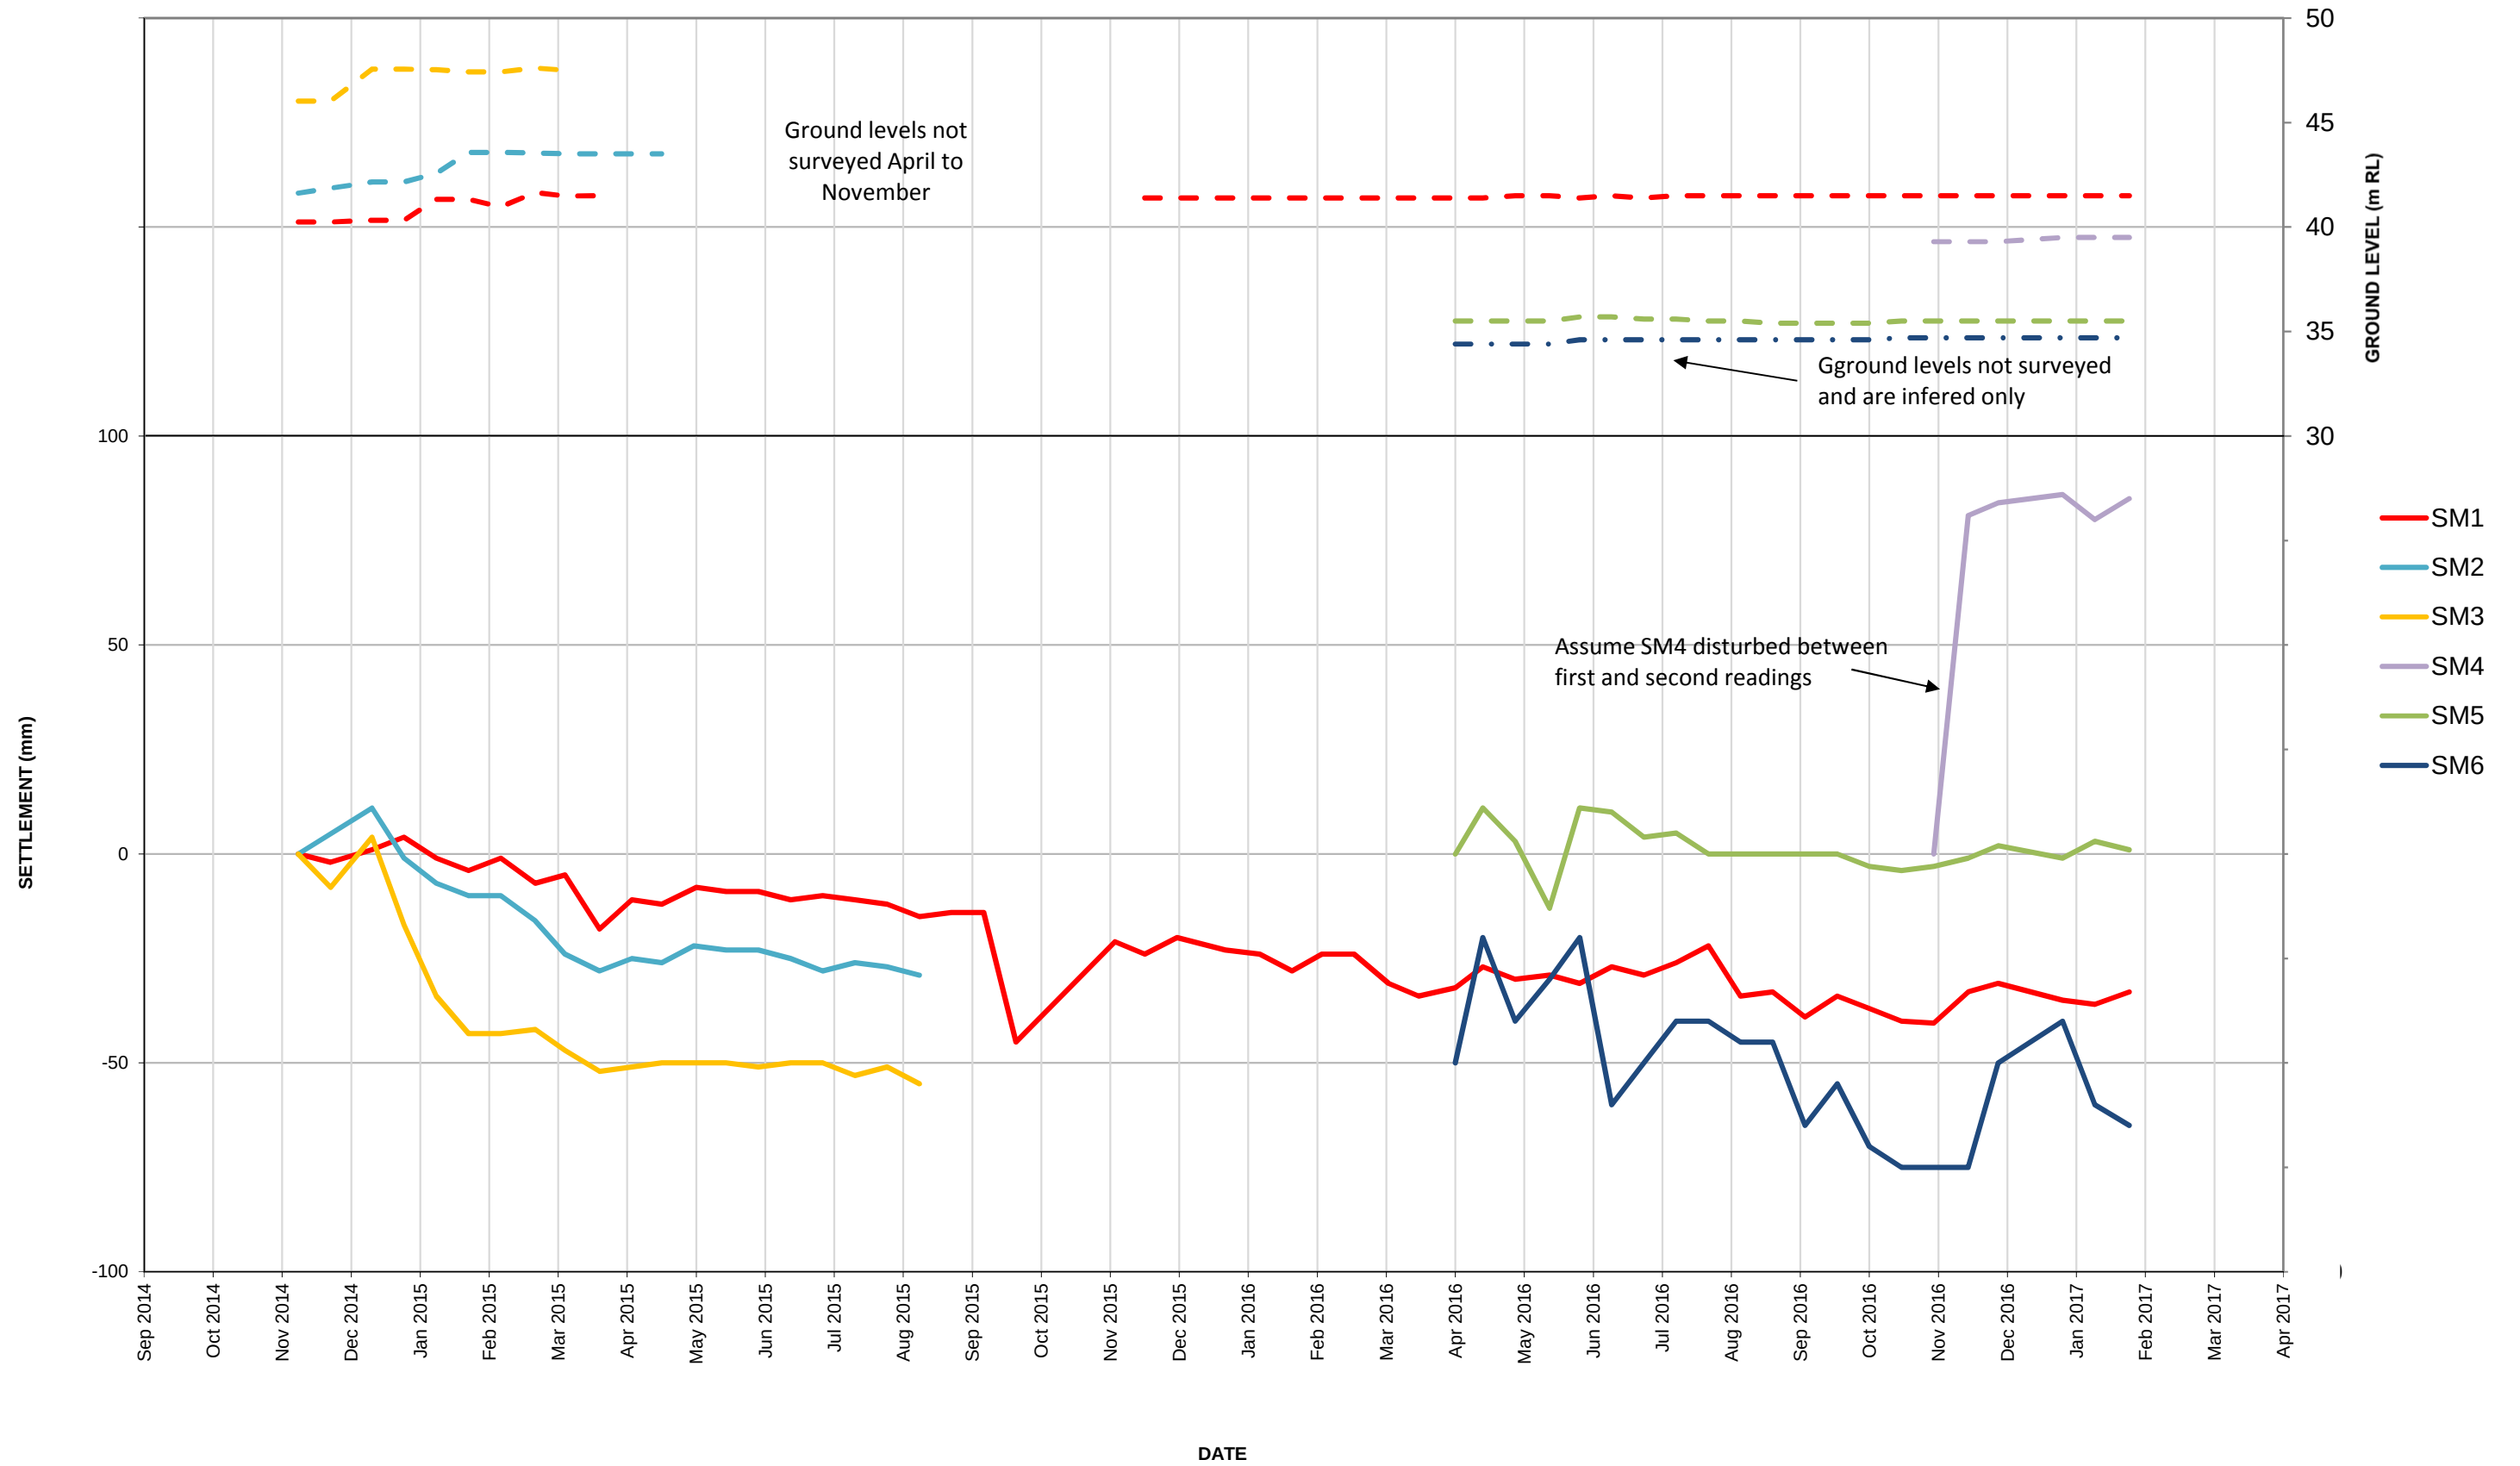
Test Number	Date	Test RL (m)	Result			Pass/Fail
			Air Voids (%)	Shear Vane (kPa)	Scala (blows per 100mm)	
B-286	26/02/2016	31.33	2.7	UTP		Pass
B-287		30.96	6.6	190		Pass
B-288		31.28	0.7	UTP		Pass
B-289		30.92	2.4	202		Pass
B-290		31.62	0.7	128		Fail
B-291		31.14	-2.8	157		Pass
B-292		31.47	-3.8	138		Fail
B-293		31.12	-2.8	202		Pass
B-294		31.43	1.5	159		Pass
B-295		31.14	-0.7	202		Pass
B-296		31.61	0.9	201		Pass
B-297		31.21	-2.8	179		Pass
B-298		31.06	1.3	198		Pass
B-299		30.76	5.3	UTP		Pass
B-300		31.04	6.8	169		Pass
B-301		30.79	7.1	169		Pass
B-302		31.53	1.2	202		Pass
B-303		31.15	1.8	202		Pass
B-304		31.61	2.5	UTP		Pass
B-305		31.21	0.2	202		Pass
B-306		32.08	1.3	UTP		Pass
B-307		31.81	7.2	202		Pass
B-308		31.60	-1.2	198		Pass
B-309		31.25	4.3	196		Pass
B-321	9/11/2016	36.70	2.0	153		Pass
B-322		35.73	2.0	169		Pass
B-323		37.74	3.0	178		Pass
B-324		35.20	2.0	159		Pass
B-325		33.61	0.0	202		Pass
B-330		38.17	7.0	186		Pass
B-336	5/12/2016	41.51	7.0	202		Pass
B-337		40.98	4.0	149		Pass
B-338		41.03	5.0	202		Pass
B-339		43.27	8.0	197		Pass
B-340		41.86	2.0	162		Pass
B-341		42.58	1.0	168		Pass
B-342		43.88	2.0	171		Pass
B-343		36.13	2.0	193		Pass
B-344		37.62	0.0	195		Pass
B-345		40.43	5.0	202		Pass
B-346		37.42	11.0	193		Pass
B-347		36.25	-2.0	198		Pass
B-348		35.90	3.0	172		Pass
B-349	14/12/2016	43.97	9.0	202		Pass
B-350		43.80	7.0	183		Pass
B-351		42.84	4.0	184		Pass
B-352		44.49	7.0	187		Pass
B-353		37.27	6.0	185		Pass

Notes

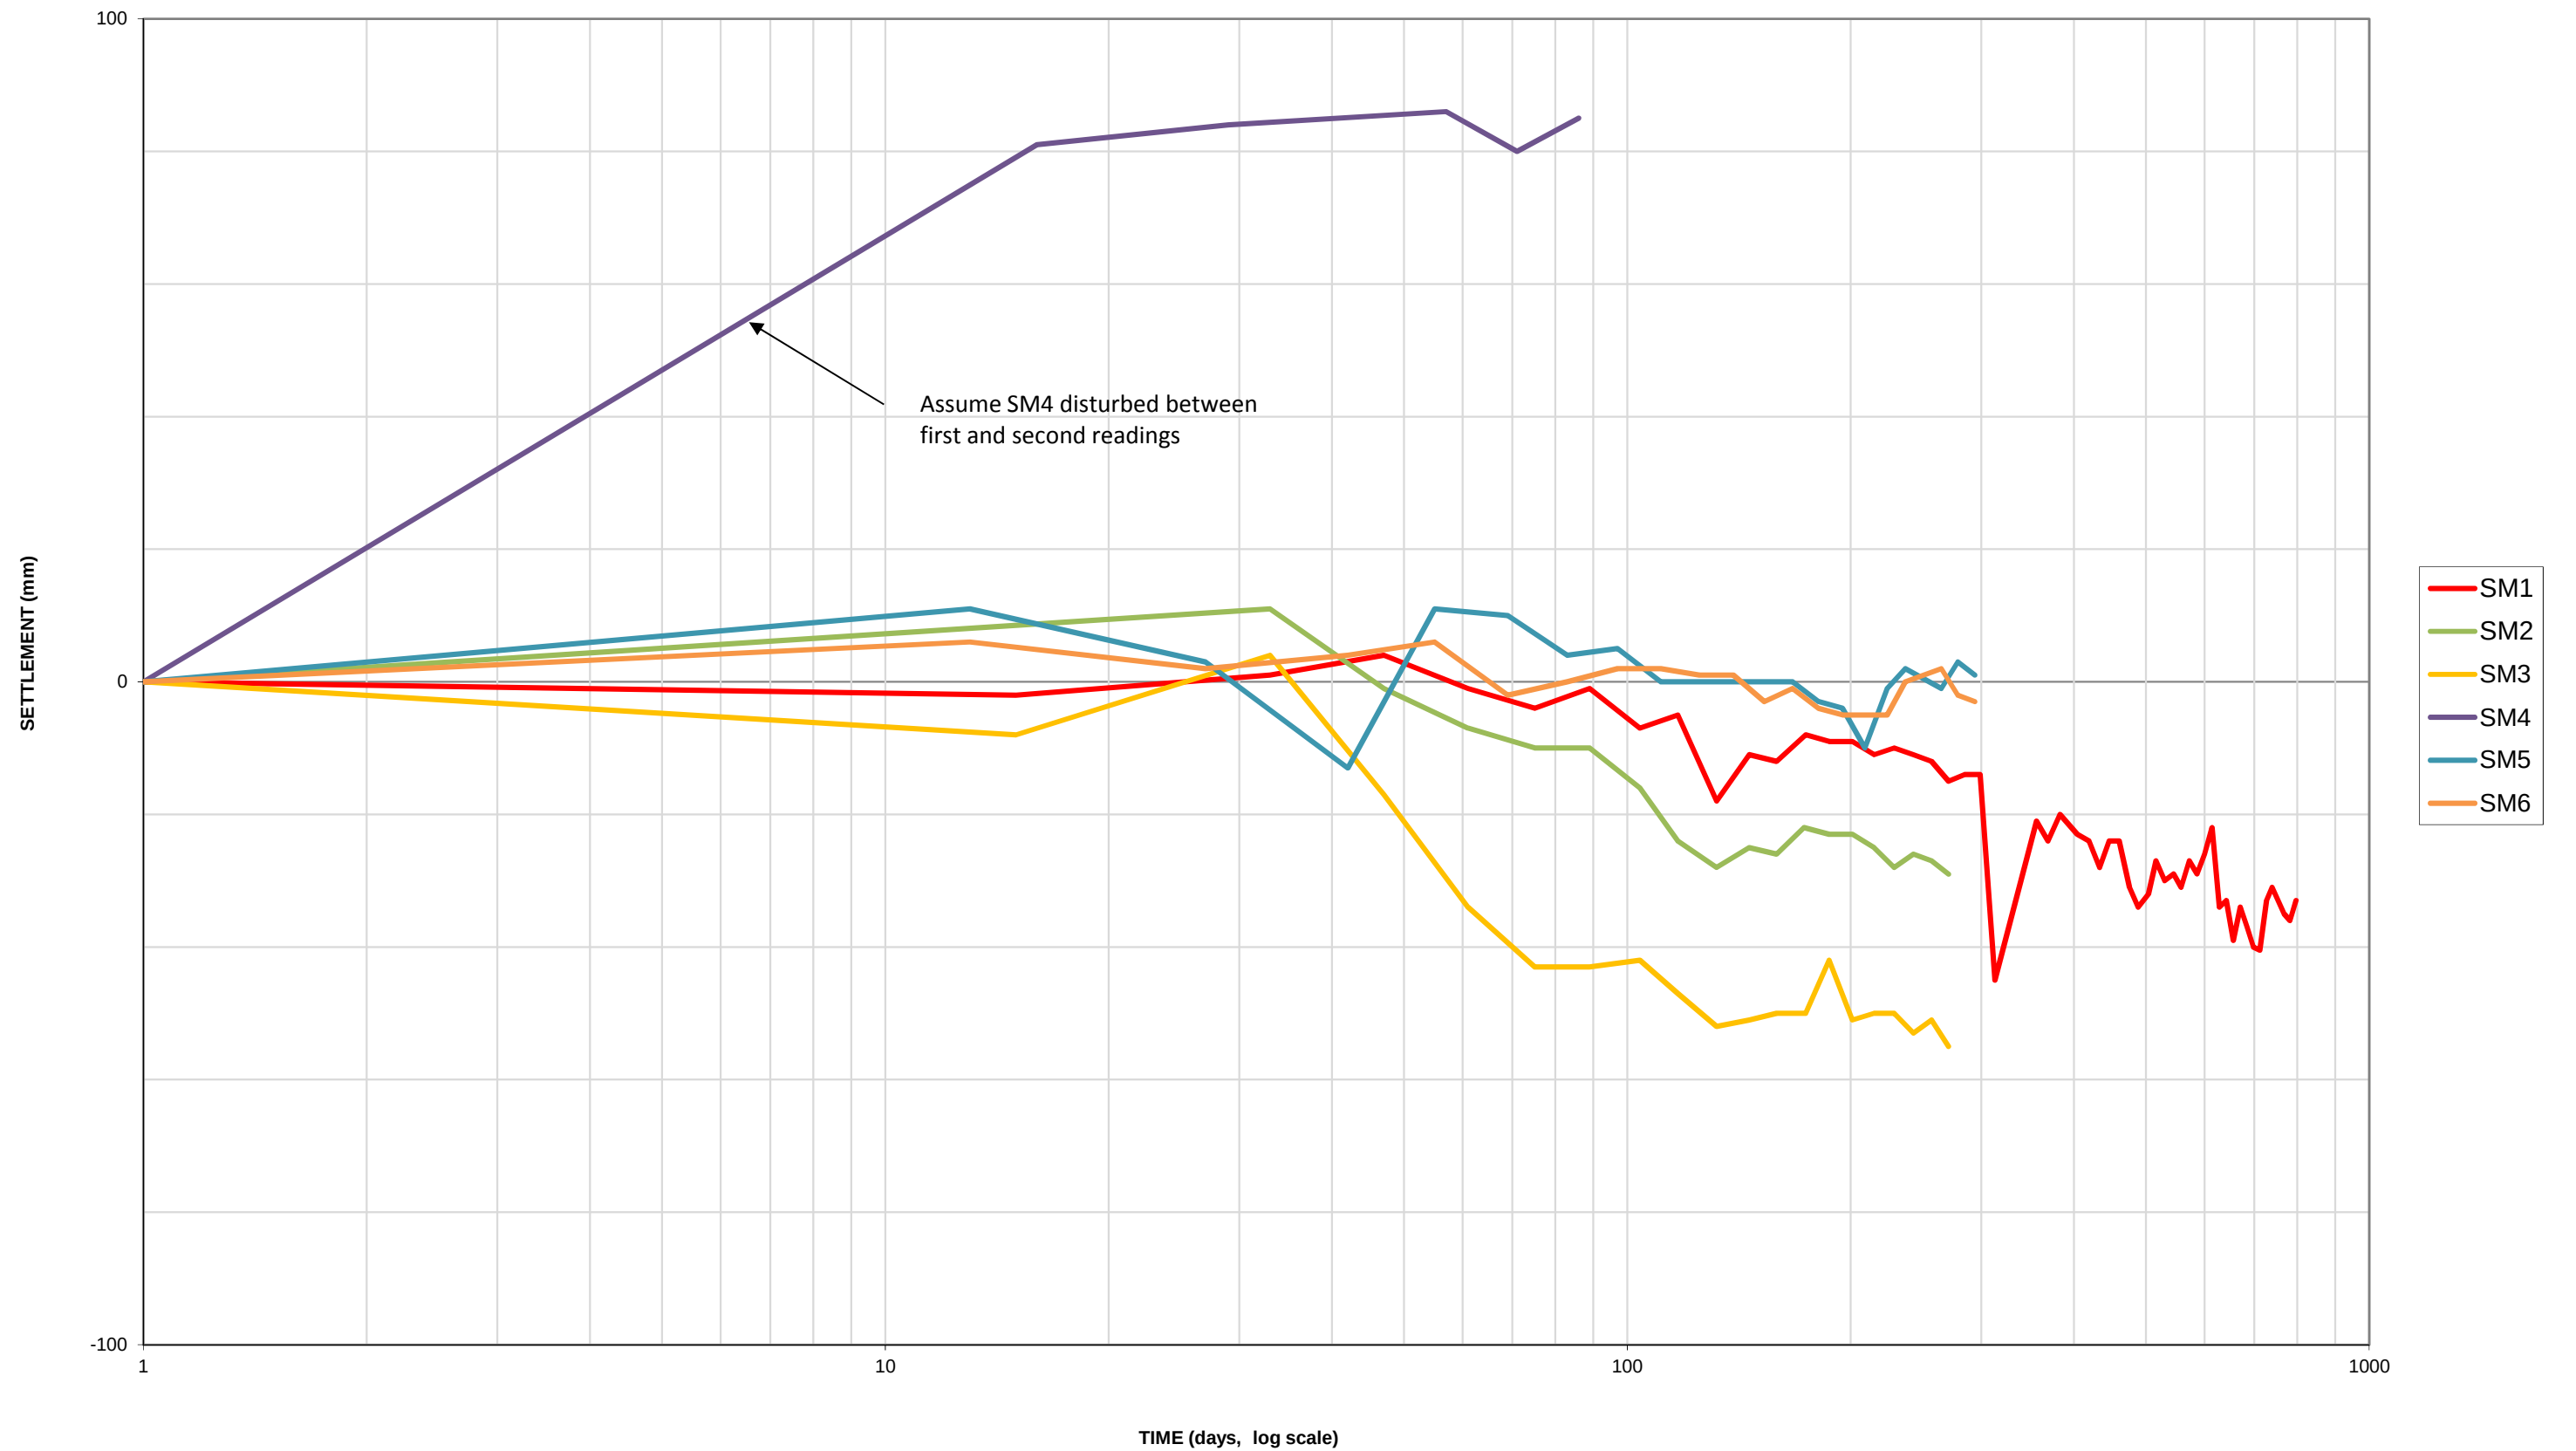
- 1 Shear strength for NDM tests calculated from average of 4 vane tests at each test location. UTP = unable to penetrate.
- 2 A Solid Density of between 2.4 t/m³ and 2.6 t/m³ was assumed for fills depending on source material.
- 3 All test locations and elevations surveyed by JMC Ltd.
- 4 For failed test results, refer to Section 6.2.2 of Coffey GCR ref: GENZTAUC13086AP-AM

Appendix F – Static Settlement Results

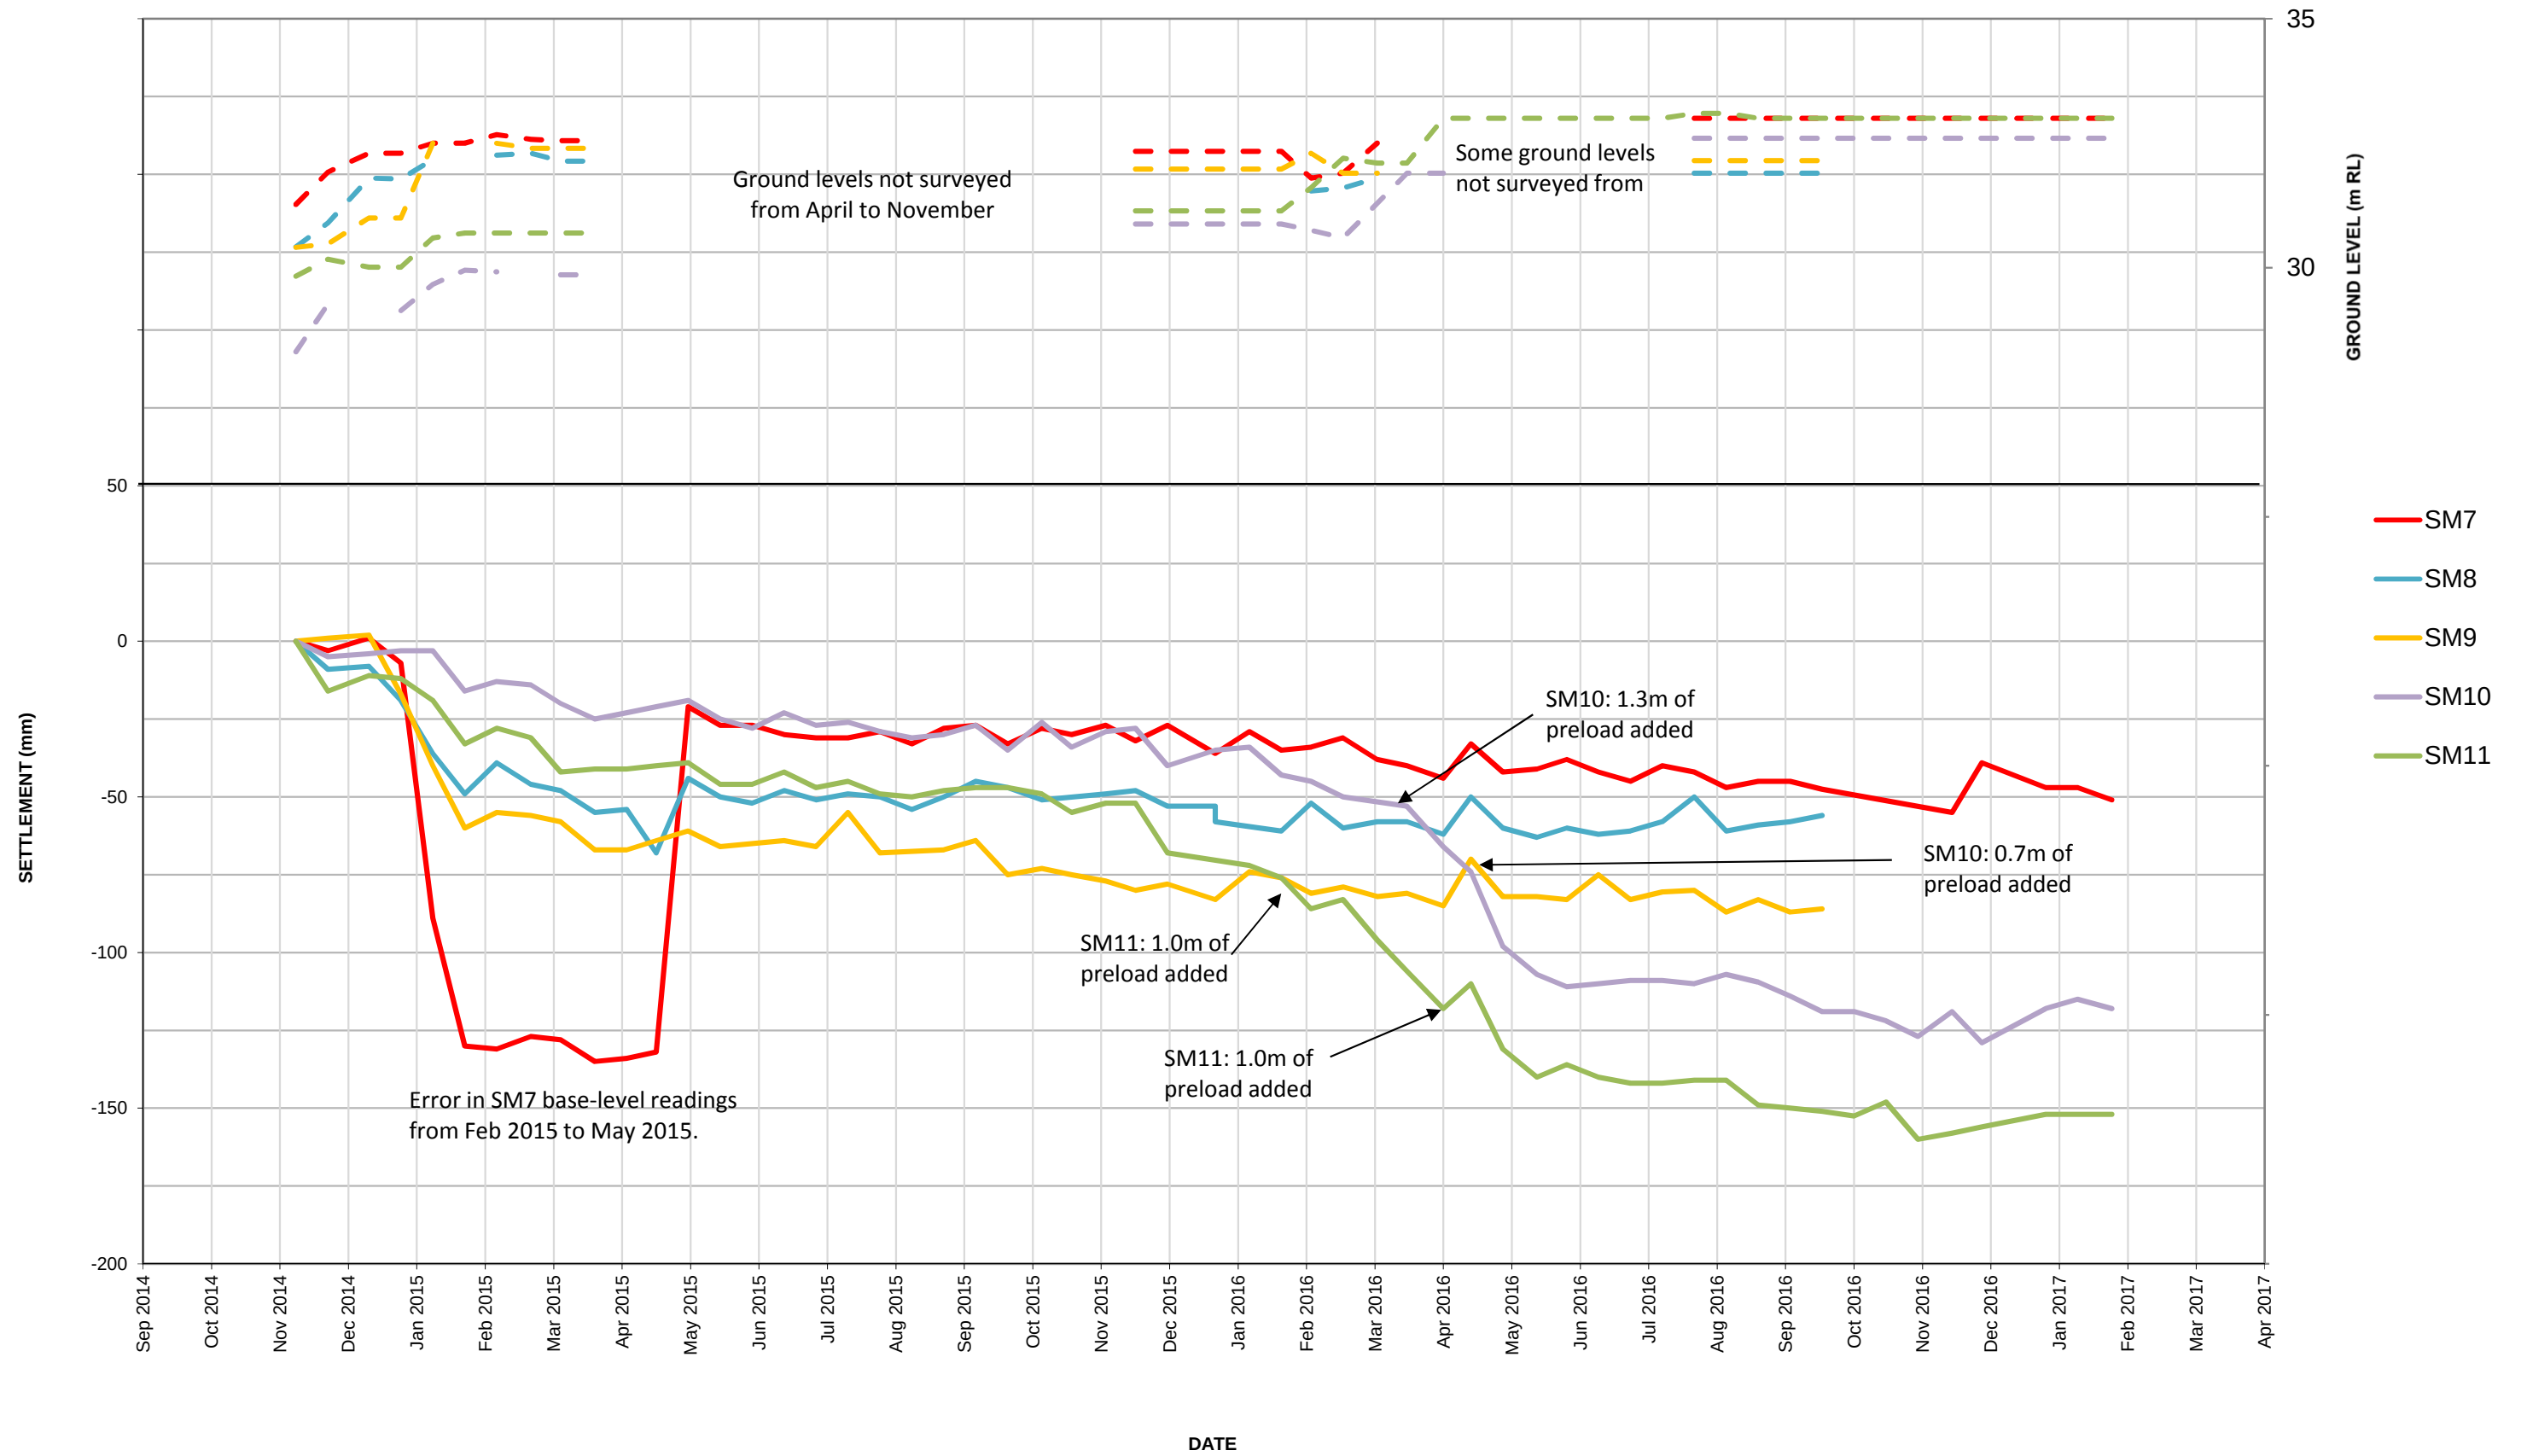
SETTLEMENT VS TIME



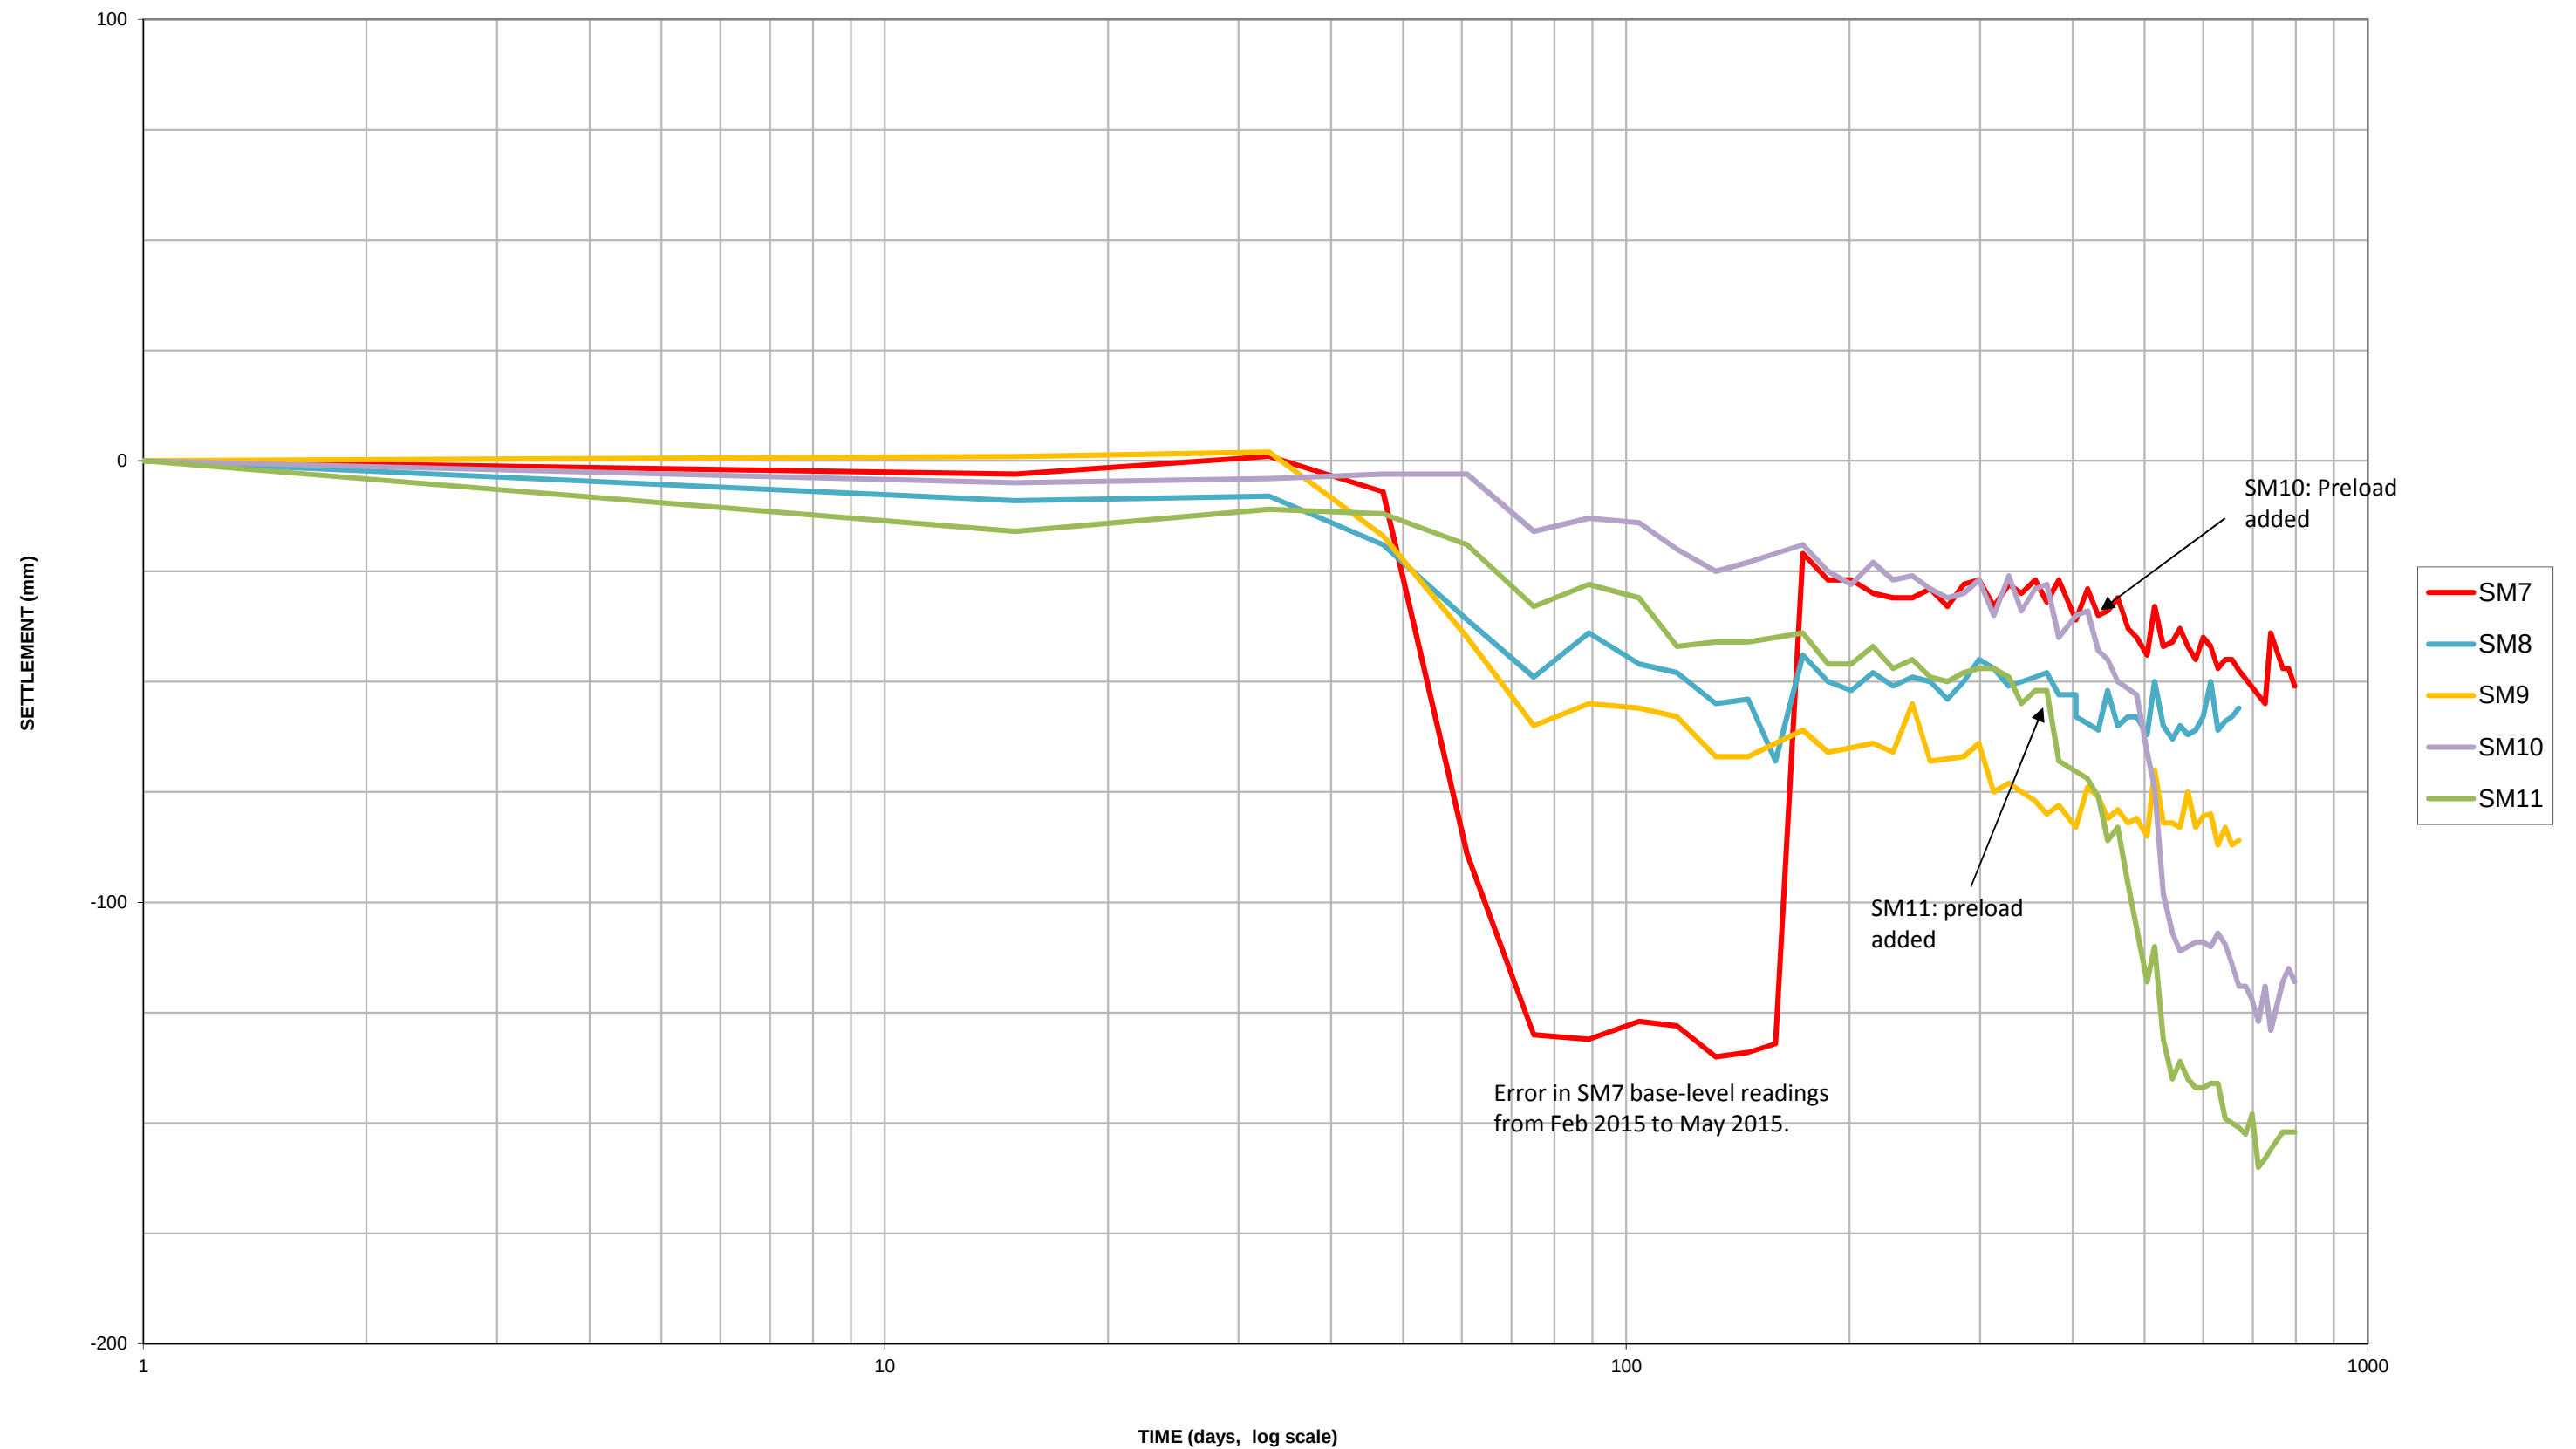
SETTLEMENT VS TIME (LOG SCALE)



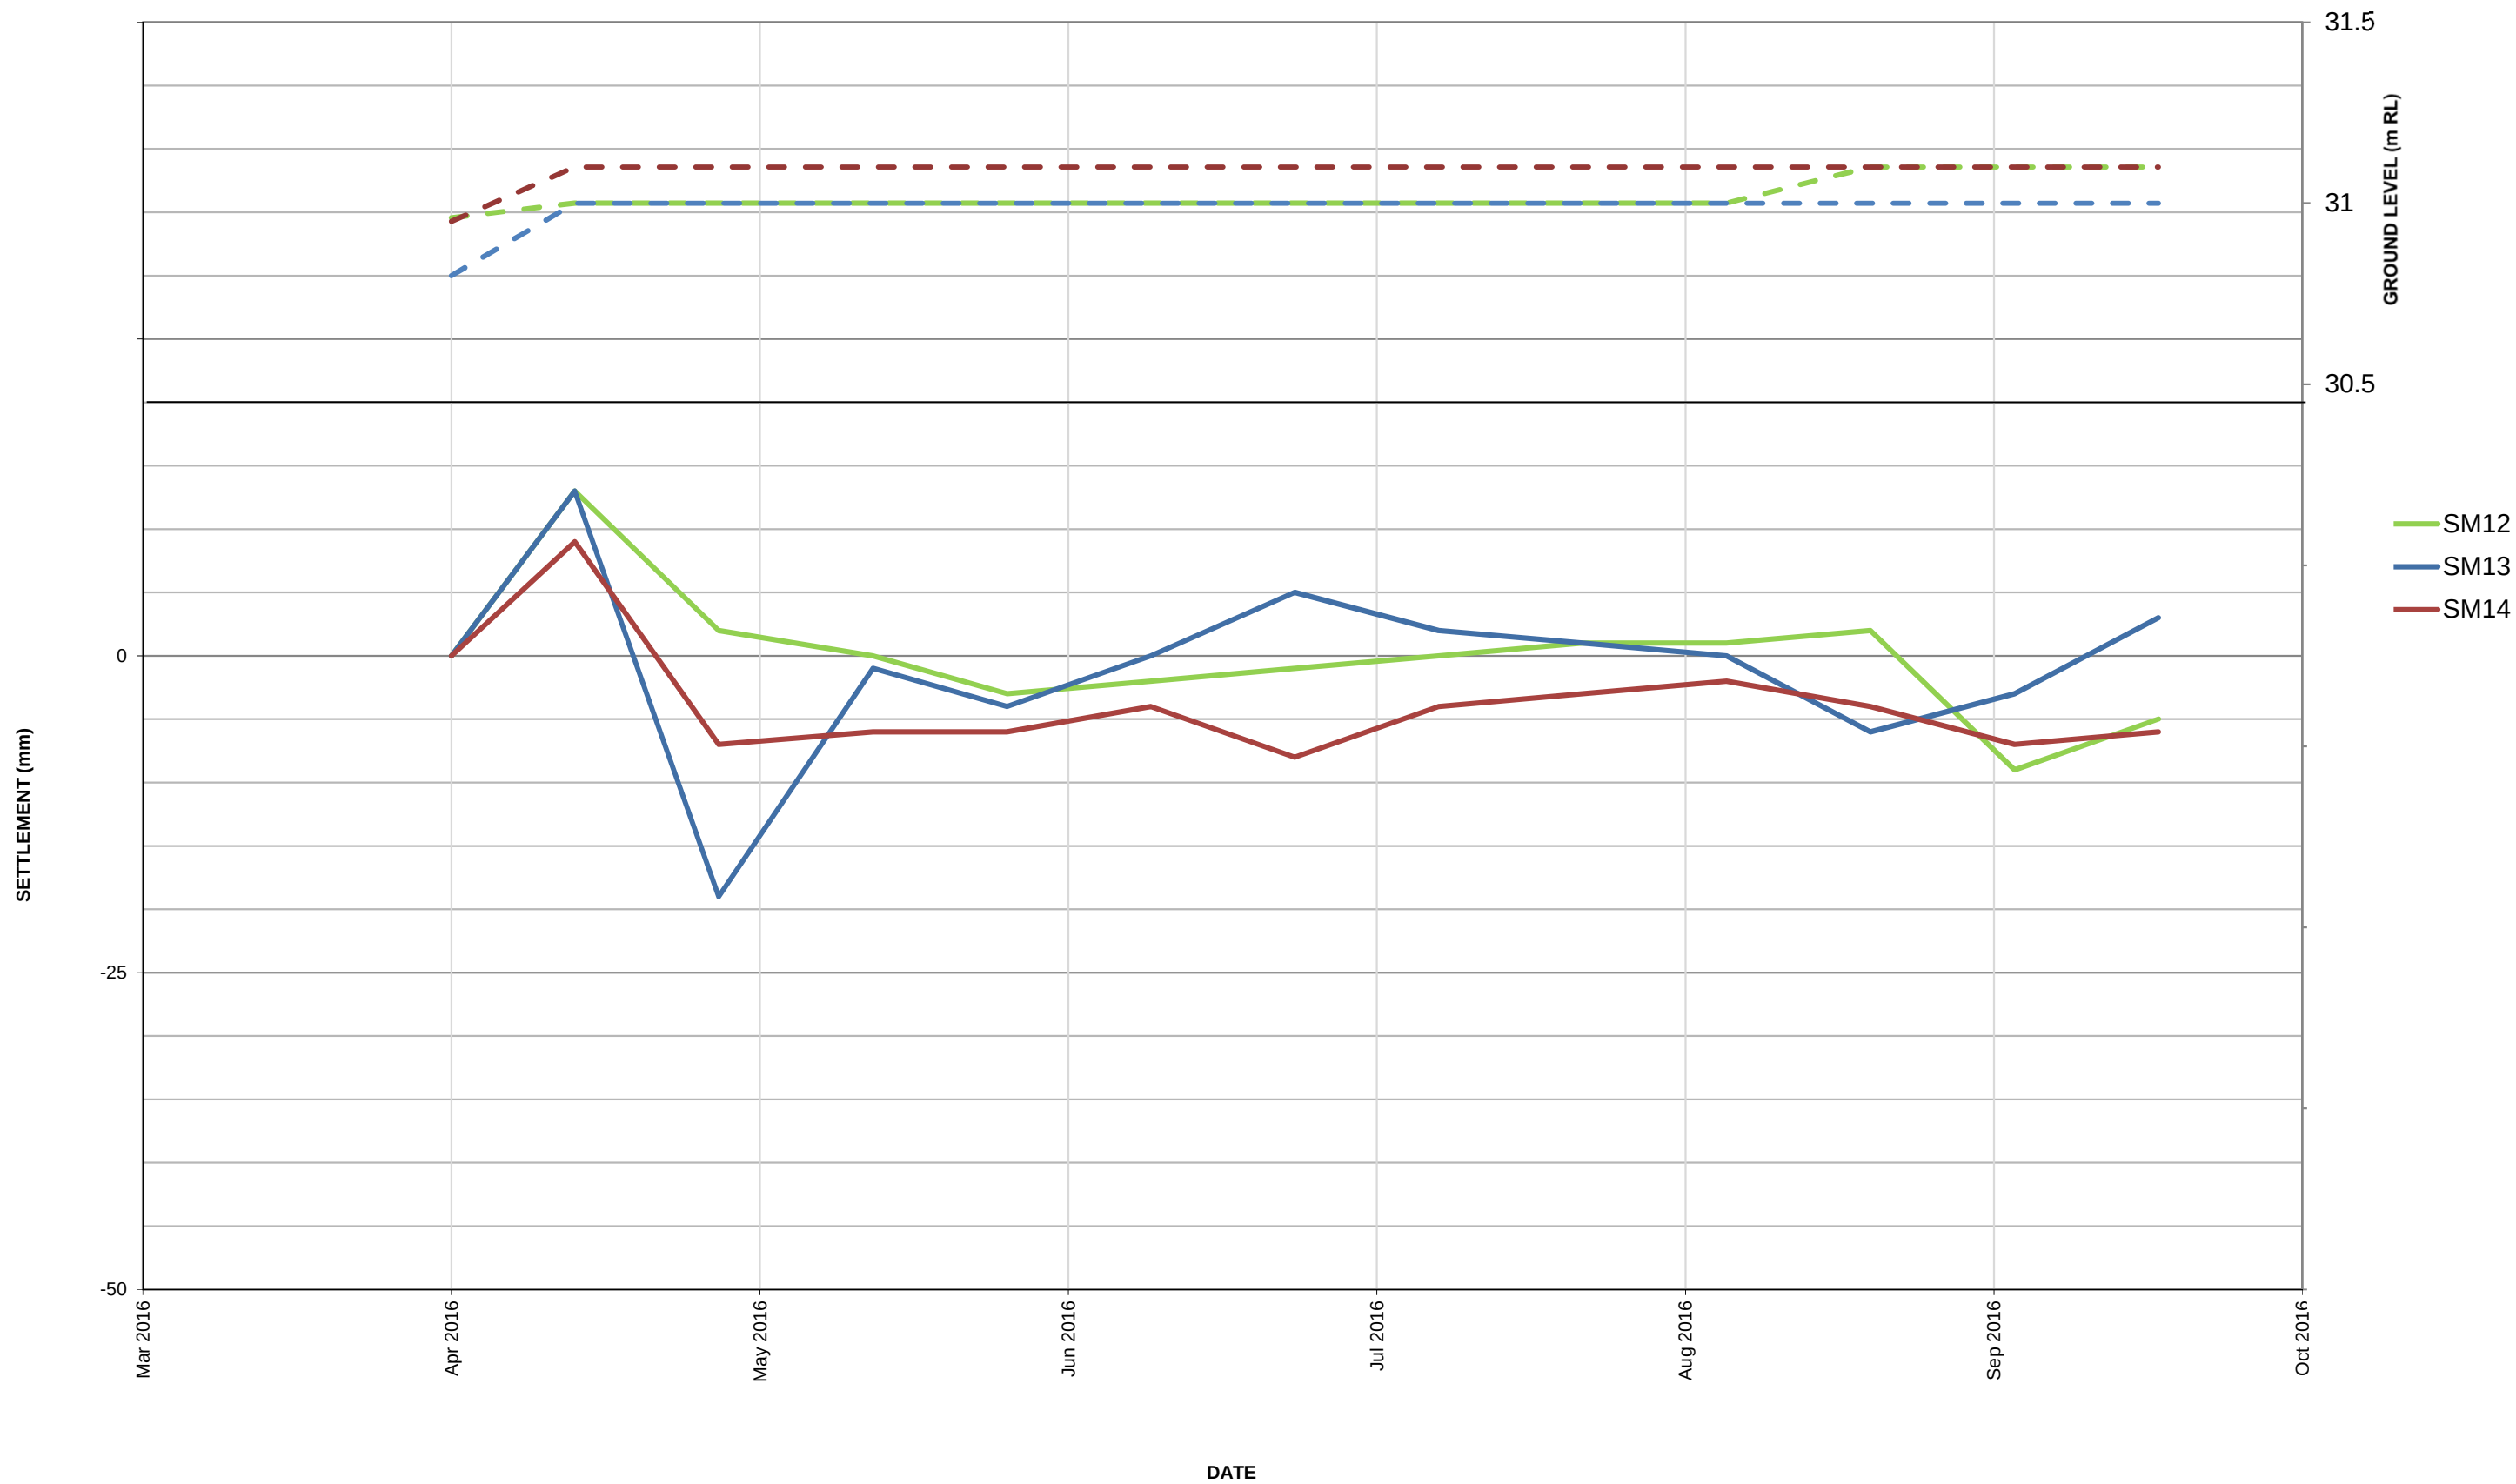
SETTLEMENT VS TIME



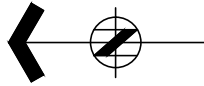
SETTLEMENT VS TIME (LOG SCALE)



SETTLEMENT VS TIME



Appendix G – Harrison Grierson Drawings



DAM 2 REFER SHEETS
137845-AB401-431 FOR DETAILS

NOTES:

1. LEVELS ARE IN TERMS OF THE MOTURIKI DATUM.
2. COORDINATES ARE IN TERMS OF PLENTY 2000 CIRCUIT.
3. ORIGIN OF LEVELS TCC BENCHMARK BM 1343 RL 57.59m.
4. METHOD OF SURVEY: GPS
5. ALL WORKS HAVE BEEN CARRIED OUT TO TCC IDC 2011 STANDARDS.
6. STANDARD ROAD RESERVE FOOTPATHS ARE 1.5m WIDE 'RIVERLEA GOLD' EXPOSED AGGREGATE CONCRETE.
7. ALL VEHICLE/PEDESTRIAN LETDOWNS AND PATH STUBS WITHIN ROAD RESERVE ARE 'RIVERLEA GOLD' EXPOSED AGGREGATE CONCRETE.
8. ALL CONCRETE RIGHT OF WAYS ARE 'HALF BLACK' EXPOSED AGGREGATE.
9. COUNCIL BENCHMARKS HAVE BEEN SUPPLIED BY TCC. FINAL LOCATIONS HAVE BEEN CONFIRMED ON SITE BY SURVEYOR.
10. BOTH BUS STOPS HAVE 13m LENGTH OF 180mm HIGH KERB.

LEGEND:

- 2.4m NOISEWALL (PRIVATE)
- RETAINING WALL (PRIVATE)
- 'HALF BLACK' EXPOSED AGGREGATE CONCRETE
- 'RIVERLEA GOLD' EXPOSED AGGREGATE CONCRETE
- BERM/RESERVE GRASS
- GARDEN
- GRAVEL TRACK
- MULTIMAT 100
- STAIRS
- K1 KERB LINE AND REFERENCE
- TCC BENCHMARK
- AS BUILT STREETLIGHT
- AS BUILT TREE
- AS BUILT SIGN
- NANAKO STREAM

				ORIGINATOR:	DATE:	SIGNED:	PLOT BY:
				TCH	22.12.17		TRS
				DRAWN:	DATE:	SIGNED:	PLOT DATE:
				TRS	22.12.17		19.01.18
D	TRACK AND STAIRS CHAINAGES ADDED	TCH	19.01.18	TR	DATE:	SIGNED:	
C	FINAL AS BUILT	TCH	18.01.18	TR	22.12.17		
B	DRAFT AS BUILT	TCH	16.01.18	TR	DATE:	SIGNED:	
A	DRAFT AS BUILT	TCH	22.12.17	TR	19.01.18		
REF	REVISIONS	BY	DATE	GPR	DATE:	SIGNED:	
					19.01.18		



ASSOCIATION OF
CONSULTING ENGINEERS
NEW ZEALAND

ISO 9001
QUALITY
ASSURED



TAURANGA OFFICE
LEVEL 1, 60 SPRING STREET
TAURANGA 3110
T +64 7 578 0023
W www.harrisongrierison.com

PROJECT:

Summit
THE LAKES (2012) LIMITED

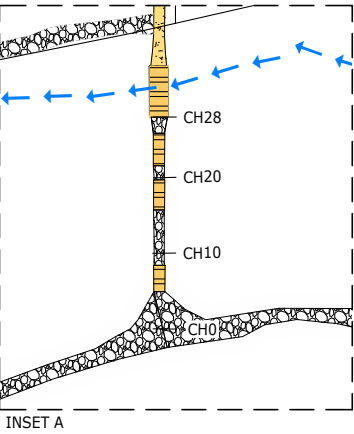
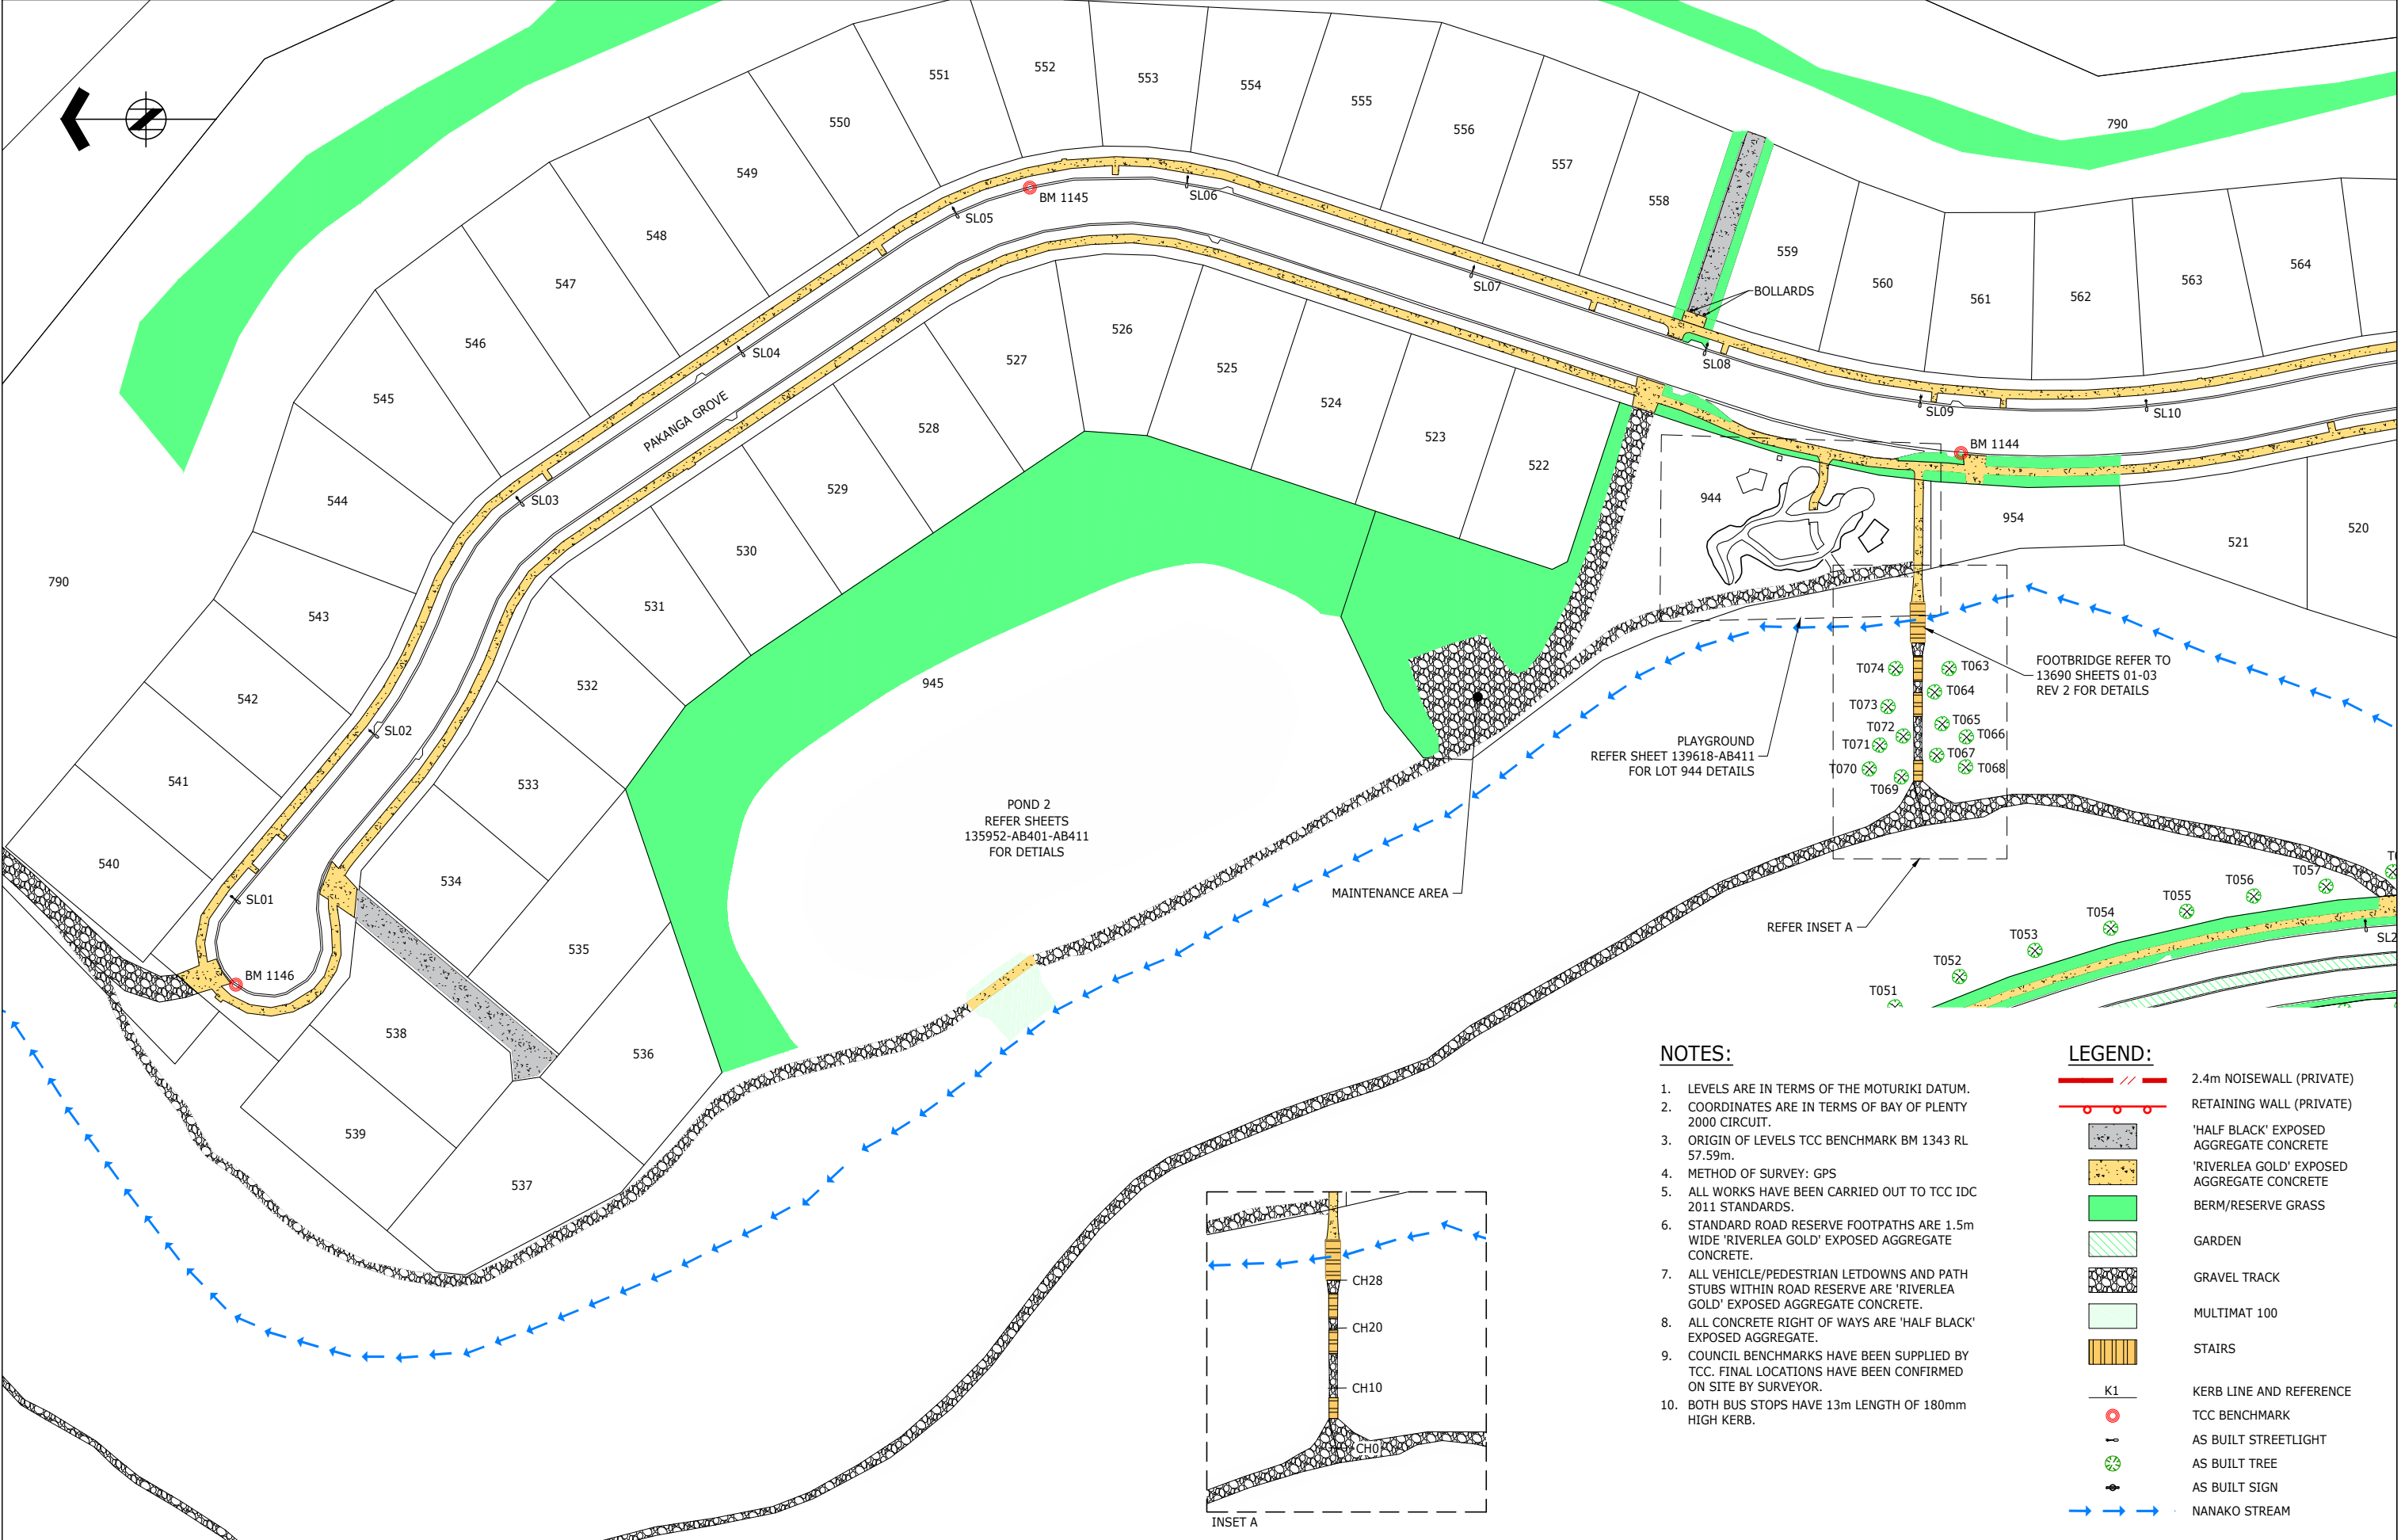
TITLE:

STAGE 3I
STREETSCAPE/TRANSPORTATION AS BUILT PLANS
SHEET 1
TCC IP 101782

ISSUE STATUS:

FINAL AS BUILT

PROJECT No:	1520-139618-01	SCALE:	1:500 - A1 1:1000 - A3	A1
DRAWING No:	139618-AB401	REV		D



NOTES:

1. LEVELS ARE IN TERMS OF THE MOTURIKI DATUM.

2. COORDINATES ARE IN TERMS OF BAY OF PLENTY 2000 CIRCUIT.

3. ORIGIN OF LEVELS TCC BENCHMARK BM 1343 RL 57.59m.

4. METHOD OF SURVEY: GPS

5. ALL WORKS HAVE BEEN CARRIED OUT TO TCC IDC 2011 STANDARDS.

6. STANDARD ROAD RESERVE FOOTPATHS ARE 1.5m WIDE 'RIVERLEA GOLD' EXPOSED AGGREGATE CONCRETE.

7. ALL VEHICLE/PEDESTRIAN LETDOWNS AND PATH STUBS WITHIN ROAD RESERVE ARE 'RIVERLEA GOLD' EXPOSED AGGREGATE CONCRETE.

8. ALL CONCRETE RIGHT OF WAYS ARE 'HALF BLACK' EXPOSED AGGREGATE.

9. COUNCIL BENCHMARKS HAVE BEEN SUPPLIED BY TCC. FINAL LOCATIONS HAVE BEEN CONFIRMED ON SITE BY SURVEYOR.

10. BOTH BUS STOPS HAVE 13m LENGTH OF 180mm HIGH KERB.

LEGEND:

2.4m NOISEWALL (PRIVATE)

RETAINING WALL (PRIVATE)

'HALF BLACK' EXPOSED AGGREGATE CONCRETE

'RIVERLEA GOLD' EXPOSED AGGREGATE CONCRETE

BERM/RESERVE GRASS

GARDEN

GRAVEL TRACK

MULTIMAT 100

STAIRS

K1

KERB LINE AND REFERENCE

TCC BENCHMARK

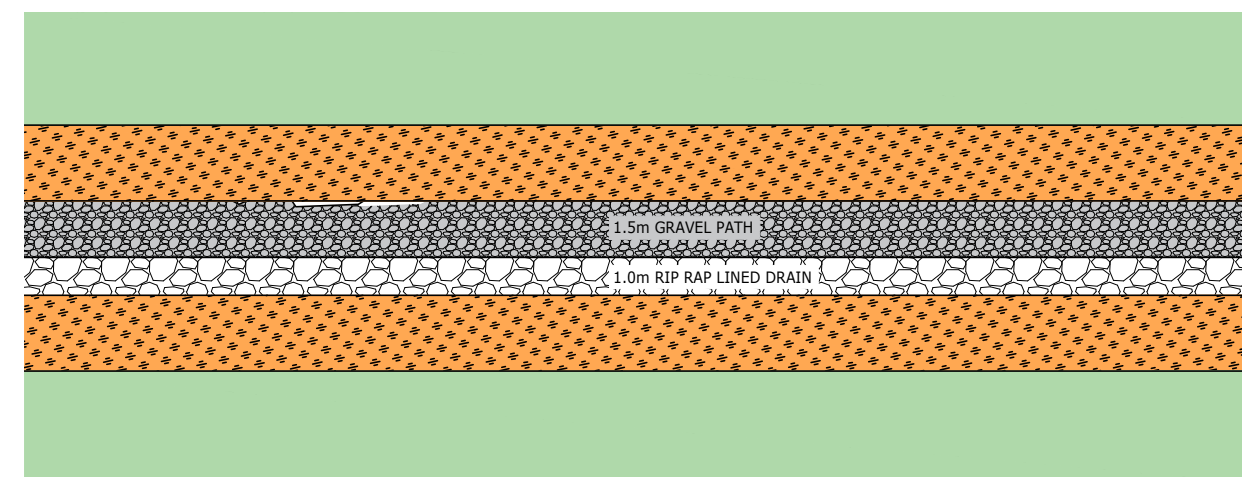
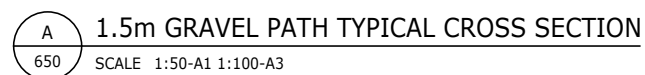
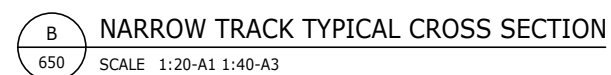
AS BUILT STREETLIGHT

AS BUILT TREE

AS BUILT SIGN

NANAKO STREAM

				ORIGINATOR: TCH	DATE: 22.12.17	SIGNED:	PLOT BY: TRS	ASSOCIATION OF CONSULTING ENGINEERS NEW ZEALAND ISO 9001 QUALITY ASSURED	TAURANGA OFFICE LEVEL 1, 60 SPRING STREET TAURANGA 3110 T +64 7 578 0023 W www.harrisongrierson.com Summit THE LAKES (2012) LIMITED	PROJECT: TITLE: STAGE 3I STREETSCAPE/TRANSPORTATION AS BUILT PLANS SHEET 2 TCC IP 101782	ISSUE STATUS: FINAL AS BUILT		
				DRAWN: PSJ	DATE: 22.12.17	SIGNED:	PLOT DATE: 19.01.18				PROJECT No: 1520-139618-01	SCALE: 1:500 - A1 1:1000 - A3	A1
				CHECKED: TCH	DATE: 19.01.18	SIGNED:	SURVEY BY: -				DRAWING No: 139618-AB402		REV
				APPROVED: GPR	DATE: 19.01.18	SIGNED:	SURVEY DATE: -						
D TRACK AND STAIRS CHAINAGES ADDED				TCH	19.01.18								
C FINAL AS BUILT				TCH	18.01.18								
B DRAFT AS BUILT				TCH	16.01.18								
A DRAFT AS BUILT				TCH	22.12.17								
REF REVISIONS				BY	DATE	GPR	19.01.18						



1. GRAVEL TRACKS TO BE 100mm DEEP GAP40 BASECOURSE MATERIAL TO BE WELL GRADED ANGULAR STONE WITH CLAY CONTENT OF 3-5%. SURFACE FINISH TO BE SMOOTH AND IMPERMEABLE.
2. CONTRACTOR TO PROVIDE GRADING CURVE TO ENGINEER FOR APPROVAL.
3. REFER TO TCC TRACKS MANUAL FOR STEP DETAILS

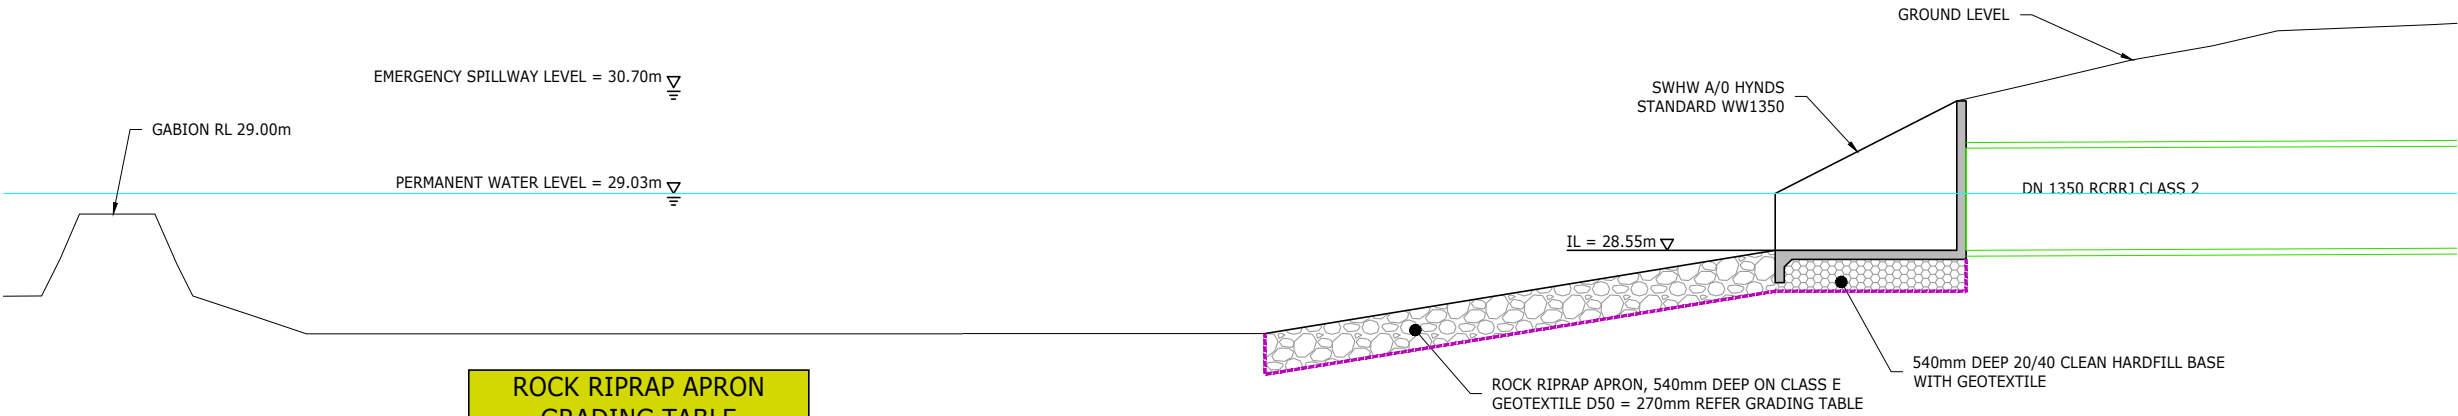
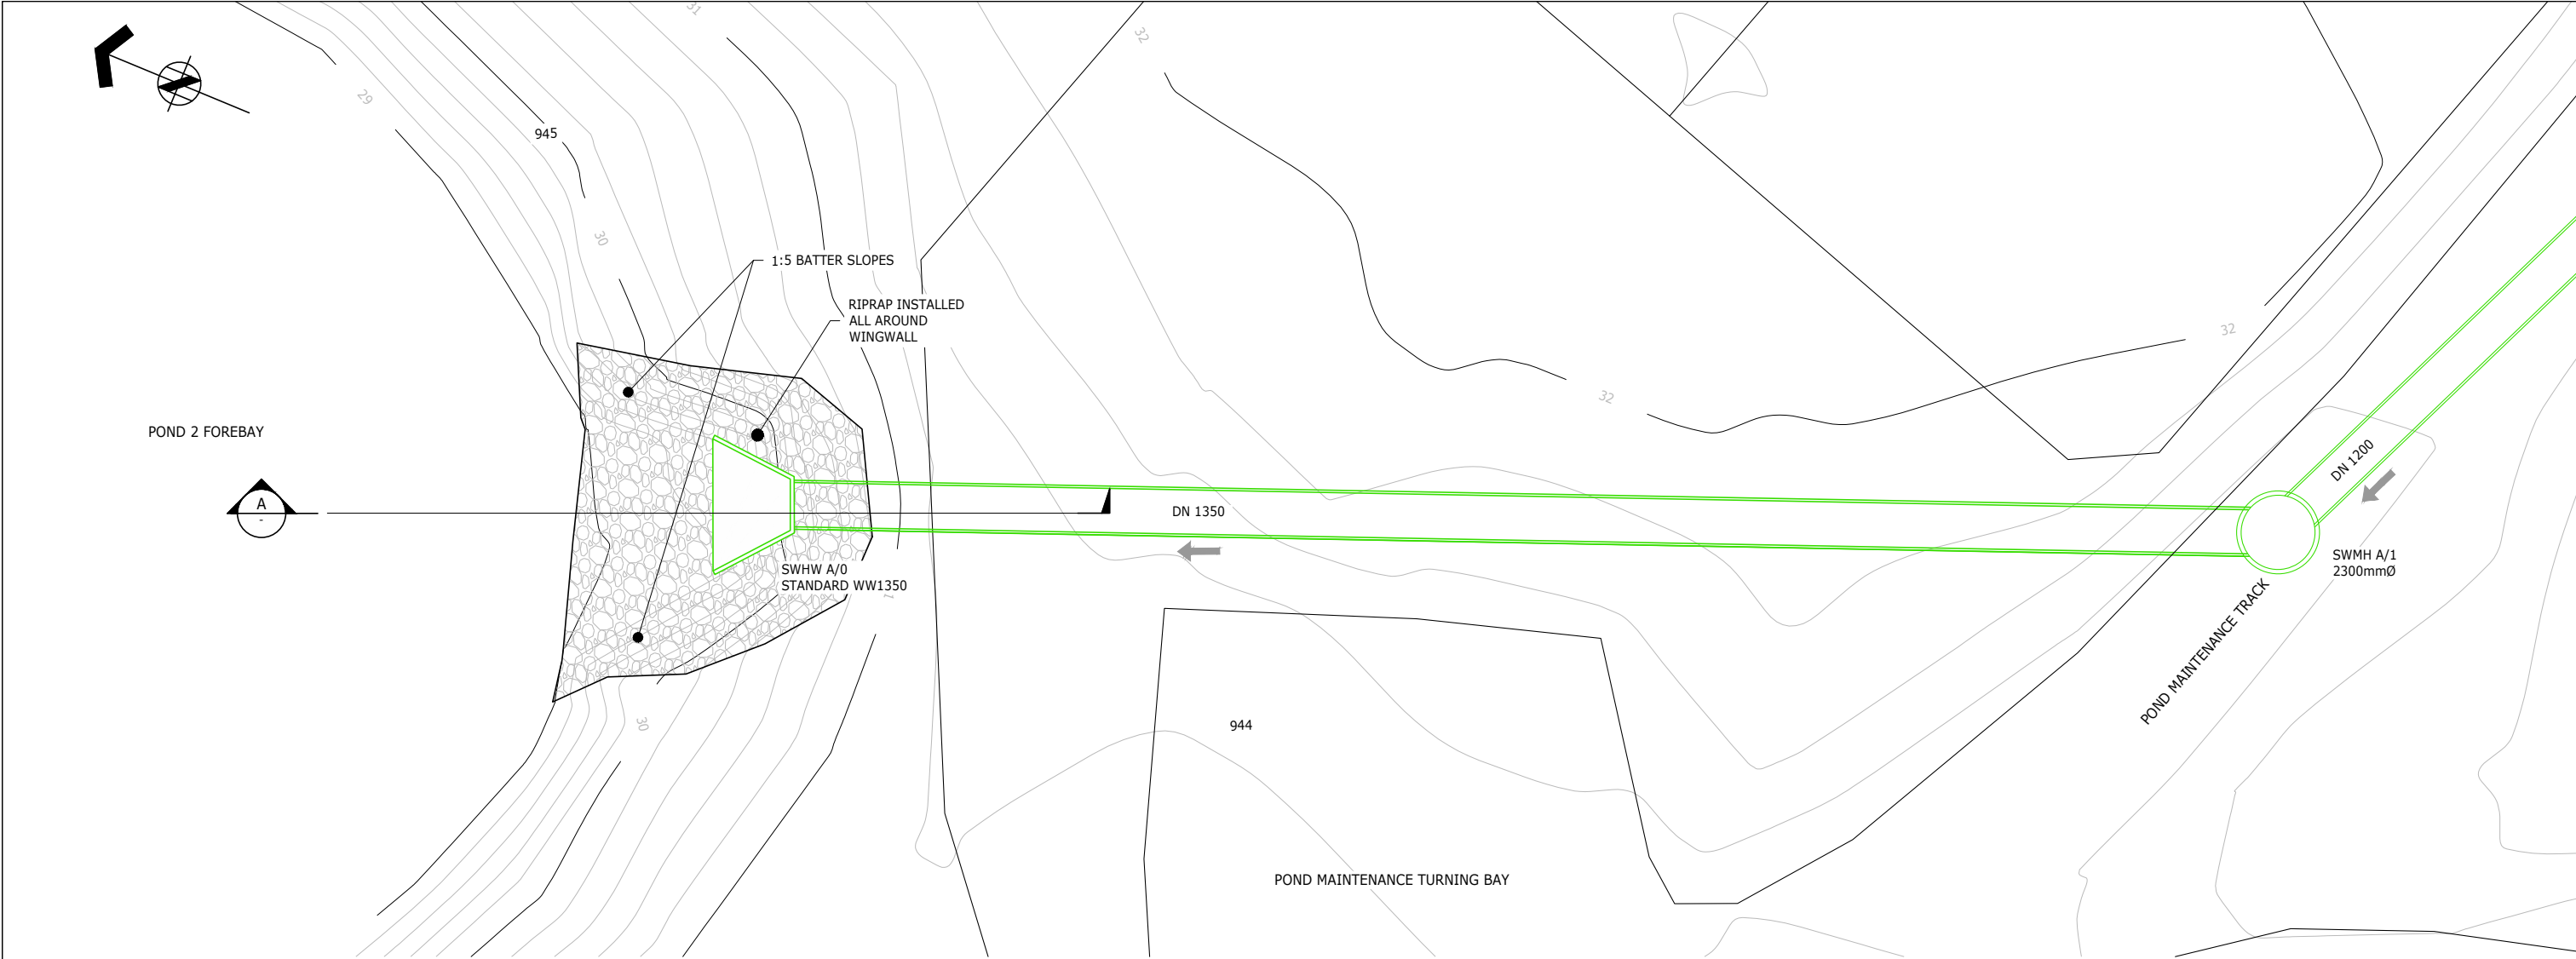
				ORIGINATOR: DATE: 01.12.16 GPR		SIGNED:		PLOT BY: TRS		 ASSOCIATION OF CONSULTING ENGINEERS NEW ZEALAND		ISO 9001 QUALITY ASSURED		PROJECT: THE LAKES (2012) LTD TAURANGA		TITLE: STAGE 3 (ZONE 3) EARTHWORKS EASTERN GULLY RESERVE TYPICAL CROSS SECTIONS SHEET		ISSUE STATUS: CONSTRUCTION					
				DRAWN: DATE: 01.12.16 HEH		SIGNED:		PLOT DATE: 24.02.17										PROJECT No: 1510-137845-01		SCALES: AS SHOWN		A1	
				CHECKED: DATE: 23.02.17 RJM		SIGNED:		SURVEY BY: THIS DRAWING AND DESIGN REMAINS THE PROPERTY OF, AND MAY NOT BE REPRODUCED OR ALTERED, WITHOUT THE WRITTEN PERMISSION OF HARRISON GRIERSON CONSULTANTS LIMITED. NO LIABILITY SHALL BE ACCEPTED FOR UNAUTHORISED USE OF THIS DRAWING.										DRAWING No: 137845-01-668		REV			
2 ADDED DETAIL C 1 ISSUED FOR CONSTRUCTION REVISIONS		GPR 23.02.17 GPR 31.01.17 BY DATE APPROVED: DATE: 23.02.17 GPR		APPROVED: DATE: 23.02.17 GPR		SIGNED:		SURVEY DATE:														B	



- NOTES:**
1. LEVELS ARE IN TERMS OF THE MOTURIKI DATUM.
 2. COORDINATES ARE IN TERMS OF BAY OF PLENTY 2000 CIRCUIT.
 3. MAJOR CONTOURS ARE SHOWN AT 1m INTERVALS.
 4. MINOR CONTOURS ARE SHOWN AT 0.2m INTERVALS.
 5. ORIGIN OF LEVELS TCC BENCHMARK BM 1343 RL 57.59m.
 6. METHOD OF SURVEY: GPS
 7. ALL WORKS WERE CARRIED OUT TO TCC IDC 2011 STANDARDS.
 8. ALL MANHOLES ARE 1050mm DIA UNLESS OTHERWISE SHOWN.
 9. ALL STORMWATER PIPES ARE RCRJ PIPES UNLESS OTHERWISE STATED.
 10. ALL CONCRETE PIPES ARE CLASS 2 UNLESS OTHERWISE STATED.
 11. ALL BURIED AS BUILT INFORMATION SUPPLIED BY HIGGINS CONTRACTORS LTD.

- LEGEND:**
- ASBUILT CONTOURS - MAJOR
 - ASBUILT CONTOURS - MINOR
 - AS BUILT STORMWATER LINE
 - AS BUILT SUBSOIL
 - PERMANENT WATER LEVEL - 29.30m
 - NANAKO STREAM
 - AS BUILT MANHOLE
 - AS BUILT HEADWALL
 - EMERGENCY SPILLWAY
 - 'RIVERLEA GOLD' EXPOSED AGGREGATE CONCRETE
 - RIPRAP
 - WALKING TRACK
 - 'RAPIDS' BOULDERS

			ORIGINATOR:	DATE:	SIGNED:	PLOT BY:		ASSOCIATION OF CONSULTING ENGINEERS NEW ZEALAND	ISO 9001 QUALITY ASSURED		TAURANGA OFFICE LEVEL 1, 60 SPRING STREET TAURANGA 3110 T +64 7 578 0023 W www.harrisongrierson.com	PROJECT:  THE LAKES (2012) LIMITED	TITLE: STAGE 3I POND 2 AS BUILT LAYOUT PLAN TCC IP 101782	ISSUE STATUS:		FINAL AS BUILT		
		TCH	18.01.18		TRS	PROJECT No: 1520-139618-01								SCALES: 1:250 - A1 1:500 - A3				
		DRWN:	DATE:	SIGNED:	PLOT DATE:													
C	FINAL AS BUILT	TCH	19.01.18	CHECKED:	DATE:	SIGNED:	SURVEY BY:	THIS DRAWING AND DESIGN REMAINS THE PROPERTY OF, AND MAY NOT BE REPRODUCED OR ALTERED, WITHOUT THE WRITTEN PERMISSION OF HARRISON GRIERSON CONSULTANTS LIMITED. NO LIABILITY SHALL BE ACCEPTED FOR UNAUTHORISED USE OF THIS DRAWING.						DRAWING No:		135952-AB401	C	
B	FINAL AS BUILT	TCH	19.01.18	TCH	19.01.18		-											
A	DRAFT AS BUILT	TCH	18.01.18	APPROVED:	DATE:	SIGNED:	SURVEY DATE:											
REF	REVISIONS	BY	DATE	GPR	19.01.18		-											



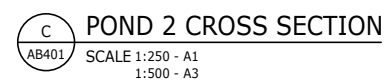
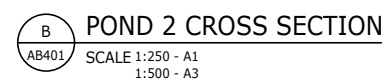
ROCK RIPRAP APRON GRADING TABLE	
SIEVE SIZE (mm)	MINIMUM PERCENTAGE OF ROCK LARGER THAN
410-460	100
330-380	85
270-380	50
120-160	15

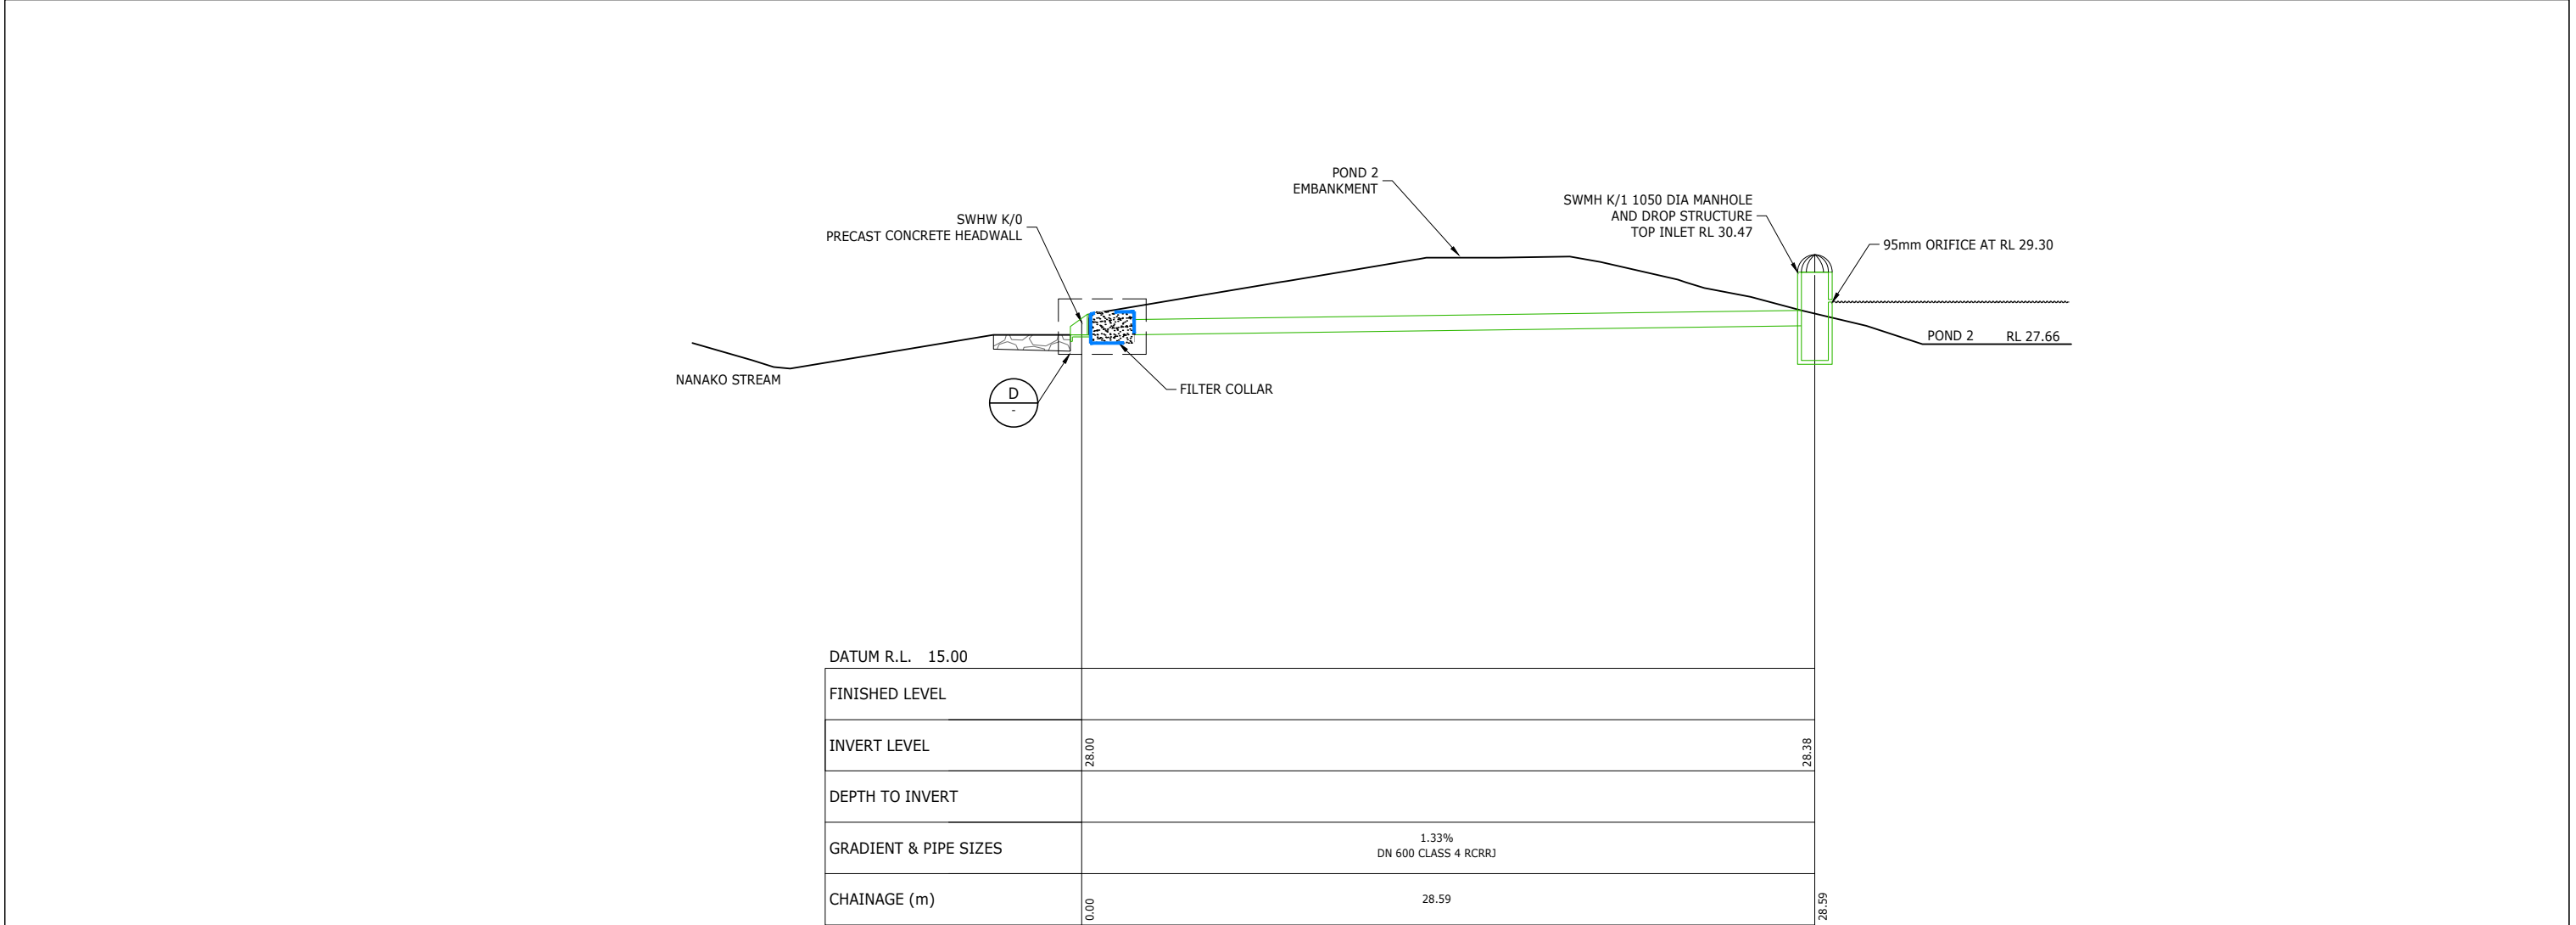
A STORMWATER OUTLET A/0 - A/1
SCALE 1:50 - A1, 1:100 - A3

- NOTES:**
- LEVELS ARE IN TERMS OF THE MOTURIKI DATUM.
 - COORDINATES ARE IN TERMS OF BAY OF PLENTY 2000 CIRCUIT.
 - ORIGIN OF LEVELS TCC BENCHMARK BM 1343 RL 57.59m.
 - METHOD OF SURVEY: GPS
 - ALL WORKS WERE CARRIED OUT TO TCC IDC 2011 AND ALL SUBSEQUENT AMENDMENTS.
 - ALL STORMWATER PIPES ARE RCRRJ PIPES.
 - ALL CONCRETE PIPES ARE CLASS 2.
 - ALL BURIED AS BUILT INFORMATION SUPPLIED BY HIGGINS CONTRACTORS LTD.

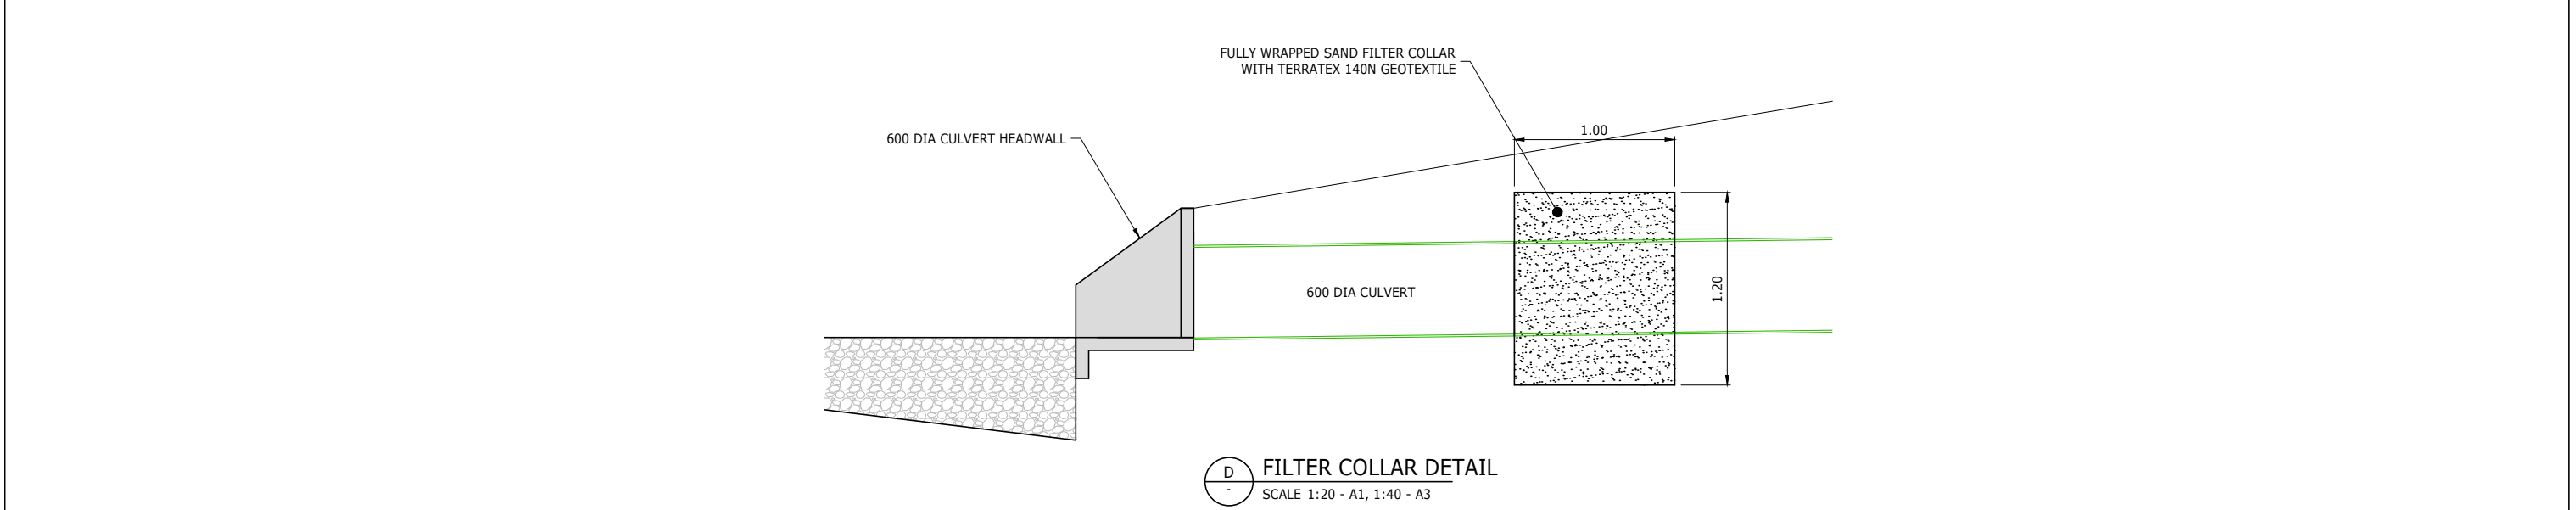
- LEGEND:**
- AS BUILT STORMWATER
 - MAJOR CONTOUR
 - MINOR CONTOUR
 - RIPRAP

				ORIGINATOR: TCH	DATE: 18.01.18	SIGNED:	PLOT BY: TRS		ASSOCIATION OF CONSULTING ENGINEERS NEW ZEALAND	ISO 9001 QUALITY ASSURED		TAURANGA OFFICE LEVEL 1 HARRISON GRIERSON HOUSE 60 SPRING STREET TAURANGA 3110 T +64 7 578 0023 W www.harrisongrierson.com	PROJECT:  THE LAKES (2012) LIMITED, TAURANGA	TITLE: STAGE 3I POND 2 AS BUILT OUTLET DETAILS TCC IP 101782	ISSUE STATUS: FINAL AS BUILT		
				DRAWN: PSJ	DATE: 18.01.18	SIGNED:	PLOT DATE: 19.01.18								PROJECT No: 1520-139618-01	SCALES: 1:100 - A1 1:200 - A3	A1
C	FINAL AS BUILT	TCH	19.01.18	CHECKED: PSJ	DATE: 19.01.18	SIGNED:	SURVEY BY:	THIS DRAWING AND DESIGN REMAINS THE PROPERTY OF, AND MAY NOT BE REPRODUCED OR ALTERED, WITHOUT THE WRITTEN PERMISSION OF HARRISON GRIERSON CONSULTANTS LIMITED. NO LIABILITY SHALL BE ACCEPTED FOR UNAUTHORISED USE OF THIS DRAWING.	SURVEY DATE:	DRAWING No:					135952-AB402	REV	
B	FINAL AS BUILT	TCH	19.01.18	GPR	DATE: 19.01.18	SIGNED:											
A	DRAFT AS BUILT	TCH	18.01.18	APPROVED: GPR	DATE: 19.01.18	SIGNED:											
REF	REVISIONS	BY	DATE														





STORMWATER LINE C LONGSECTION
SCALE 1:125 - A1, 1:250 - A3



			ORIGINATOR: TCH	DATE: 18.01.18	SIGNED:	PLOT BY: TRS		ASSOCIATION OF CONSULTING ENGINEERS NEW ZEALAND	ISO 9001 QUALITY ASSURED		TAURANGA OFFICE LEVEL 1, 60 SPRING STREET TAURANGA 3110 T +64 7 578 0023 W www.harrisingrierson.com	PROJECT:  THE LAKES (2012) LIMITED	TITLE: STAGE 3I POND 2 AS BUILT STORMWATER LONG SECTION TCC IP 101782	ISSUE STATUS: FINAL AS BUILT					
		DRAWN: TRS	DATE: 18.01.18	SIGNED:	PLOT DATE: 19.01.18														
C	FINAL AS BUILT	TCH	19.01.18	CHECKED: TCH	DATE: 19.01.18	SIGNED:	THIS DRAWING AND DESIGN REMAINS THE PROPERTY OF, AND MAY NOT BE REPRODUCED OR ALTERED, WITHOUT THE WRITTEN PERMISSION OF HARRISON GRIERSON CONSULTANTS LIMITED. NO LIABILITY SHALL BE ACCEPTED FOR UNAUTHORISED USE OF THIS DRAWING.							PROJECT No: 1520-139618-01		SCALES: AS SHOWN	A1		
B	FINAL AS BUILT	TCH	19.01.18	TCH	19.01.18									-	DRAWING No: 135952-AB411		REV	C	
A	DRAFT AS BUILT	TCH	18.01.18	APPROVED: GPR	DATE: 19.01.18	SIGNED:								-					
REF	REVISIONS	BY	DATE				-												