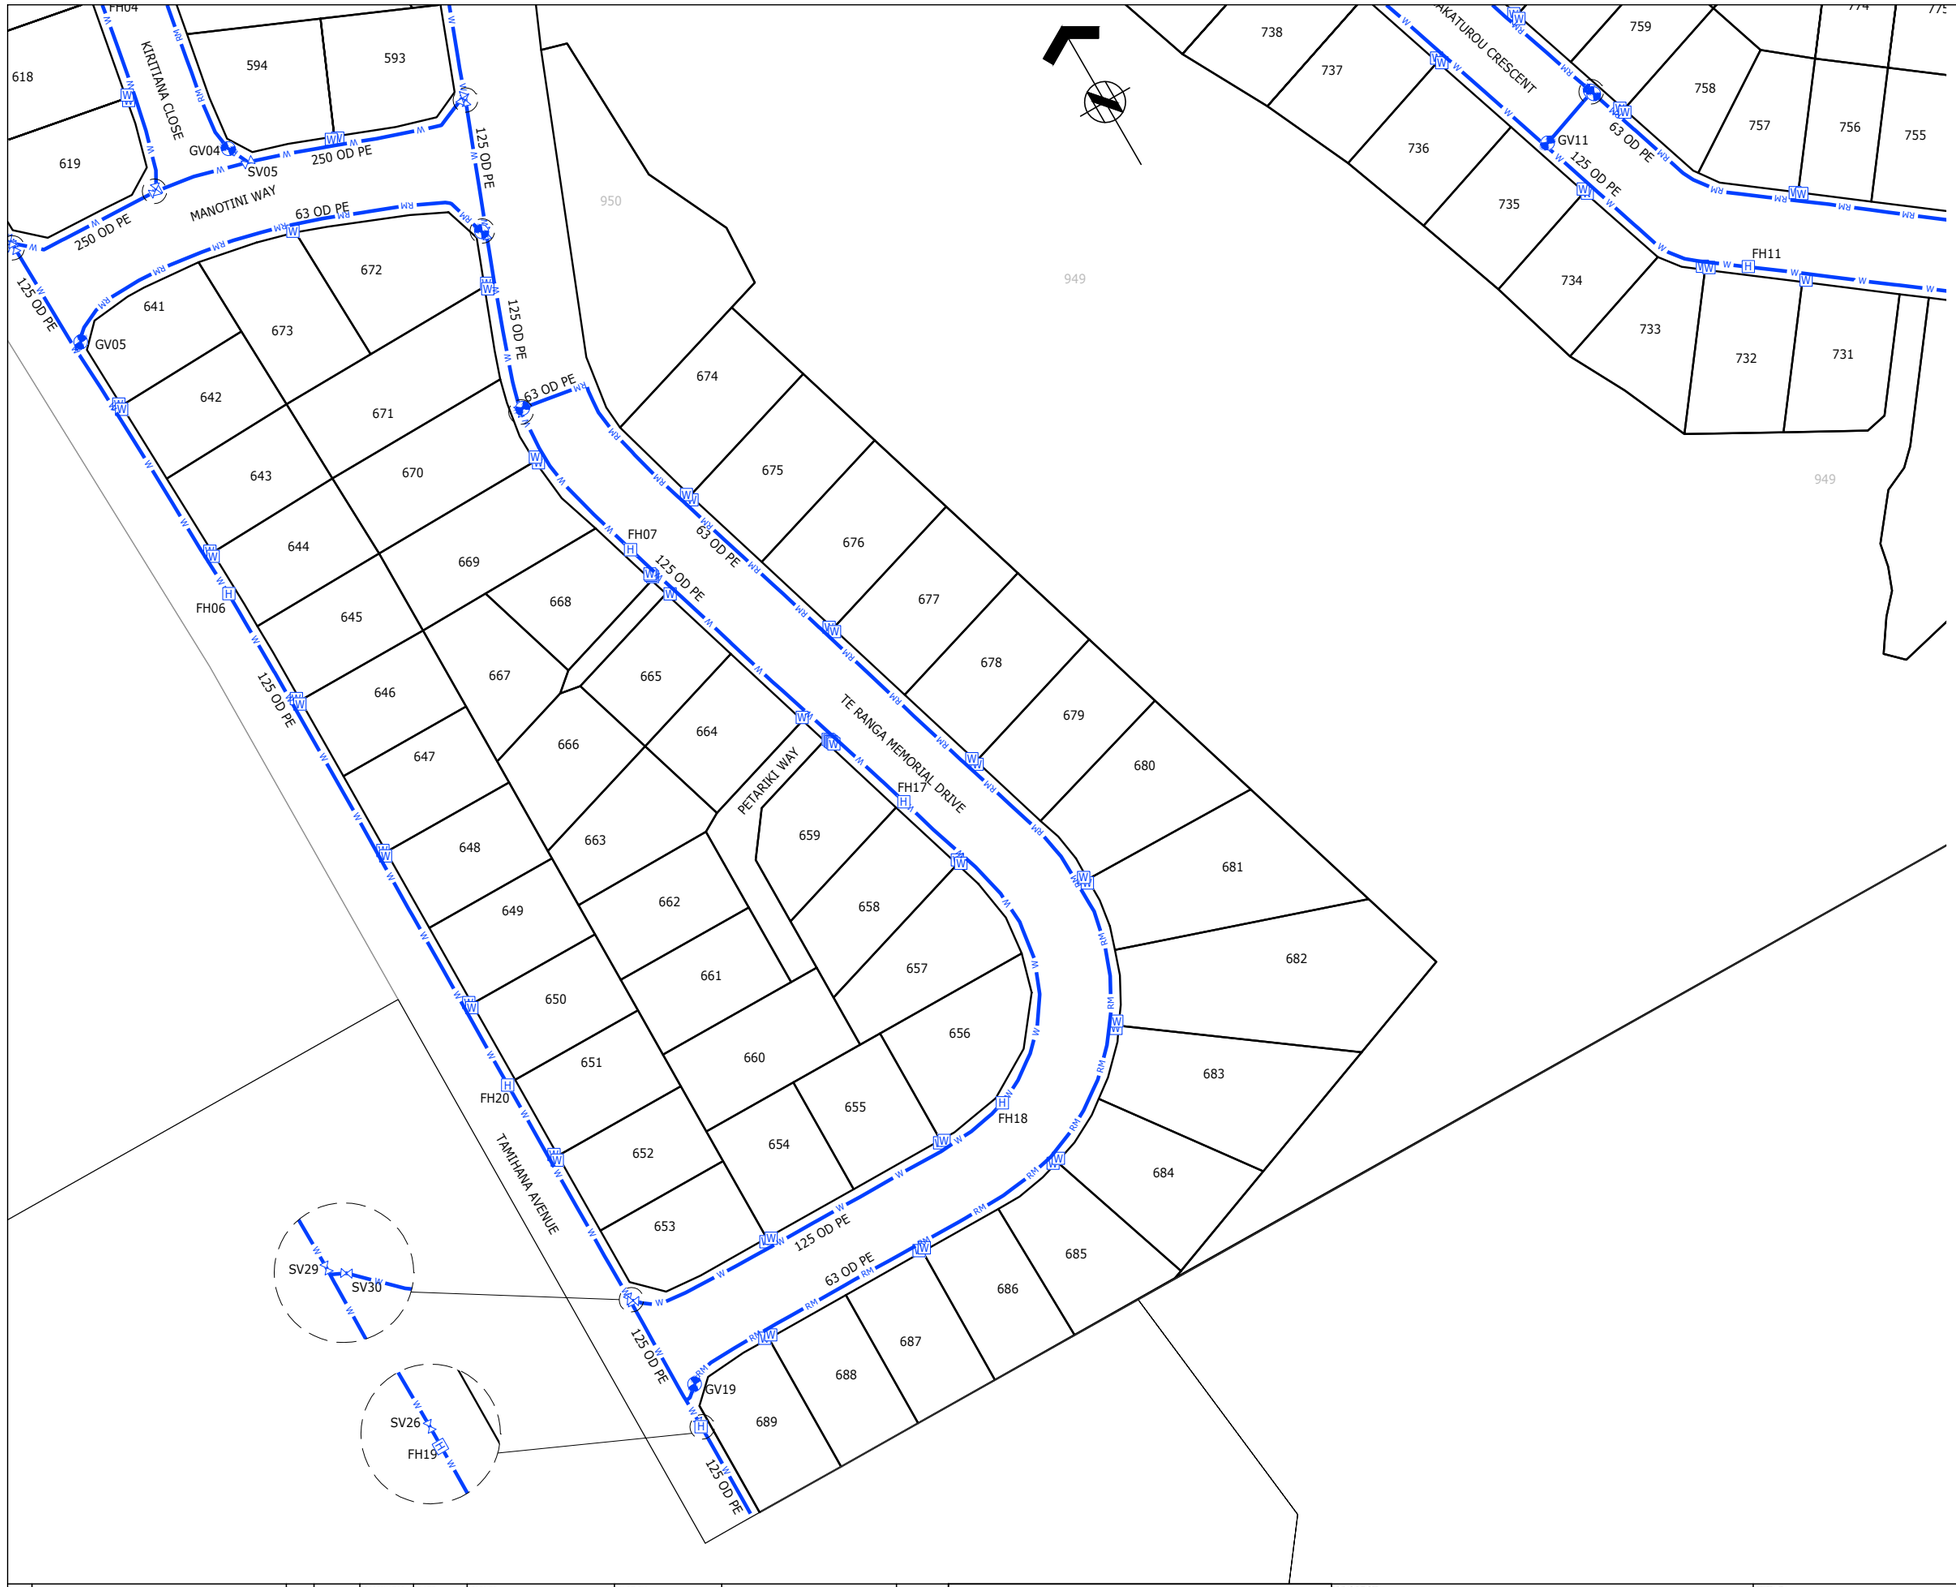

PE PIPE DIMENSIONS

TYPE	SIZE	STANDARD DIMENSION RATIO	MATERIAL	PRESSURE RATING
MAIN	250mm OD	SDR13.6	PE100	PN 12.5
MAIN	125mm OD			
RIDERMAIN	63mm OD	SDR11	PE80	
CONNECTION	25mm OD			

NOTES:

1. LEVELS ARE IN TERMS OF THE MOTURIKI DATUM.
2. COORDINATES ARE IN TERMS OF BAY OF PLENTY 2000 CIRCUIT.
3. ORIGIN OF LEVELS TCC BENCHMARK BM 1142 RL 35.645m.
4. METHOD OF SURVEY: GPS
5. ALL WORKS WERE CARRIED OUT TO TCC IDC 2011 STANDARDS.
6. ALL RIDERMAINS ARE 63 OD PE UNLESS OTHERWISE SPECIFIED.
7. REFER TO TABLE FOR PE PIPE DETAILS
8. WHERE MULTIPLE WATER METERS ARE BANKED AT THE BOUNDARY 2 OR 3 WATER METERS HAVE BEEN PLACED IN EACH BOX.
9. NO VALVES OR HYDRANTS ARE LOCATED IN THE CARRIAGEWAY.
10. ALL WATER METERS HAVE BEEN INSTALLED WITHIN THE ROAD RESERVE EXCEPT FOR KISSLING TERRACE.

LEGEND:

- W — AS BUILT WATER MAIN
- RM — AS BUILT RIDER MAIN
- H — AS BUILT HYDRANT
- AS BUILT SLUICE VALVE
- AS BUILT GATE VALVE
- W — AS BUILT WATER METER

REF	REVISIONS	BY	DATE
B	FINAL AS BUILT	GPR	27.06.18
A	DRAFT AS BUILT	GPR	12.06.18

ORIGINATOR: PSJ	DATE: 06.06.18	SIGNED:	PLOT BY: TRS
DRAWN: PSJ	DATE: 06.06.18	SIGNED:	PLOT DATE: 29.06.18
CHECKED: GPR	DATE: 27.06.18	SIGNED:	SURVEY BY: RXD
APPROVED: GPR	DATE: 27.06.18	SIGNED:	SURVEY DATE:

ASSOCIATION OF CONSULTING ENGINEERS NEW ZEALAND — ISO 9001 QUALITY ASSURED

TAURANGA OFFICE
LEVEL 1, 60 SPRING STREET
TAURANGA 3110
T +64 7 578 0023
W www.harrisongrierson.com

PROJECT: Summit
THE LAKES (2012) LIMITED, TAURANGA

TITLE: STAGE 3JKL CIVILS
WATER RETICULATION AS BUILT PLAN
SHEET 3
TCC IP 101861

ISSUE STATUS: FINAL AS BUILT

PROJECT No: 1510-141209-01 | SCALES: 1:625 - A1, 1:1250 - A3 | A1

DRAWING No: 141209-AB303 | REV B

REFER TO APPROVED MASTER DRAWINGS FOR ORIGINAL SIGNATURES File: TAURANGA N:\1510\141209_A STAGE 3JKL\CAD\ASBUILTS\141209-01-AB301-305 (WATER).DWG