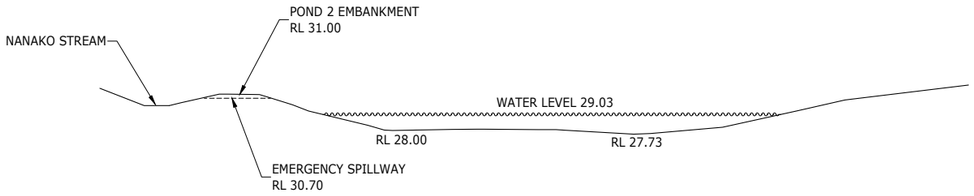

B AB401 **POND 2 CROSS SECTION**

SCALE 1:250 - A1
1:500 - A3

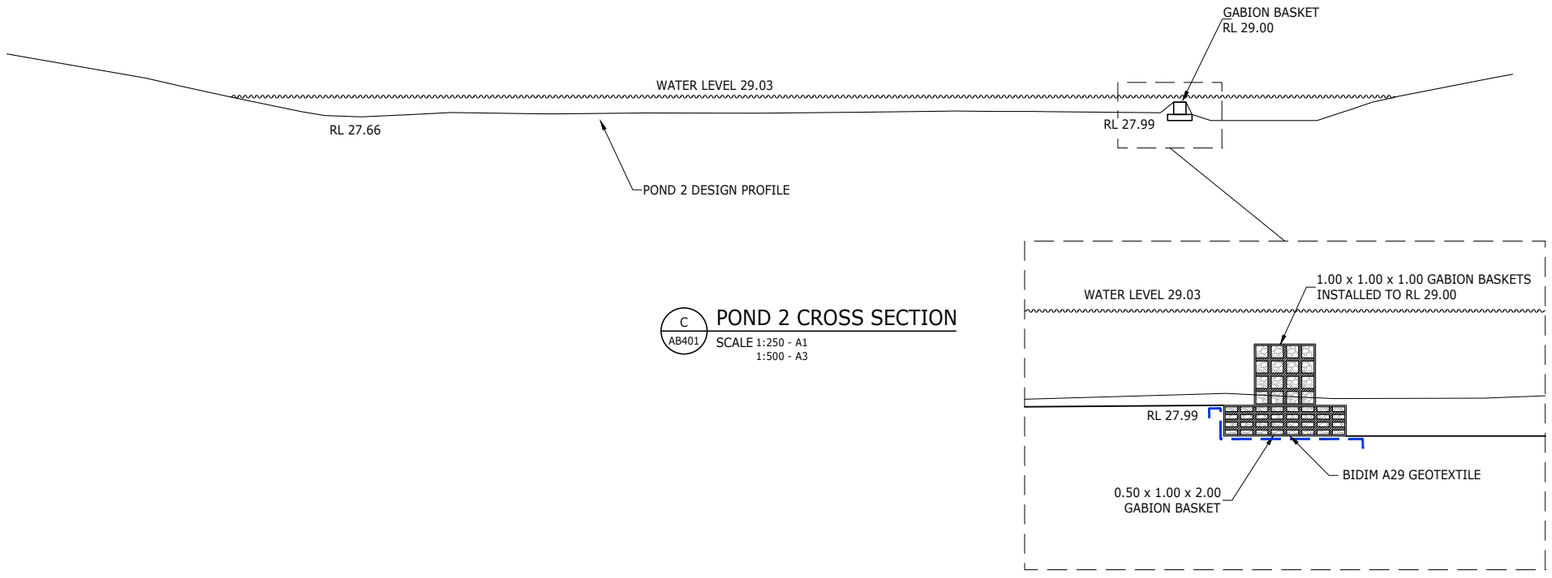

C AB401 **POND 2 CROSS SECTION**

SCALE 1:250 - A1
1:500 - A3

				ORIGINATOR: TCH	DATE: 18.01.18	SIGNED:	PLOT BY: TRS	ASSOCIATION OF CONSULTING ENGINEERS NEW ZEALAND	ISO 9001 QUALITY ASSURED
				DRAWN: PSJ	DATE: 18.01.18	SIGNED:	PLOT DATE: 19.01.18		
C	FINAL AS BUILT	TCH	19.01.18	CHECKED: GPR	DATE: 19.01.18	SIGNED:	SURVEY BY:		
B	FINAL AS BUILT	TCH	19.01.18						
A	DRAFT AS BUILT	TCH	18.01.18	APPROVED: GPR	DATE: 19.01.18	SIGNED:	SURVEY DATE:		
REF	REVISIONS	BY	DATE						

THIS DRAWING AND DESIGN REMAINS THE PROPERTY OF, AND MAY NOT BE REPRODUCED OR ALTERED, WITHOUT THE WRITTEN PERMISSION OF HARRISON GRIERSON CONSULTANTS LIMITED. NO LIABILITY SHALL BE ACCEPTED FOR UNAUTHORISED USE OF THIS DRAWING.

TAURANGA OFFICE
LEVEL 1 HARRISON GRIERSON HOUSE
60 SPRING STREET TAURANGA 3110
T +64 7 578 0023
W www.harrisongrierson.com

PROJECT:
Summit
THE LAKES (2012) LIMITED, TAURANGA

TITLE:
STAGE 3I
POND 2 AS BUILT CROSS SECTIONS
TCC IP 101782

ISSUE STATUS: FINAL AS BUILT

PROJECT No: 1520-139618-01
SCALES: 1:100 - A1, 1:200 - A3
A1

DRAWING No: 135952-AB403
REV C