NOTES:

1. LEVELS ARE IN TERMS OF THE MOTURIKI DATUM.
2. ORIGIN OF LEVELS TCC BENCHMARK BM 1069 RL 42.220m.
3. METHOD OF SURVEY: GPS
4. ALL WORKS WERE CARRIED OUT TO TCC IDC 2011 STANDARDS.
5. ALL WASTEWATER MAINS ARE 150mm uPVC PIPES UNLESS SHOWN OTHERWISE.
6. ALL WASTEWATER MAINS ARE SN16 UNLESS SHOWN OTHERWISE.
7. ALL STORMWATER AND WASTEWATER CONNECTIONS ARE 100mm NB uPVC, UNLESS UNDER CARRIAGEWAY WHERE 150mm NB uPVC ARE USED.
8. ALL MANHOLES ARE 1050mm DIA UNLESS OTHERWISE SHOWN.
9. ALL DEEP DRAINAGE CONNECTIONS ARE RAMPED UP TO WITHIN 1.5m OF SURFACE.
10. ALL BURIED AS BUILT INFORMATION SUPPLIED BY HIGGINS CONTRACTORS LTD.

LEGEND:

- AS BUILT MANHOLE
- EXISTING MANHOLE
- AS BUILT RODDING EYE
- AS BUILT WASTEWATER
- EXISTING WASTEWATER
- AS BUILT WASTEWATER CONNECTION
- FLOW DIRECTION

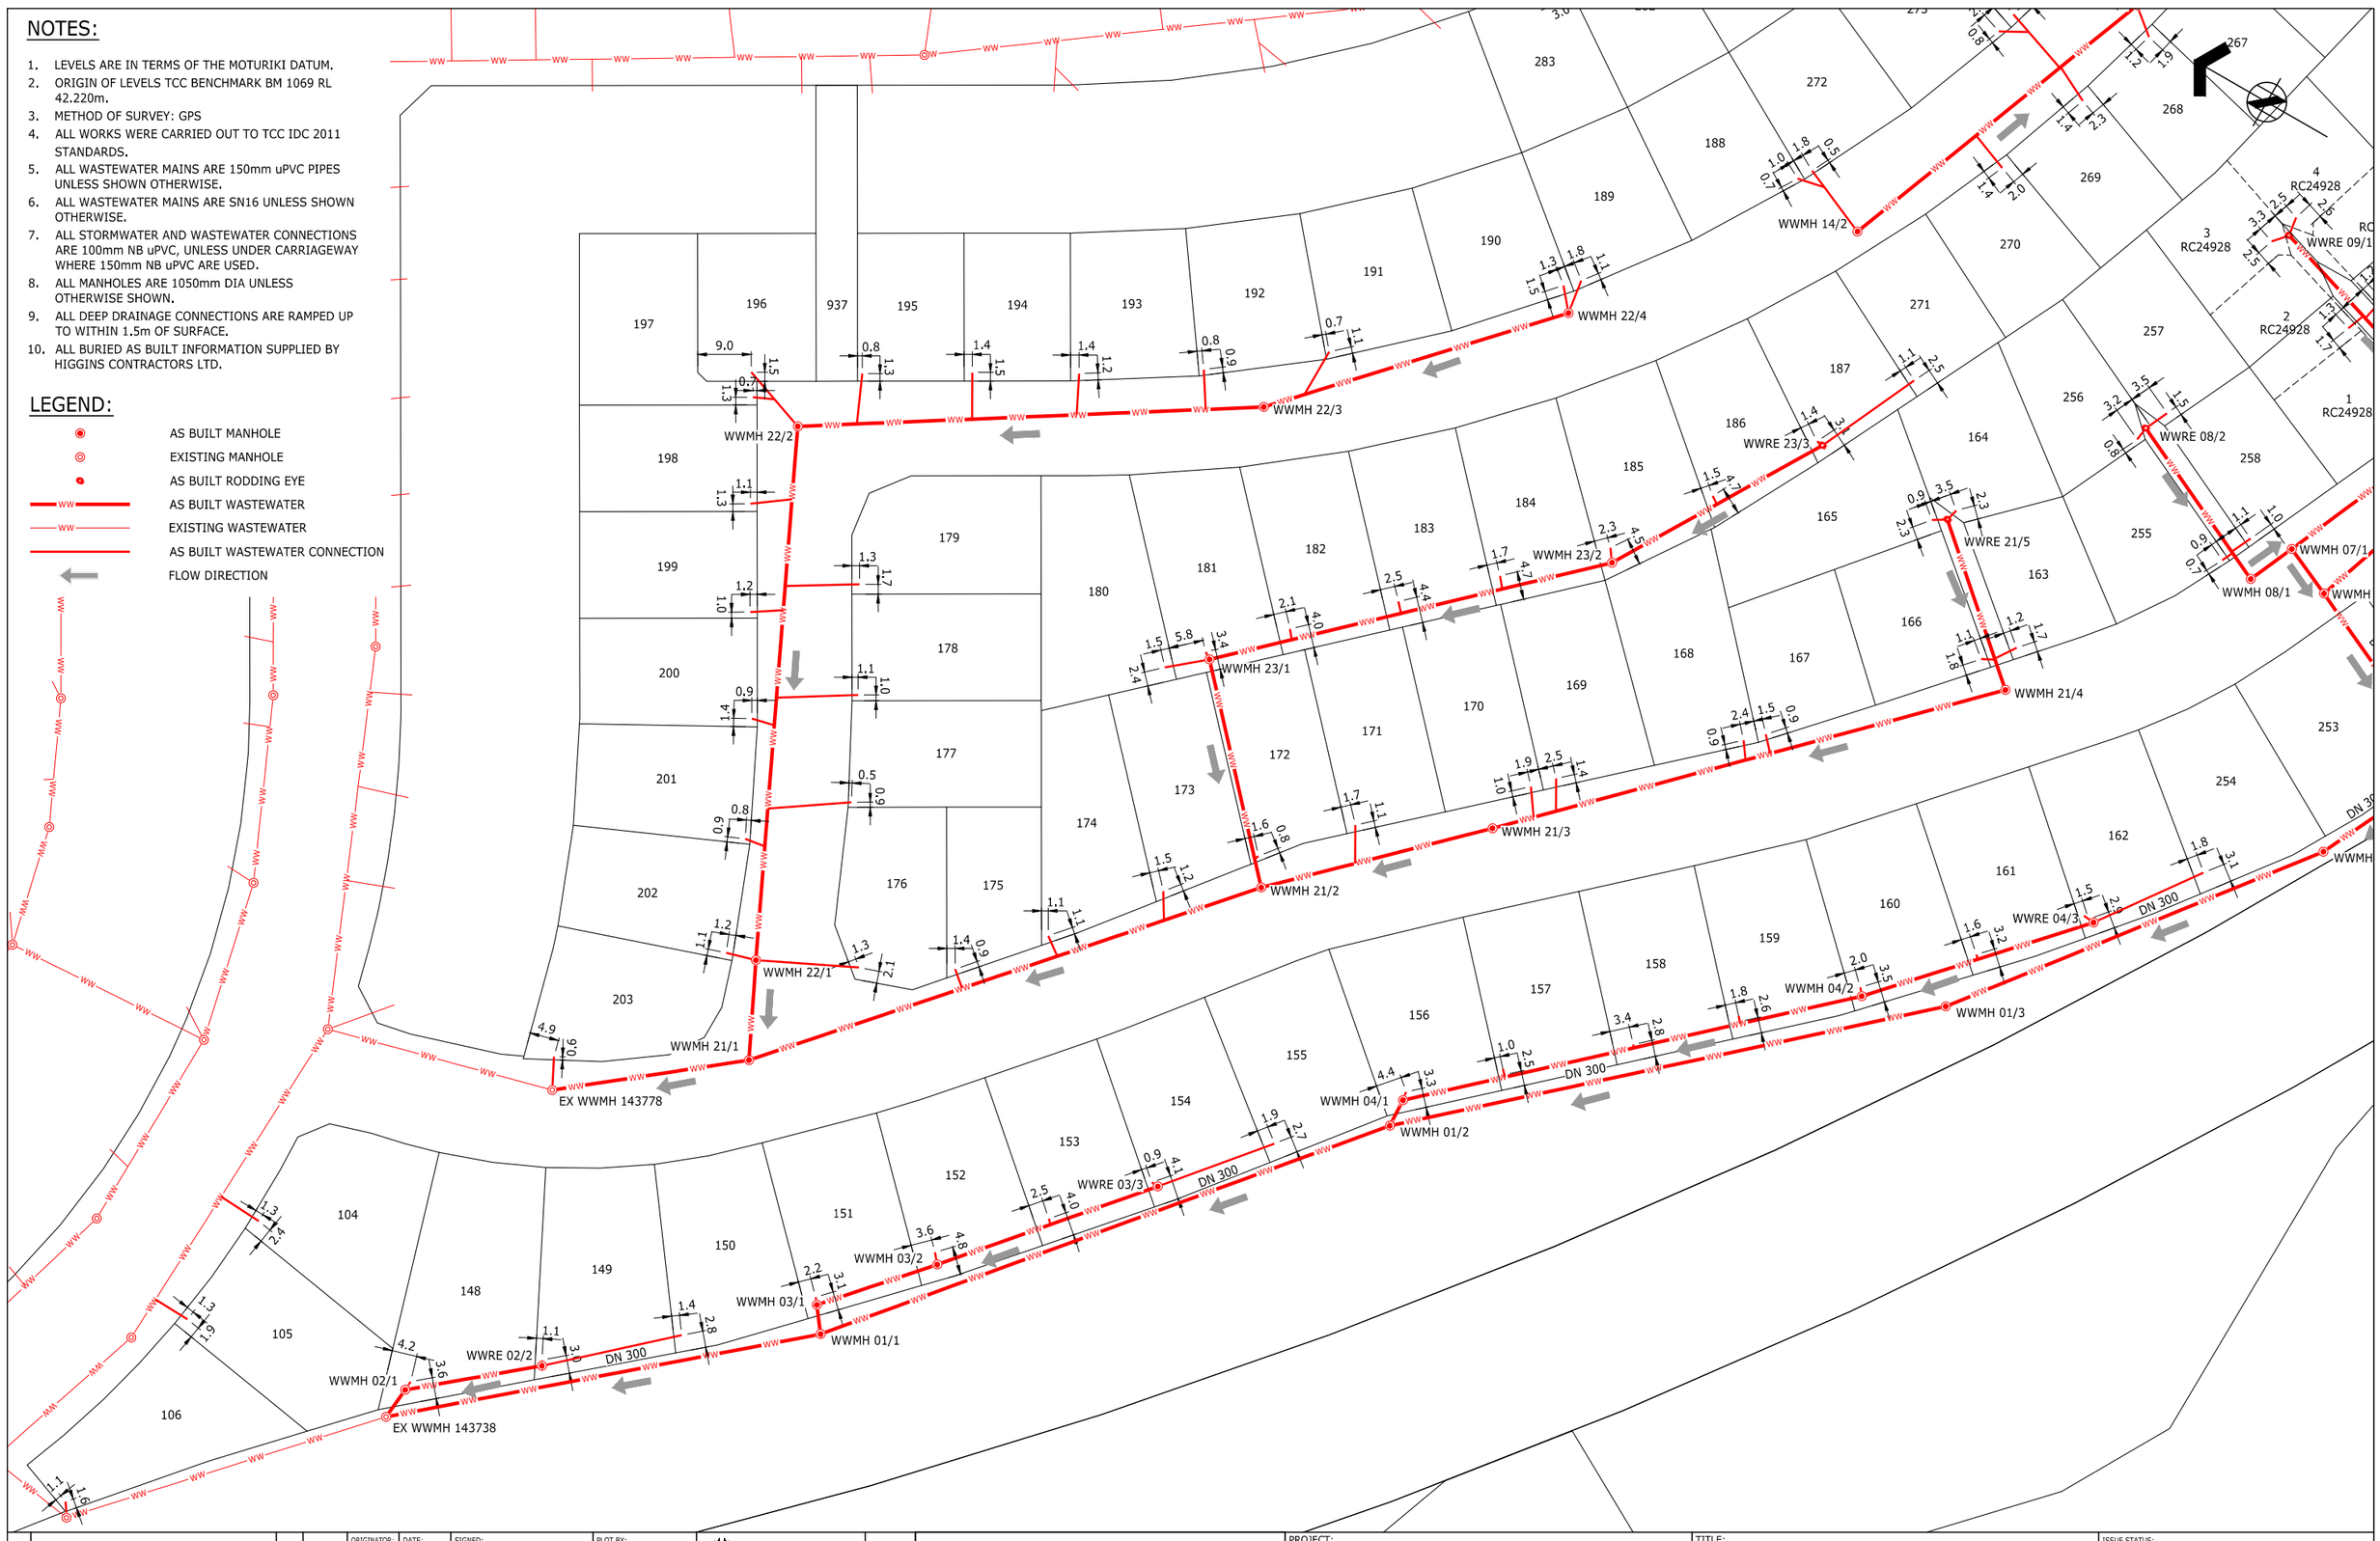

				ORIGINATOR:	DATE:	SIGNED:	PLOT BY:
				RXD	28.04.16		HEH
				DRAWN:	DATE:	SIGNED:	PLOT DATE:
				HEH	28.04.16		31.05.16
				CHECKED:	DATE:	SIGNED:	SURVEY BY:
B	AS BUILT FINAL	GPR	30.05.16	GPR	30.05.16		
A	AS BUILT DRAFT	GPR	18.05.16	APPROVED:	DATE:	SIGNED:	SURVEY DATE:
REF	REVISIONS	BY	DATE	GPR	30.05.16		

ASSOCIATION OF CONSULTING ENGINEERS NEW ZEALAND

ISO 9001 QUALITY ASSURED

TAURANGA OFFICE
LEVEL 1 HARRISON GRIERSON HOUSE
141 CAMERON ROAD TAURANGA 3110
T +64 7 578 0023
W www.harrisongrierson.com

PROJECT:

Summit

THE LAKES (2012) LIMITED, TAURANGA

TITLE:

STAGES 3CD
WASTEWATER RETICULATION AS BUILT PLAN
SHEET 4
TCC IP 101665

ISSUE STATUS: AS BUILT

PROJECT No: 1520-137966-01

SCALES: 1:500 - A1, 1:1000 - A3

A1

DRAWING No: 137966-AB204

REV B

REFER TO APPROVED MASTER DRAWINGS FOR ORIGINAL SIGNATURES File: TAURANGA N:\1520\137966_A\CAD\AS BUILTS\137966-01-AB201-206.DWG