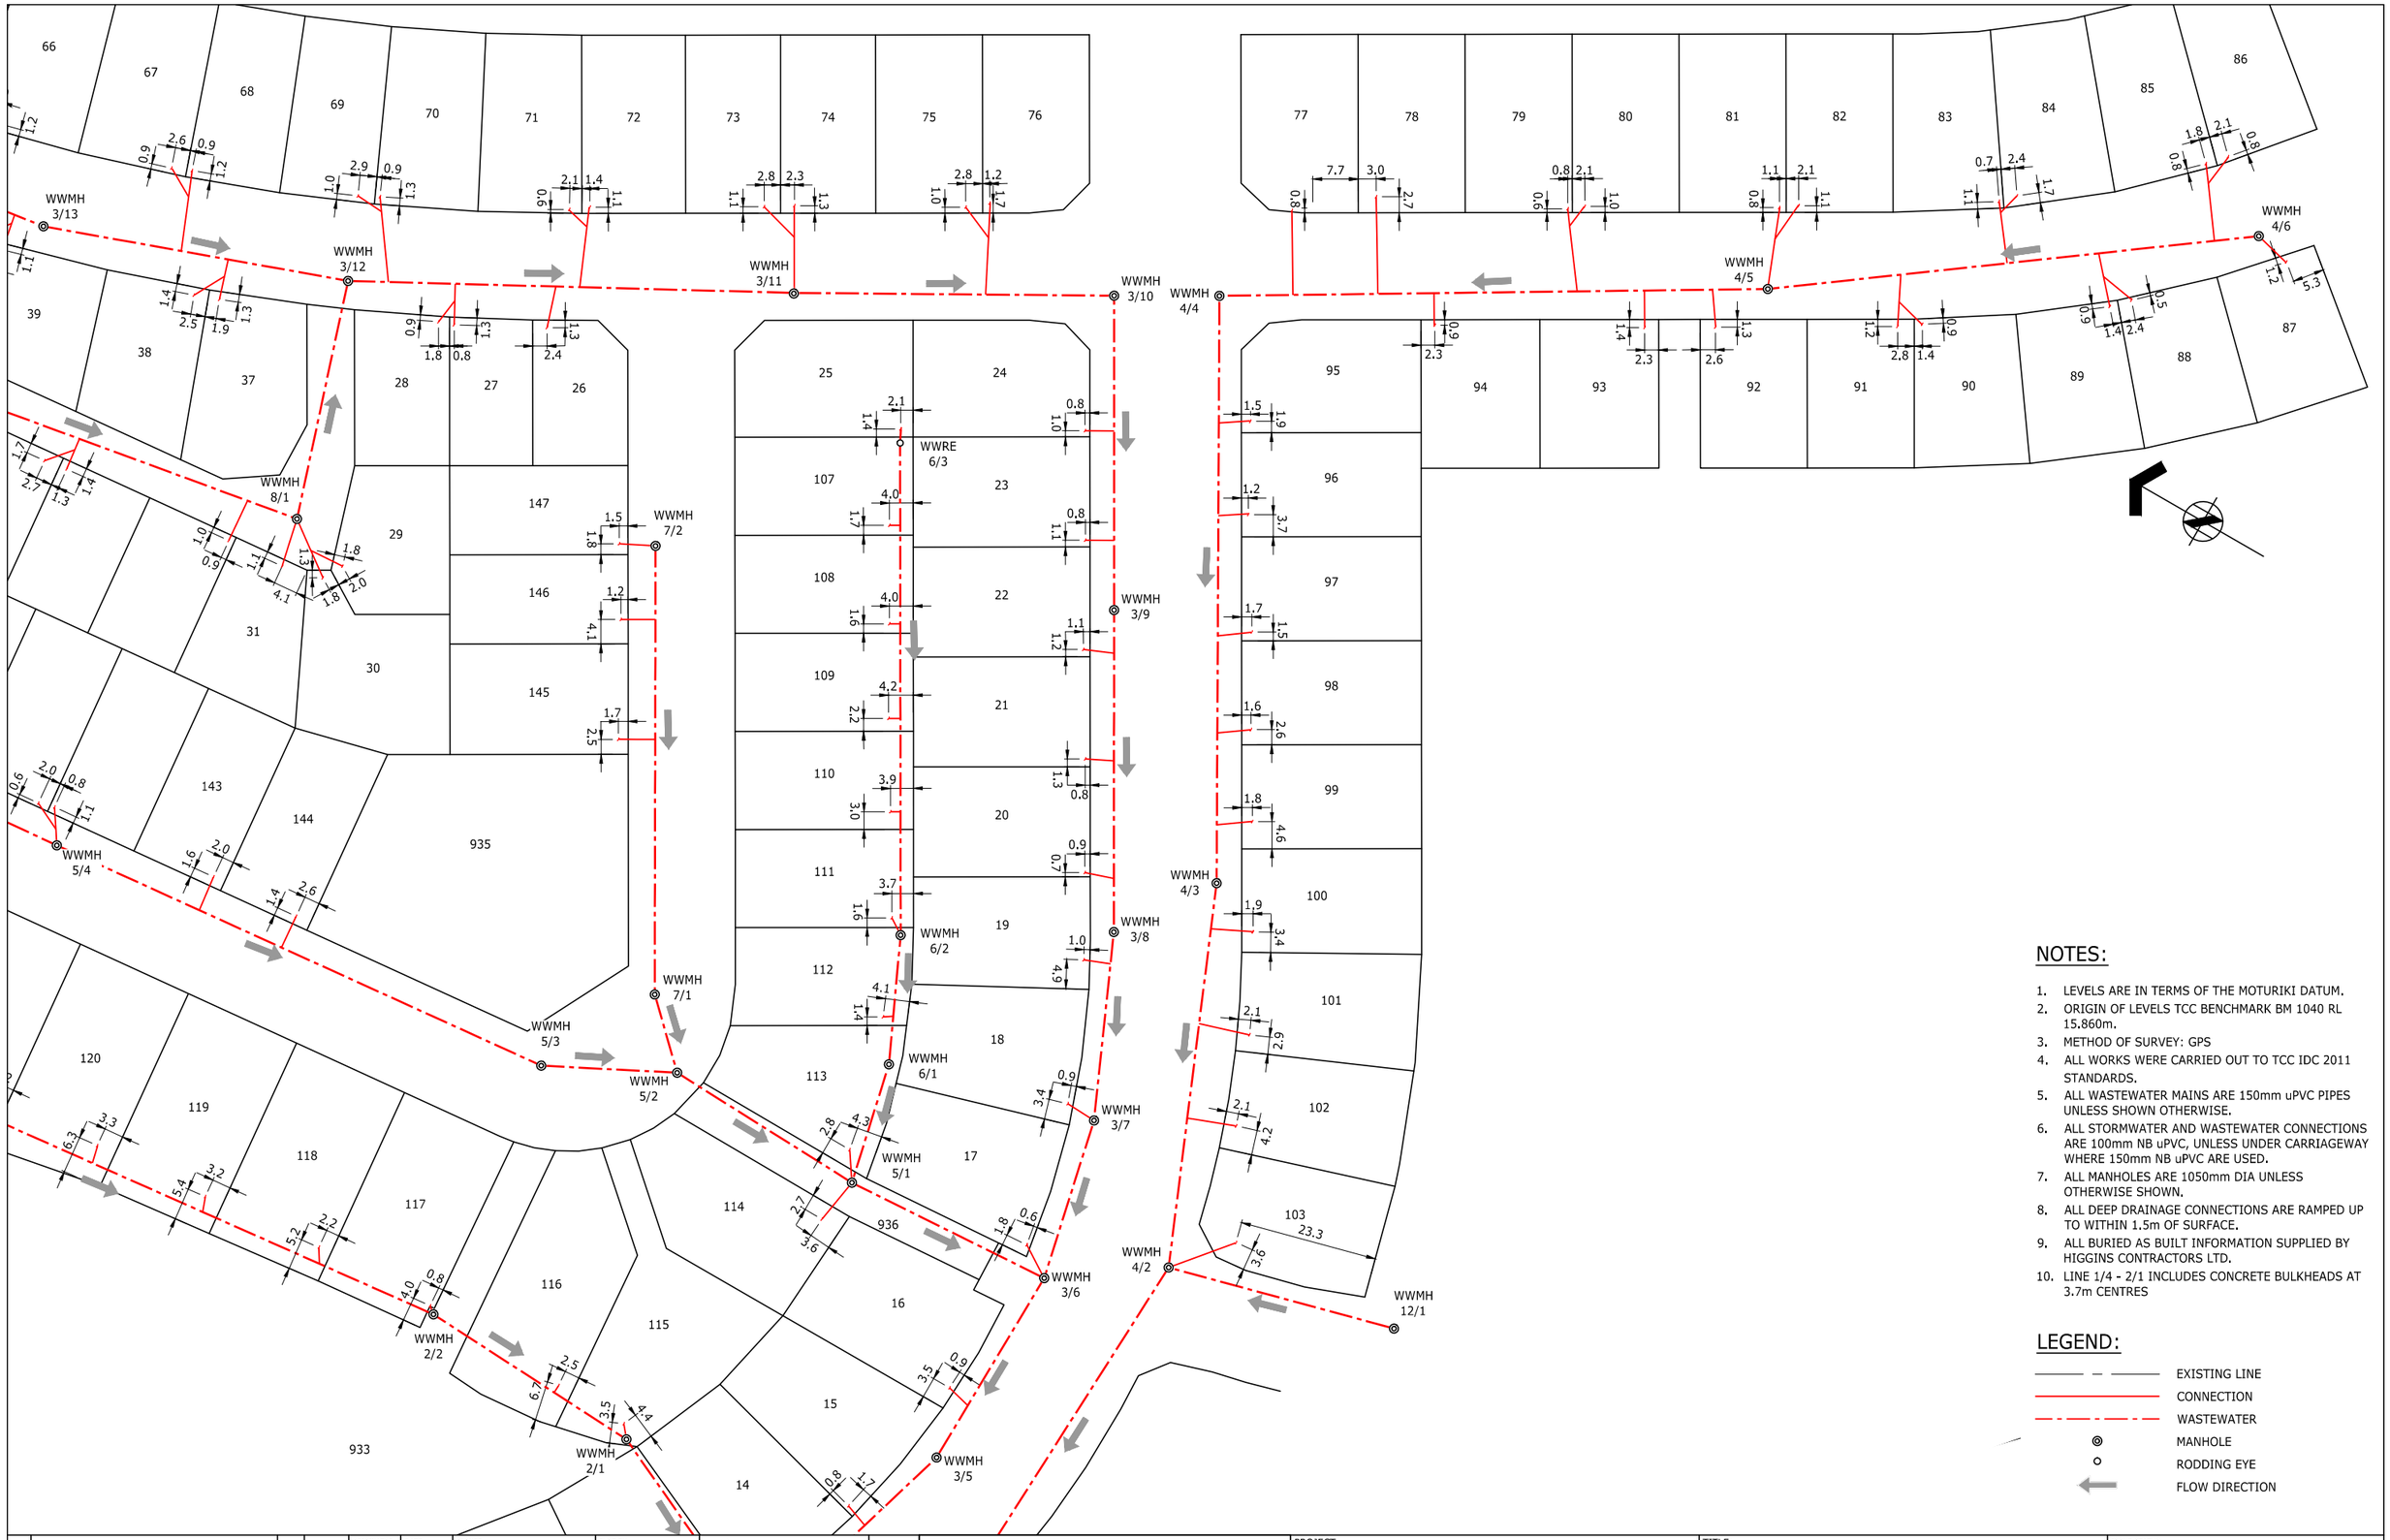

NOTES:

1. LEVELS ARE IN TERMS OF THE MOTURIKI DATUM.
2. ORIGIN OF LEVELS TCC BENCHMARK BM 1040 RL 15.860m.
3. METHOD OF SURVEY: GPS
4. ALL WORKS WERE CARRIED OUT TO TCC IDC 2011 STANDARDS.
5. ALL WASTEWATER MAINS ARE 150mm uPVC PIPES UNLESS SHOWN OTHERWISE.
6. ALL STORMWATER AND WASTEWATER CONNECTIONS ARE 100mm NB uPVC, UNLESS UNDER CARRIAGEWAY WHERE 150mm NB uPVC ARE USED.
7. ALL MANHOLES ARE 1050mm DIA UNLESS OTHERWISE SHOWN.
8. ALL DEEP DRAINAGE CONNECTIONS ARE RAMPED UP TO WITHIN 1.5m OF SURFACE.
9. ALL BURIED AS BUILT INFORMATION SUPPLIED BY HIGGINS CONTRACTORS LTD.
10. LINE 1/4 - 2/1 INCLUDES CONCRETE BULKHEADS AT 3.7m CENTRES

LEGEND:

- EXISTING LINE
- CONNECTION
- WASTEWATER
- MANHOLE
- RODDING EYE
- FLOW DIRECTION

REF	REVISIONS	BY	DATE
B	AS BUILT FINAL	RXD	30.04.15
A	AS BUILT DRAFT	RXD	21.04.15

ORIGINATOR: RXD	DATE: 21.04.15	SIGNED:	PLOT BY: HEH
DRAWN: HEH	DATE: 21.04.15	SIGNED:	PLOT DATE: 30.04.15
CHECKED: GPR	DATE: 21.04.15	SIGNED:	SURVEY BY:
APPROVED: DGN	DATE: 21.04.15	SIGNED:	SURVEY DATE:

ASSOCIATION OF CONSULTING ENGINEERS NEW ZEALAND — ISO 9001 QUALITY ASSURED

THIS DRAWING AND DESIGN REMAINS THE PROPERTY OF, AND MAY NOT BE REPRODUCED OR ALTERED, WITHOUT THE WRITTEN PERMISSION OF HARRISON GRIERSON CONSULTANTS LIMITED. NO LIABILITY SHALL BE ACCEPTED FOR UNAUTHORISED USE OF THIS DRAWING.

TAURANGA OFFICE
LEVEL 1 HARRISON GRIERSON HOUSE
141 CAMERON ROAD TAURANGA 3110
T +64 7 578 0023
W www.harrisongrierson.com

PROJECT: Summit
THE LAKES (2012) LTD, TAURANGA

TITLE: STAGES 3AB
WASTEWATER RETICULATION AS BUILT PLAN
SHEET 2
TCC IP 101574

ISSUE STATUS: AS BUILT

PROJECT No: 1520-135959-01 | SCALES: 1:500 - A1, 1:1000 - A3 | A1

DRAWING No: 135959-AB201 | REV B

REFER TO APPROVED MASTER DRAWINGS FOR ORIGINAL SIGNATURES File: TAURANGA N:\1520\135959_A\CAD\AS BUILT\135959-AB200.DWG